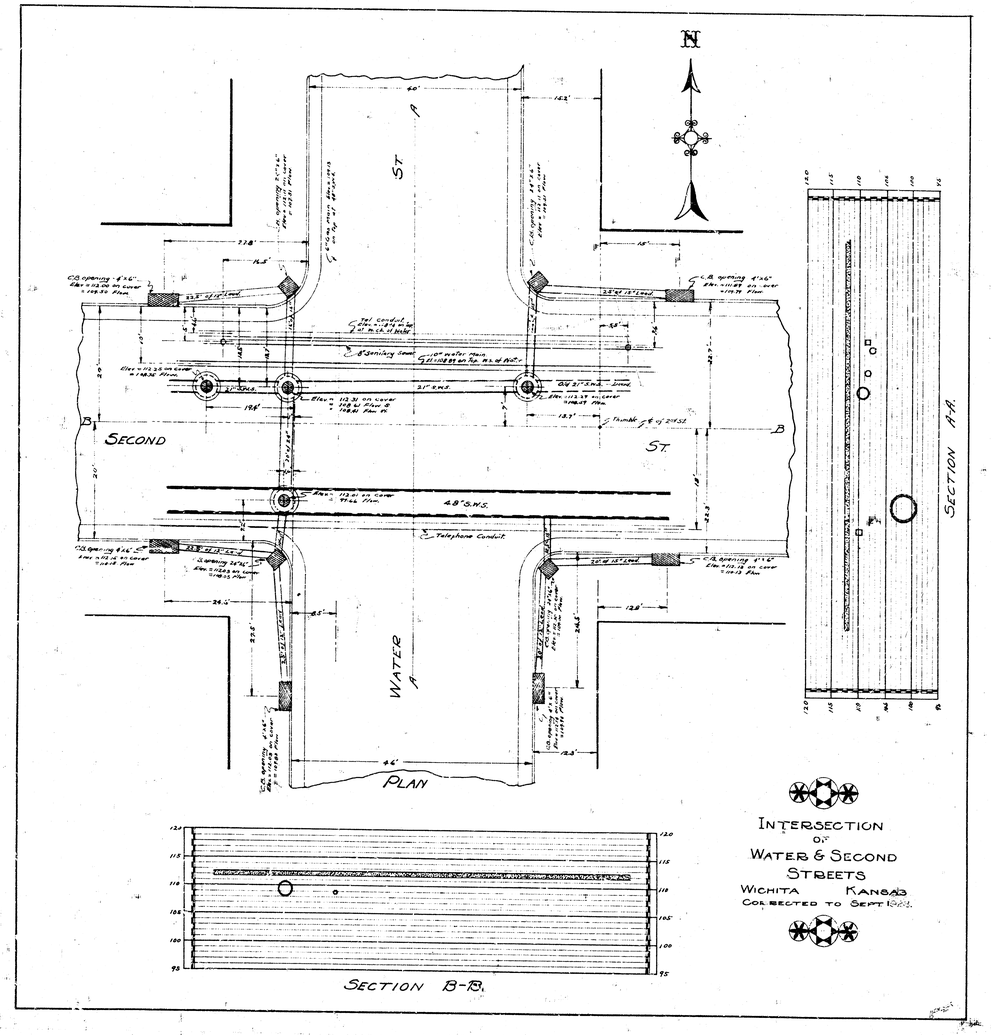
N
WATER ST
SECOND ST
PLAN
SECTION A-A.
SECTION B-B.
INTERSECTION
OF
WATER & SECOND
STREETS
WICHITA KANSAS
CORRECTED TO SEPT 1922.