INTERSECTION 2nd & RIDGEWOOD 26' ~~30'~~ Conc. ~~C.I.G.~~

~~BM Elev. 185.31 S. cb. 2nd Wt. Ridgewood (W.G. in Globe)~~

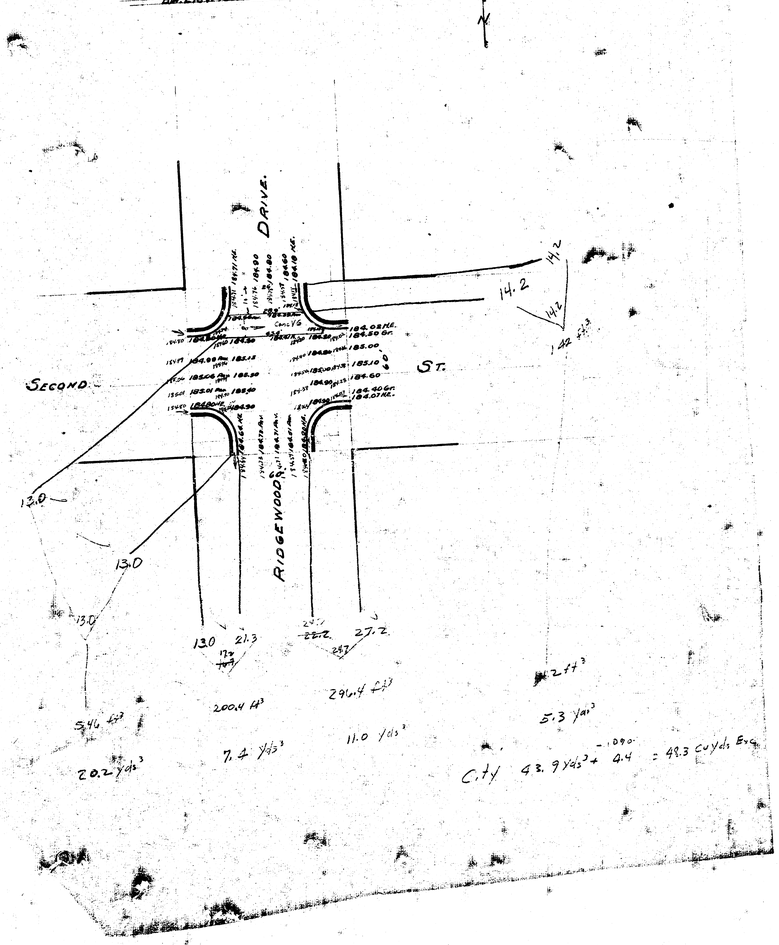

Paving Plan
Intersection
2nd & Ridgewood
Drive
1940