
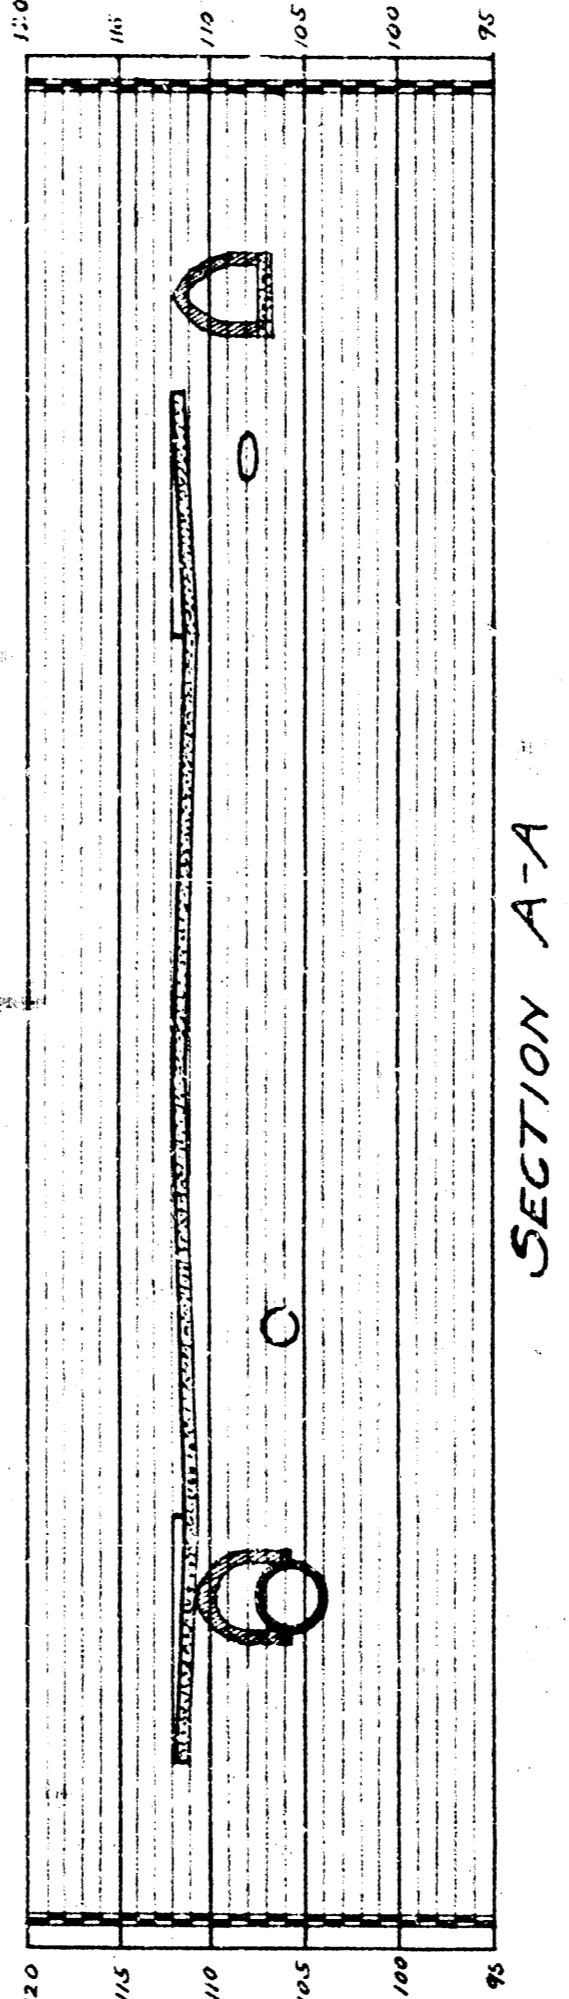


INTERSECTION
 OF
 THIRD STREET
 AND
 ALLEY E. OF MAIN ST.
 WICHITA KANSAS.
 CORRECTED TO NOV. 1923.

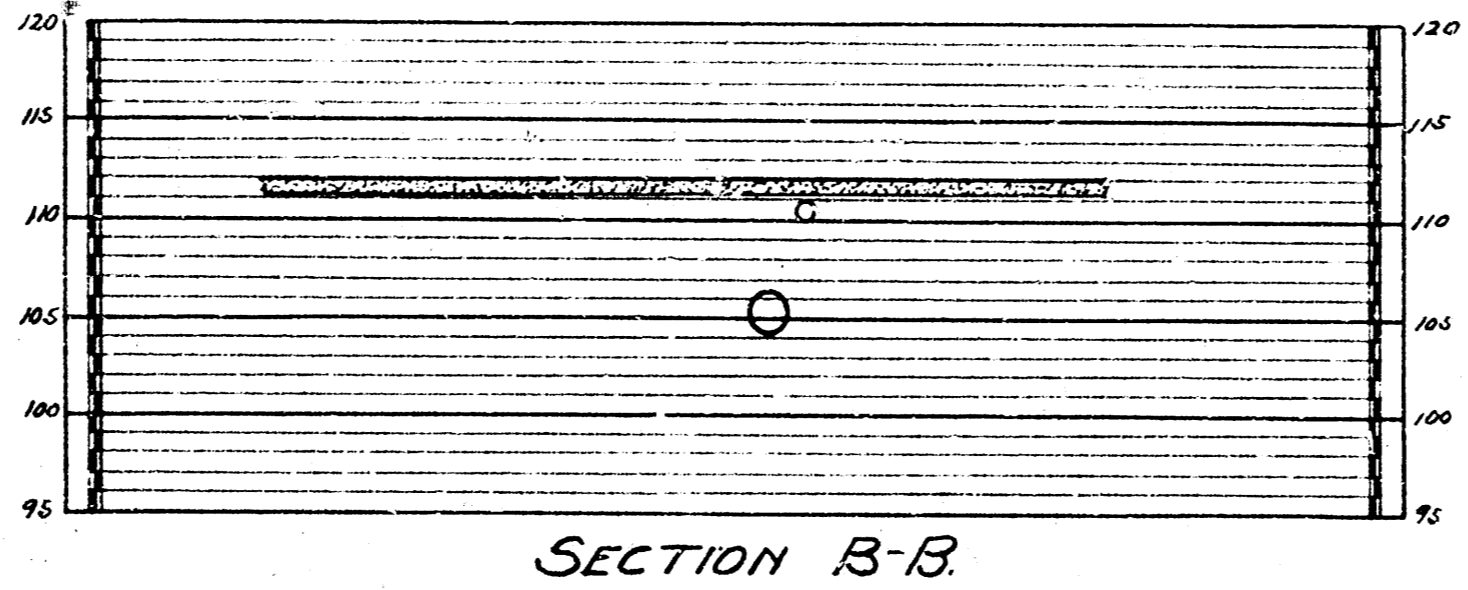

PLAN

SECTION B-B

SECTION A-A