


S-4

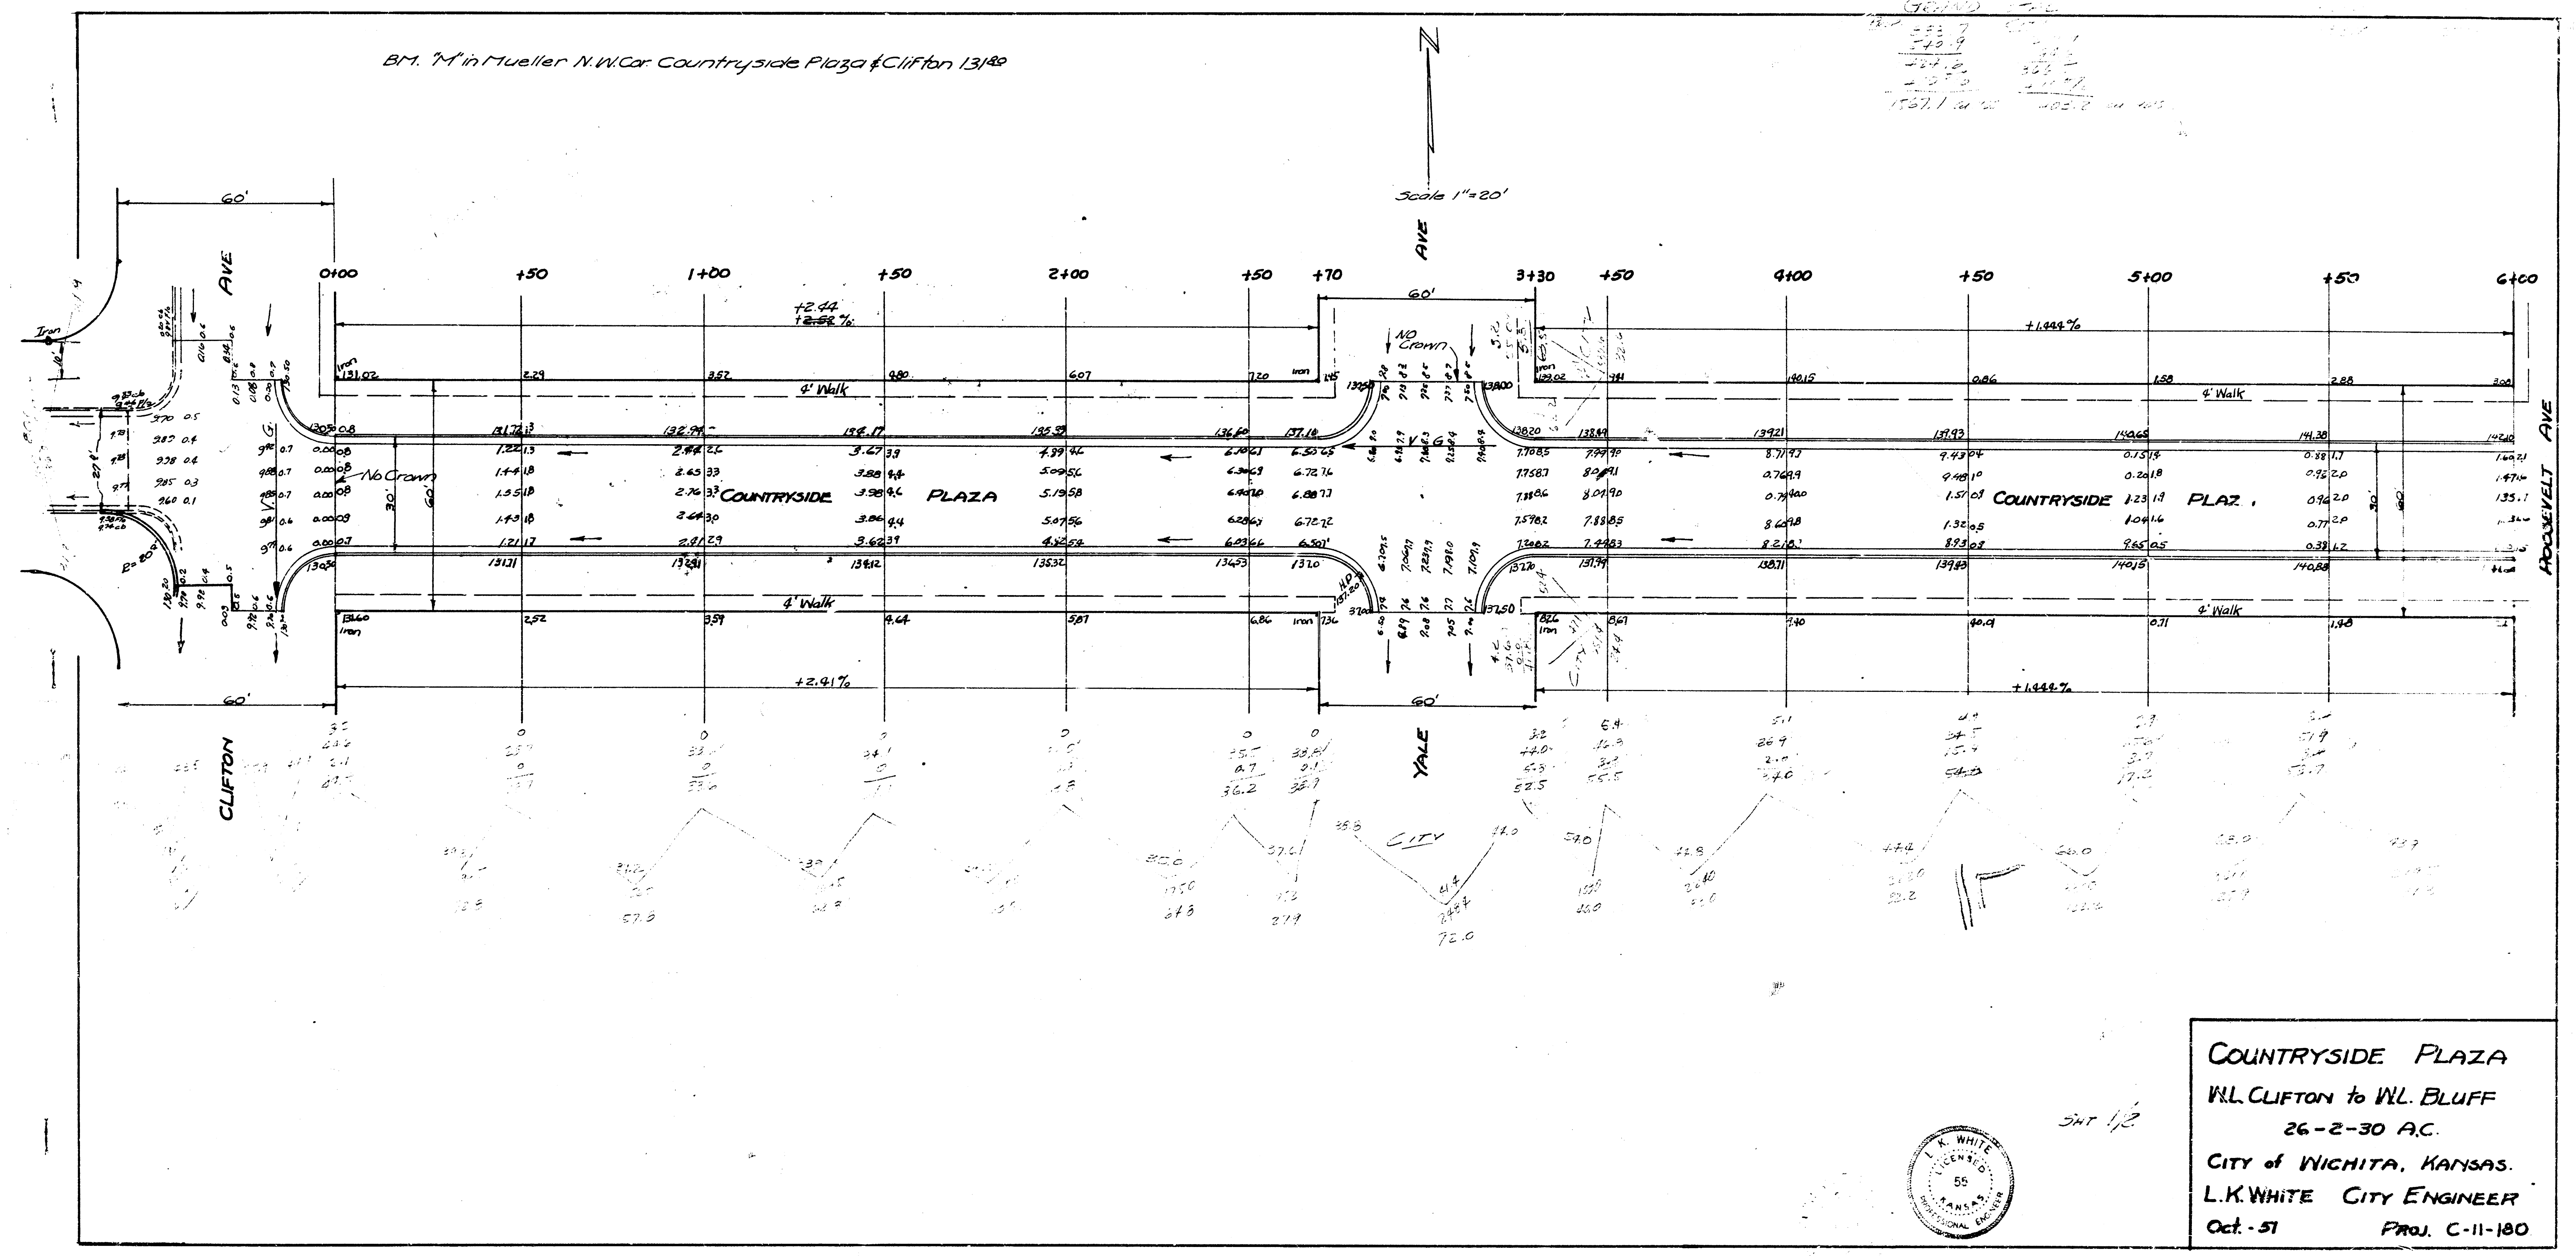

COUNTRYSIDE PLAZA
W.L. CLIFTON to W.L. BLUFF
26-2-30 A.C.
CITY of WICHITA, KANSAS.
L.K. WHITE CITY ENGINEER
Oct.-51 PROJ. C-11-180

7609

7609

