


B.M. 174.62 Top of Prop. Iron NW Cor. Ridgewood & Courtleigh Dr.

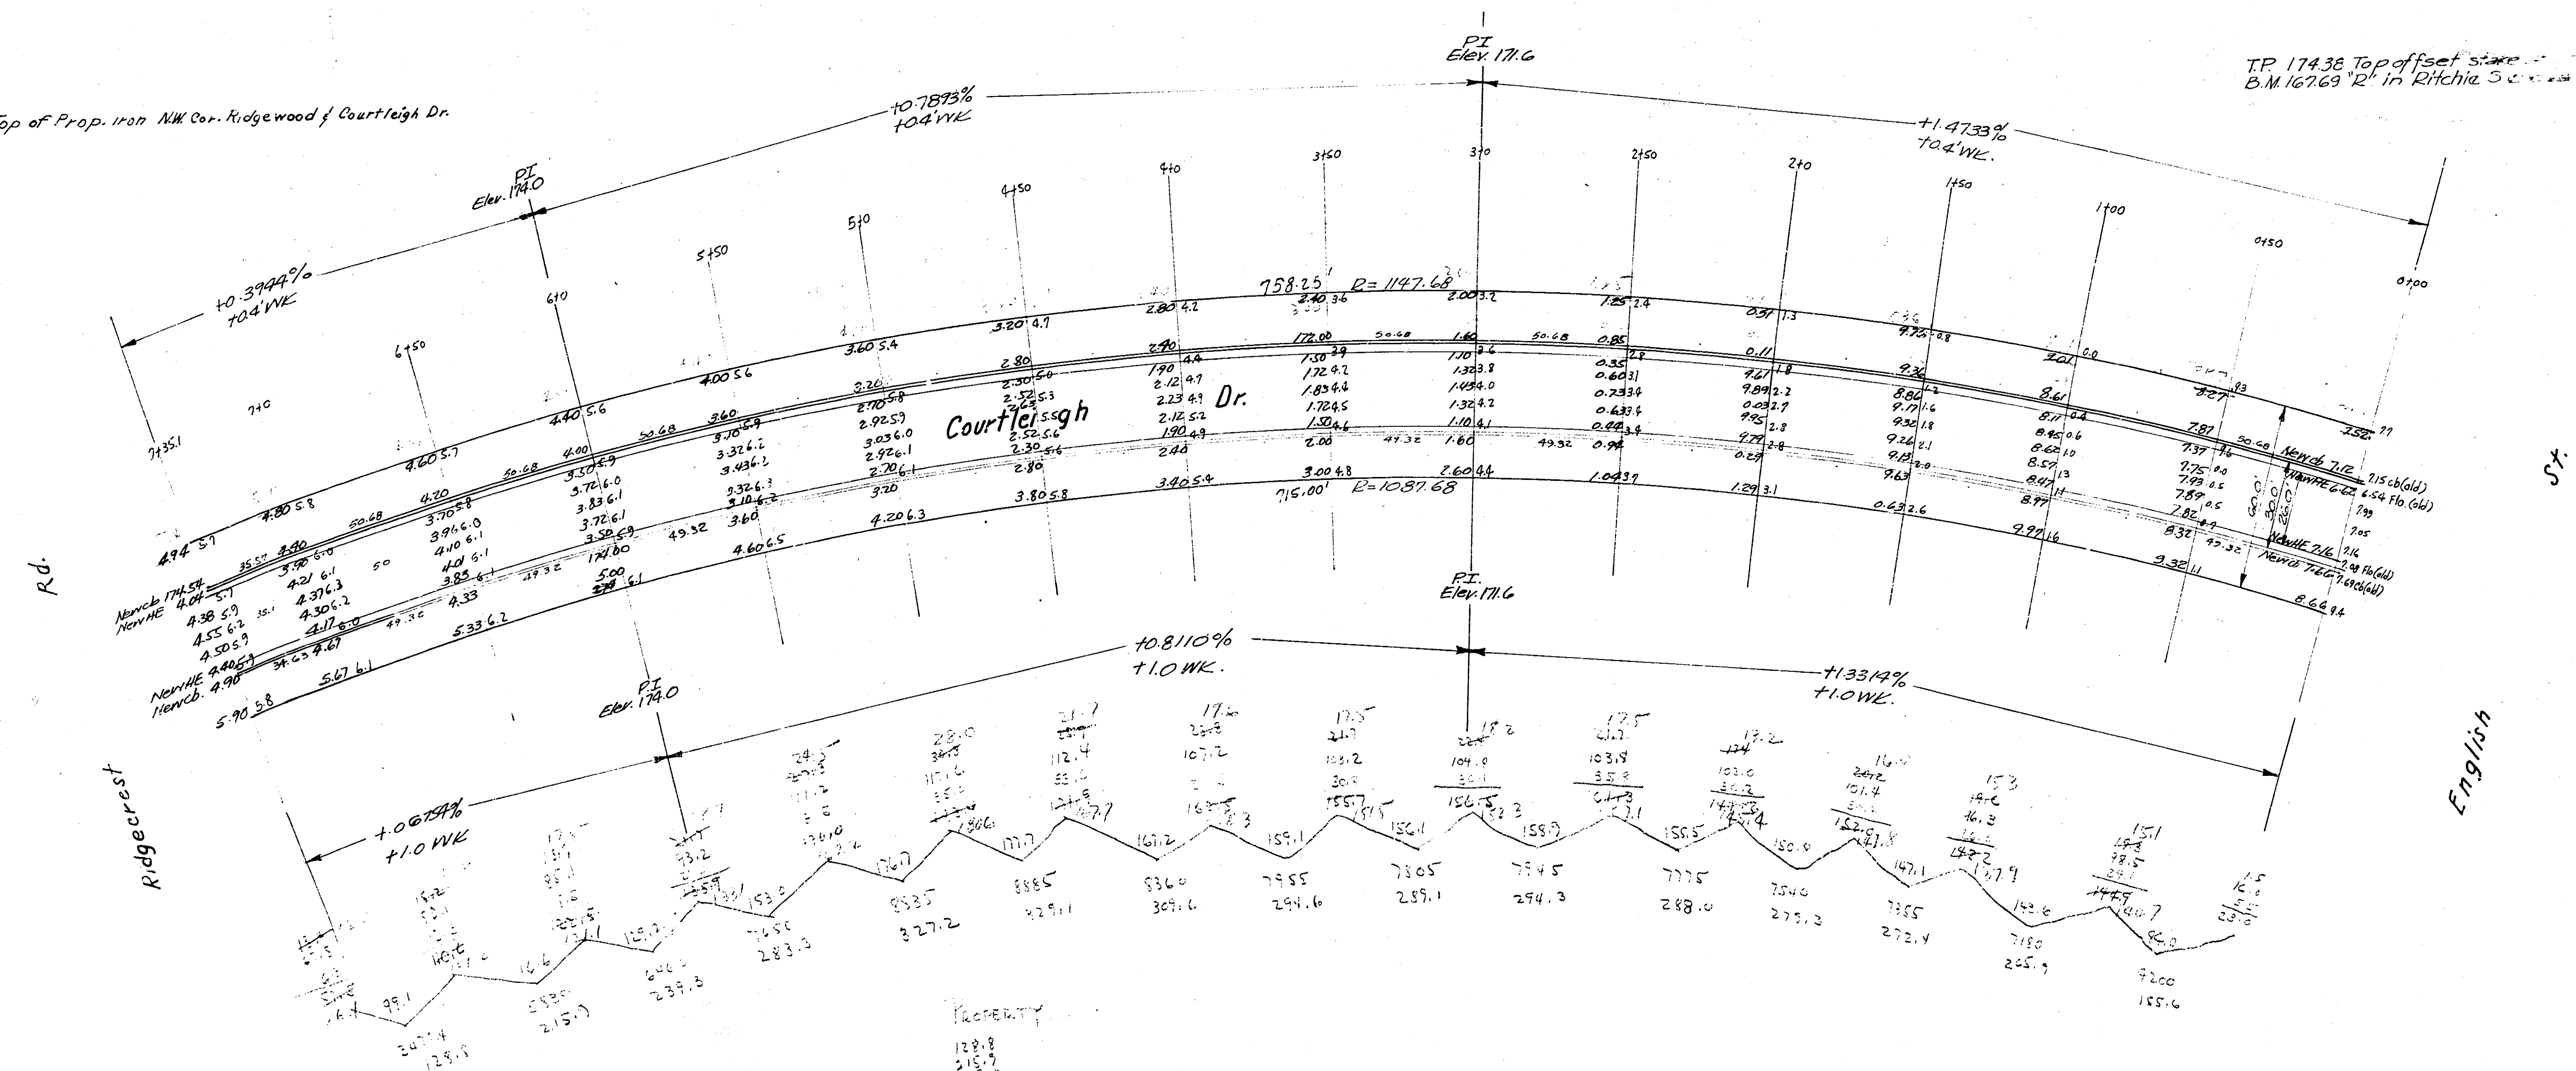


Total Cu Yds.

Note: Stationing is on Centerline Courtleigh Dr.
Grade Percentages figured on Curb-Line Distances.

Courtleigh Dr.
S.L. English St. to N.L. Ridgewood Dr.
26-2-30 ASPH. CONC.
CITY of WICHITA, KANSAS
L.K. WHITE - CITY ENGINEER
Feb. 1950 Proj. No. C15-178