
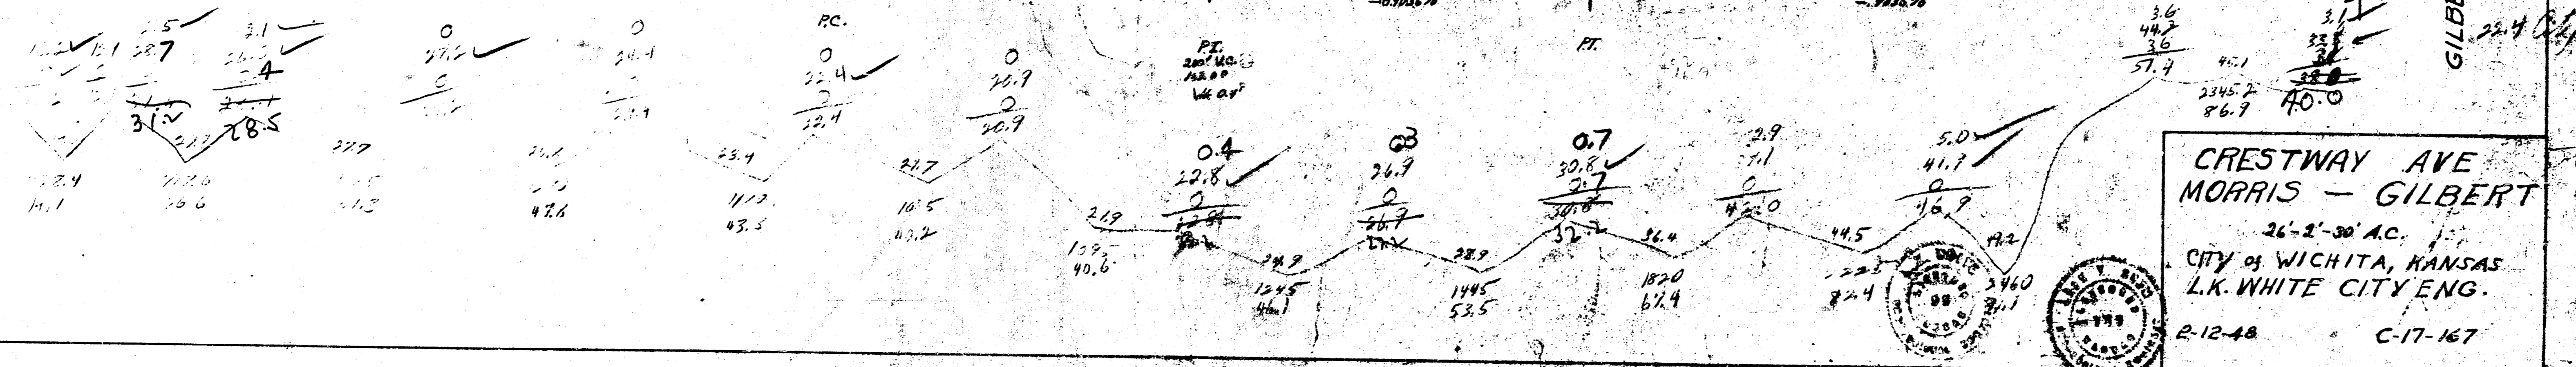



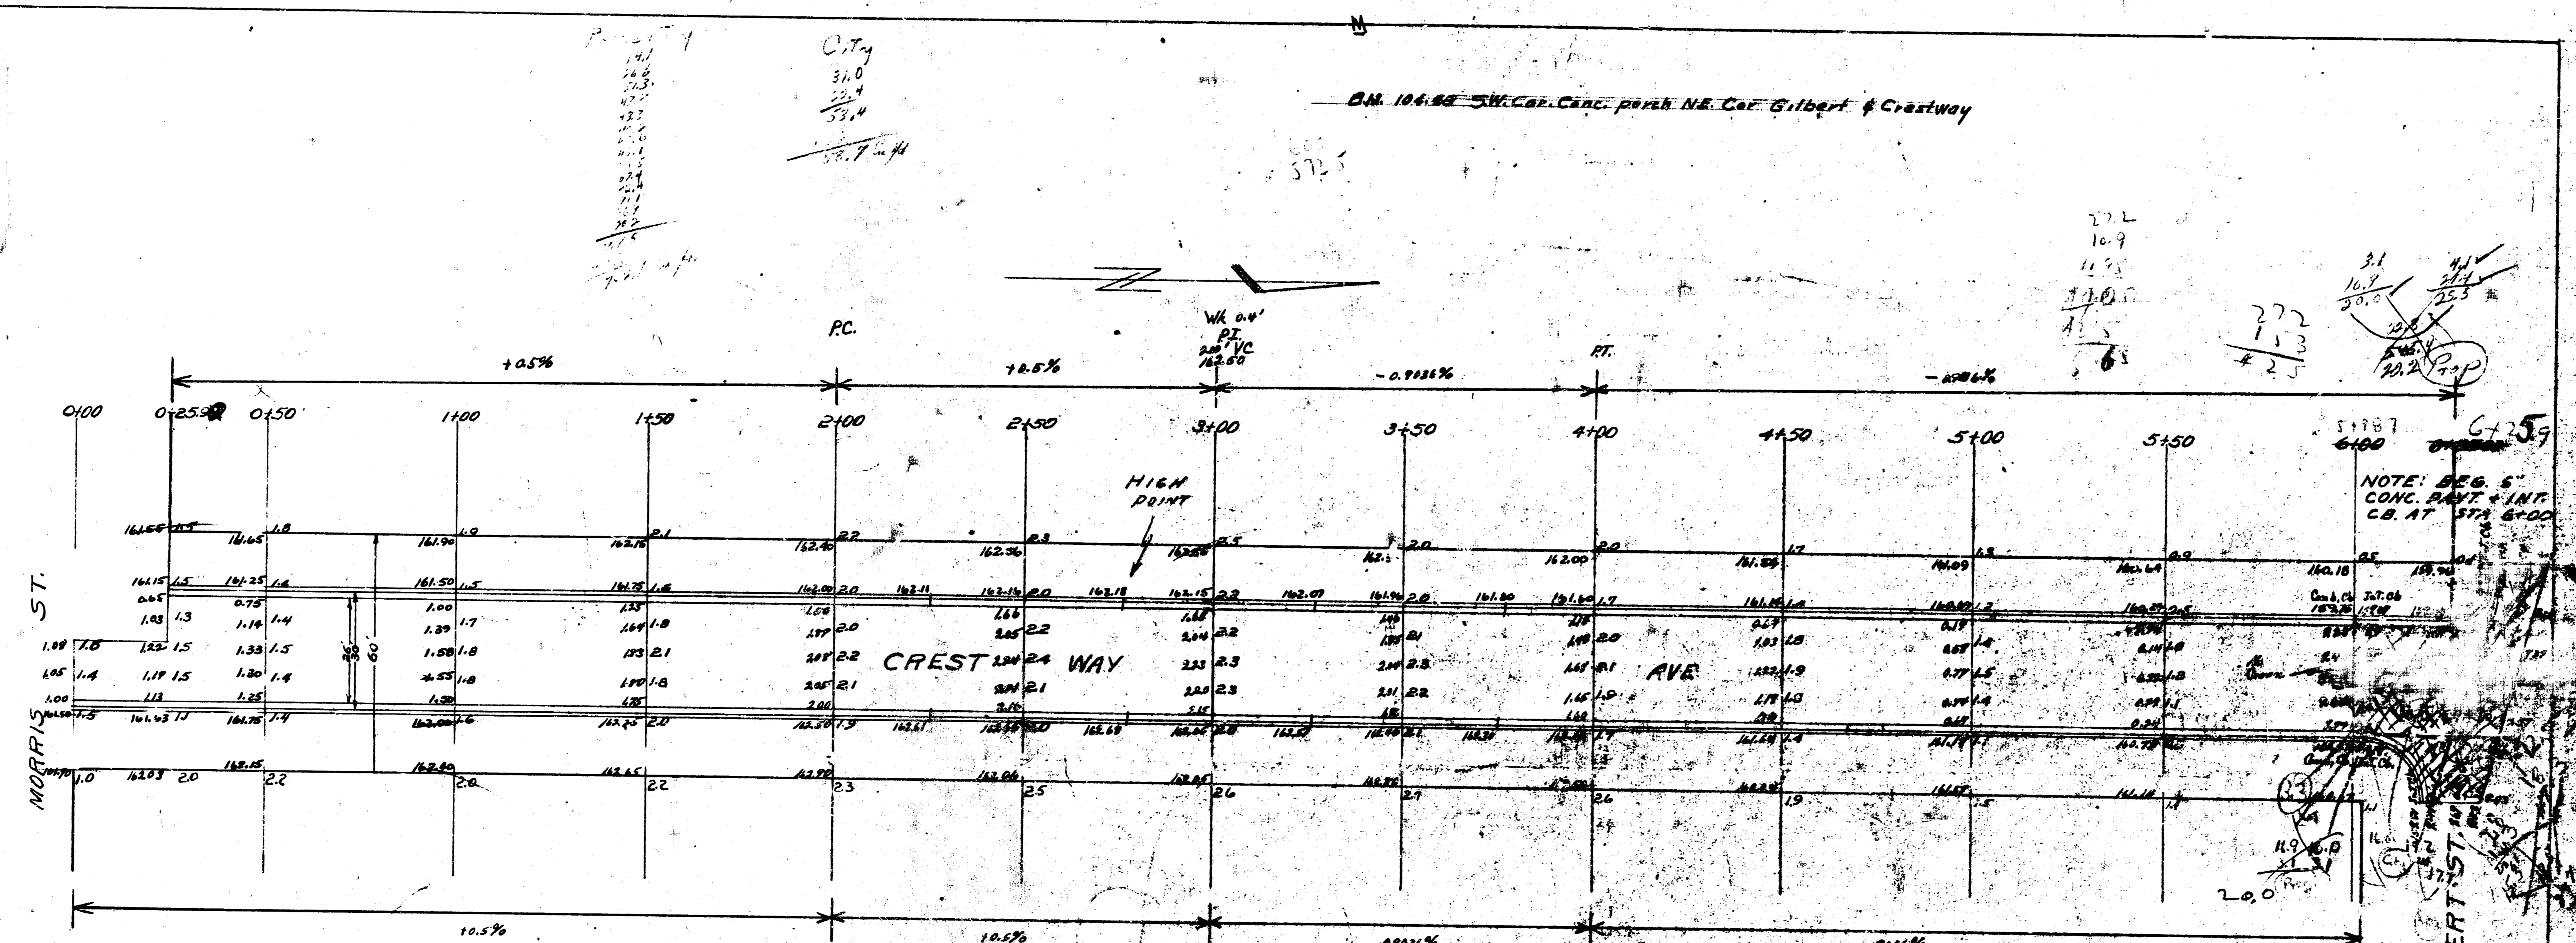

CRESTWAY AVE
MORRIS - GILBERT
26'-2'-30" A.C.
CITY OF WICHITA, KANSAS
L.K. WHITE CITY ENG.
R-12-48 C-17-167

7/15/48

GILBERT ST



NOTE: SEE 5' CONC. BAYT + INT. C.B. AT STA 6+00

City
31.0
28.4
33.4
32.7
31.1
30.4
-0.4
-1.1
