



TYPED BY: [illegible]
 CHECKED BY: [illegible]
 REVIEWED BY: [illegible]
 DRAWN BY: [illegible]
 DATE: [illegible]
 APPROVAL: [illegible]
 PAVED SIDEWALKS
 PAVED DRIVEWAYS
 PAVED PARKING SPACES

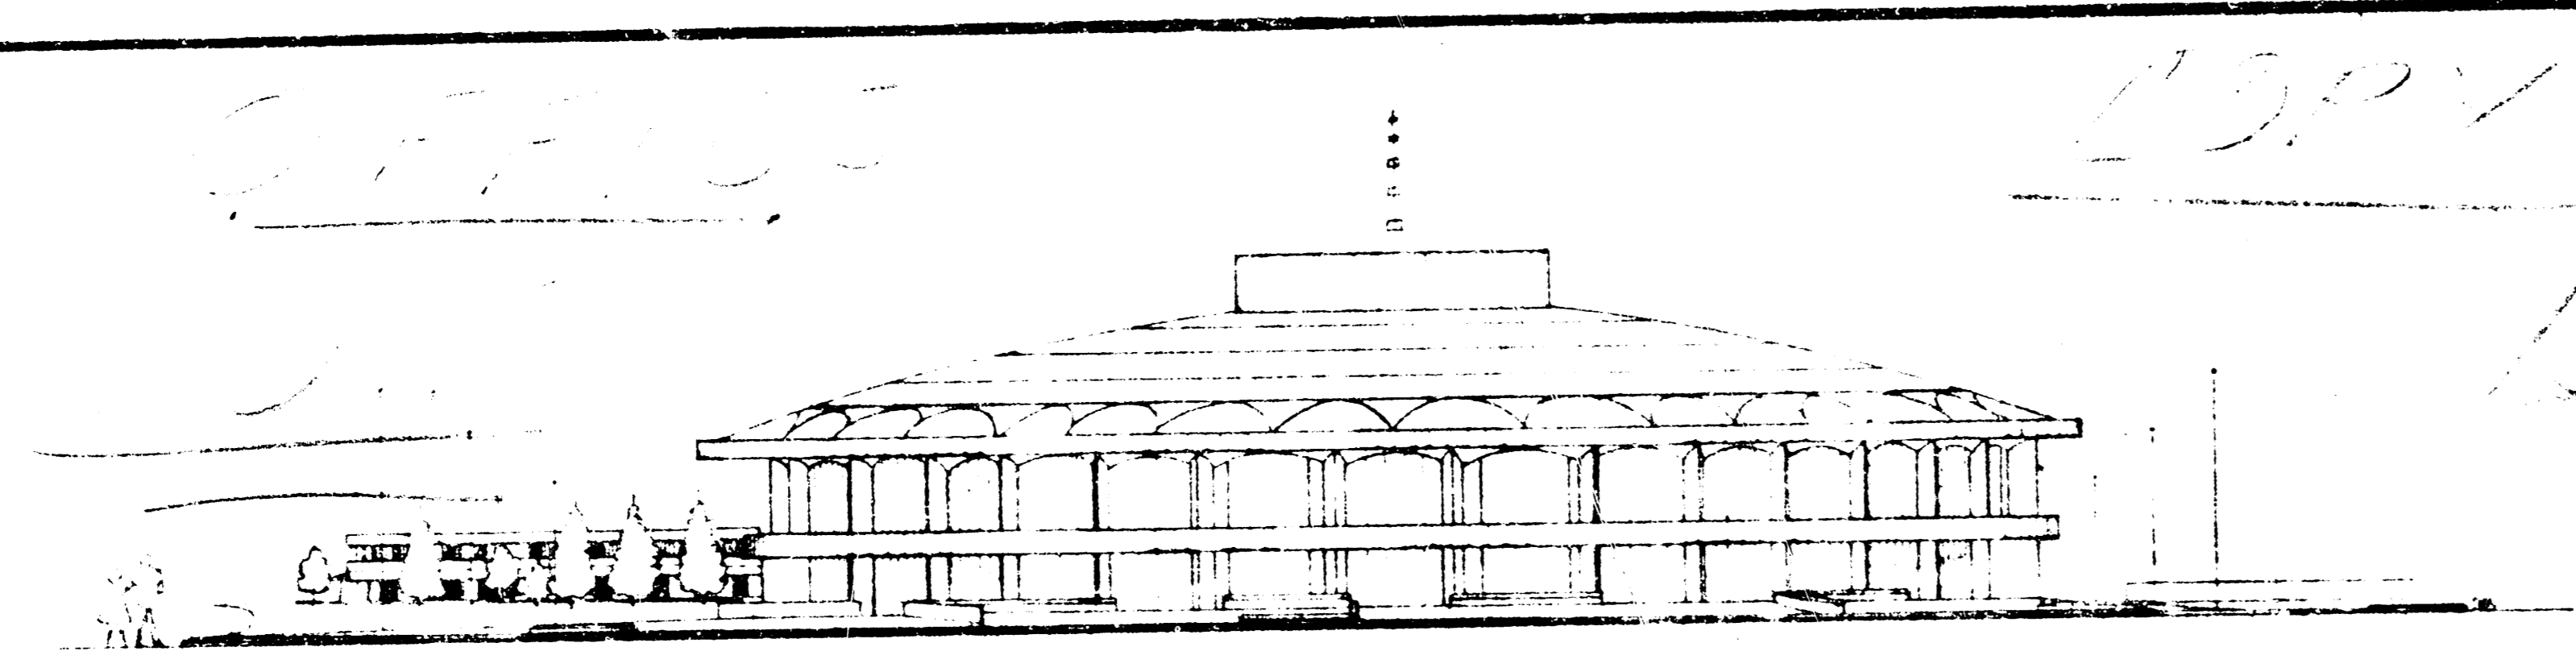

— STREET IMPROVEMENT —

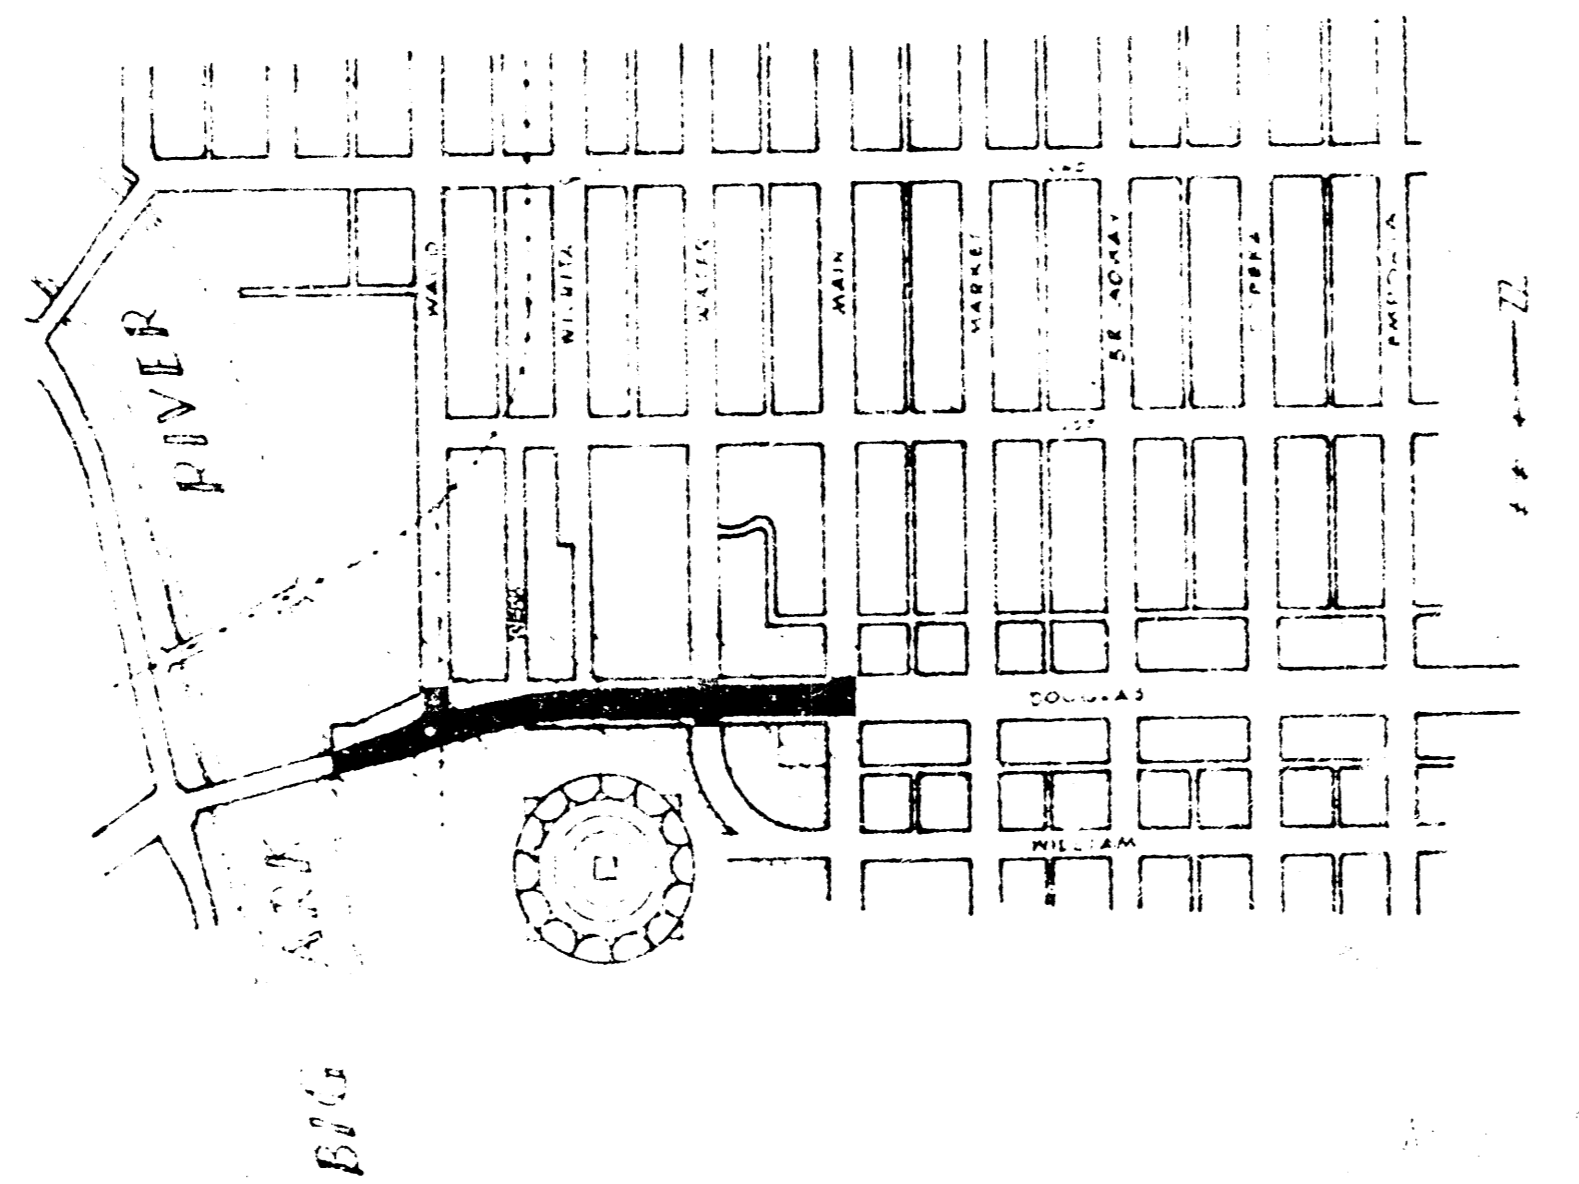




URBAN RENEWAL AGENCY
 of the
 WICHITA, KANSAS METROPOLITAN AREA
 CIVIC CENTER PROJECT - KANSAS R-19
 DOUGLAS AVENUE

DEPARTMENT OF PUBLIC WORKS
 CITY OF WICHITA, KANSAS
 B.E. SMITH CITY ENGINEER
 DRAWING NO. C19-38 #C19-07




1/8

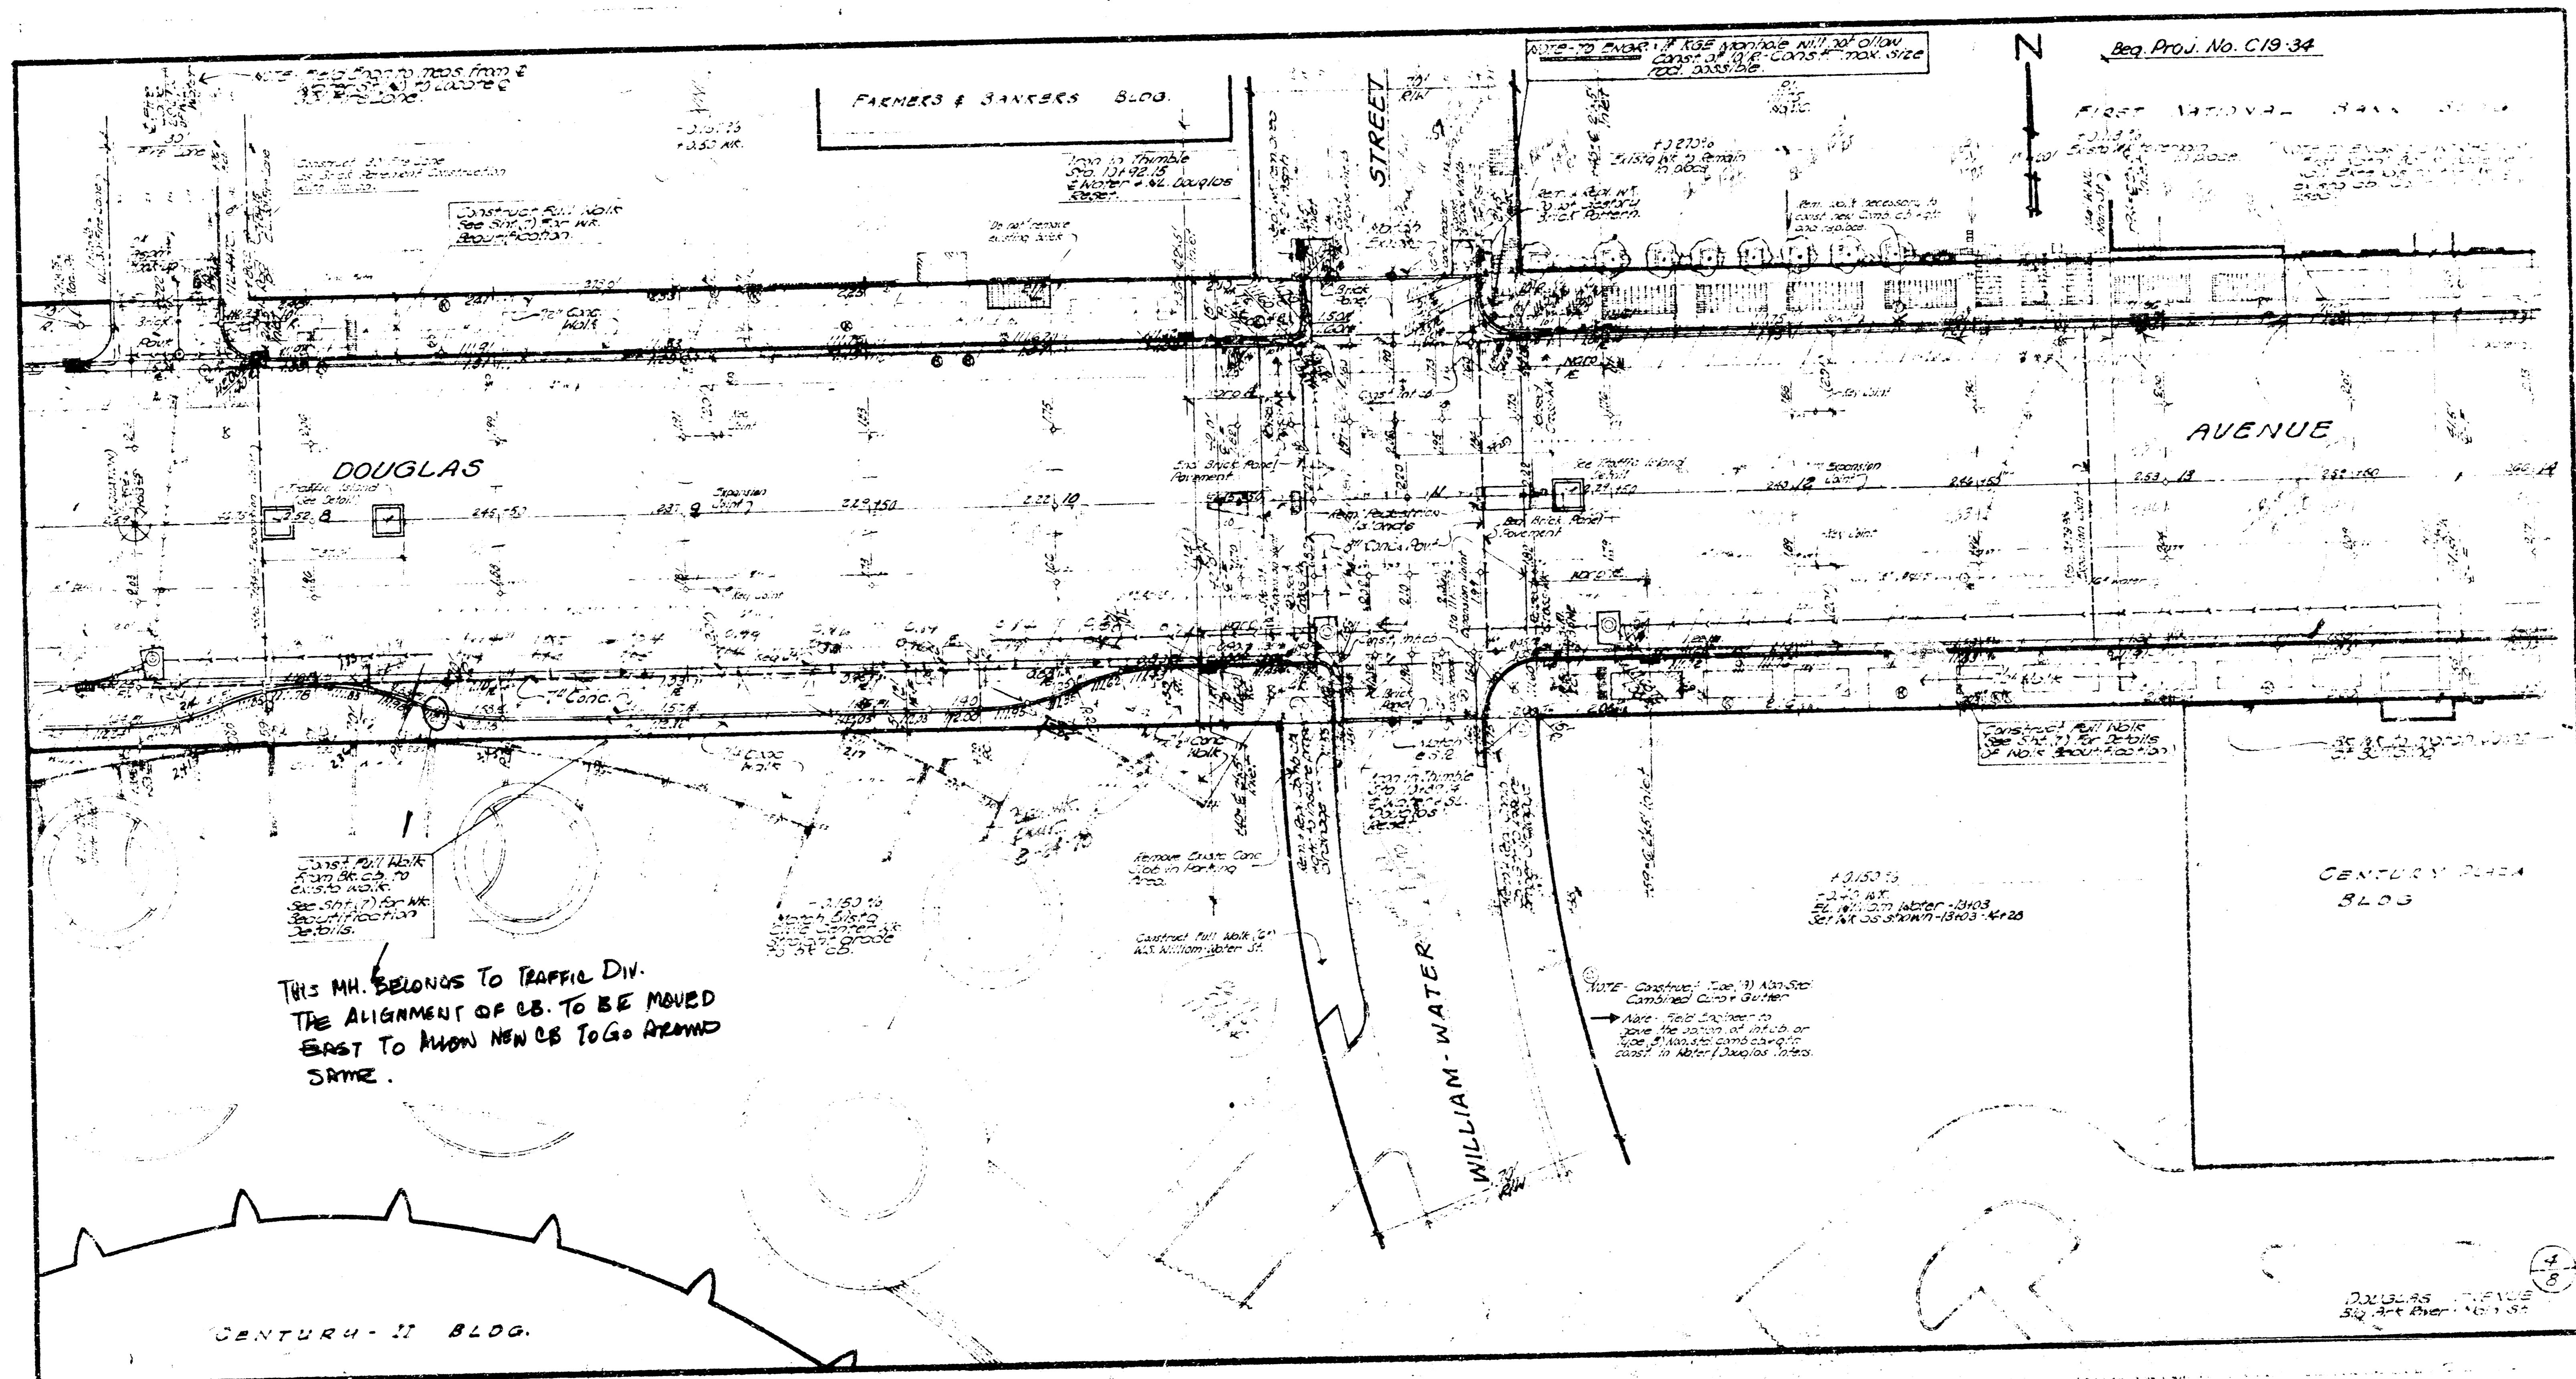

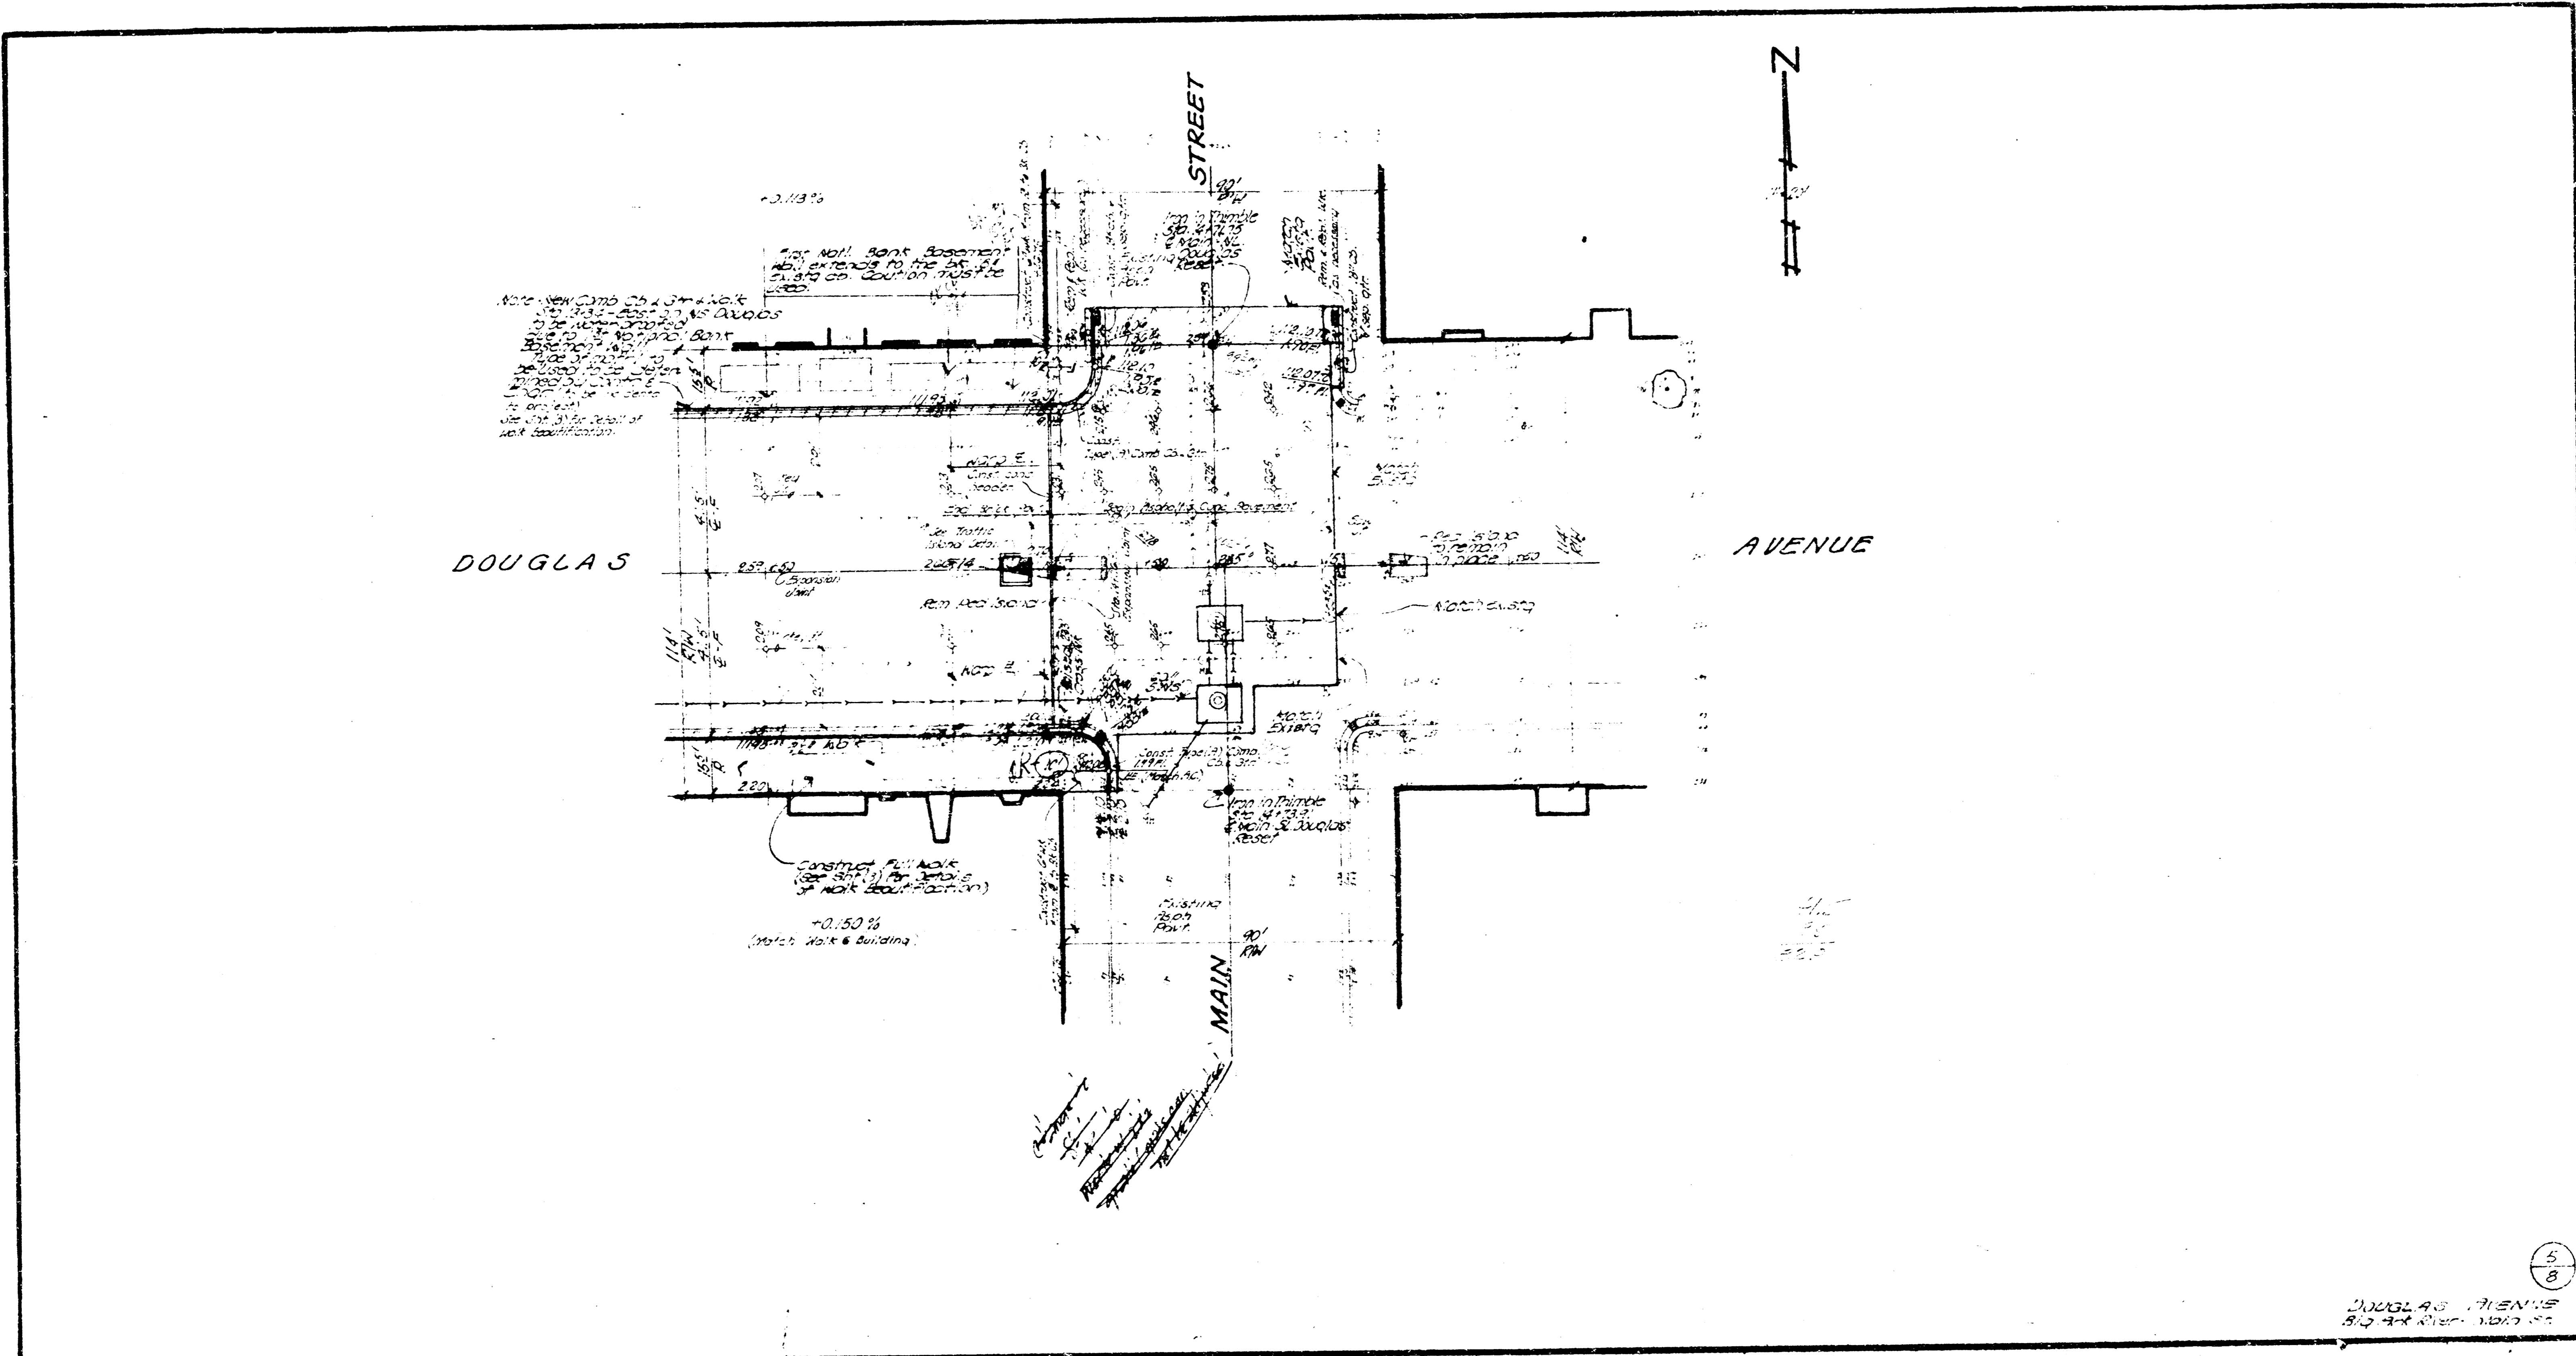

5
8
DOUGLAS AVENUE

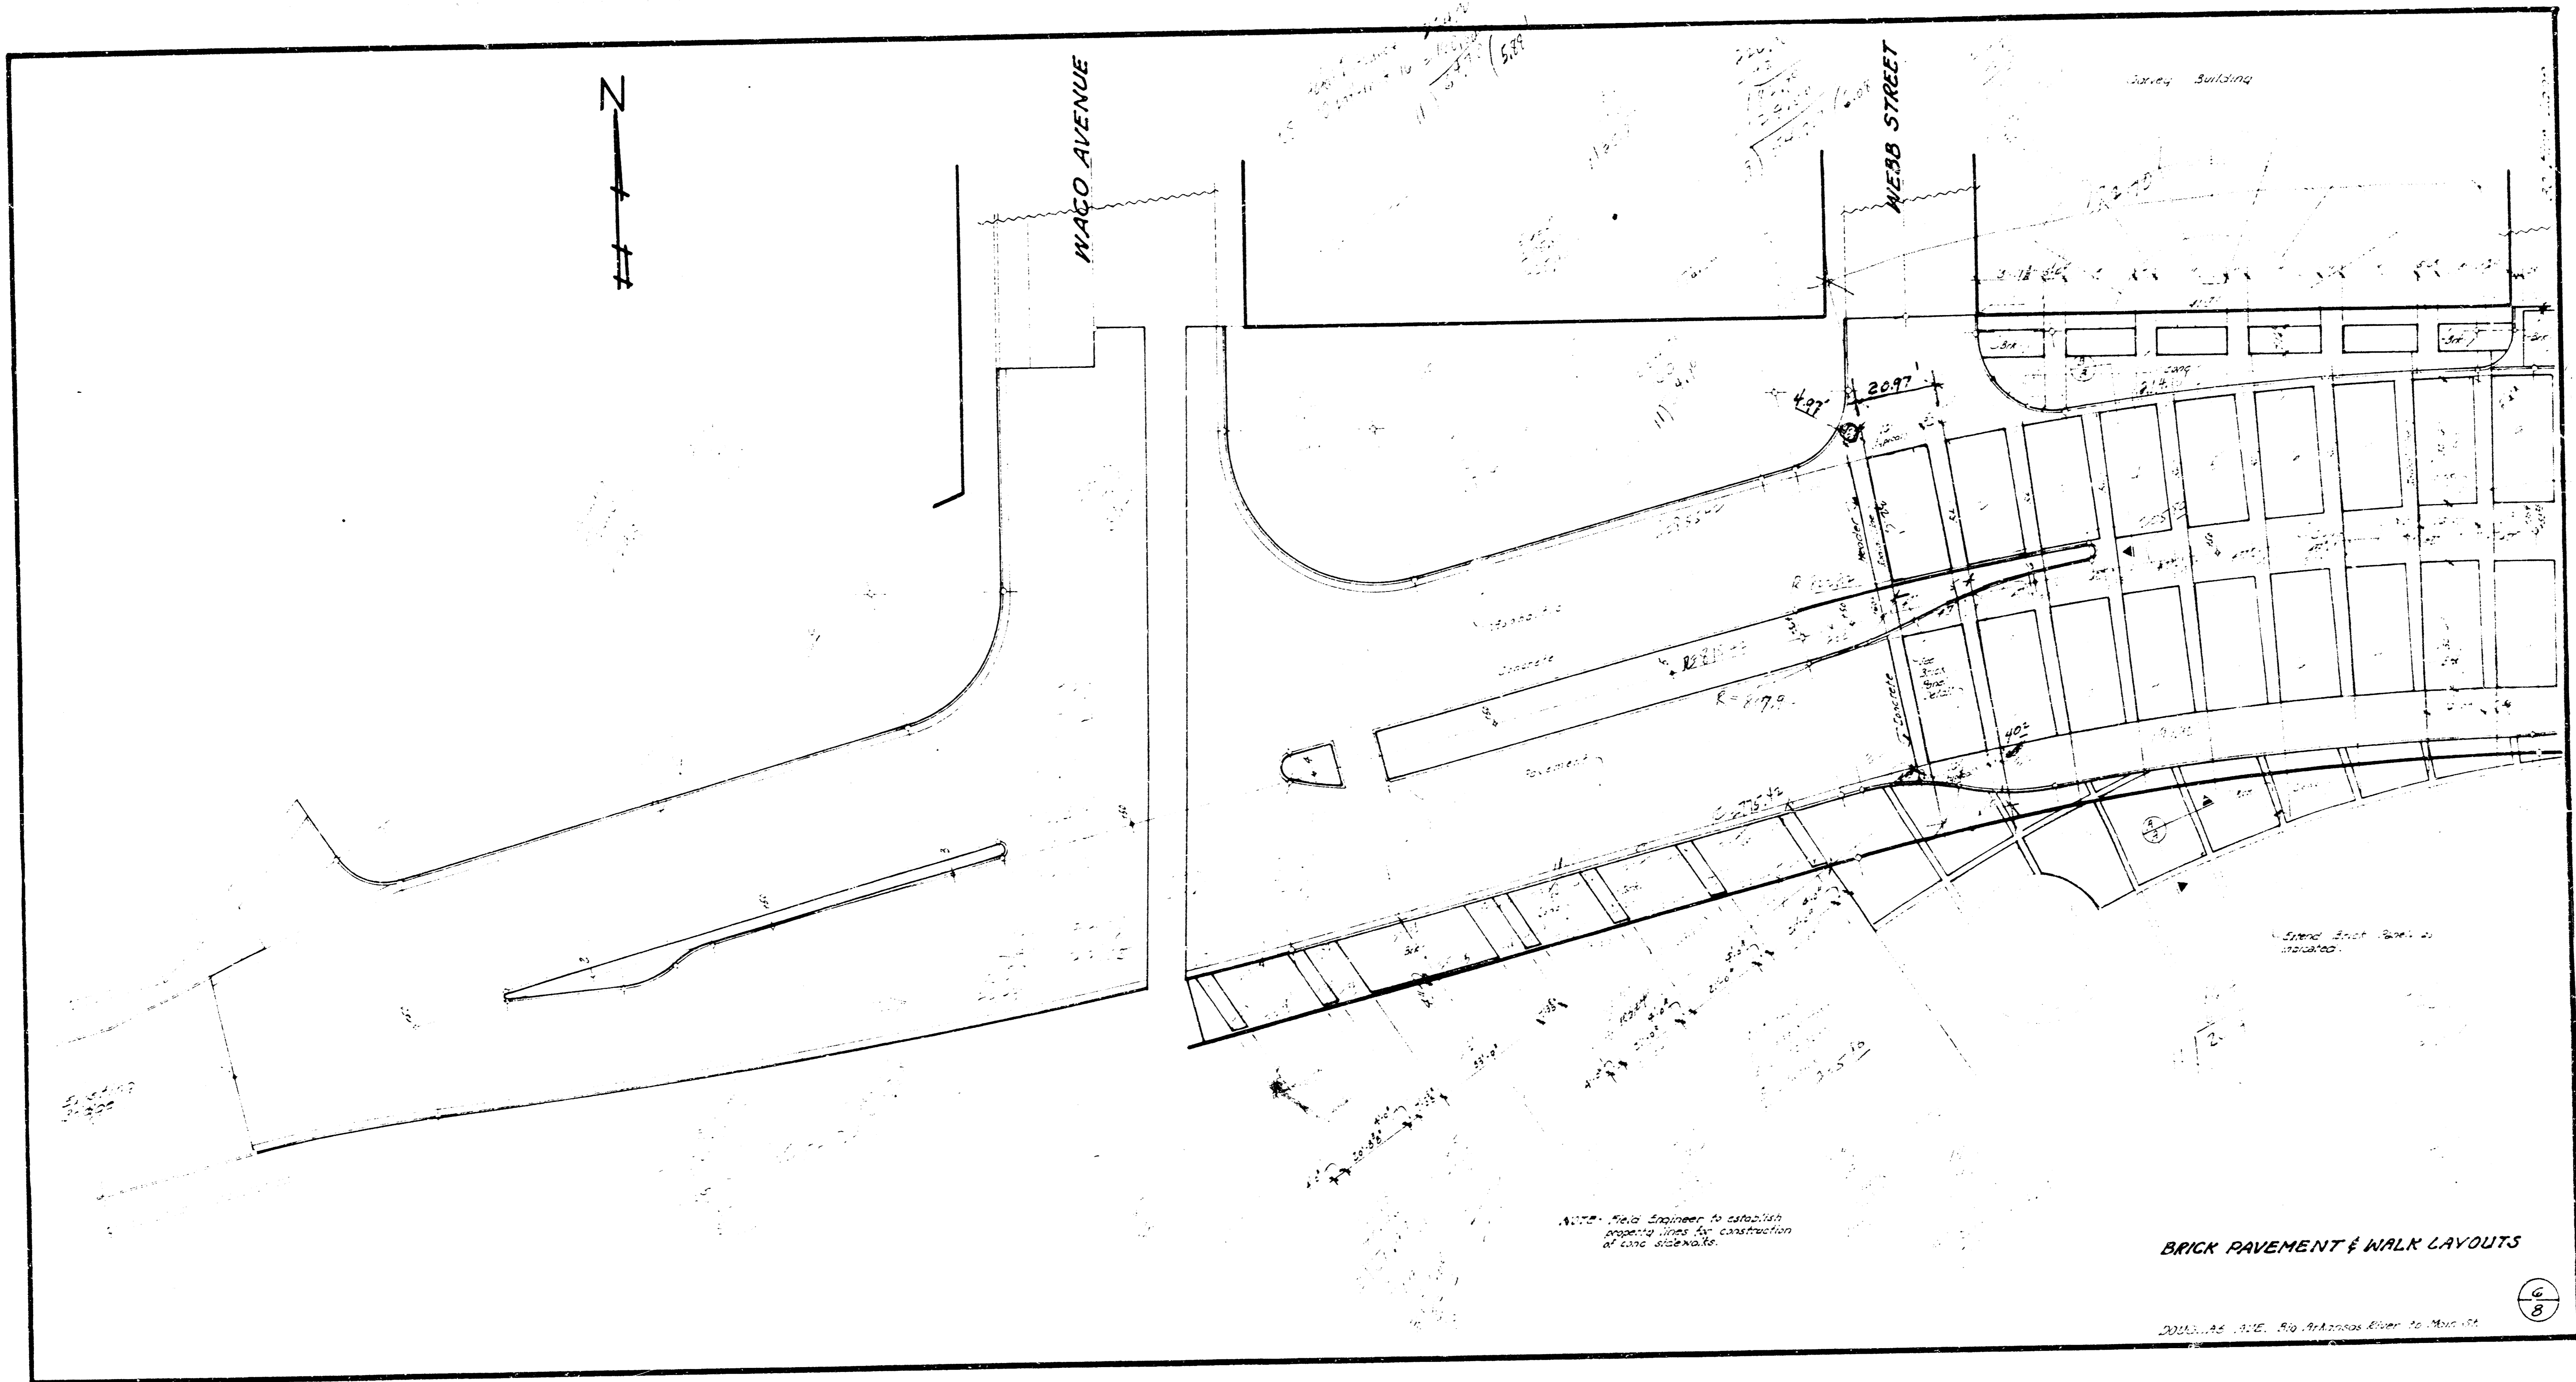







BRICK PAVEMENT & WALK LAYOUTS




6/8

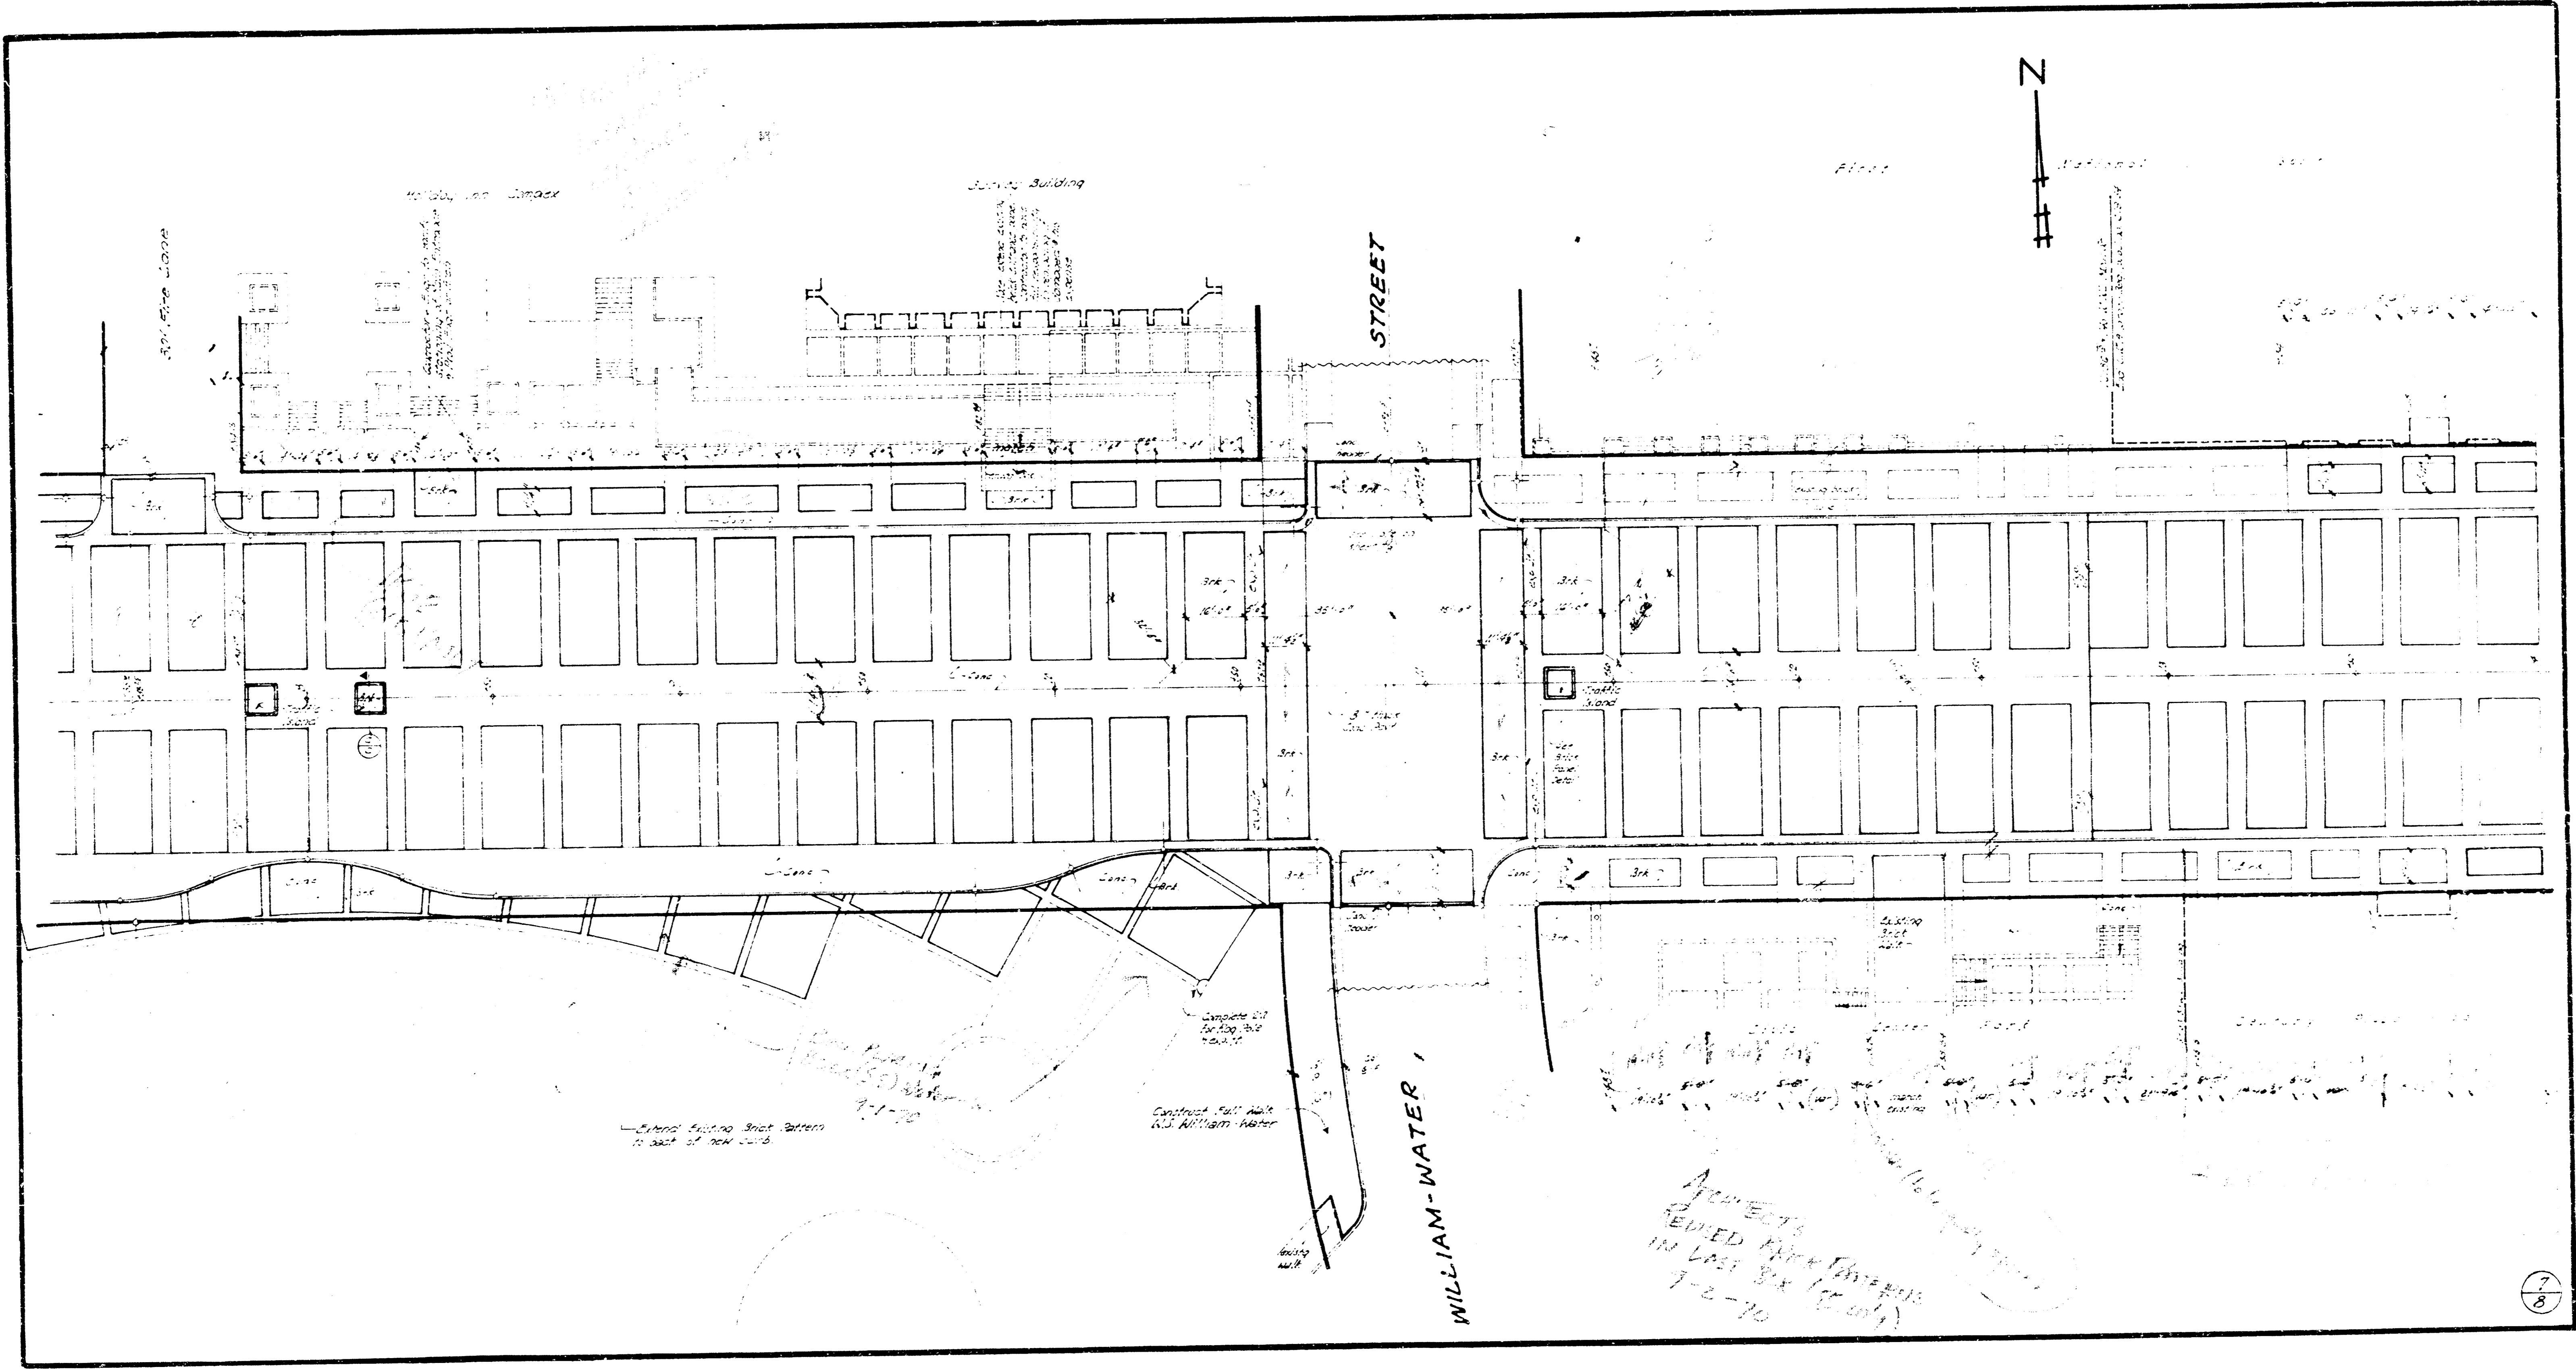


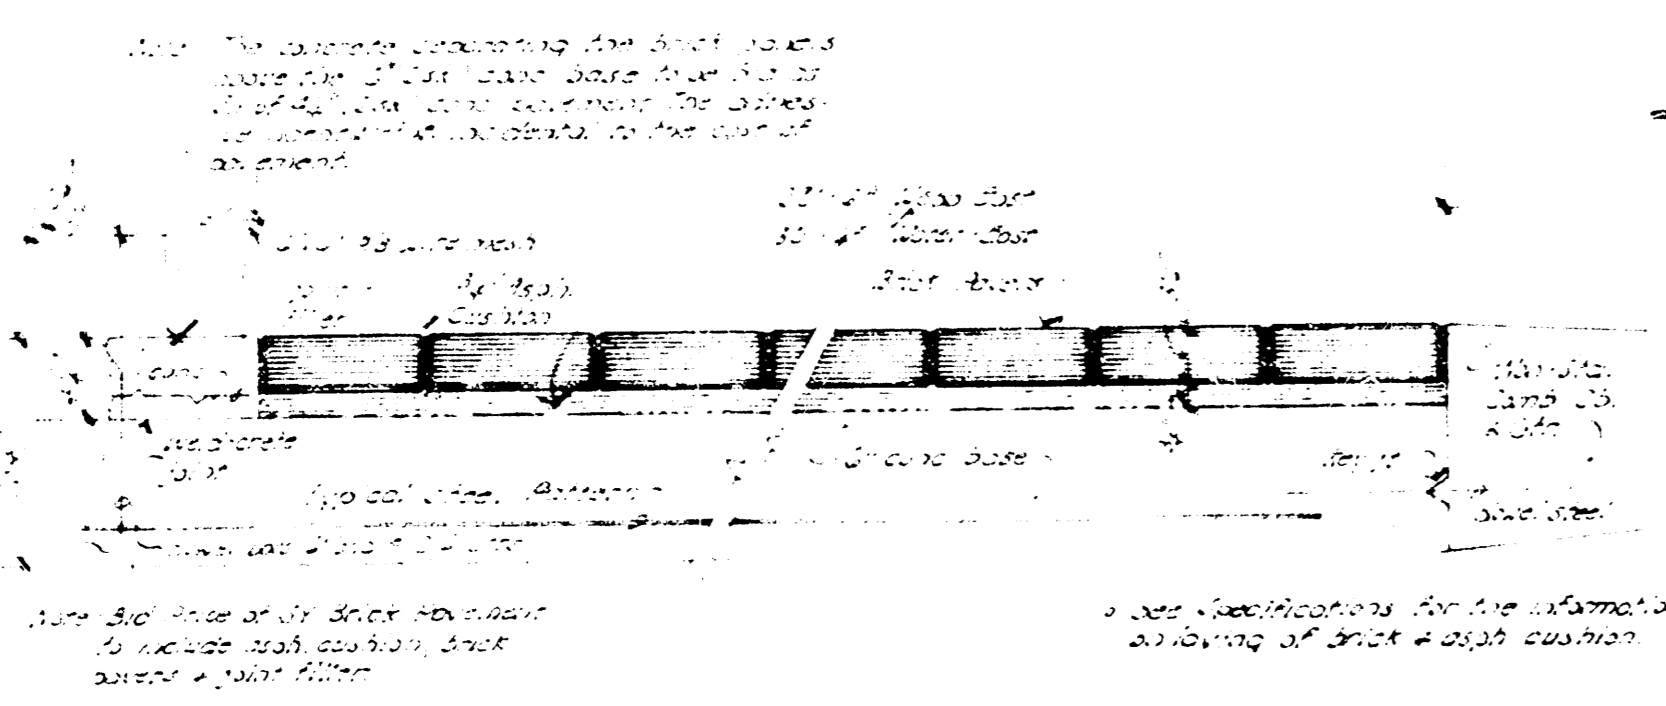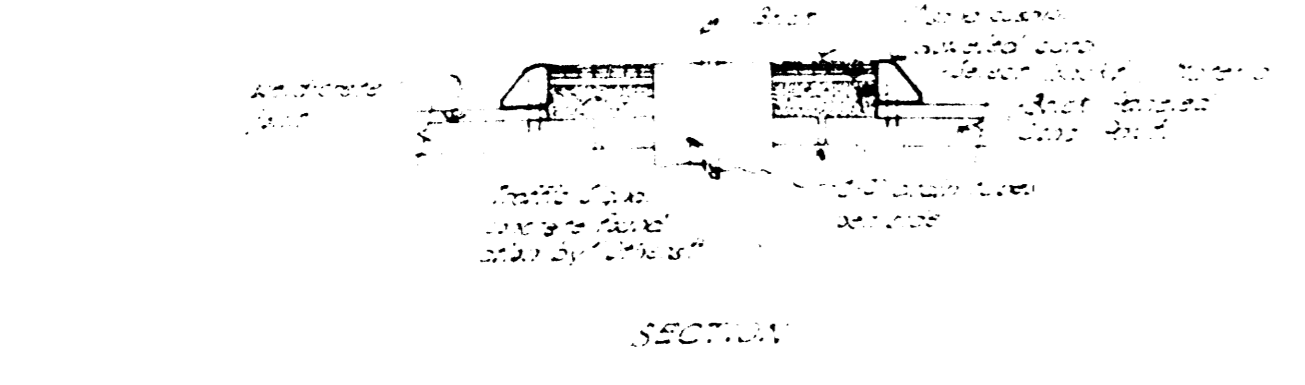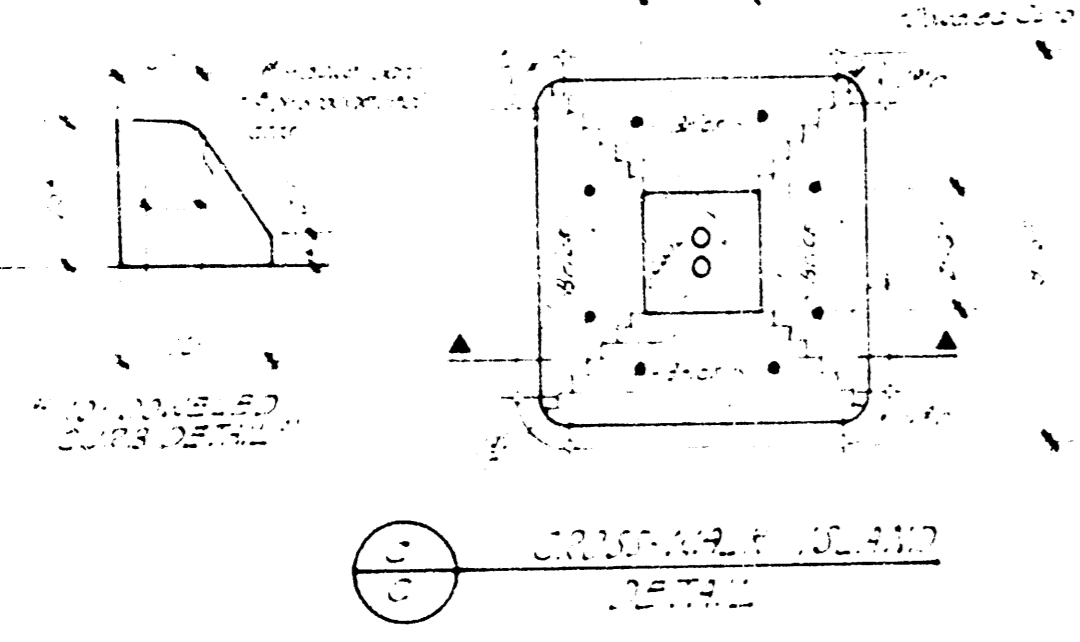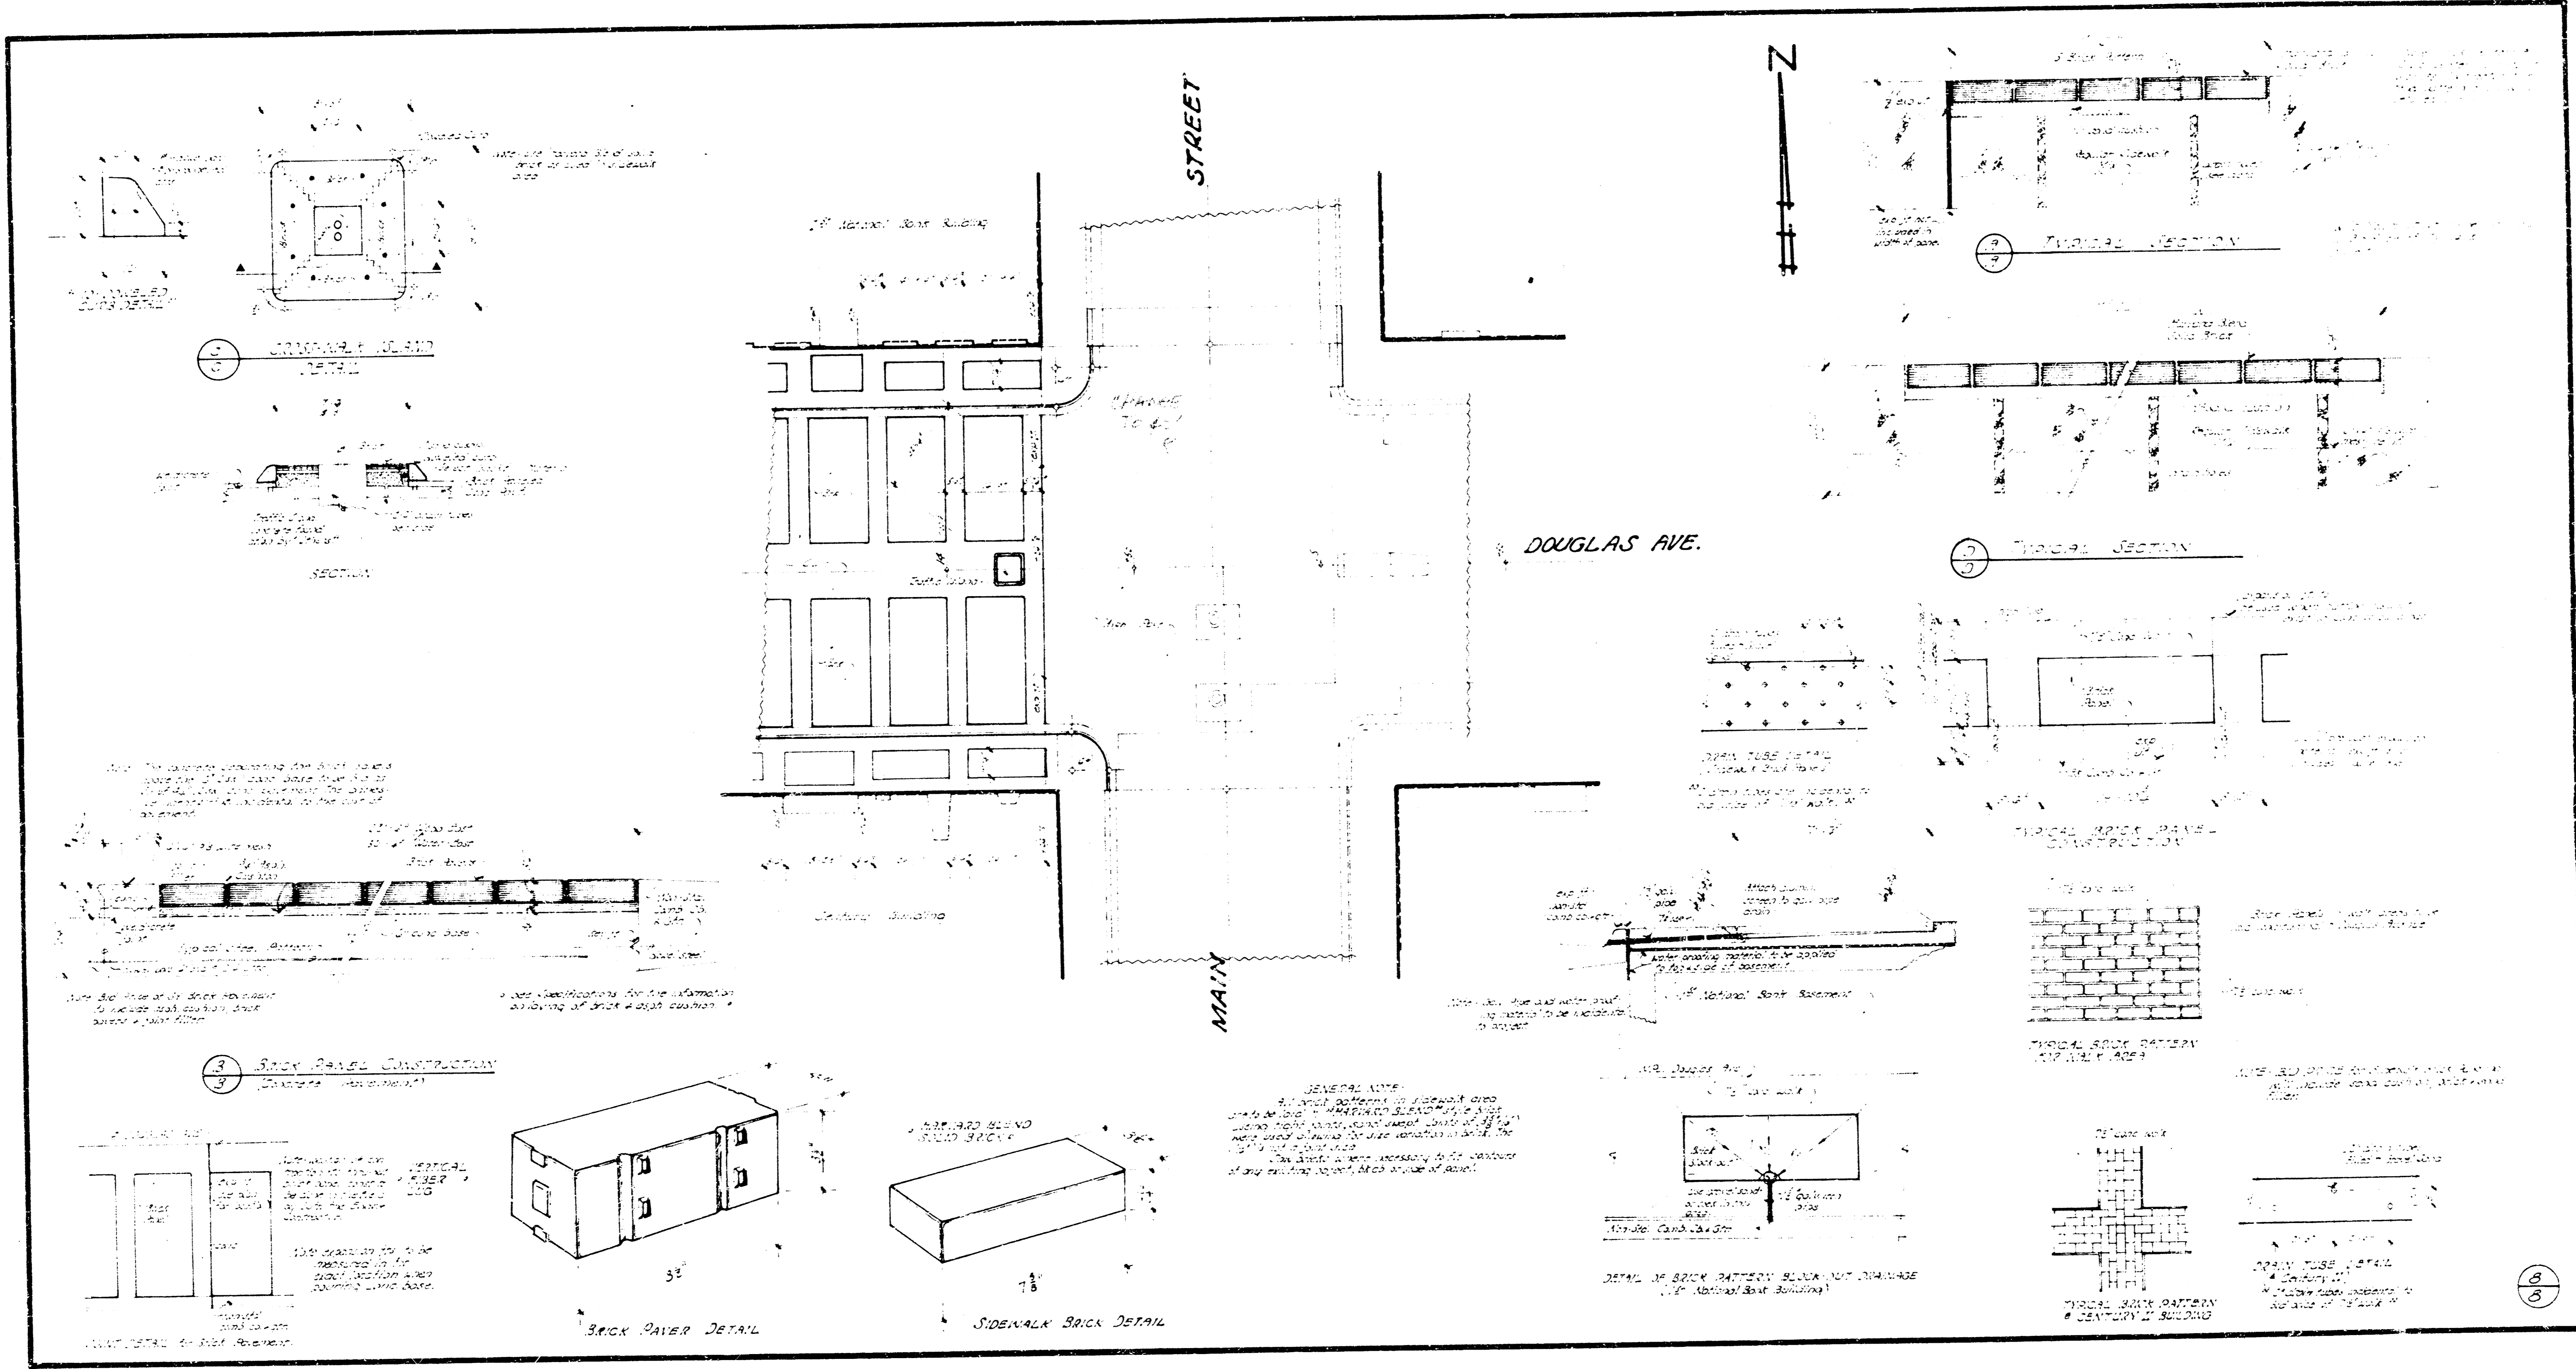


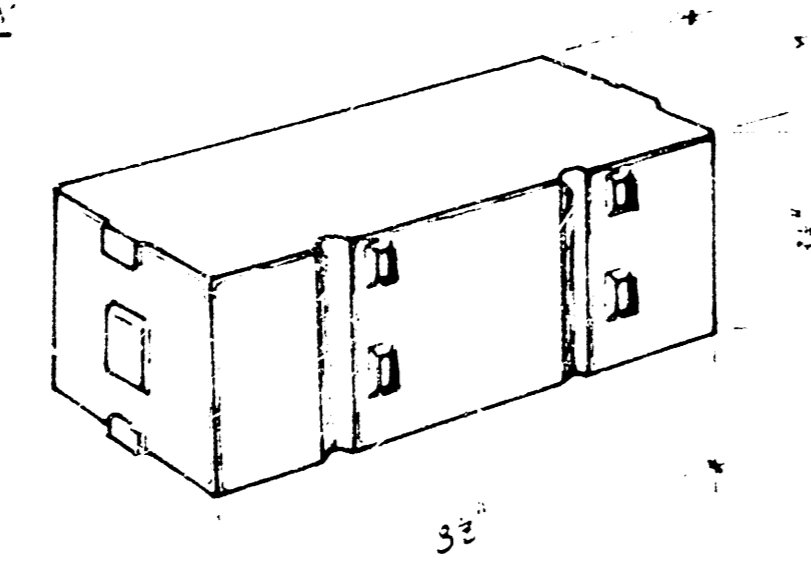
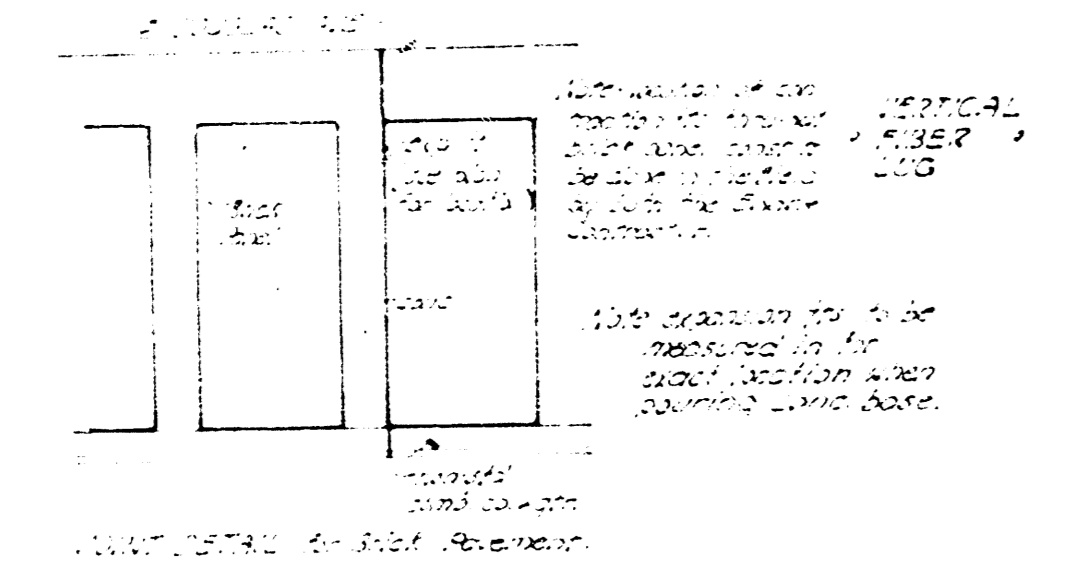



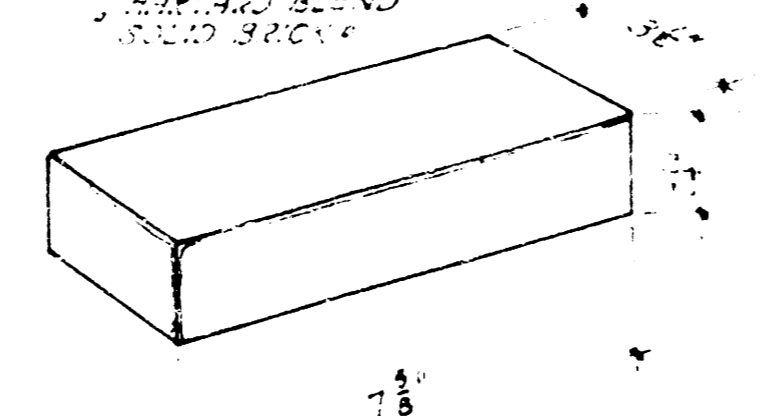


SIDEWALK BRICK DETAIL


GENERAL NOTE:


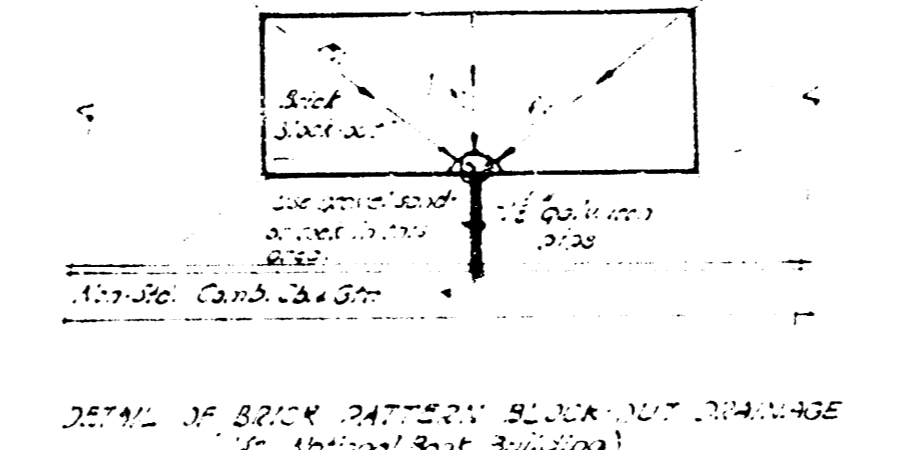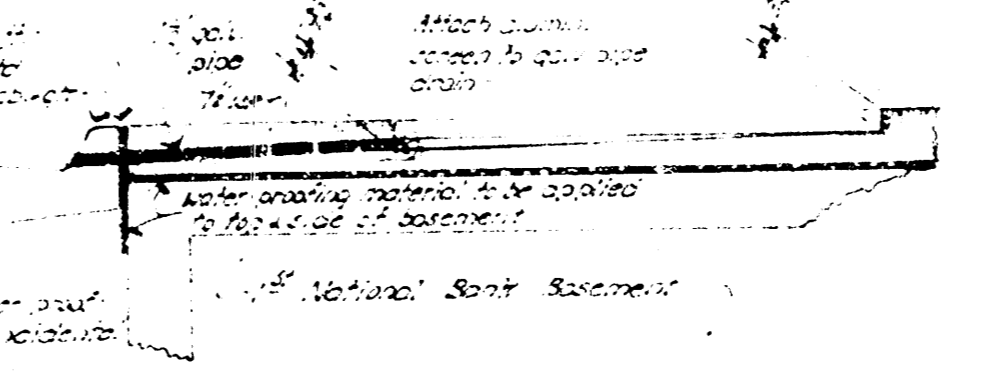


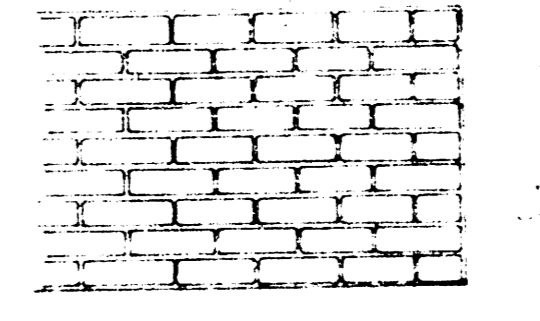

TYPICAL BRICK PATTERN

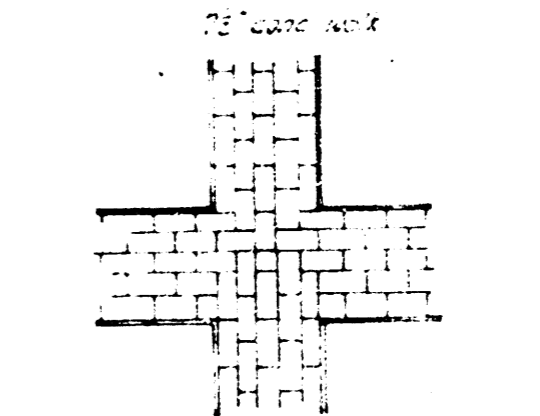

TYPICAL BRICK PATTERN

8