


BM 14611 Top S. Bolt W. Hubward SS Bridge on Eastern Avenue.
 Stationing on a line 3000' W of E.L. Eastern Avenue.

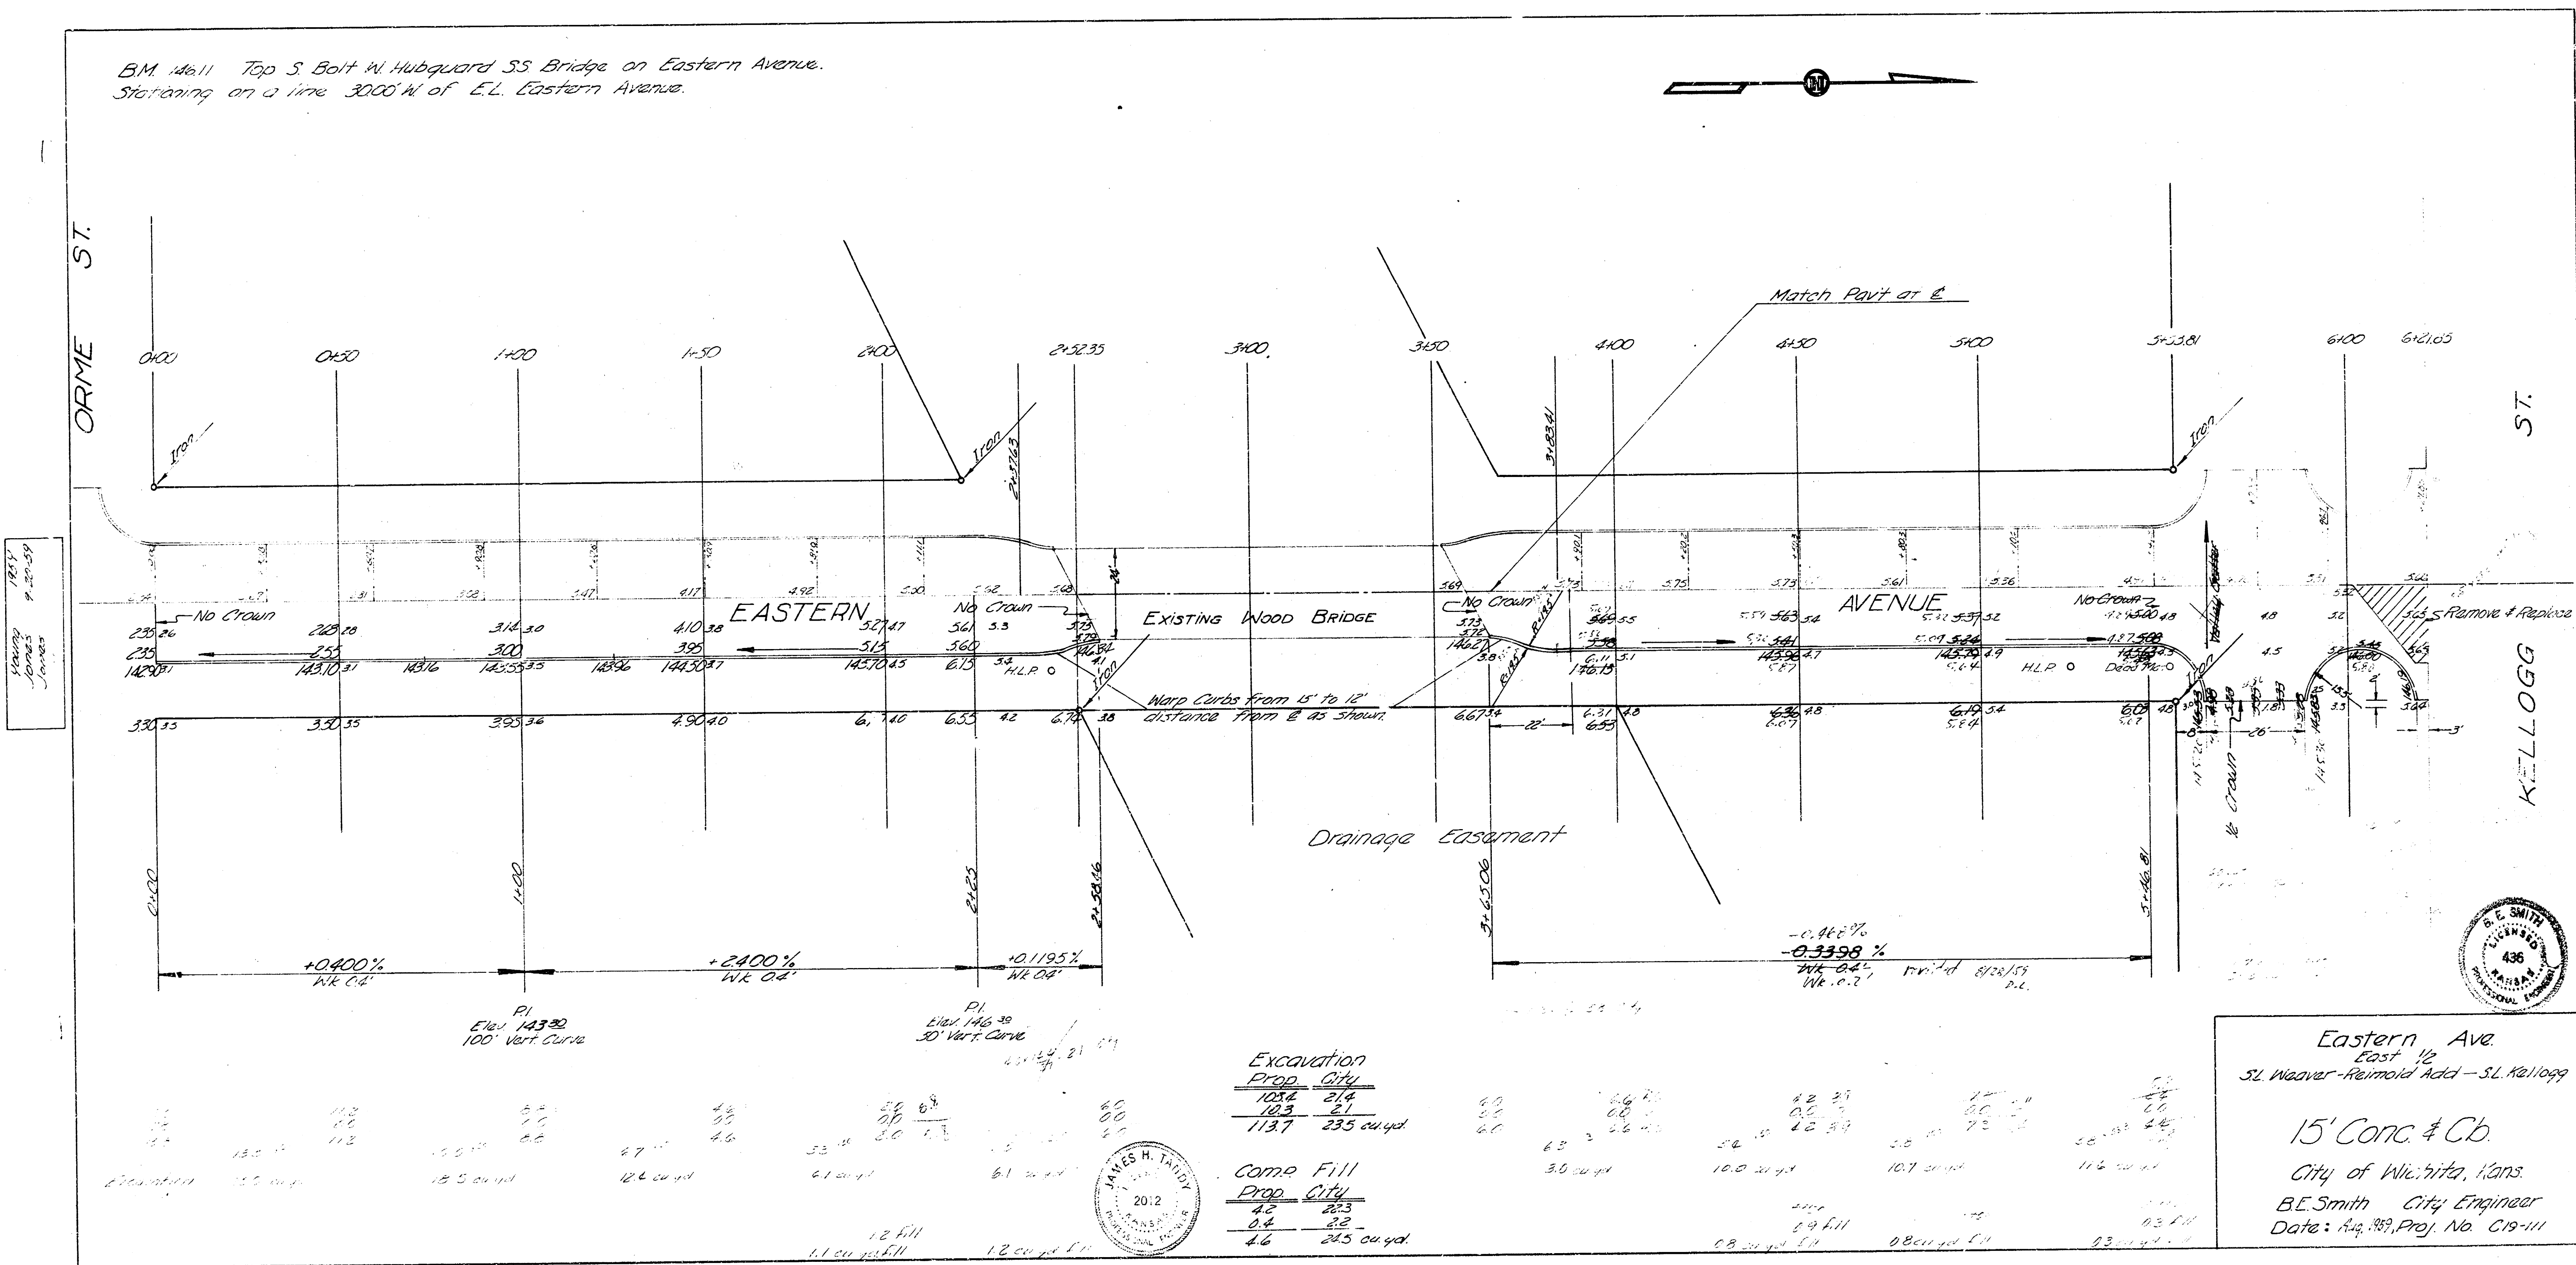




Eastern Ave.
 East 1/2
 SL Weaver-Reinhold Add - SL Kellogg
 15' Conc & Cb.
 City of Wichita, Kans.
 B.E. Smith City Engineer

Excavation	
Prop.	Qty.
103	2.1
113.7	235 cu yd.

Comp. Fill	
Prop.	Qty.
4.2	2.3
0.4	2.2
4.6	235 cu yd.

