



B.M. 164.50 "R" in Ritchie E.L. Capri N. Co. Zimmerly
 B.M. 164.77 "R" in Ritchie Top Ch. E. end radi. N.E. Cor. Zimmerly & Rosalia
 B.M. 155.31 "R" in Ritchie E.L. Capri S. Co. Bayley

Final Quantities

Units	Quantities	Total
S.Y.	Pavement	1,201.0
L.F.	Comb. Obs. Str.	1,083.3
L.F.	Sep. C.C.	188.9
S.F.	Sep. Bit.	1,322.2
S.F.	6" Drive	1,155.8
Lbs.	Rein. Steel	4,840
C.Y.	Excav.	1,985.3

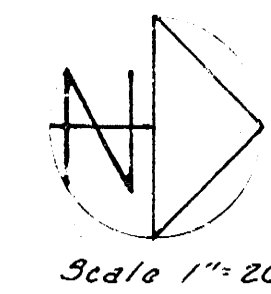

Units	Quantities	Total
S.Y.	Pavement	1,201.0
L.F.	Comb. Obs. Str.	1,083.3
Lbs.	Rein. Steel	4,840
C.Y.	Excavation	1,985.3

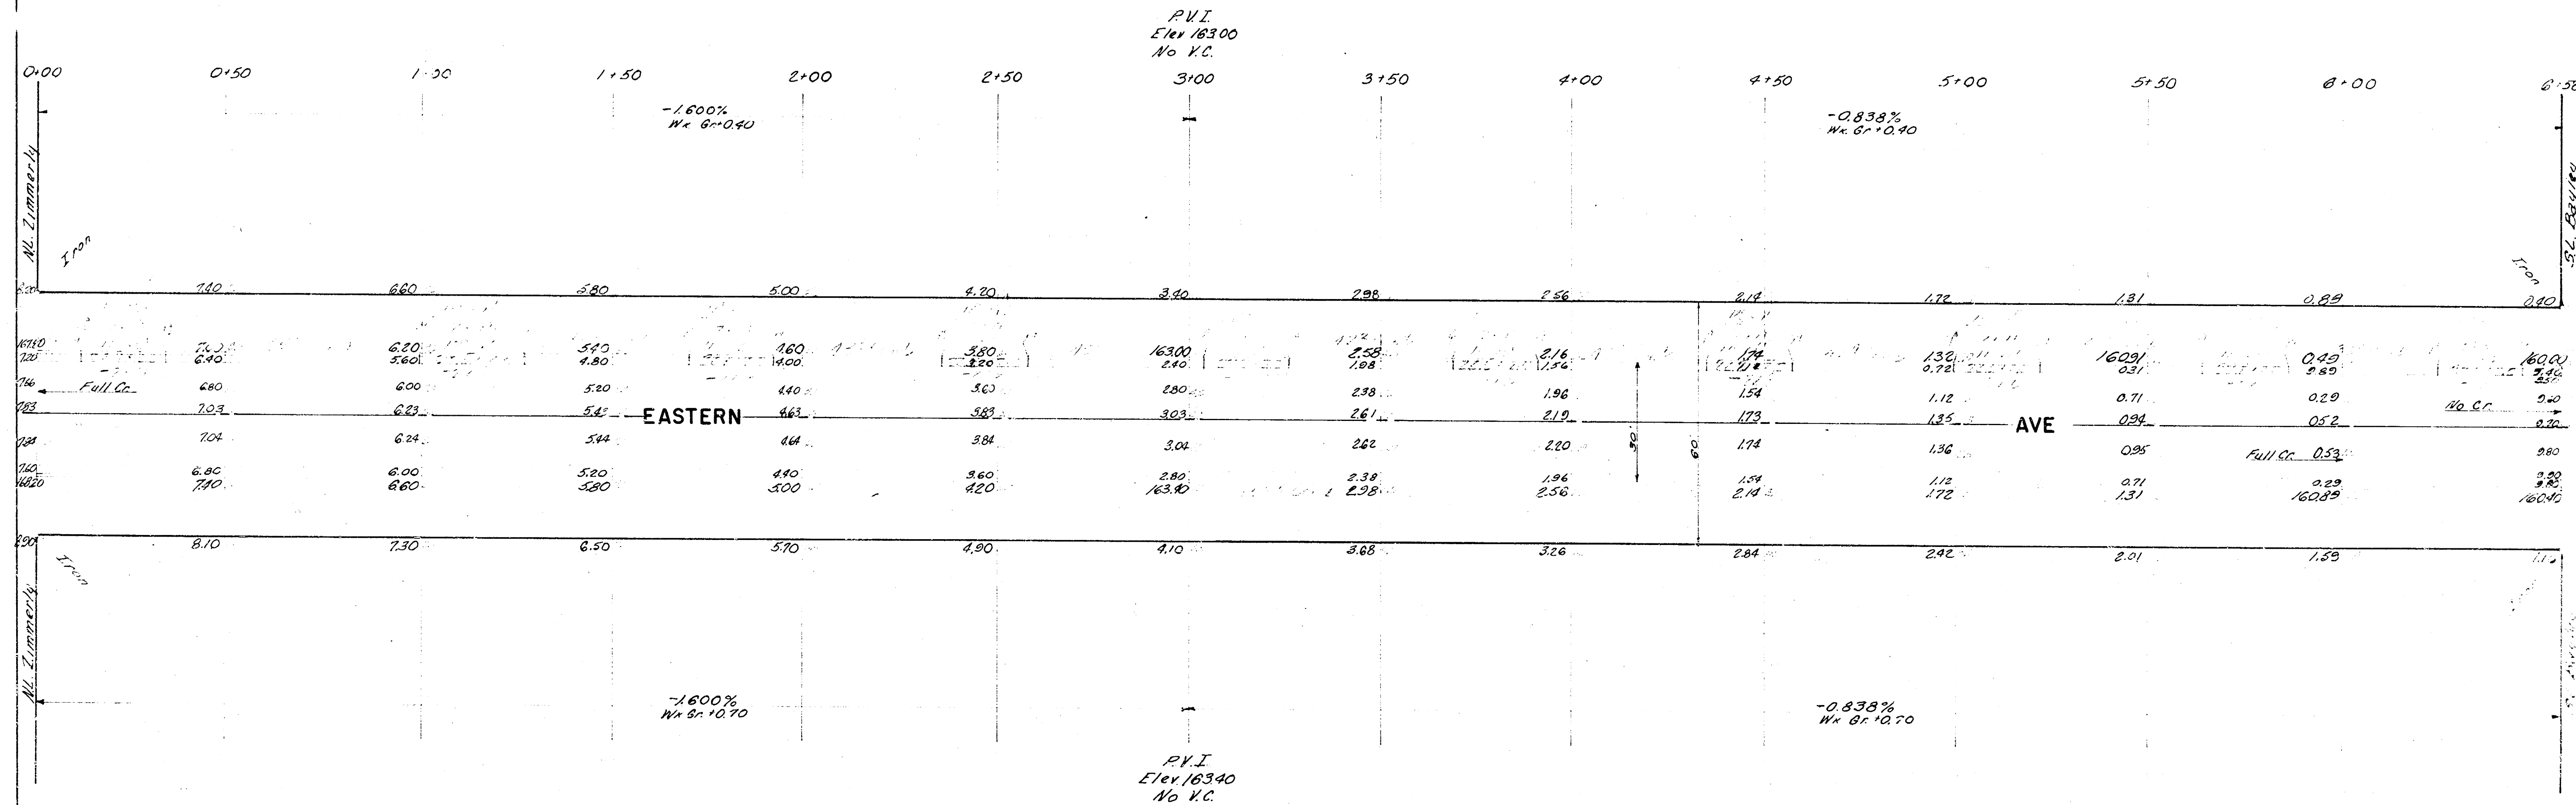

EASTERN AVE.
 N.L. ZIMMERLY S.L. BAYLEY

26' - 2' - 30' A.C.

CITY OF WICHITA, KANSAS
 B.E. SMITH CITY ENGINEER
 DATE PRIVATE JOB