
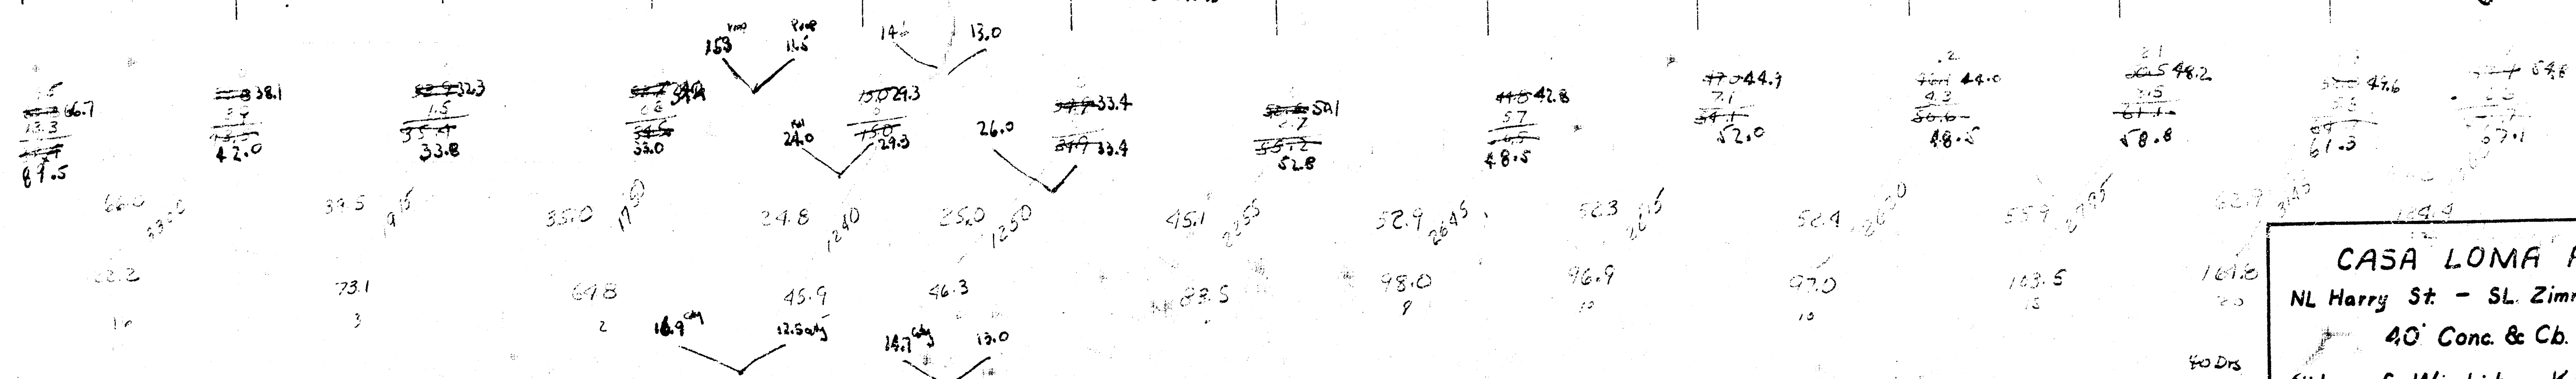



BM 146.89 Standard SW Edgemoor & Harry.
 BM 151.62 NW cor. conc. porch, Hts. 1202 SE Casa Loma & Harry.

Total
 City 2347
 Prep 1120.9
 3467.9
 0.3802
 0.4163%
 0.371%

NOTE: Quarter point elevations are construction grades for keyed joints.

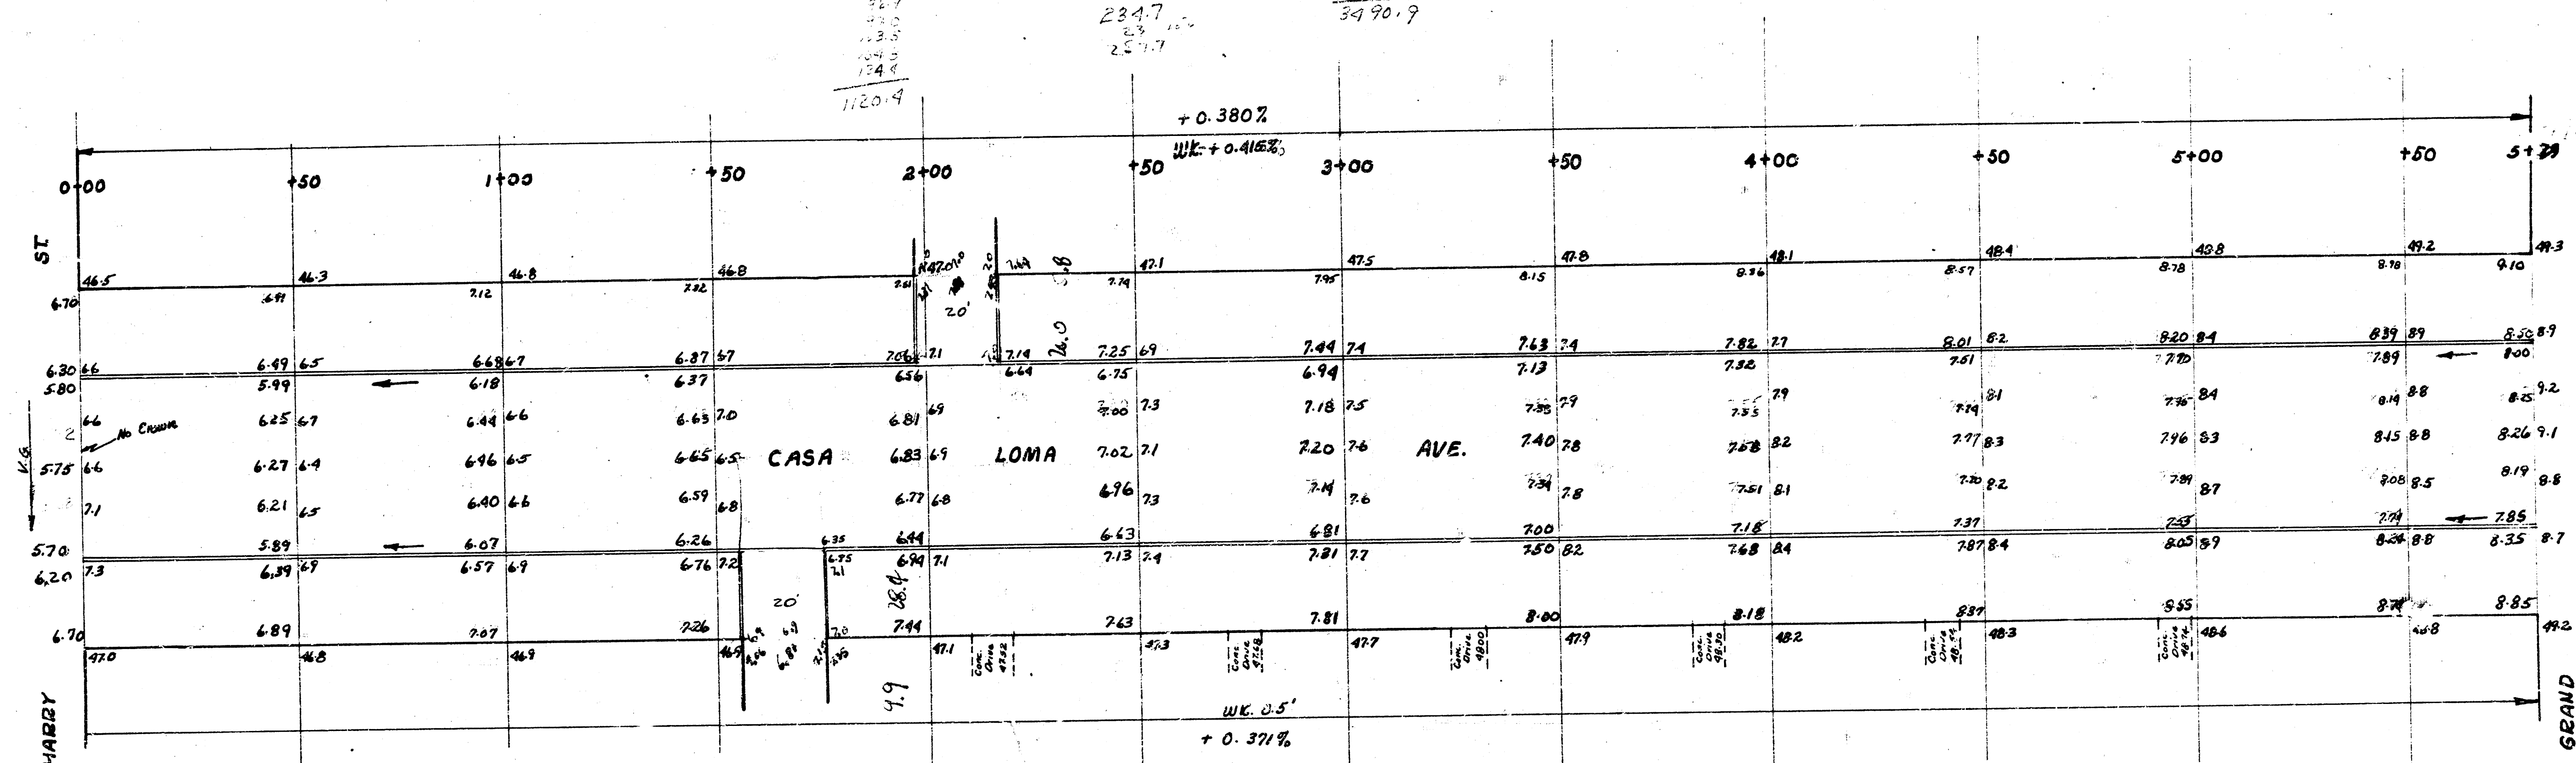

CASA LOMA AVE.
 NE Harry St. - SL Zimmerly St.
 40' Conc. & Cb.
 City of Wichita, Kansas
 L. K. White City Engineer
 Sept. 1950 Proj. No. C10-142.

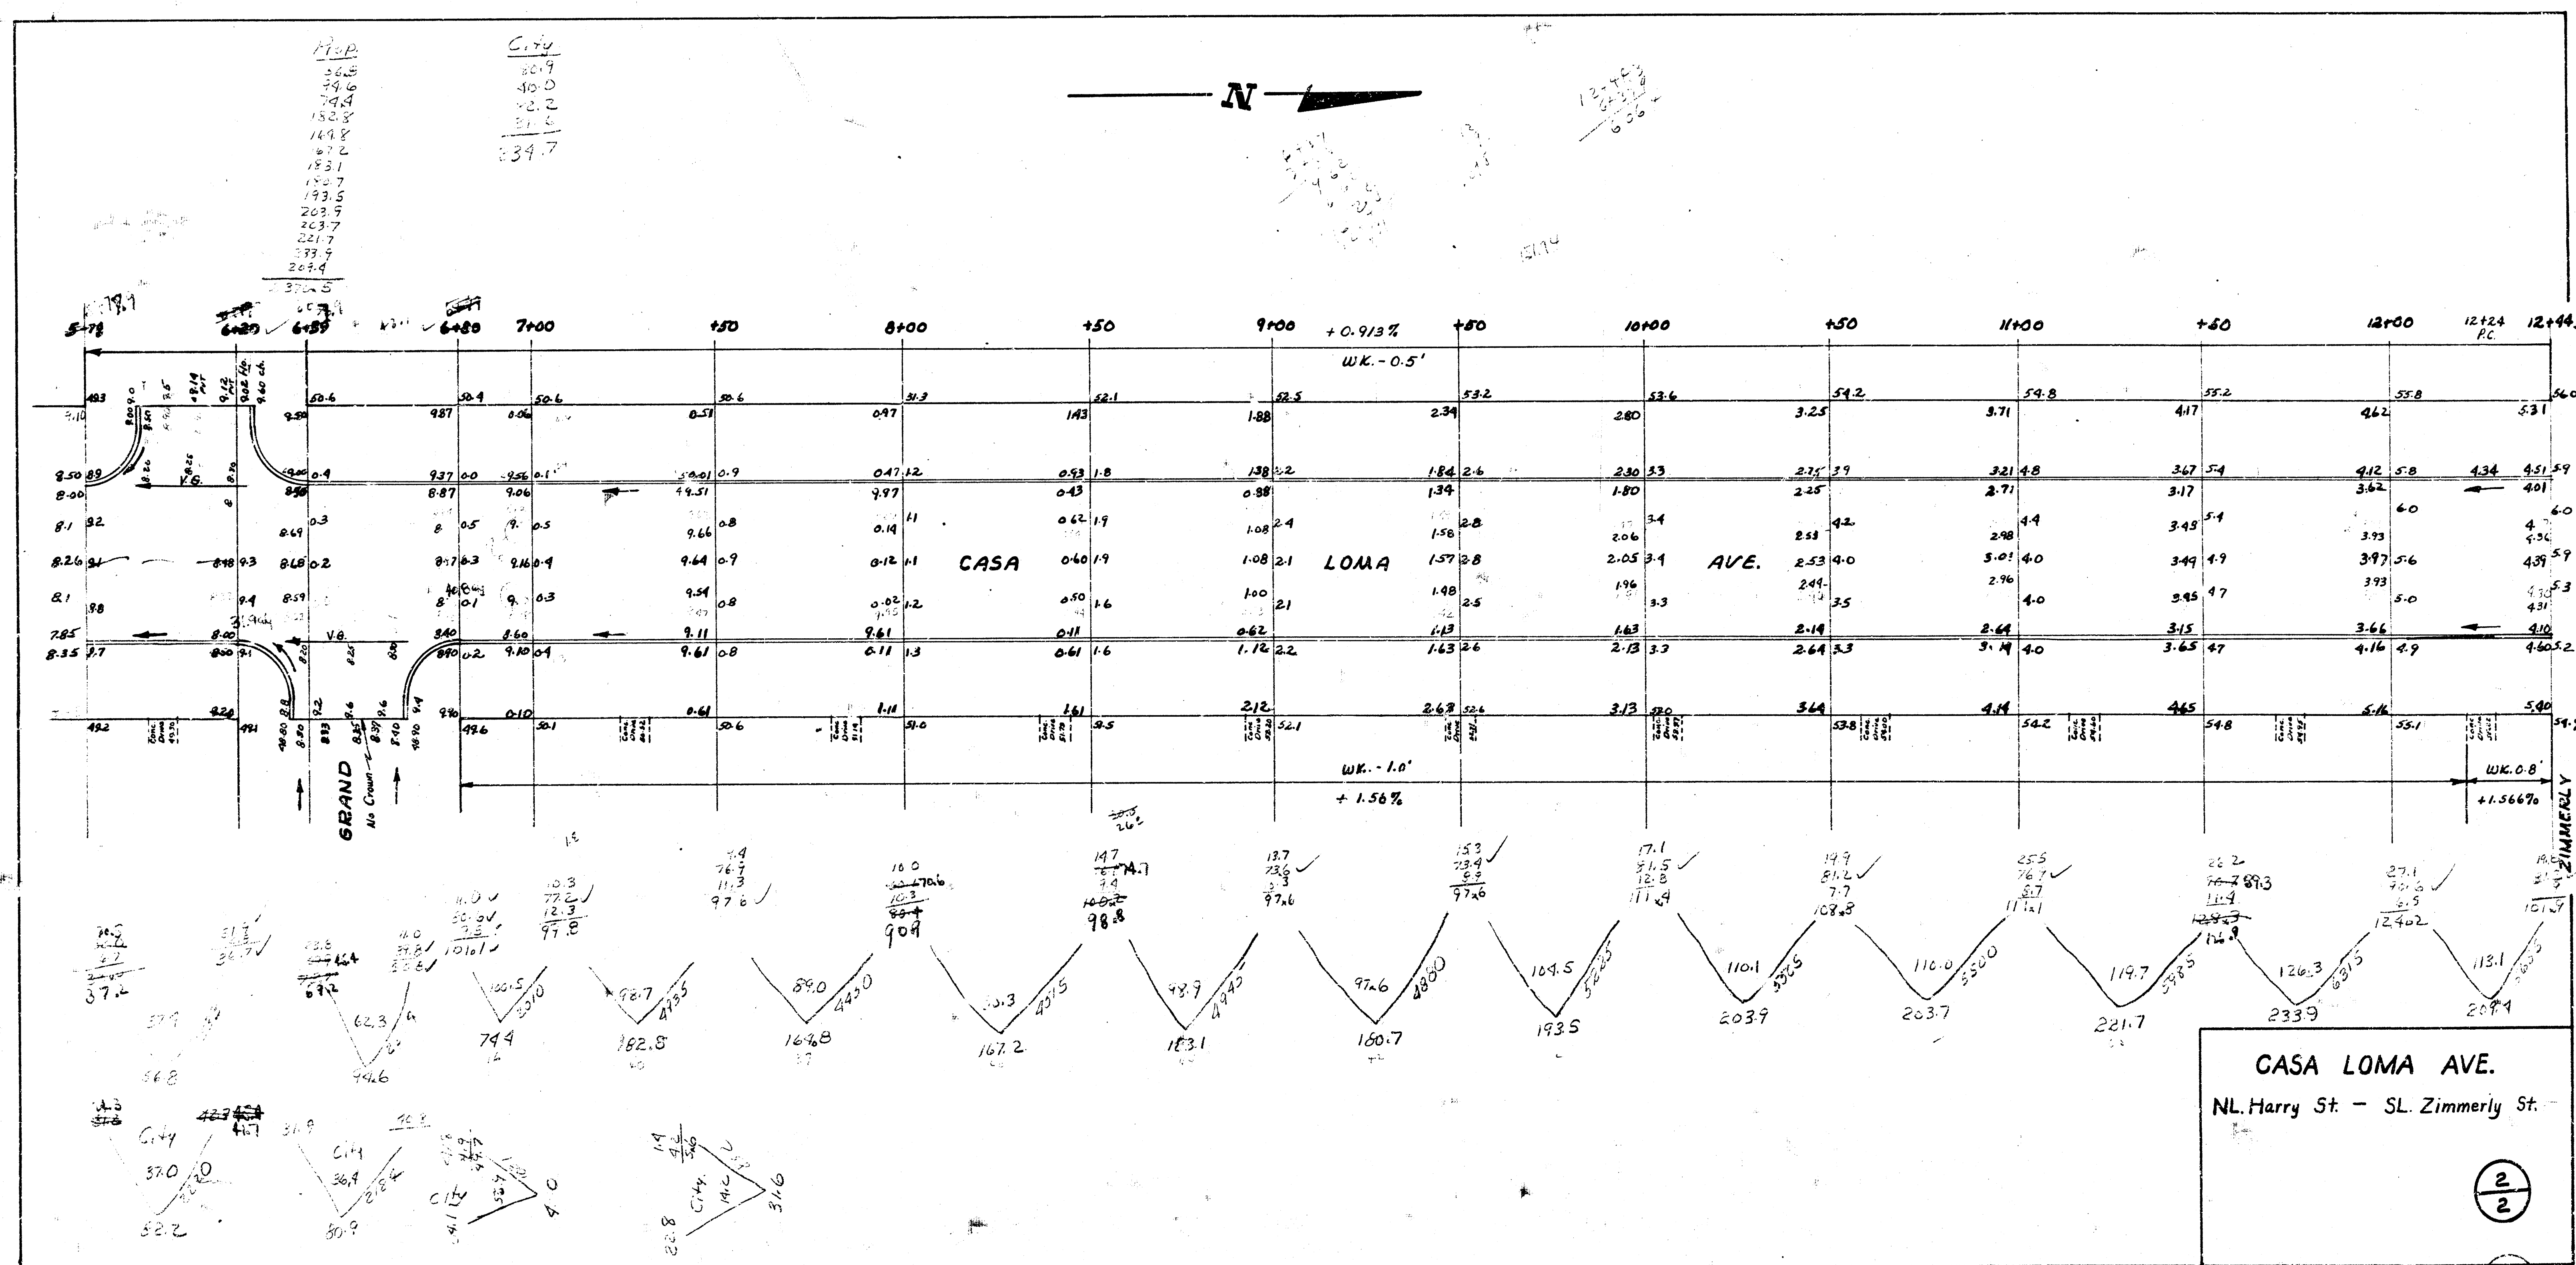

CASA LOMA AVE.
NL. Harry St. - SL. Zimmerly St.

2
2

4 2 2 50