B.M. 1172.0 "G" IN GLOBE N. END NW. RAD. EDWARDS & ST. LOUIS
B.M. 1172.89 "G" IN GLOBE E. END SE. RAD. GORDON & ST. LOUIS
BM 1172.60 "G" IN GLOBE E. END S.E. RAD. NEWELL & EDWARDS

STA ON E

NOTE: CROSS SECTIONS FROM STA 2+00 TO 3+50 TO BE TAKEN IN FIELD WHEN JOB IS STAKED

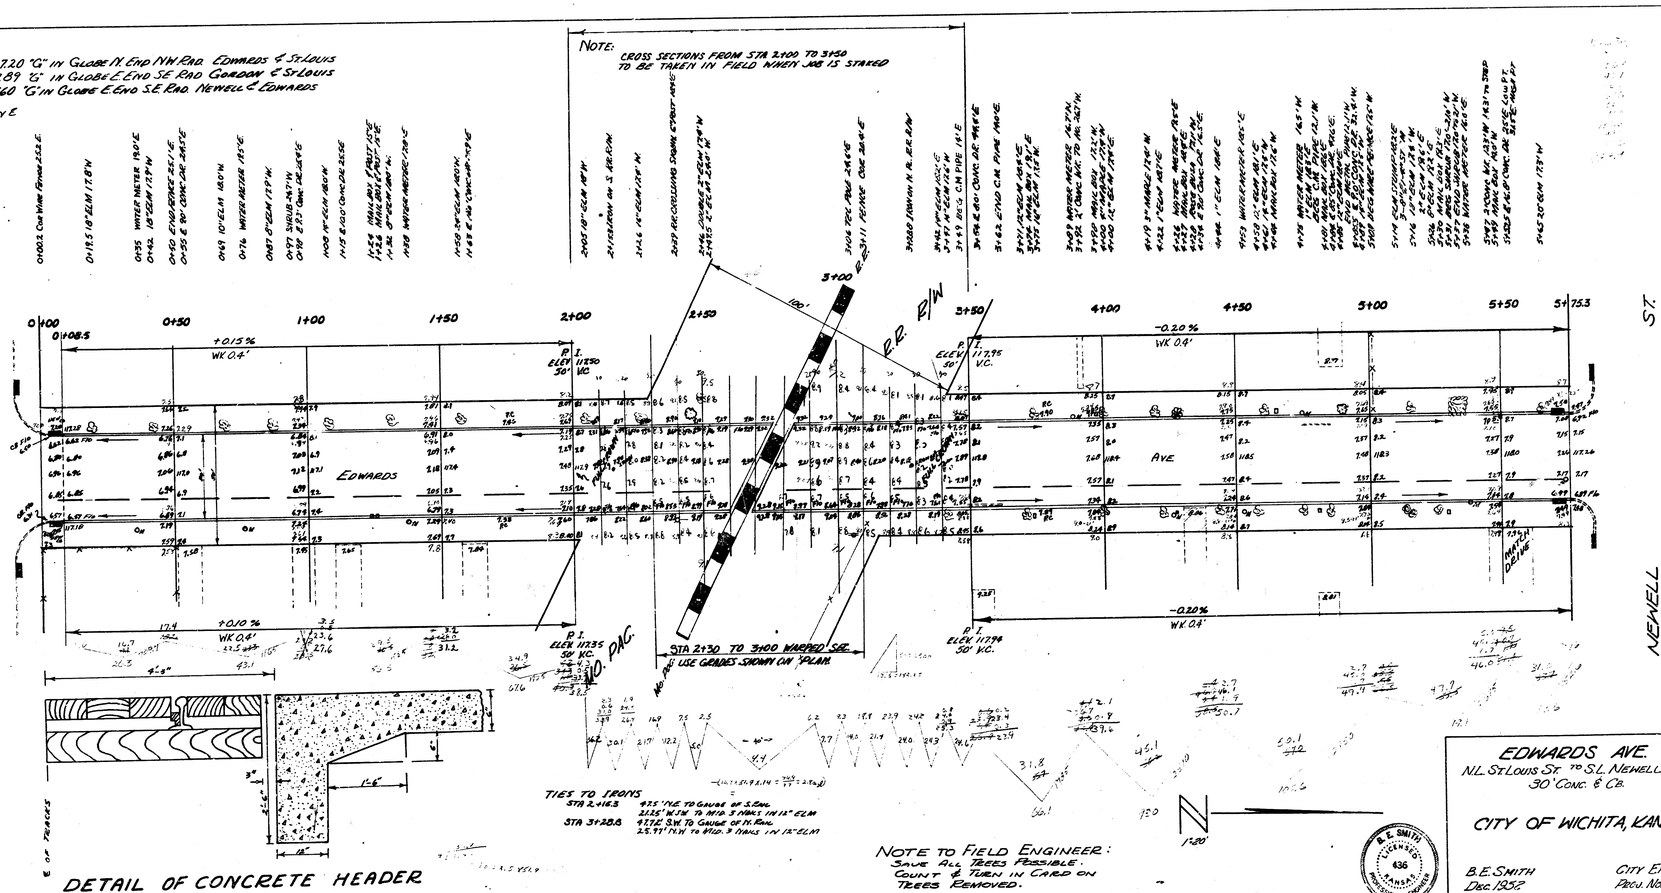

TIES TO IRONS
STA 2+16.3
8.25' N.E. TO GAUGE OF S. RAIL
2.25' W.S.W. TO NAIL & 3 NAILS IN 12" ELM
STA 3+28.8
4.72' S.W. TO GAUGE OF N. RAIL
2.5' N.N.W. TO NAIL & 3 NAILS IN 12" ELM

DETAIL OF CONCRETE HEADER
NO SCALE

NOTE TO FIELD ENGINEER:
SAVE ALL TREES POSSIBLE.
COUNT & TURN IN CARD ON TREES REMOVED.

B.E. SMITH LICENSED 636 KANSAS PROFESSIONAL ENGINEER

EDWARDS AVE.
N.L. ST. LOUIS ST. TO S.L. NEWELL ST.
30' CONC. & C.B.

CITY OF WICHITA, KAN.

B.E. SMITH
DEC. 1952

CITY ENGINEER
PROJ. No. C12-82

Survey Gd. JR Bk. 474/100
Plan Ag.
Rec. Ag.
Checked