


B.M. 113.98 1' ON C. OF CURB RAD. S.W. ST. CLAIR & 2ND
B.M. 112.92 1' ON IN THIMBLE C. OF ATHENIAN ST.

N

C.I. 7
94.8
37.33
33.2
751.3 cu yds.

8K 72 CM

NOTE: BASE LINE = W.P.L. ON BK. OF W.K.
TREE DISTANCES MEASURED FROM W.P.L. TO SIDE OF TREE NEAREST STREET.

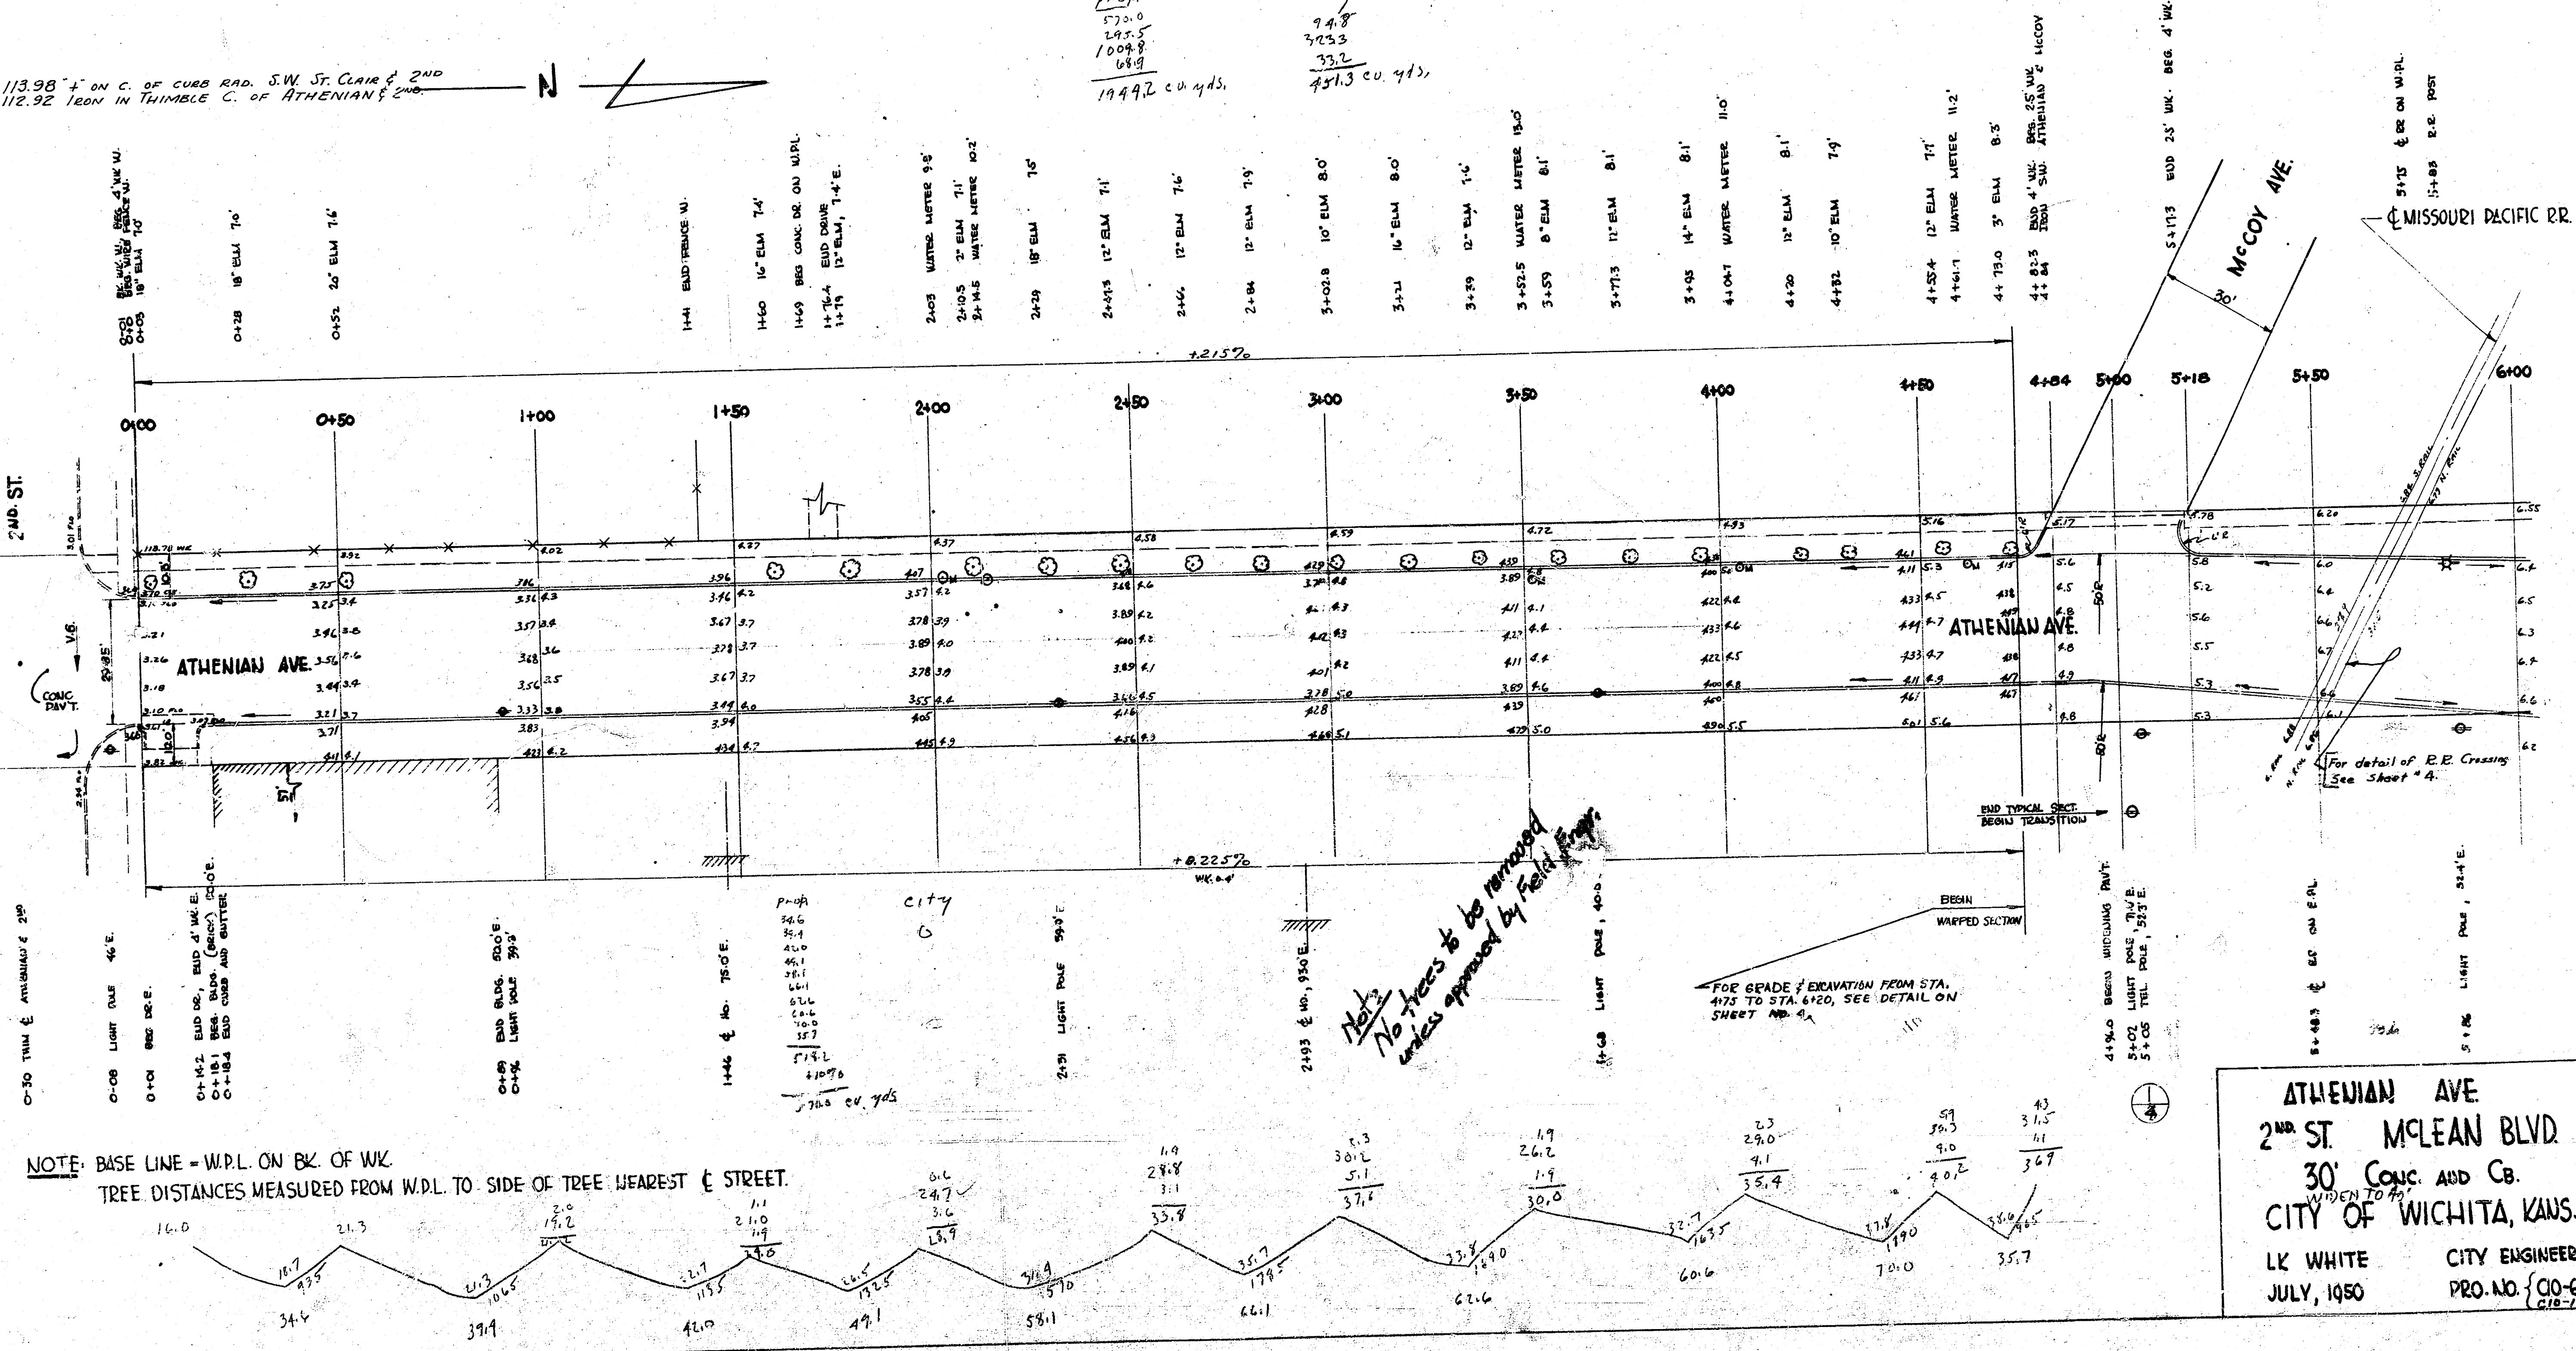


Not
No trees to be removed
unless approved by field engineer


SHEET NO. 4


ATHENIAN AVE
2ND ST. MCLEAN BLVD
30' CONC. ADD CB.
CITY OF WICHITA, KANS.
L.K. WHITE CITY ENGINEER
JULY, 1950 PRO. NO. 100-64
C10-73-6





BX 72 CM

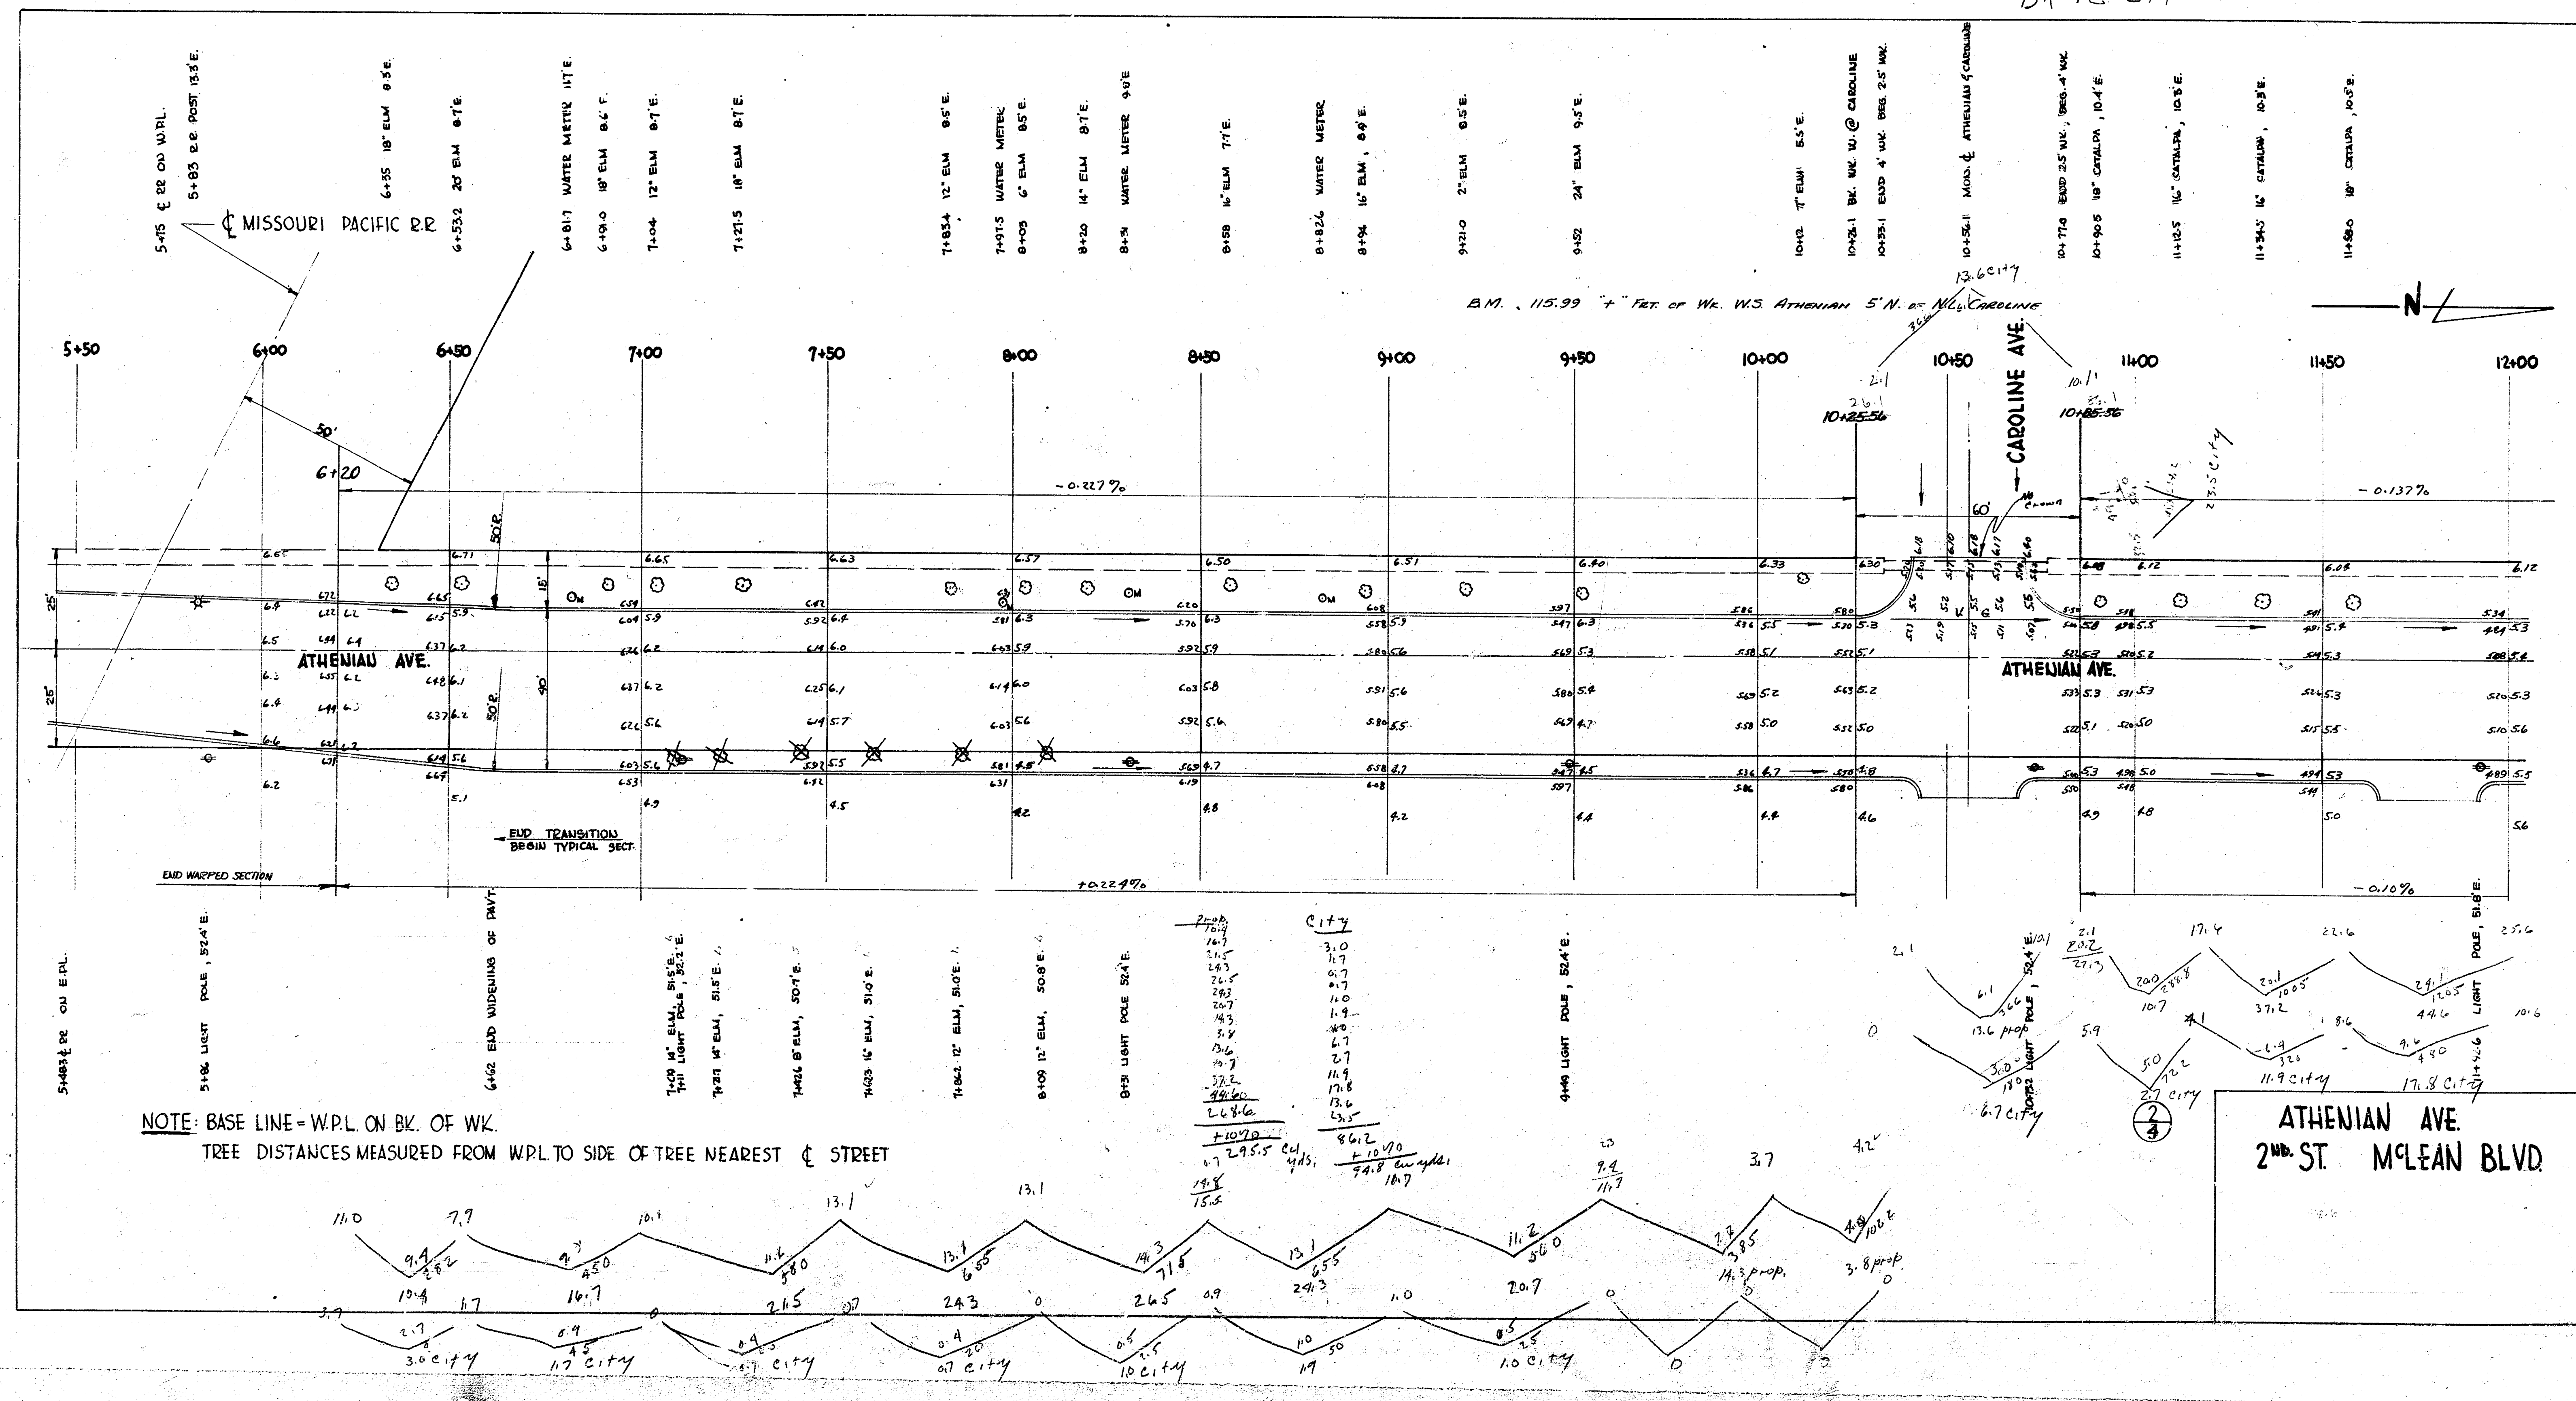

Br 72 C 11

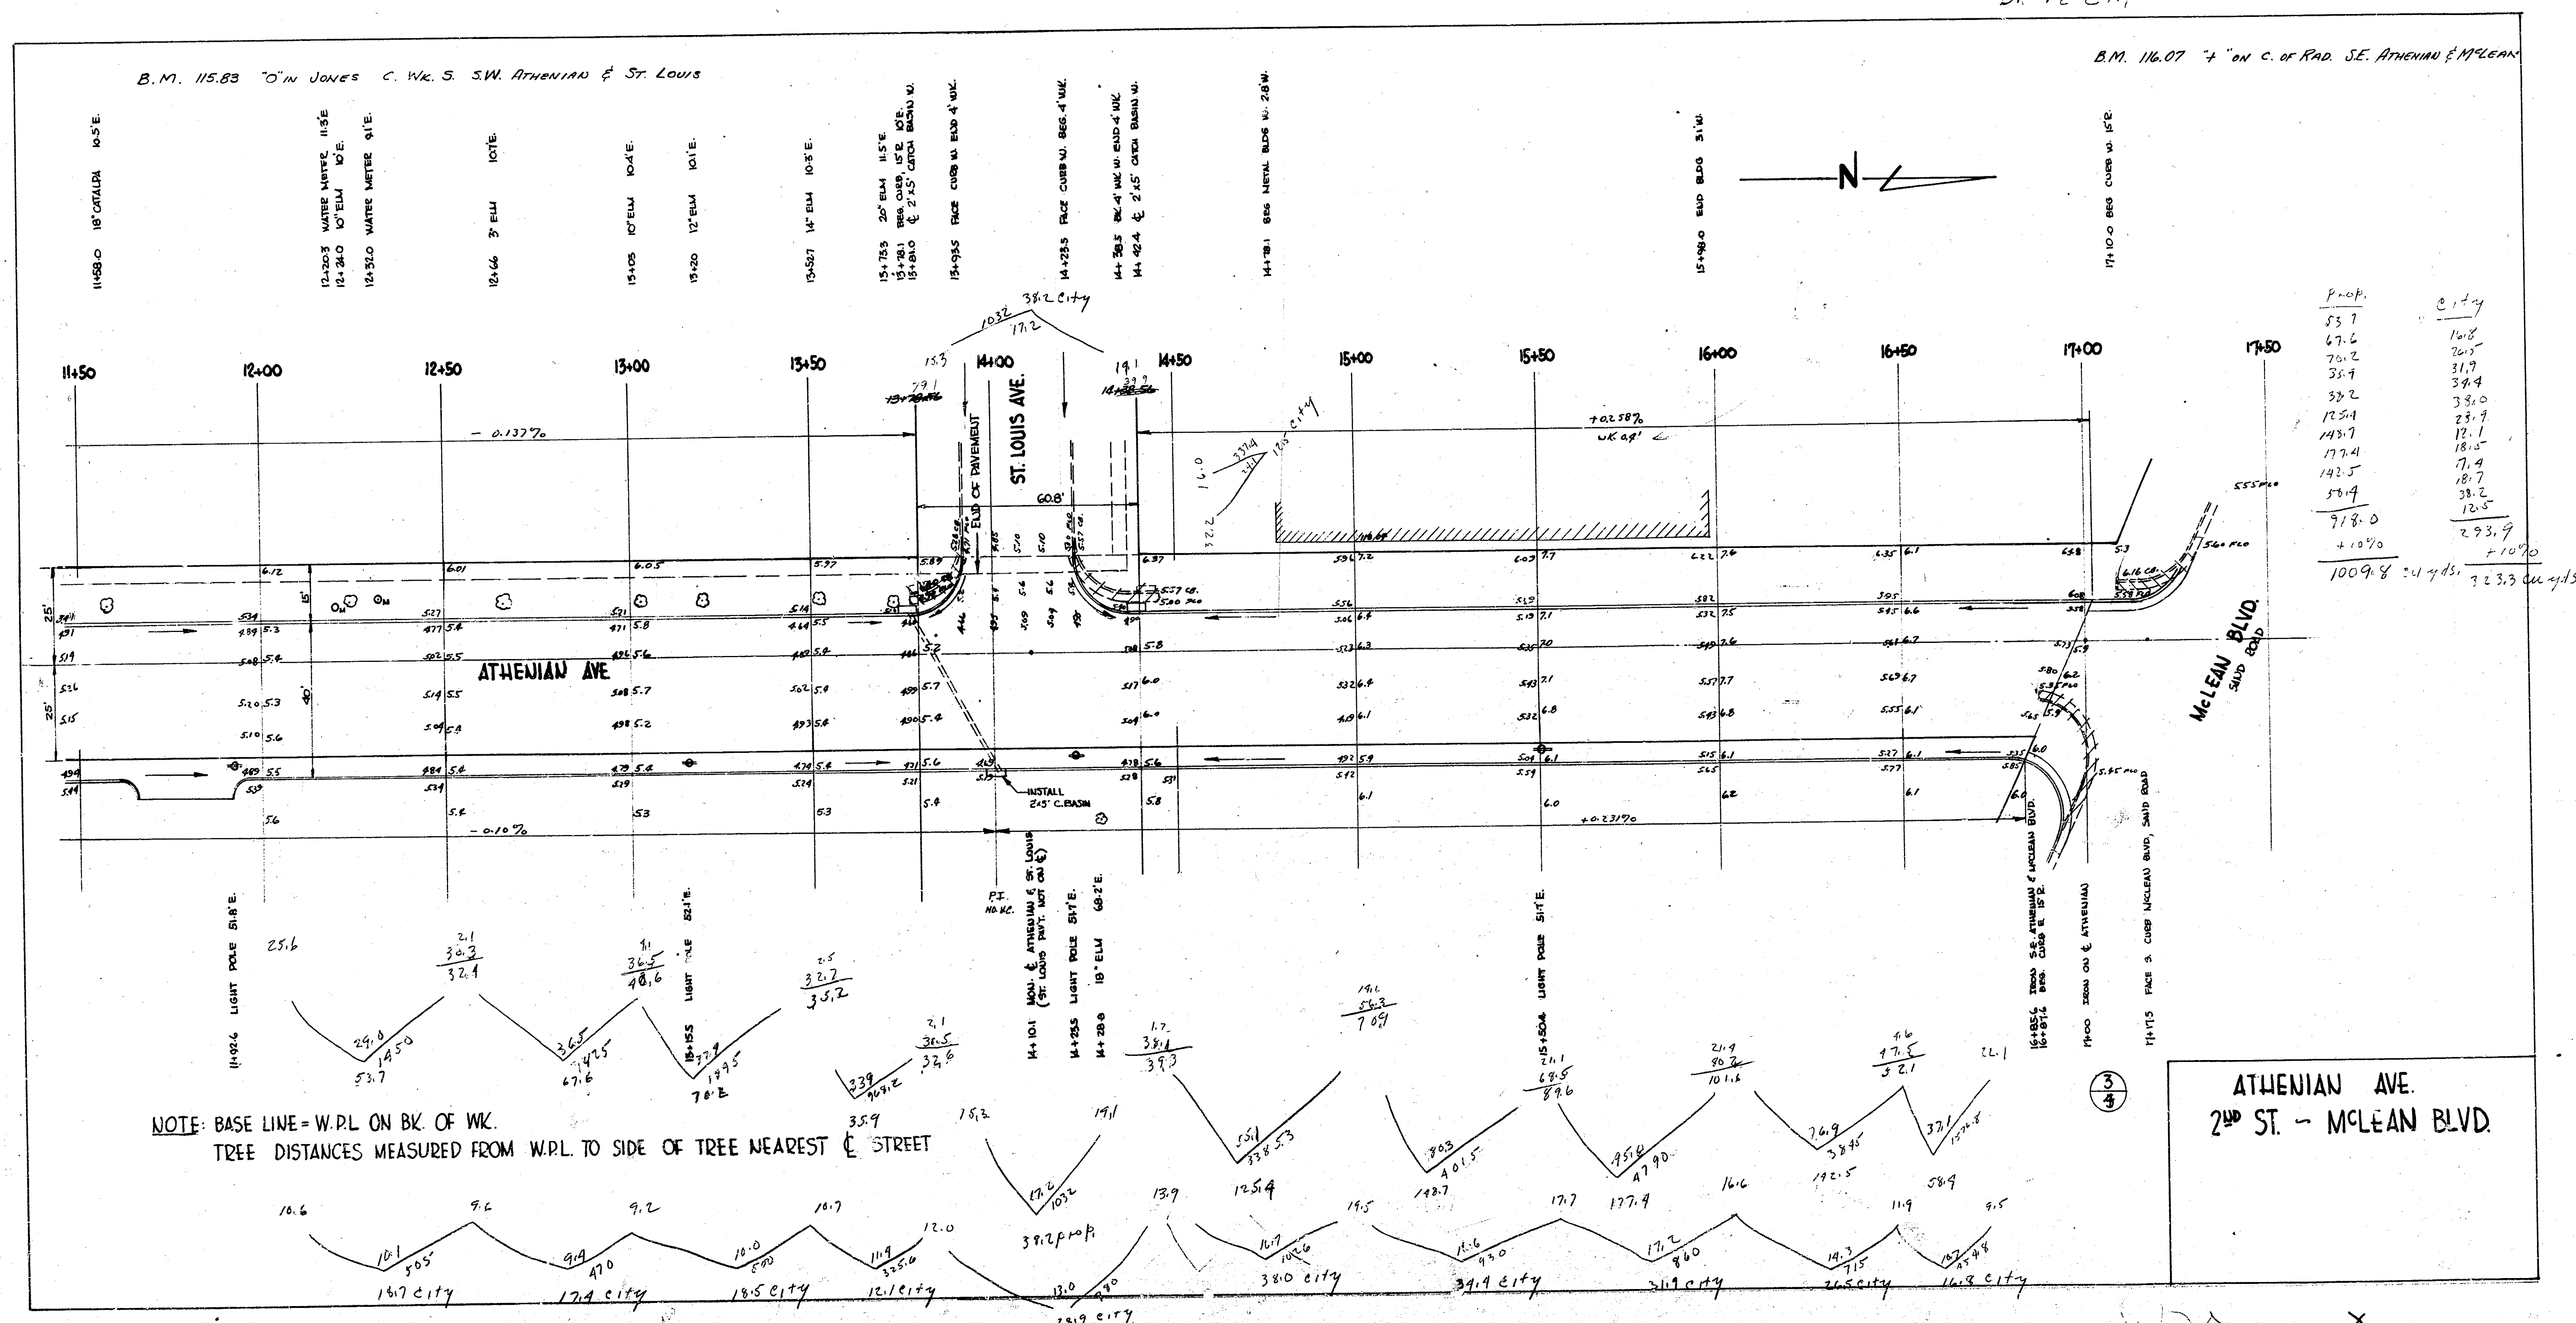

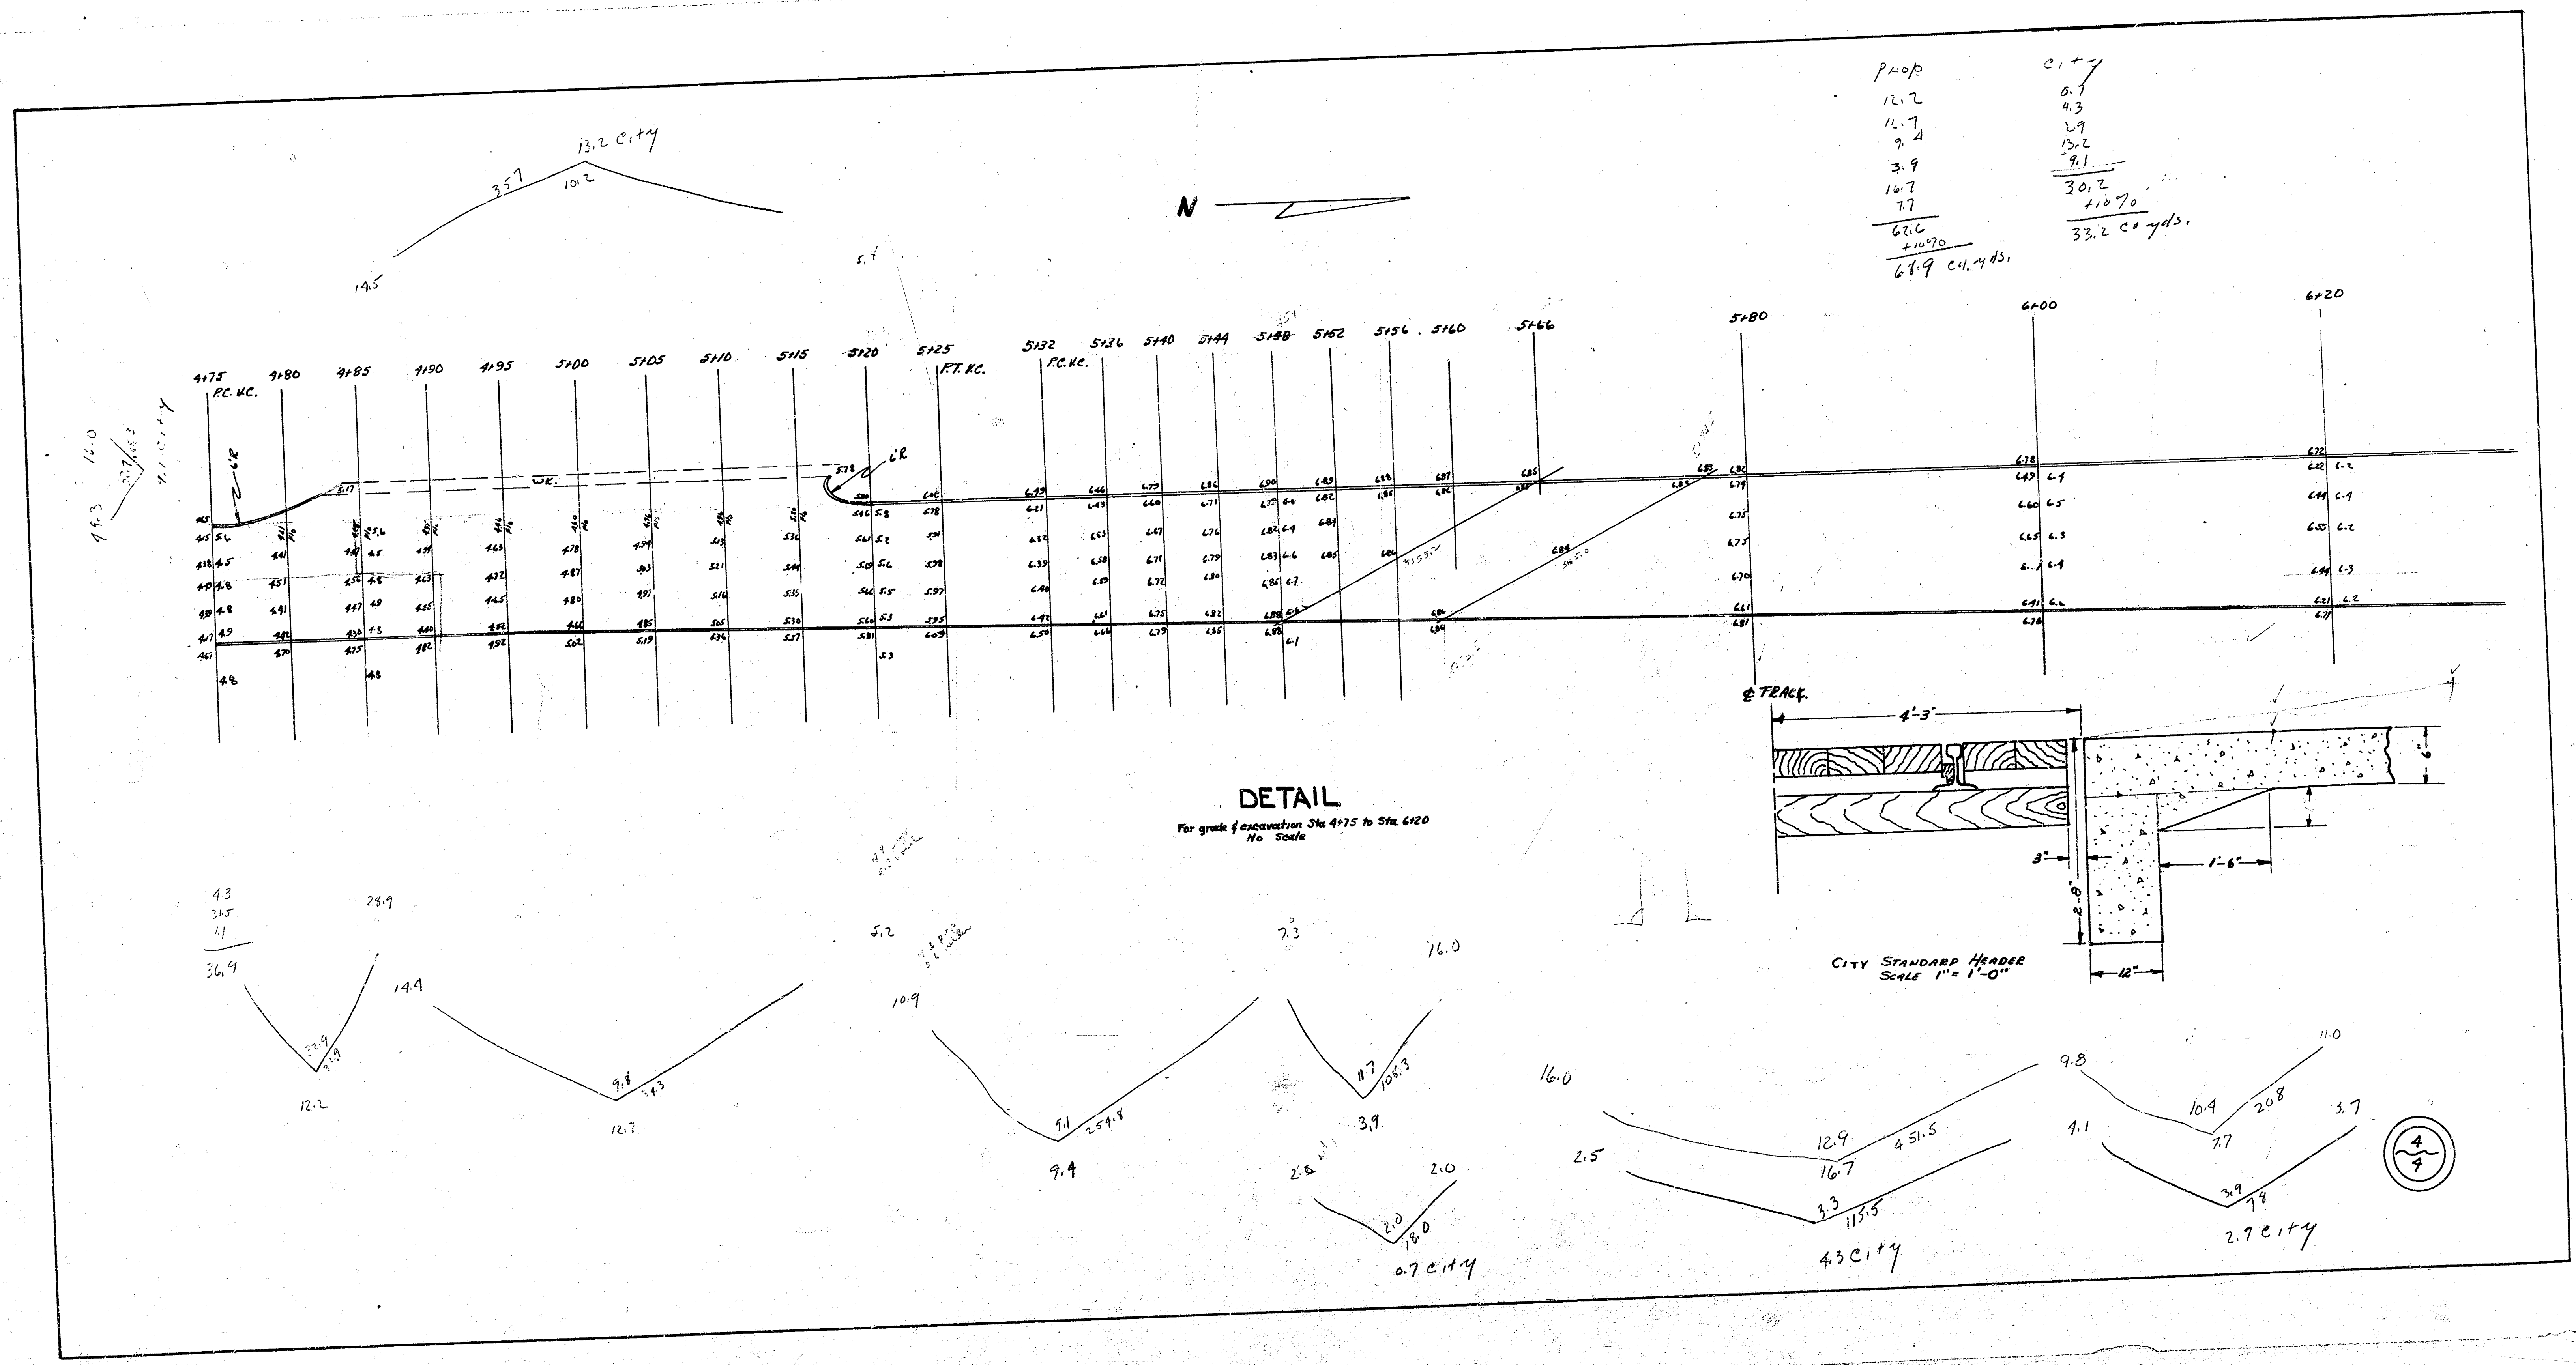

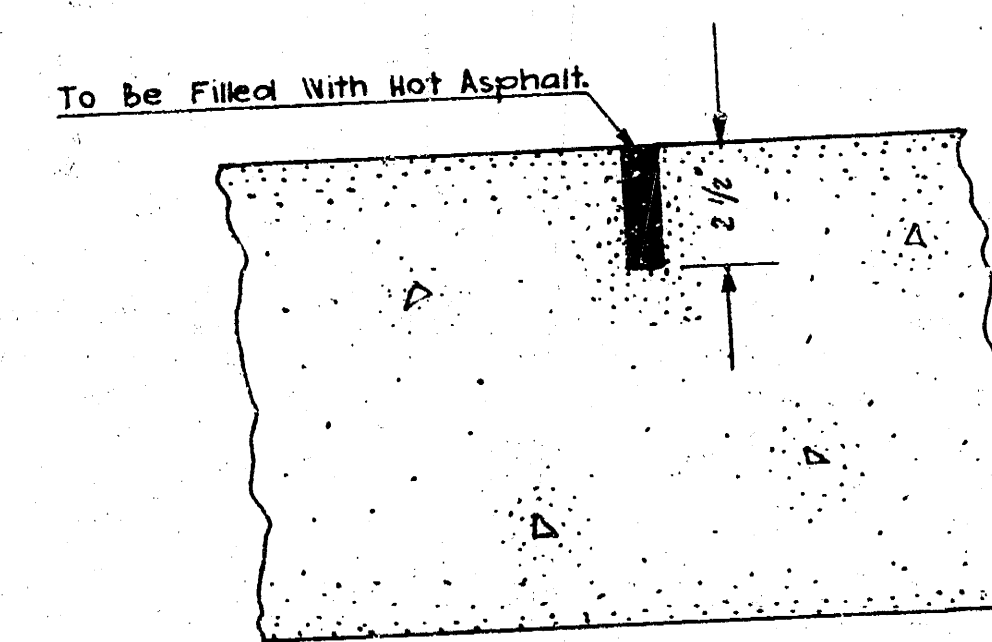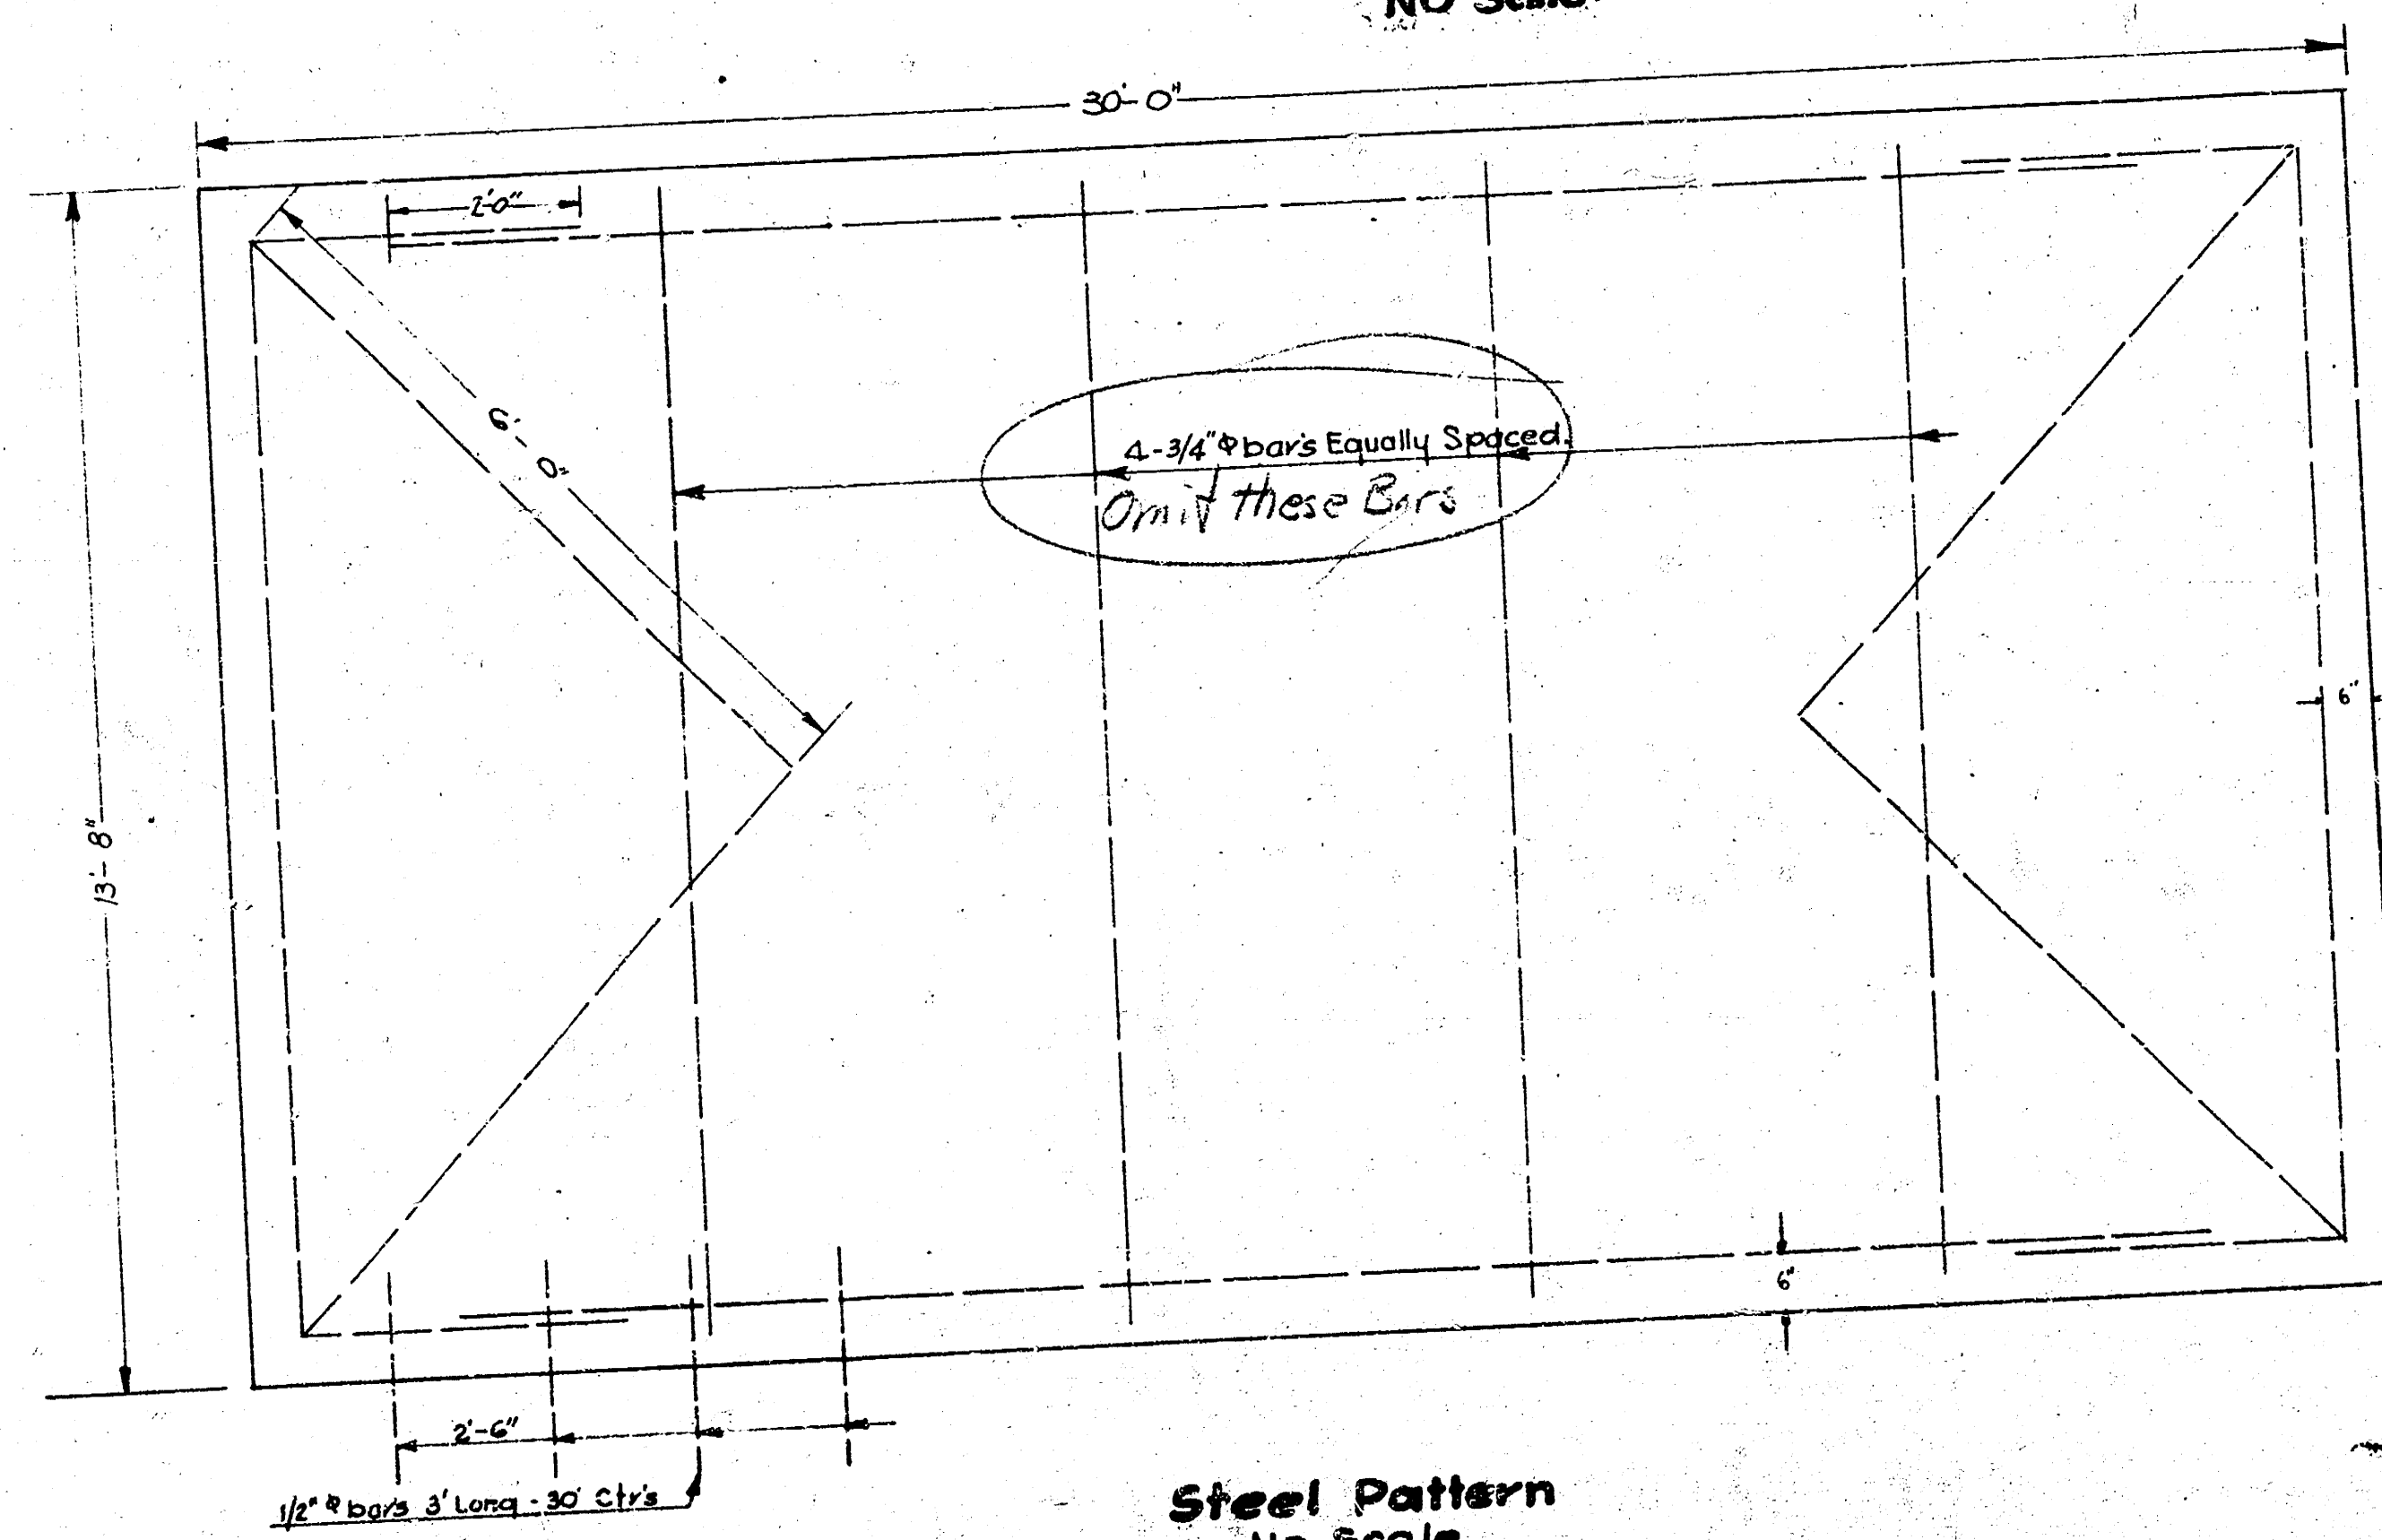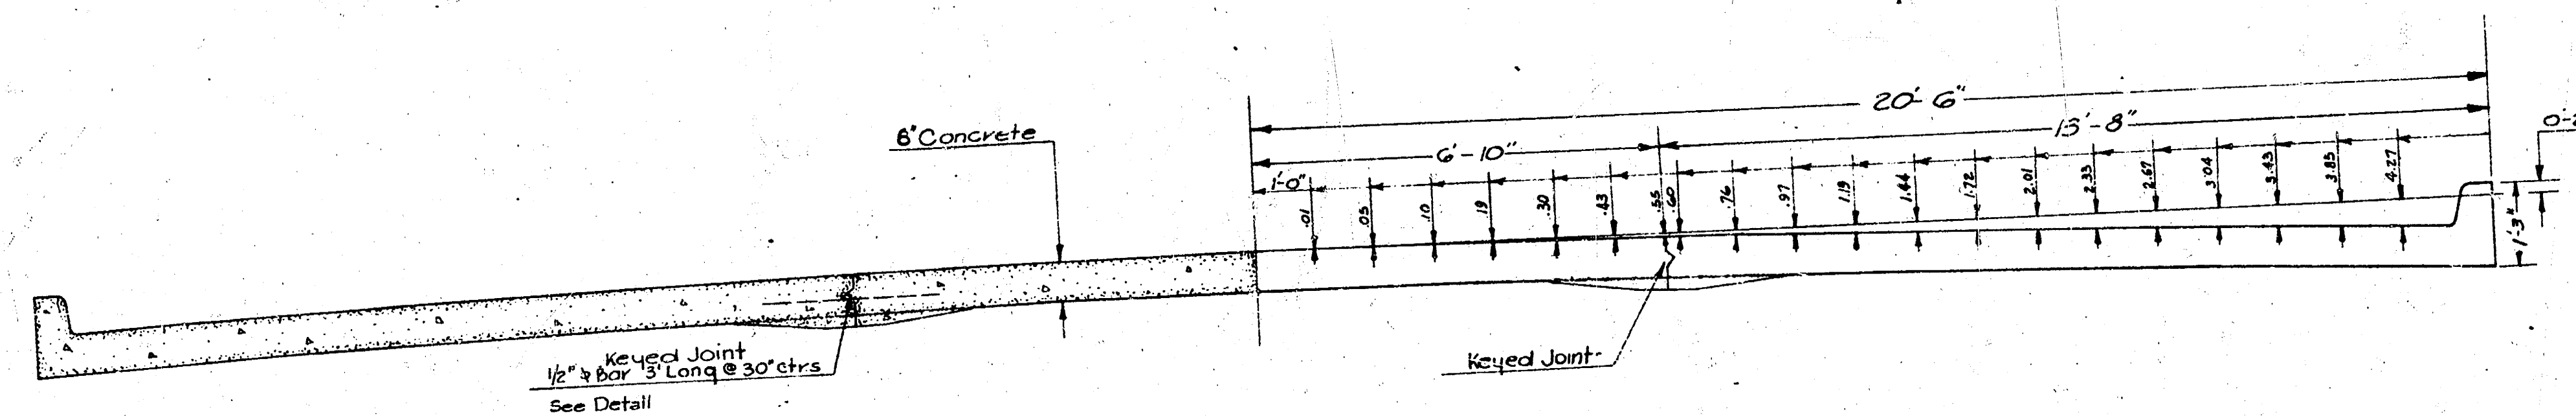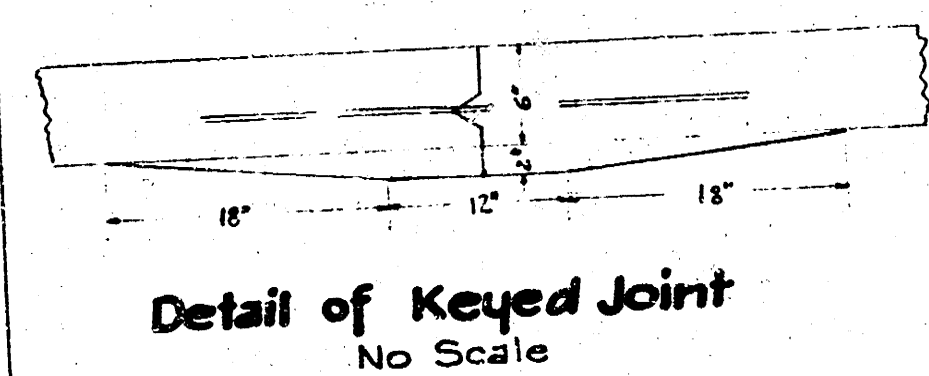

Detail of 4' Concrete Pavement
Jan. 1950