


MC 6-7

Total Property 330.6
+ 10% 33.1
363.7 cu yds

City - 0

BM. 119.16 Sta. NE Cor. Arkansas & 17th

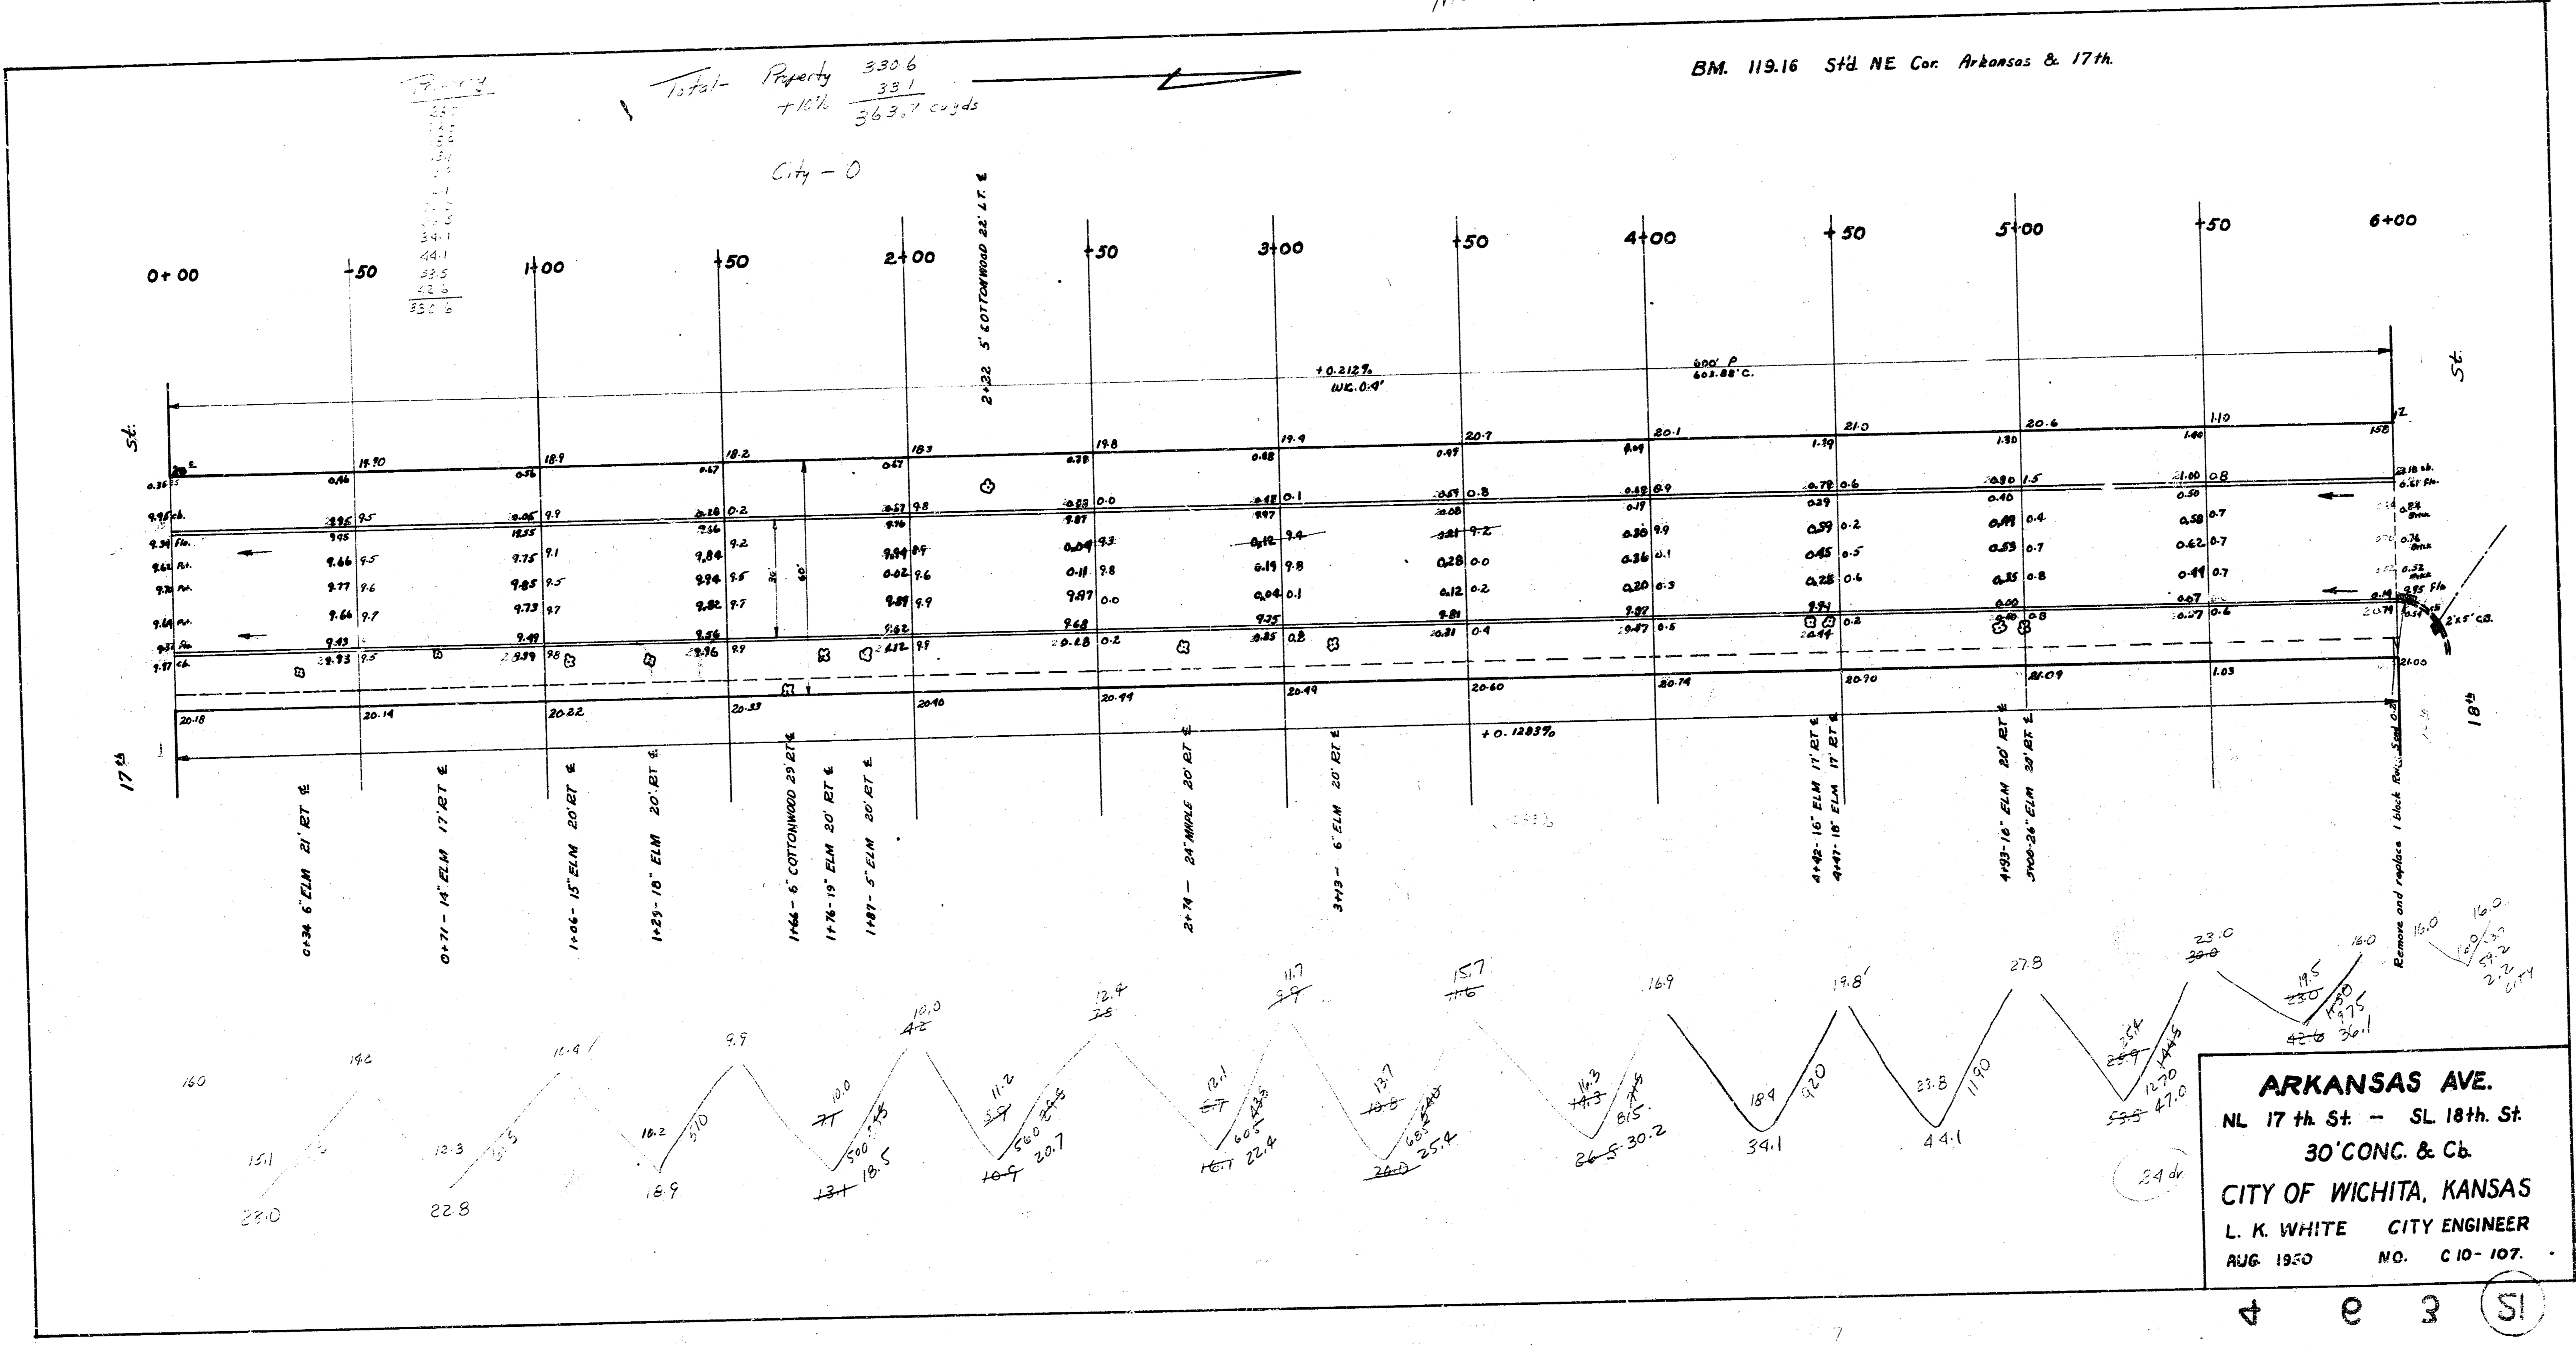

ARKANSAS AVE.
 NL 17th St. - SL 18th St.
 30' CONC. & Cb.
 CITY OF WICHITA, KANSAS
 L. K. WHITE CITY ENGINEER
 AUG 1950 NO. C 10-107

4 e 3 SI