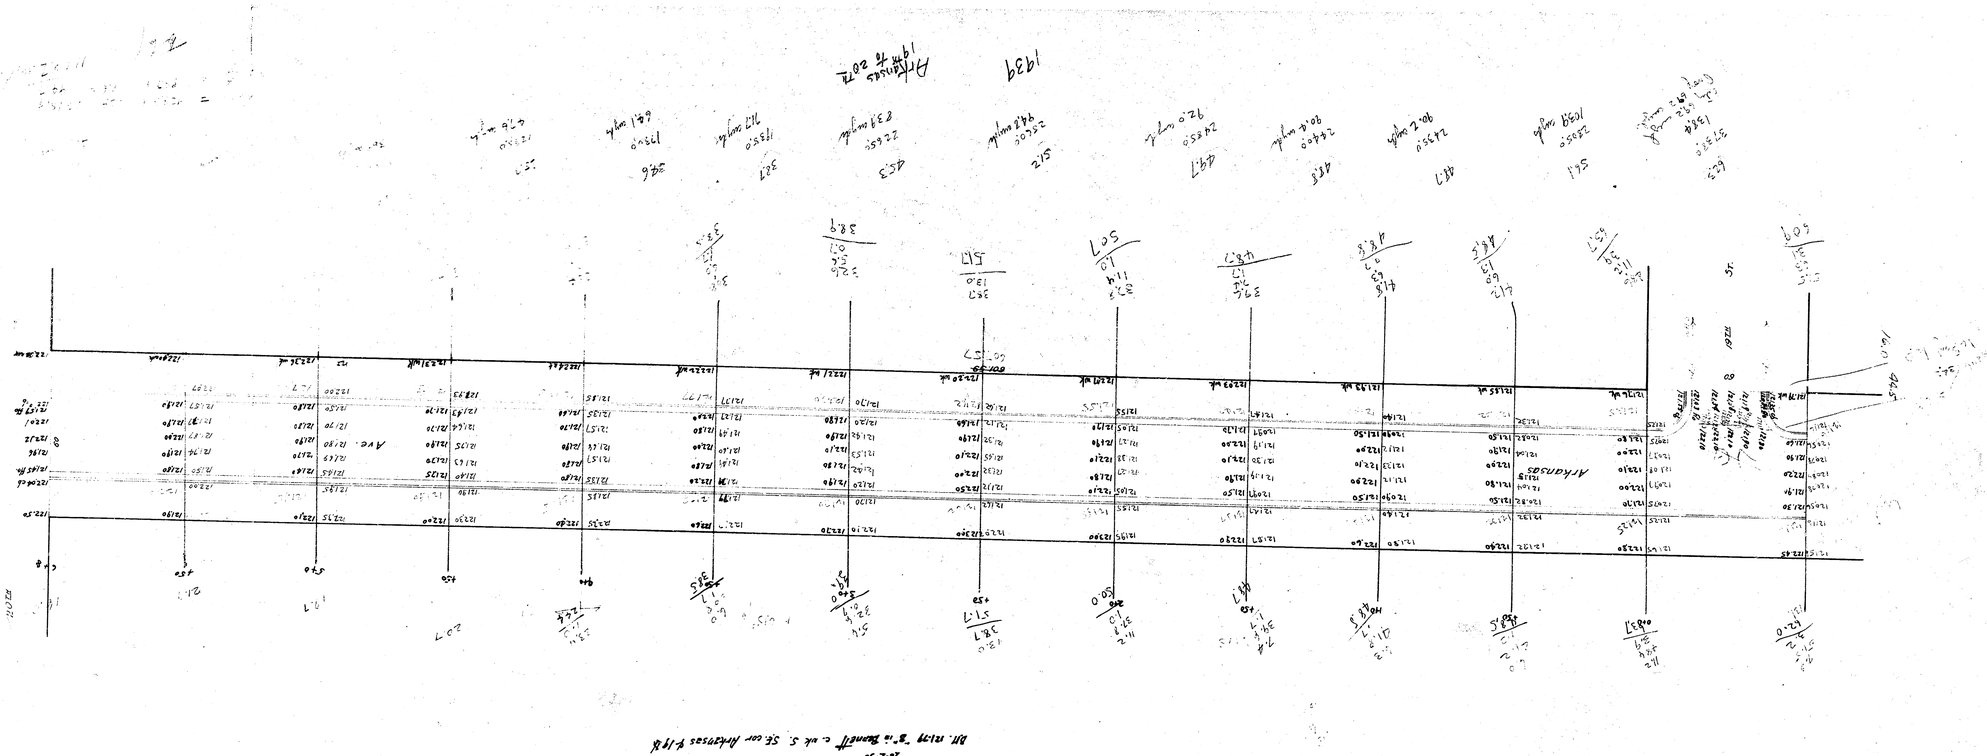

Case
24-Z-50
