B.M. 1118.10 "C" in construction, top curb at S. end of radius, S.E. 17th. & Mathewson.

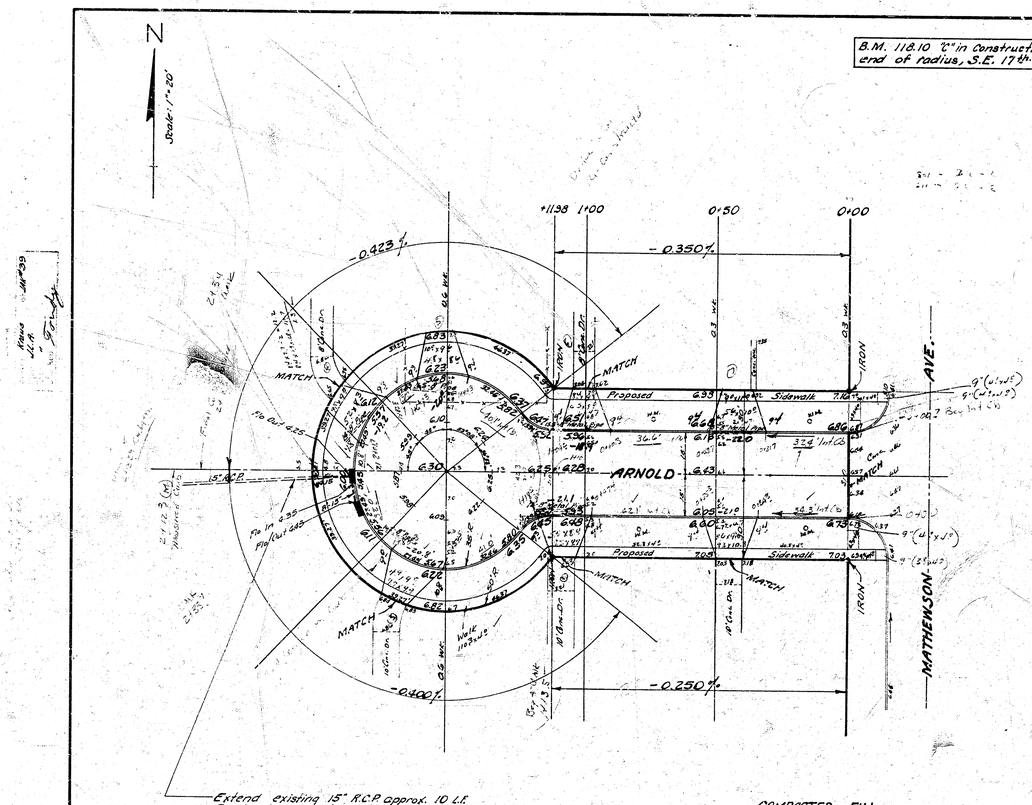

SUMMARY OF QUANTITIES

847.5'	Sq.Yds.	6" Conc. Pavement.
273 ✓	Lin.Ft.	Reinf. Int. Curb
140 ✓	Lin.Ft.	Sep. Curb
* 1,155 ✓	Sq.Ft.	6" Conc. Drive
293 ✓	Lin.Ft.	Key Joint
3,500 ✓	Lbs.	Reinf. Steel
3 ✓	Cu.Yds.	Concrete
3 ✓	Cu.Yds.	Special Excavation
292 ✓	Cu.Yds.	Excavation
90 ✓	Lin.Ft.	Pipe Removed
85 ✓	Lin.Ft.	Fence Removed
18 ✓	Lin.Ft.	15" R.C.P.
2 ✓	Ea.	2'x5' Inlets
147 ✓	Cu.Yds.	Comp. Fill

* 7-10' drives estimated

NOTE:

This job is to be coordinated with the paving of Mathewson (project C18-122) and all excavation is to be used (1) in the parking areas on Mathewson, (2) on the lots adjacent to Mathewson.

NOTE TO CONTRACTOR

This project will be constructed under the supervision of the CITY ENGINEER and conform to the SPECIFICATIONS of the CITY OF WICHITA. The CONTRACTOR shall assure the City of Wichita ... of Engineering, Plans, and ... Section.

COMPACTED FILL

3.6	Cu.Yds. from X-Sec
161.2	" " Sub-Grade Modification
146.8	Cu.Yds.

JAMES H. TANDY LICENSED 2012 KANSAS PROFESSIONAL ENGINEER

JOHN L. ALLEN LICENSED 821 KANSAS PROFESSIONAL ENGINEER

B.E. SMITH LICENSED 436 KANSAS PROFESSIONAL ENGINEER COUNTY ENGINEER

(1/2)

ARNOLD STREET

FROM W.L. MATHEWSON AVE. to ℄ INC. CUL-DE-SAC

30' Conc. & Int. Curb

B.E. SMITH CITY ENGINEER
CITY OF WICHITA KANSAS

Date: May 1949

Private Contract

11 4 2 (9)