



1942
Ash - J.L. Mesita to N.L. Harry
30 Conc. - Ini. Cb.

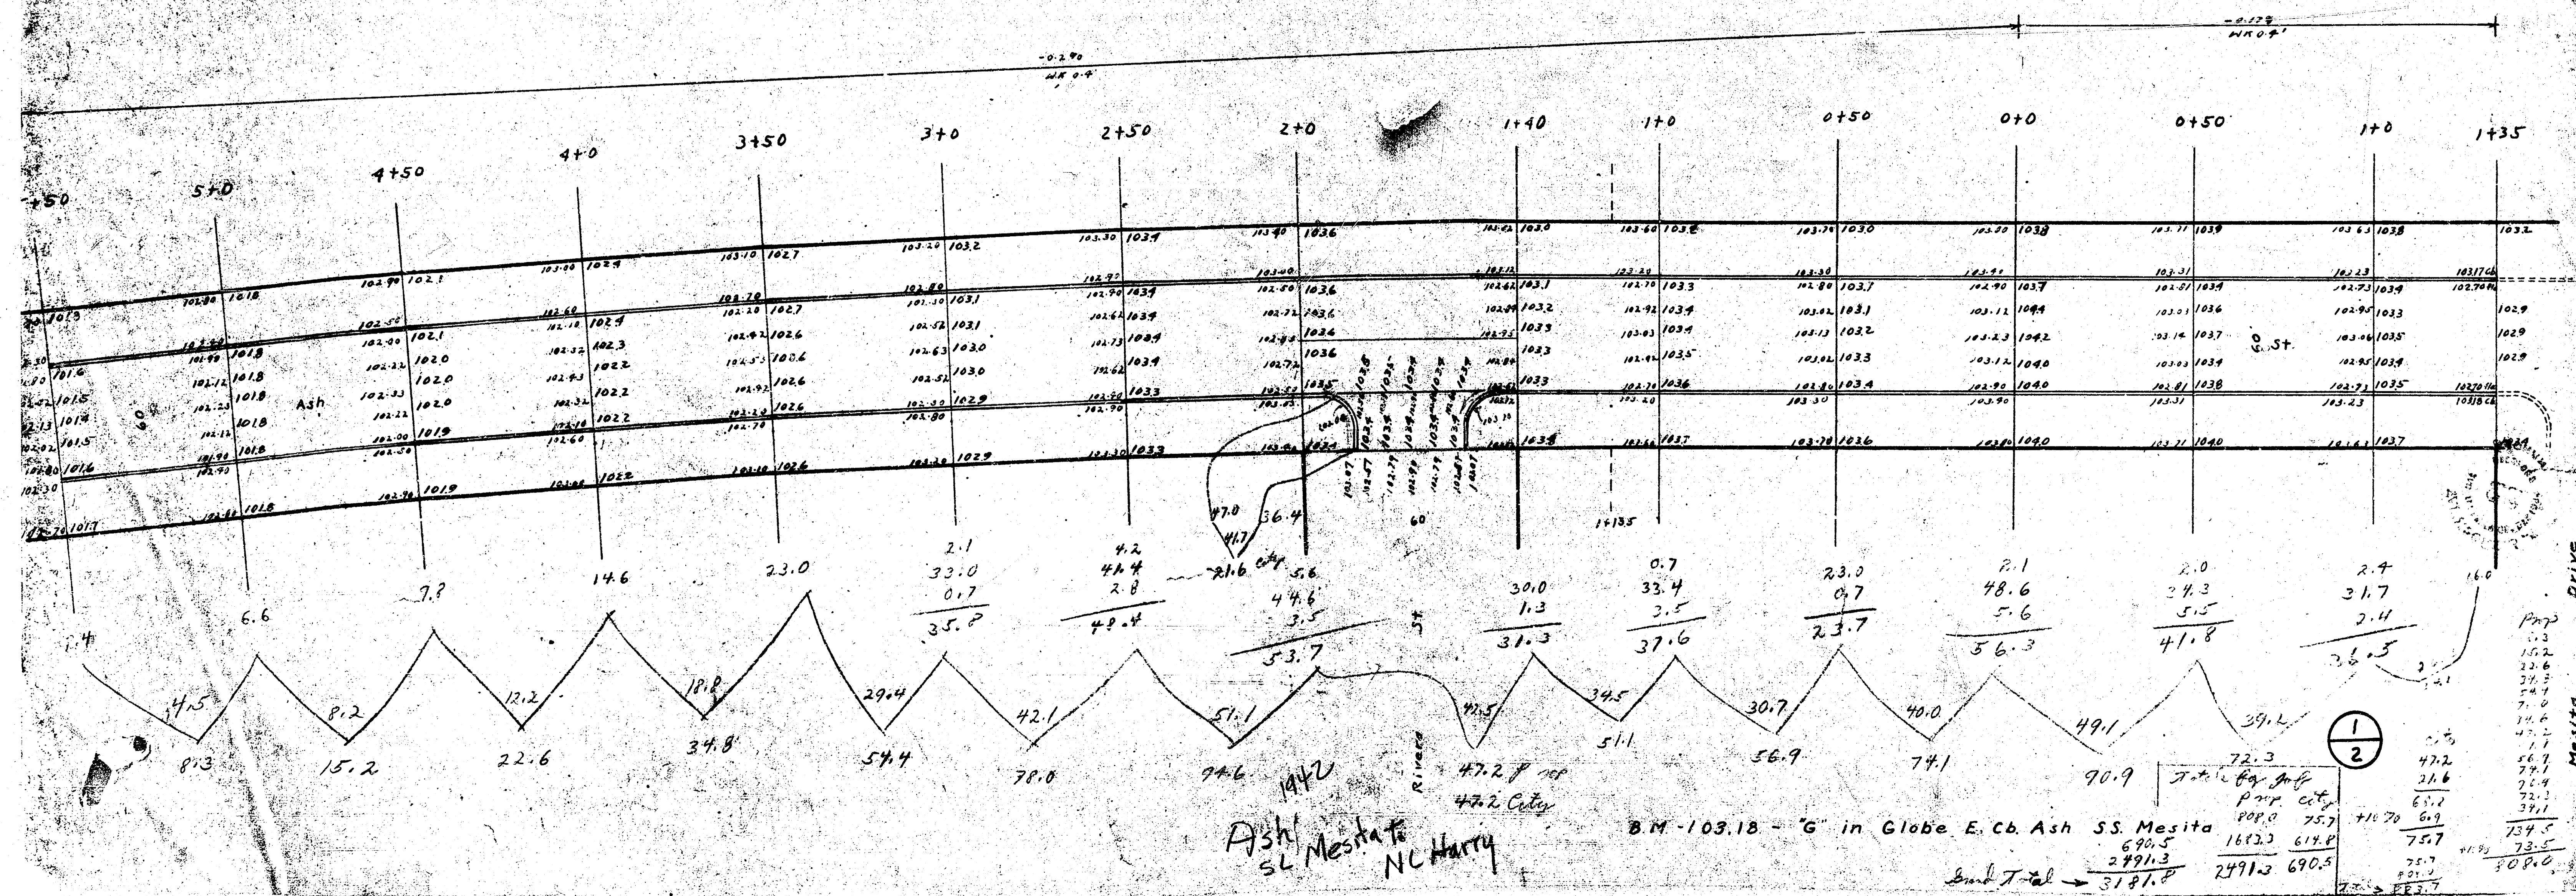

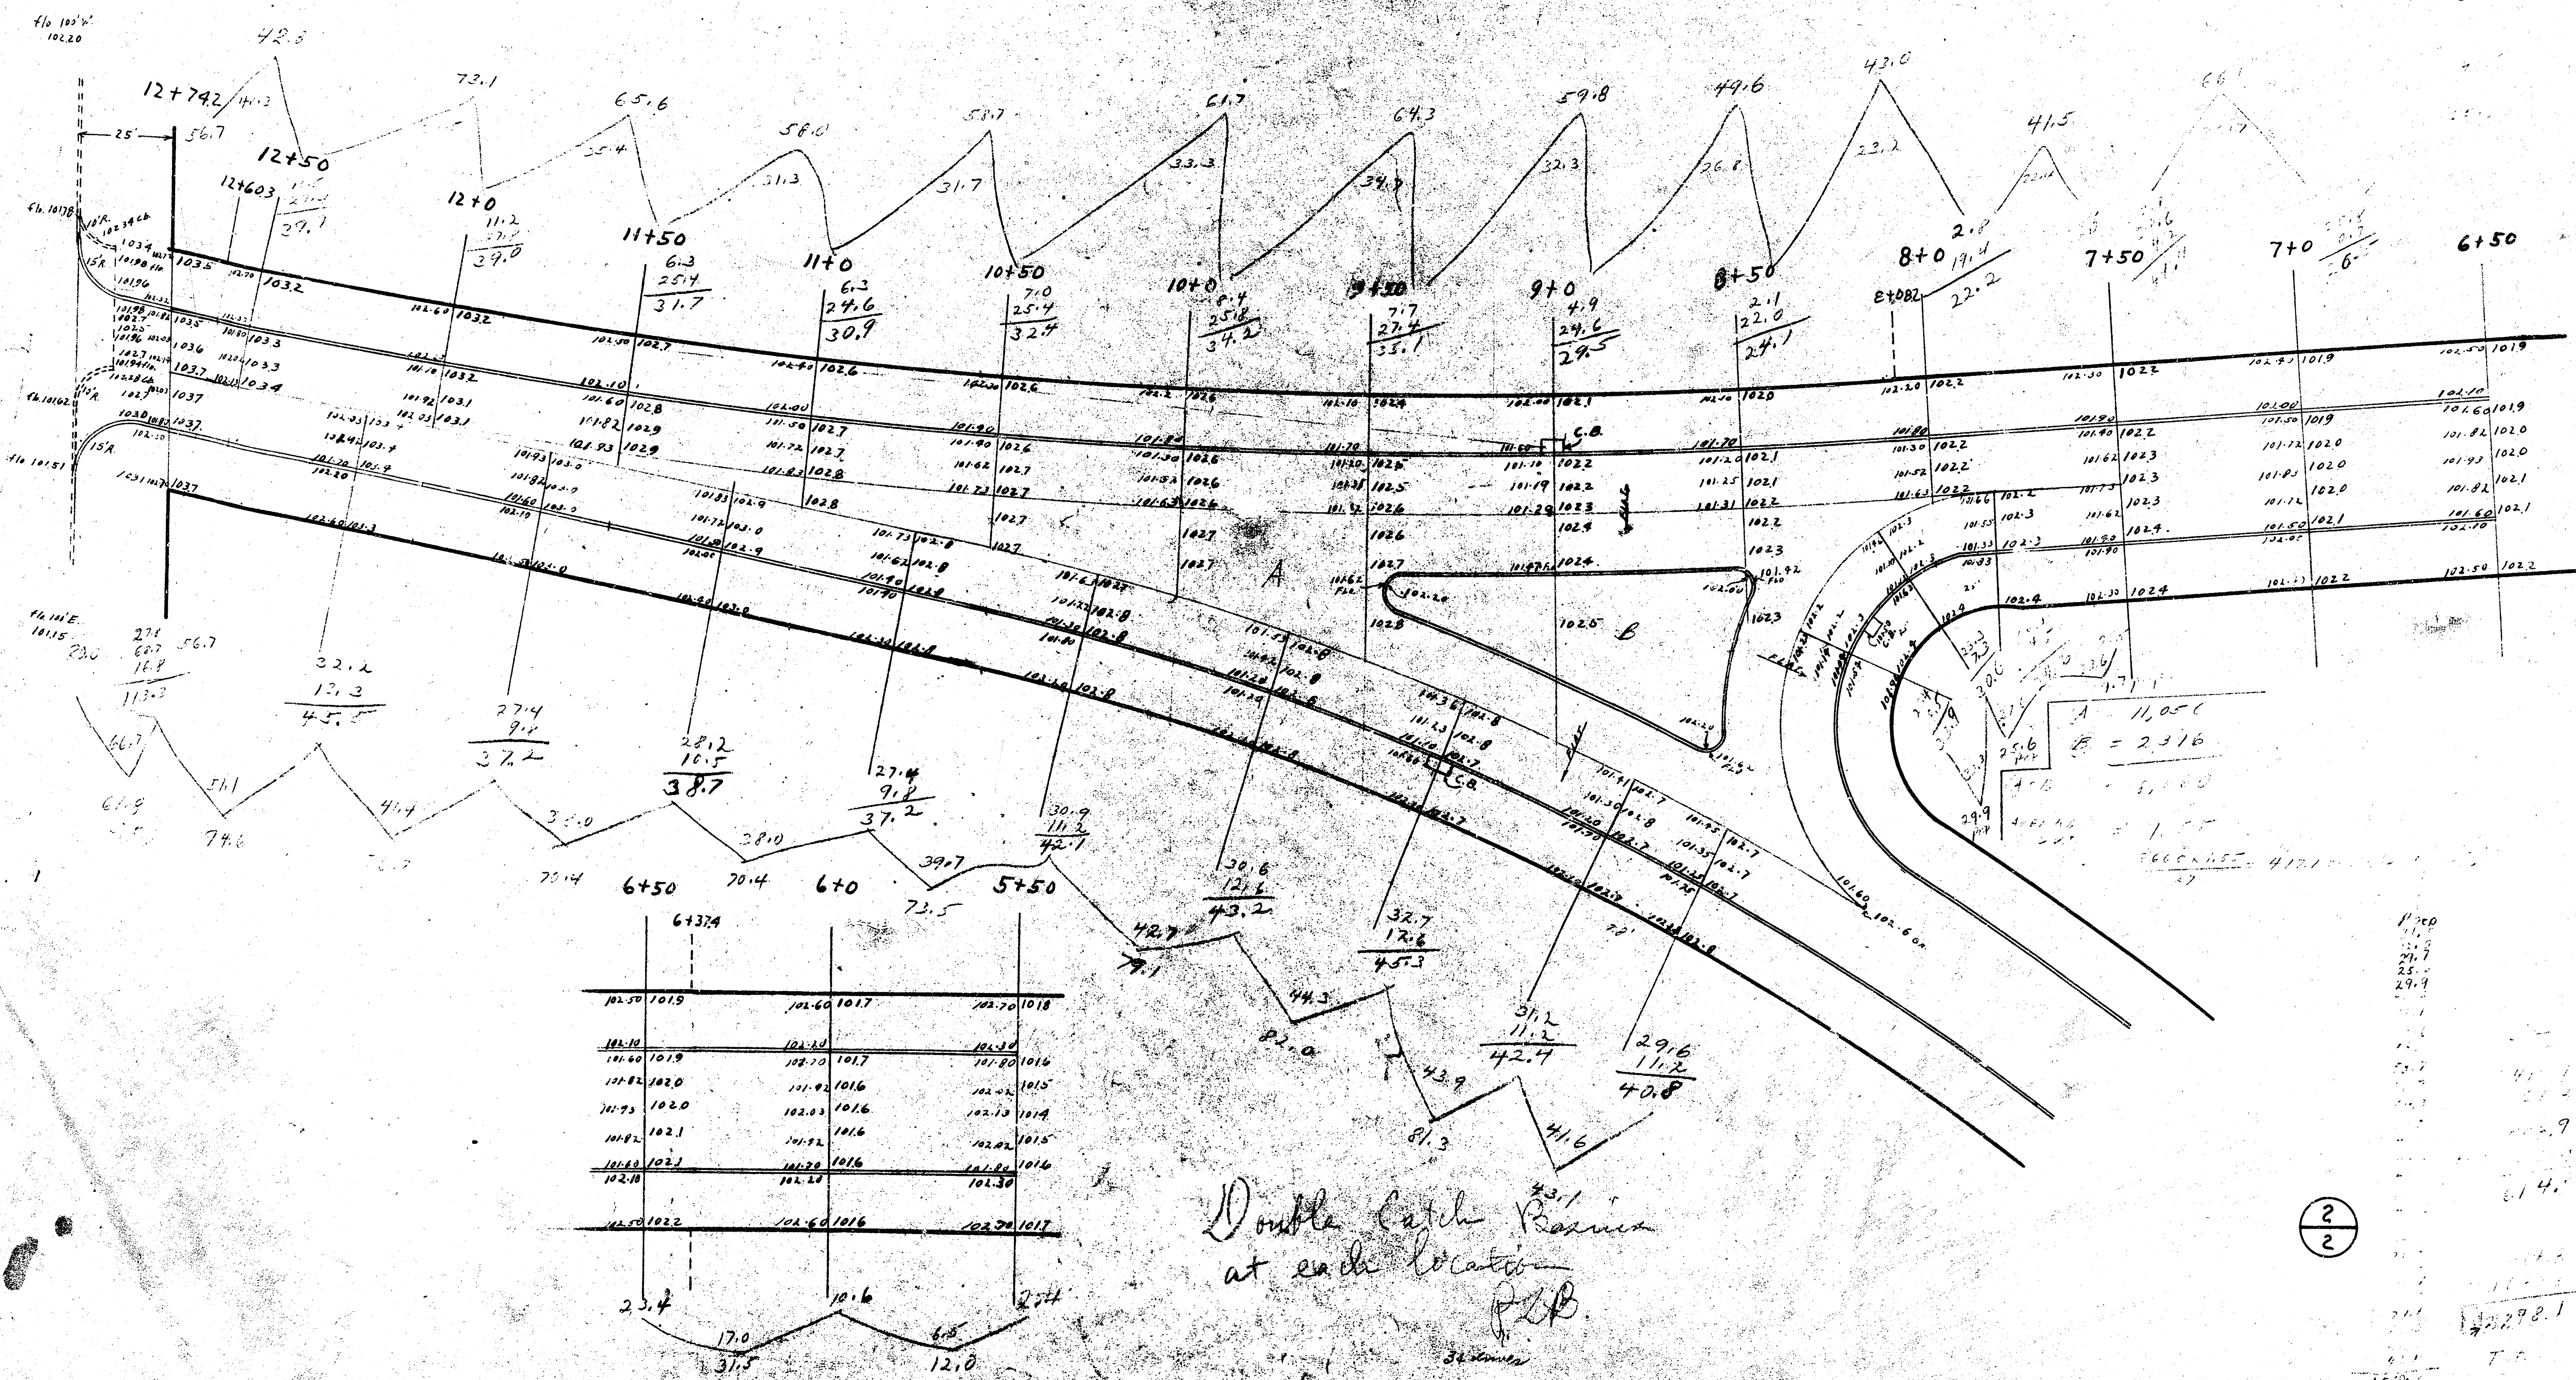

2
2