

Sheet 124 of 124
 BM elev. 112.67 N. end curb Ref. W. C. Battin & English

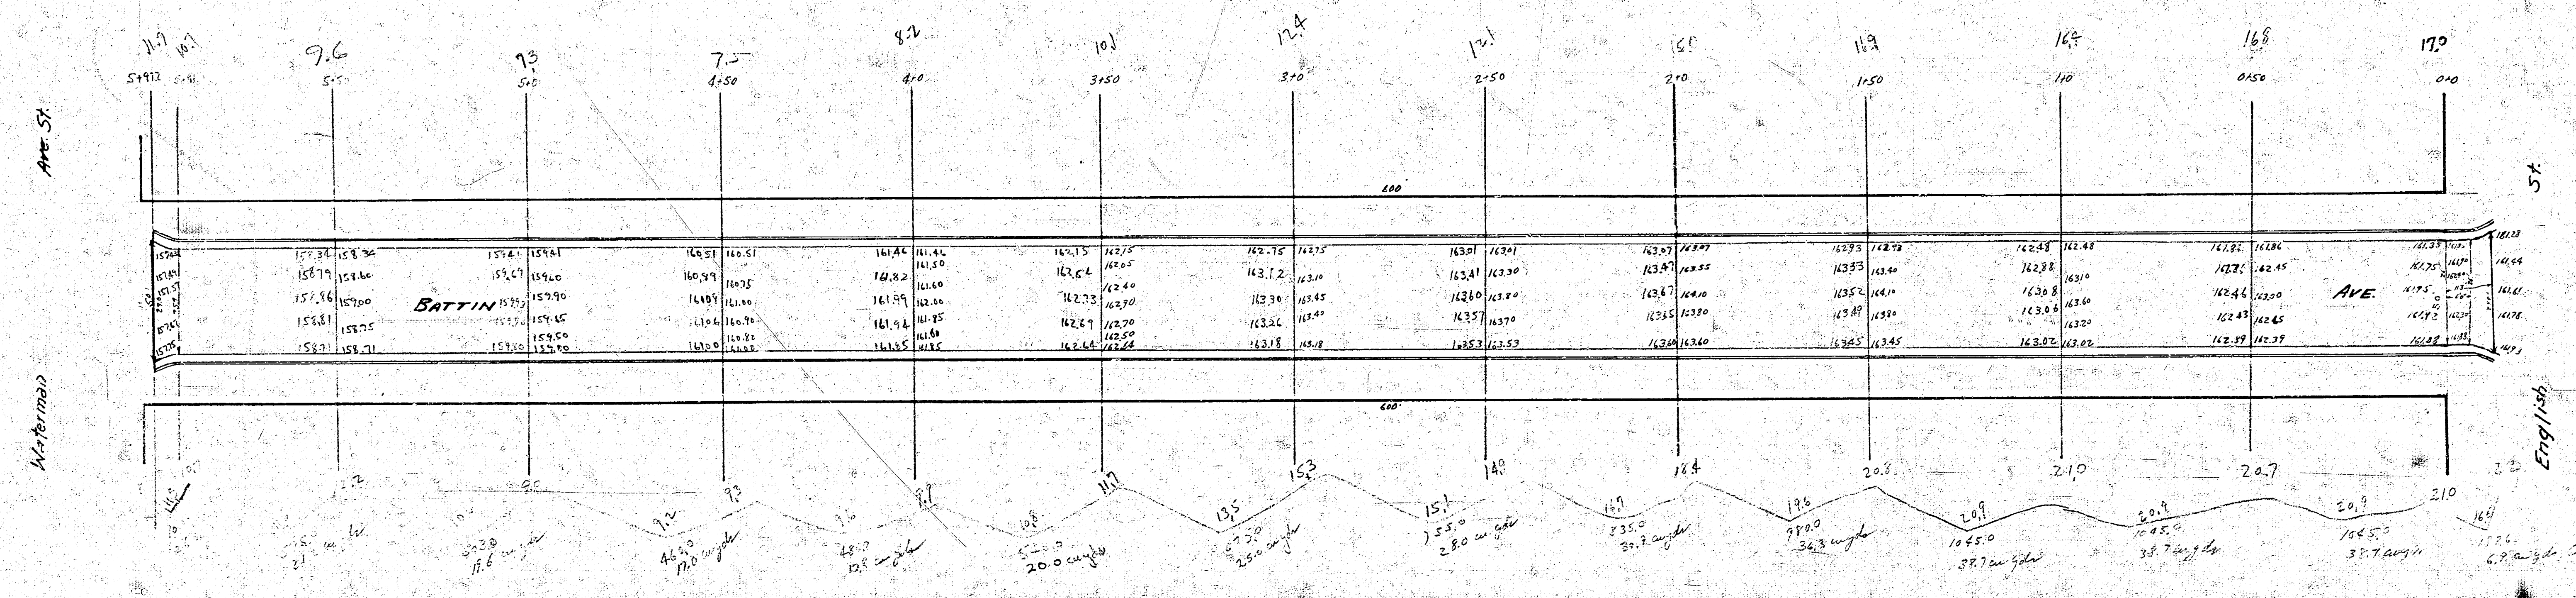


Fig. 124 of 124
 124