


B.M. 110.33 "T" in Tray, Top Hydrant, NW Corner Bayley Hydraulic

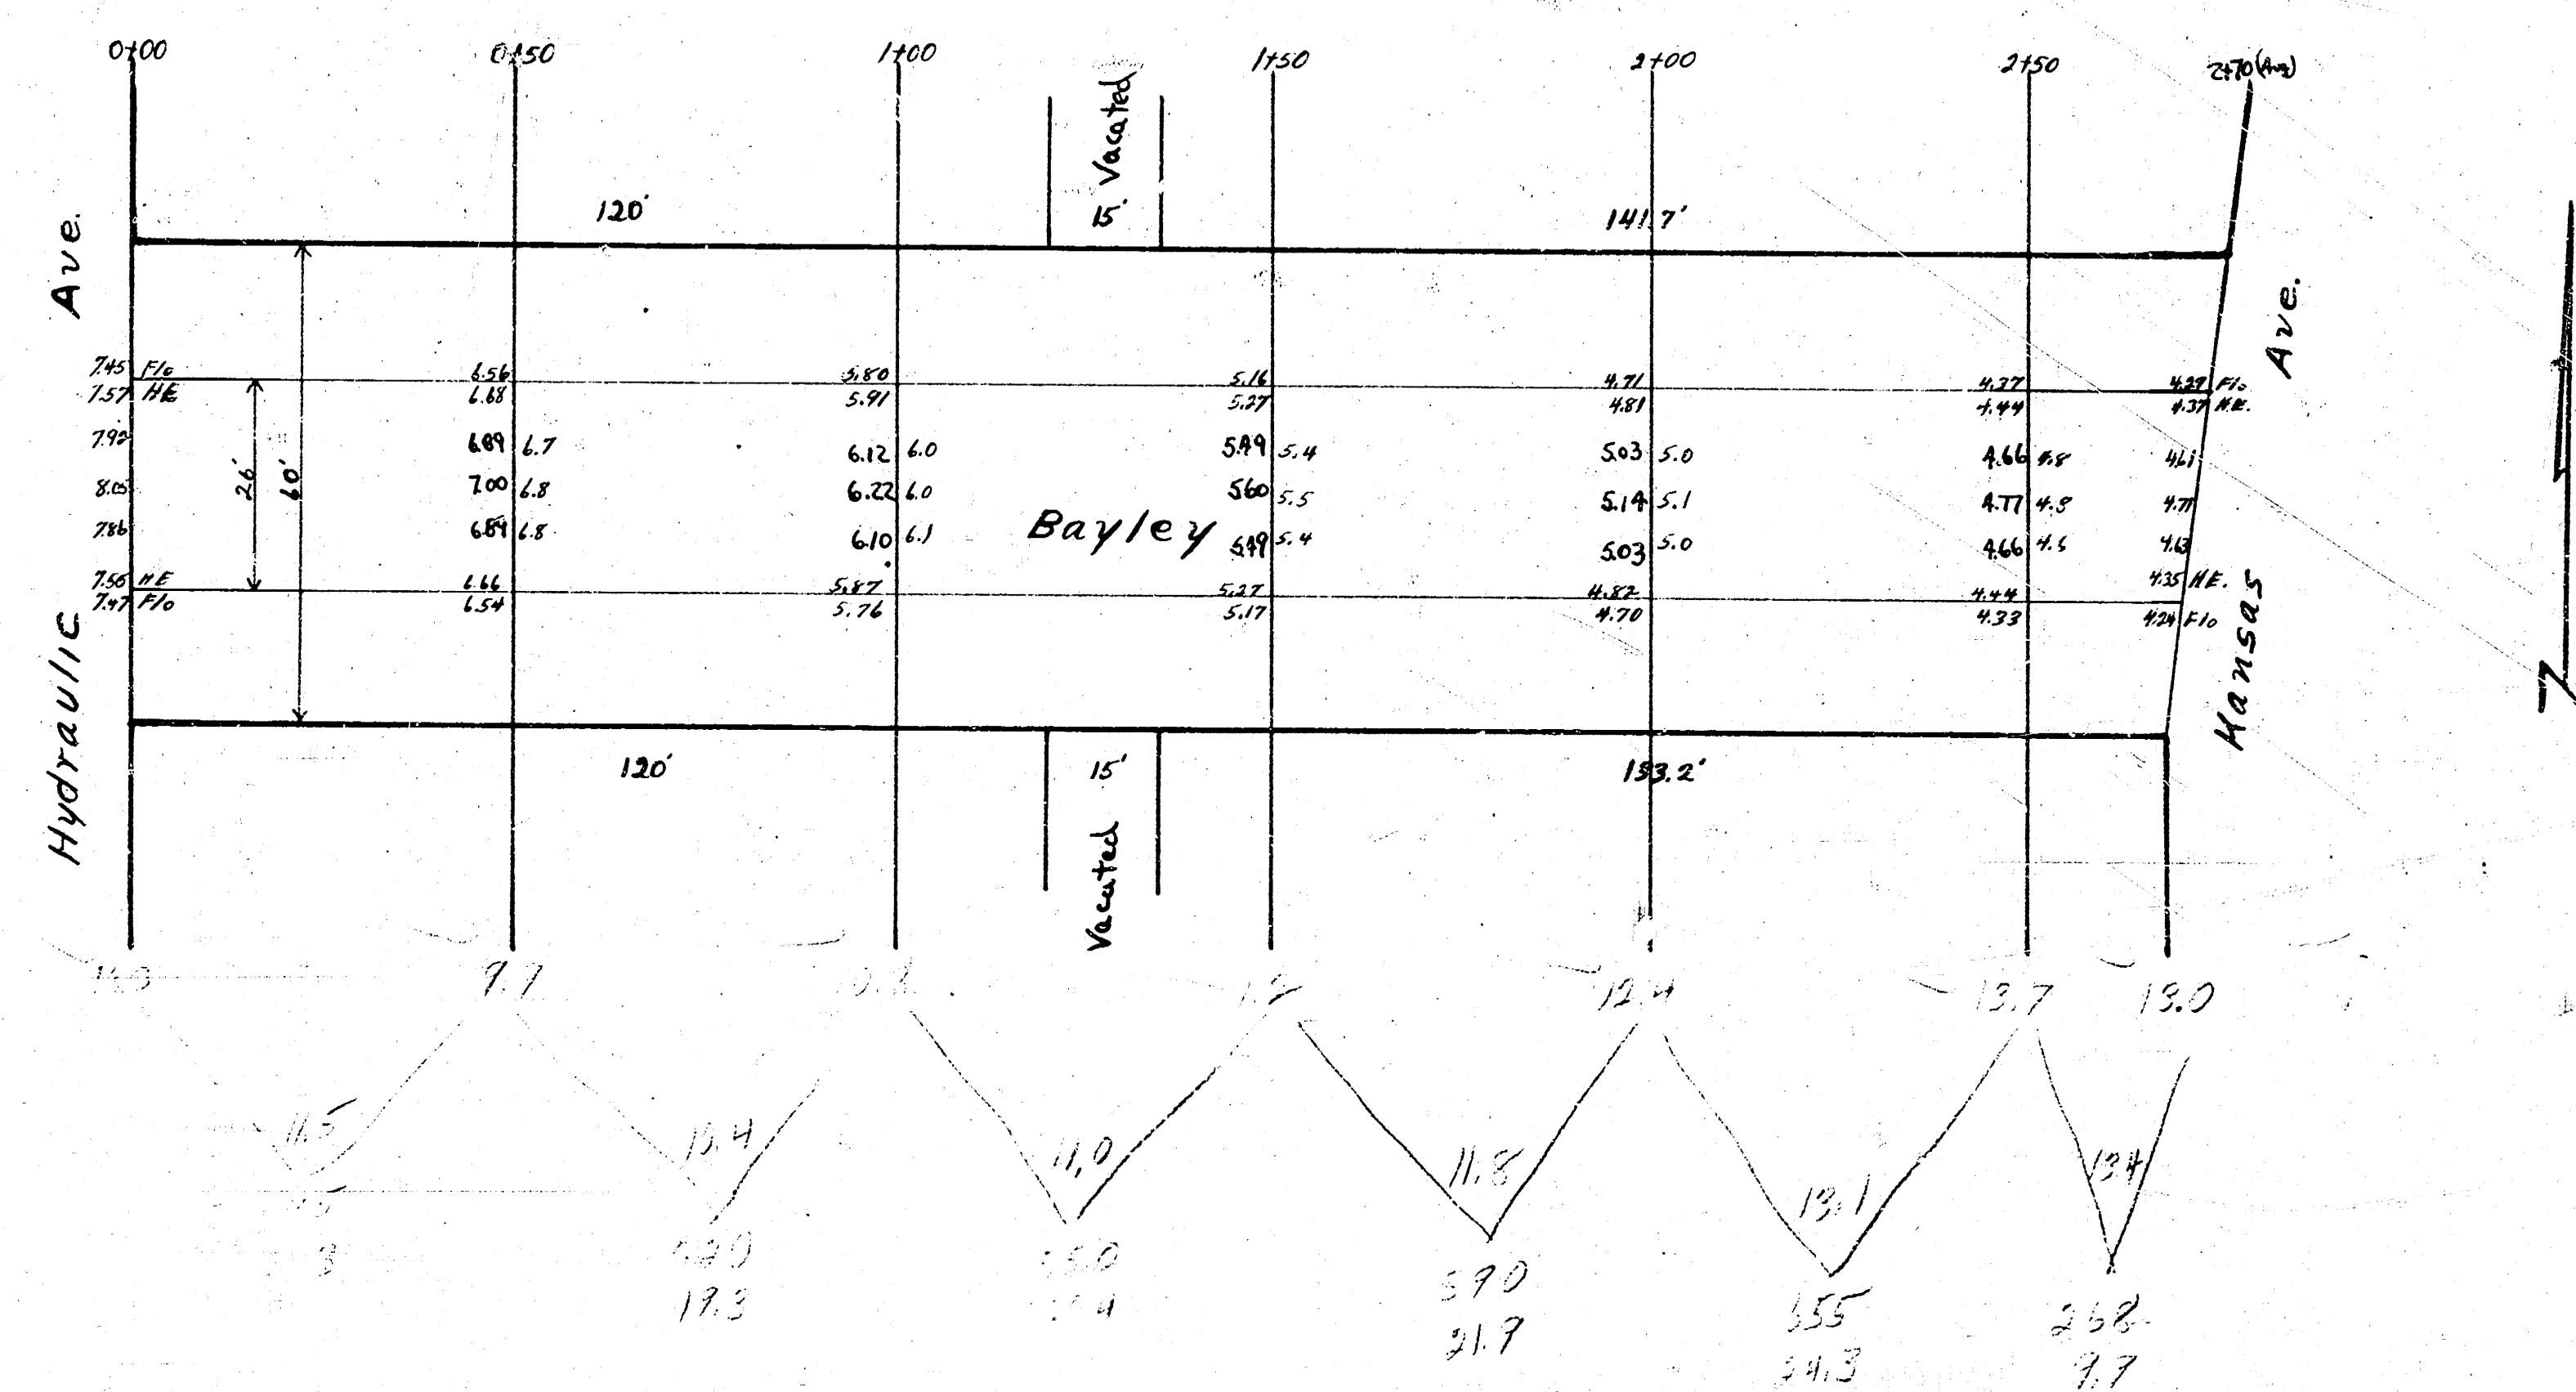

Bayley
 EL Hydraulic WL Kansas
 26' Conc.
 City of Wichita, Kansas
 L.M. White City Engineer
 November 1947 Project C17-144

