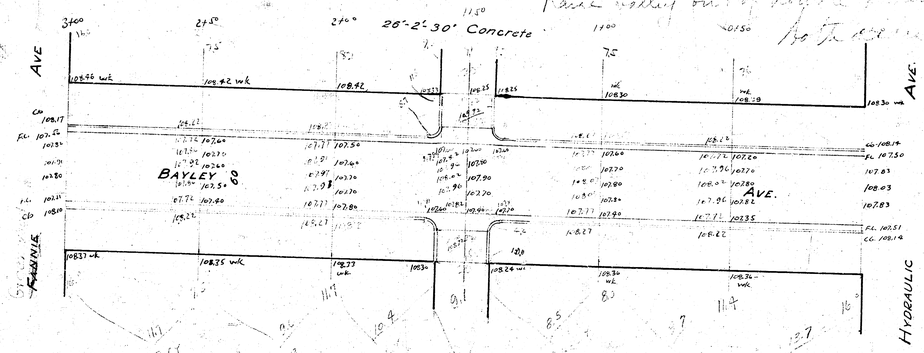
28'-2'-30' Concrete
BAYLEY
AVE.
AVE.
HYDRAULIC