


BM 10799 T in Tree Top Hyd. N.M. Cr. Ellis & Bayley

Property	City
37.4	18.7
43.1	5.4
35.4	5.2
36.6	30.0
34.1	710.0
35.5	33.0
37.3	
335.2	Con't.

NOTE: REMOVE WALL IN ALLEYS TO INSTALL RETURNS.

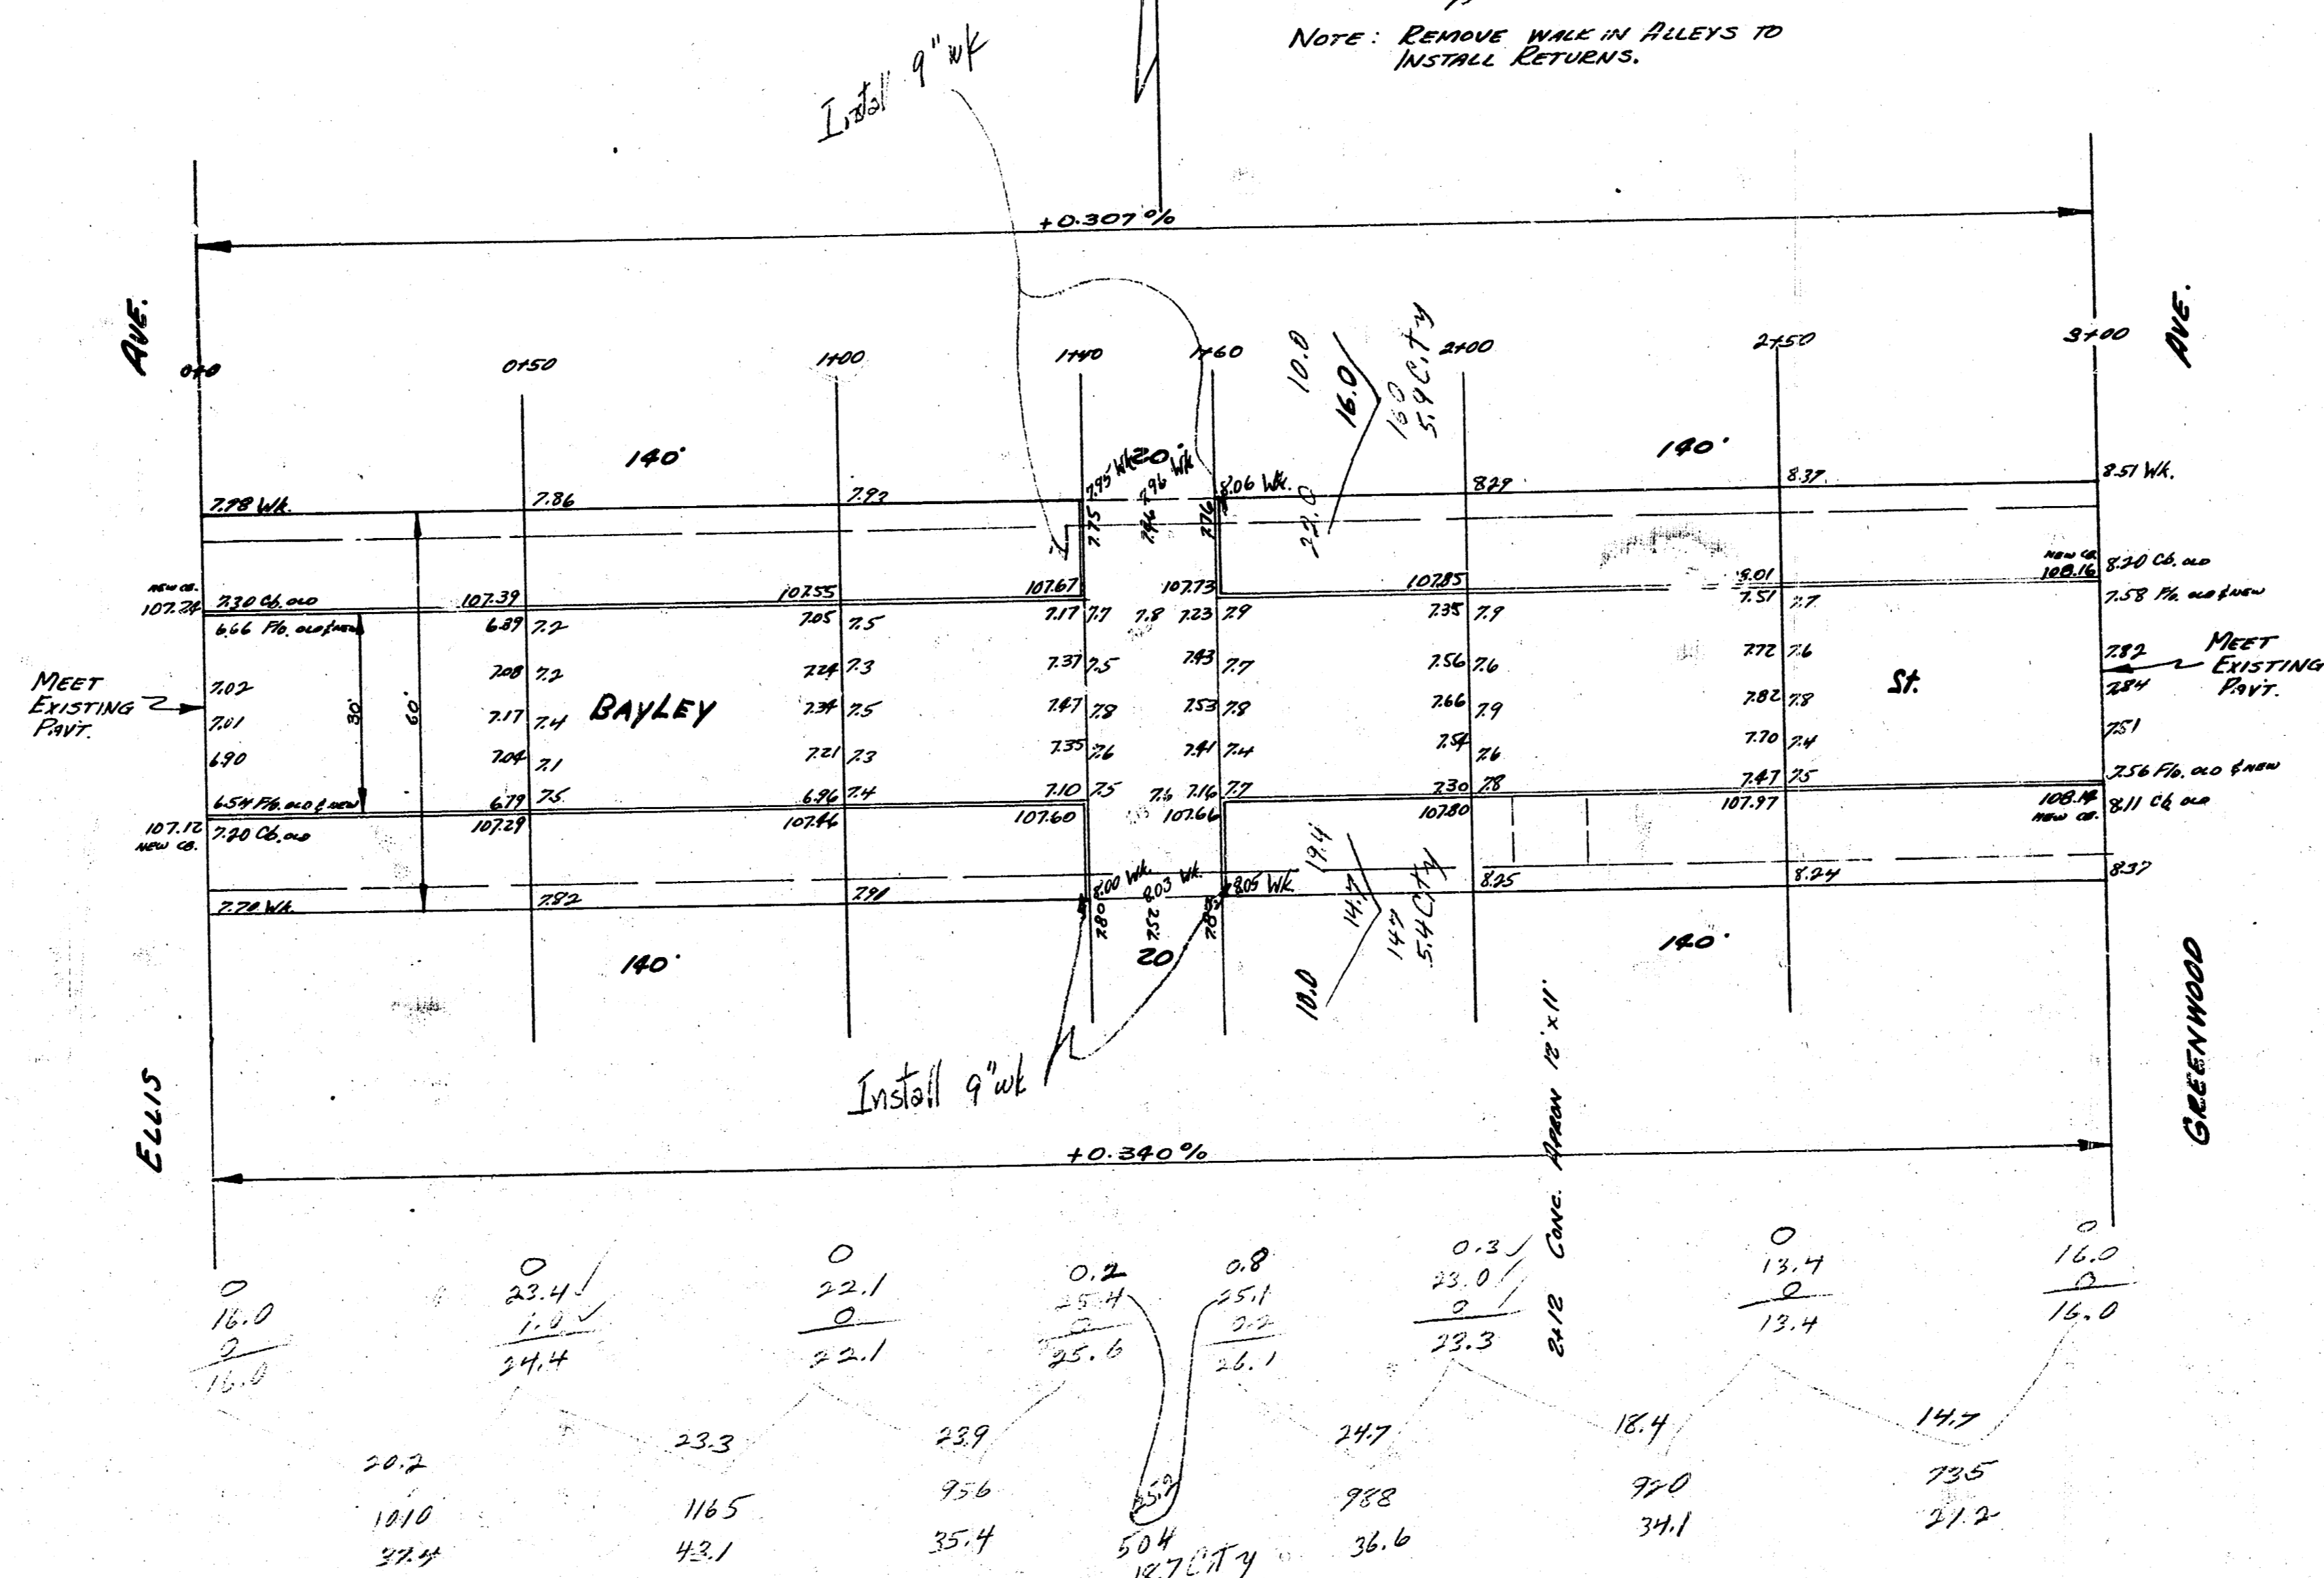

BAYLEY ST.
 E.L. ELLIS TO W.L. GREENWOOD
 30' CONC. & CO.
 CITY OF WICHITA, KANSAS
 L.K. WHITE CITY ENGINEER
 MAY 1949 PROJ. C19-93

4 1 4 3