


B.M. 153.00 S.W. COR. CONC. PAVCH. HO. # 858 So. LEAVOLA

NOTE: STATIONING IS ON S.P.L.

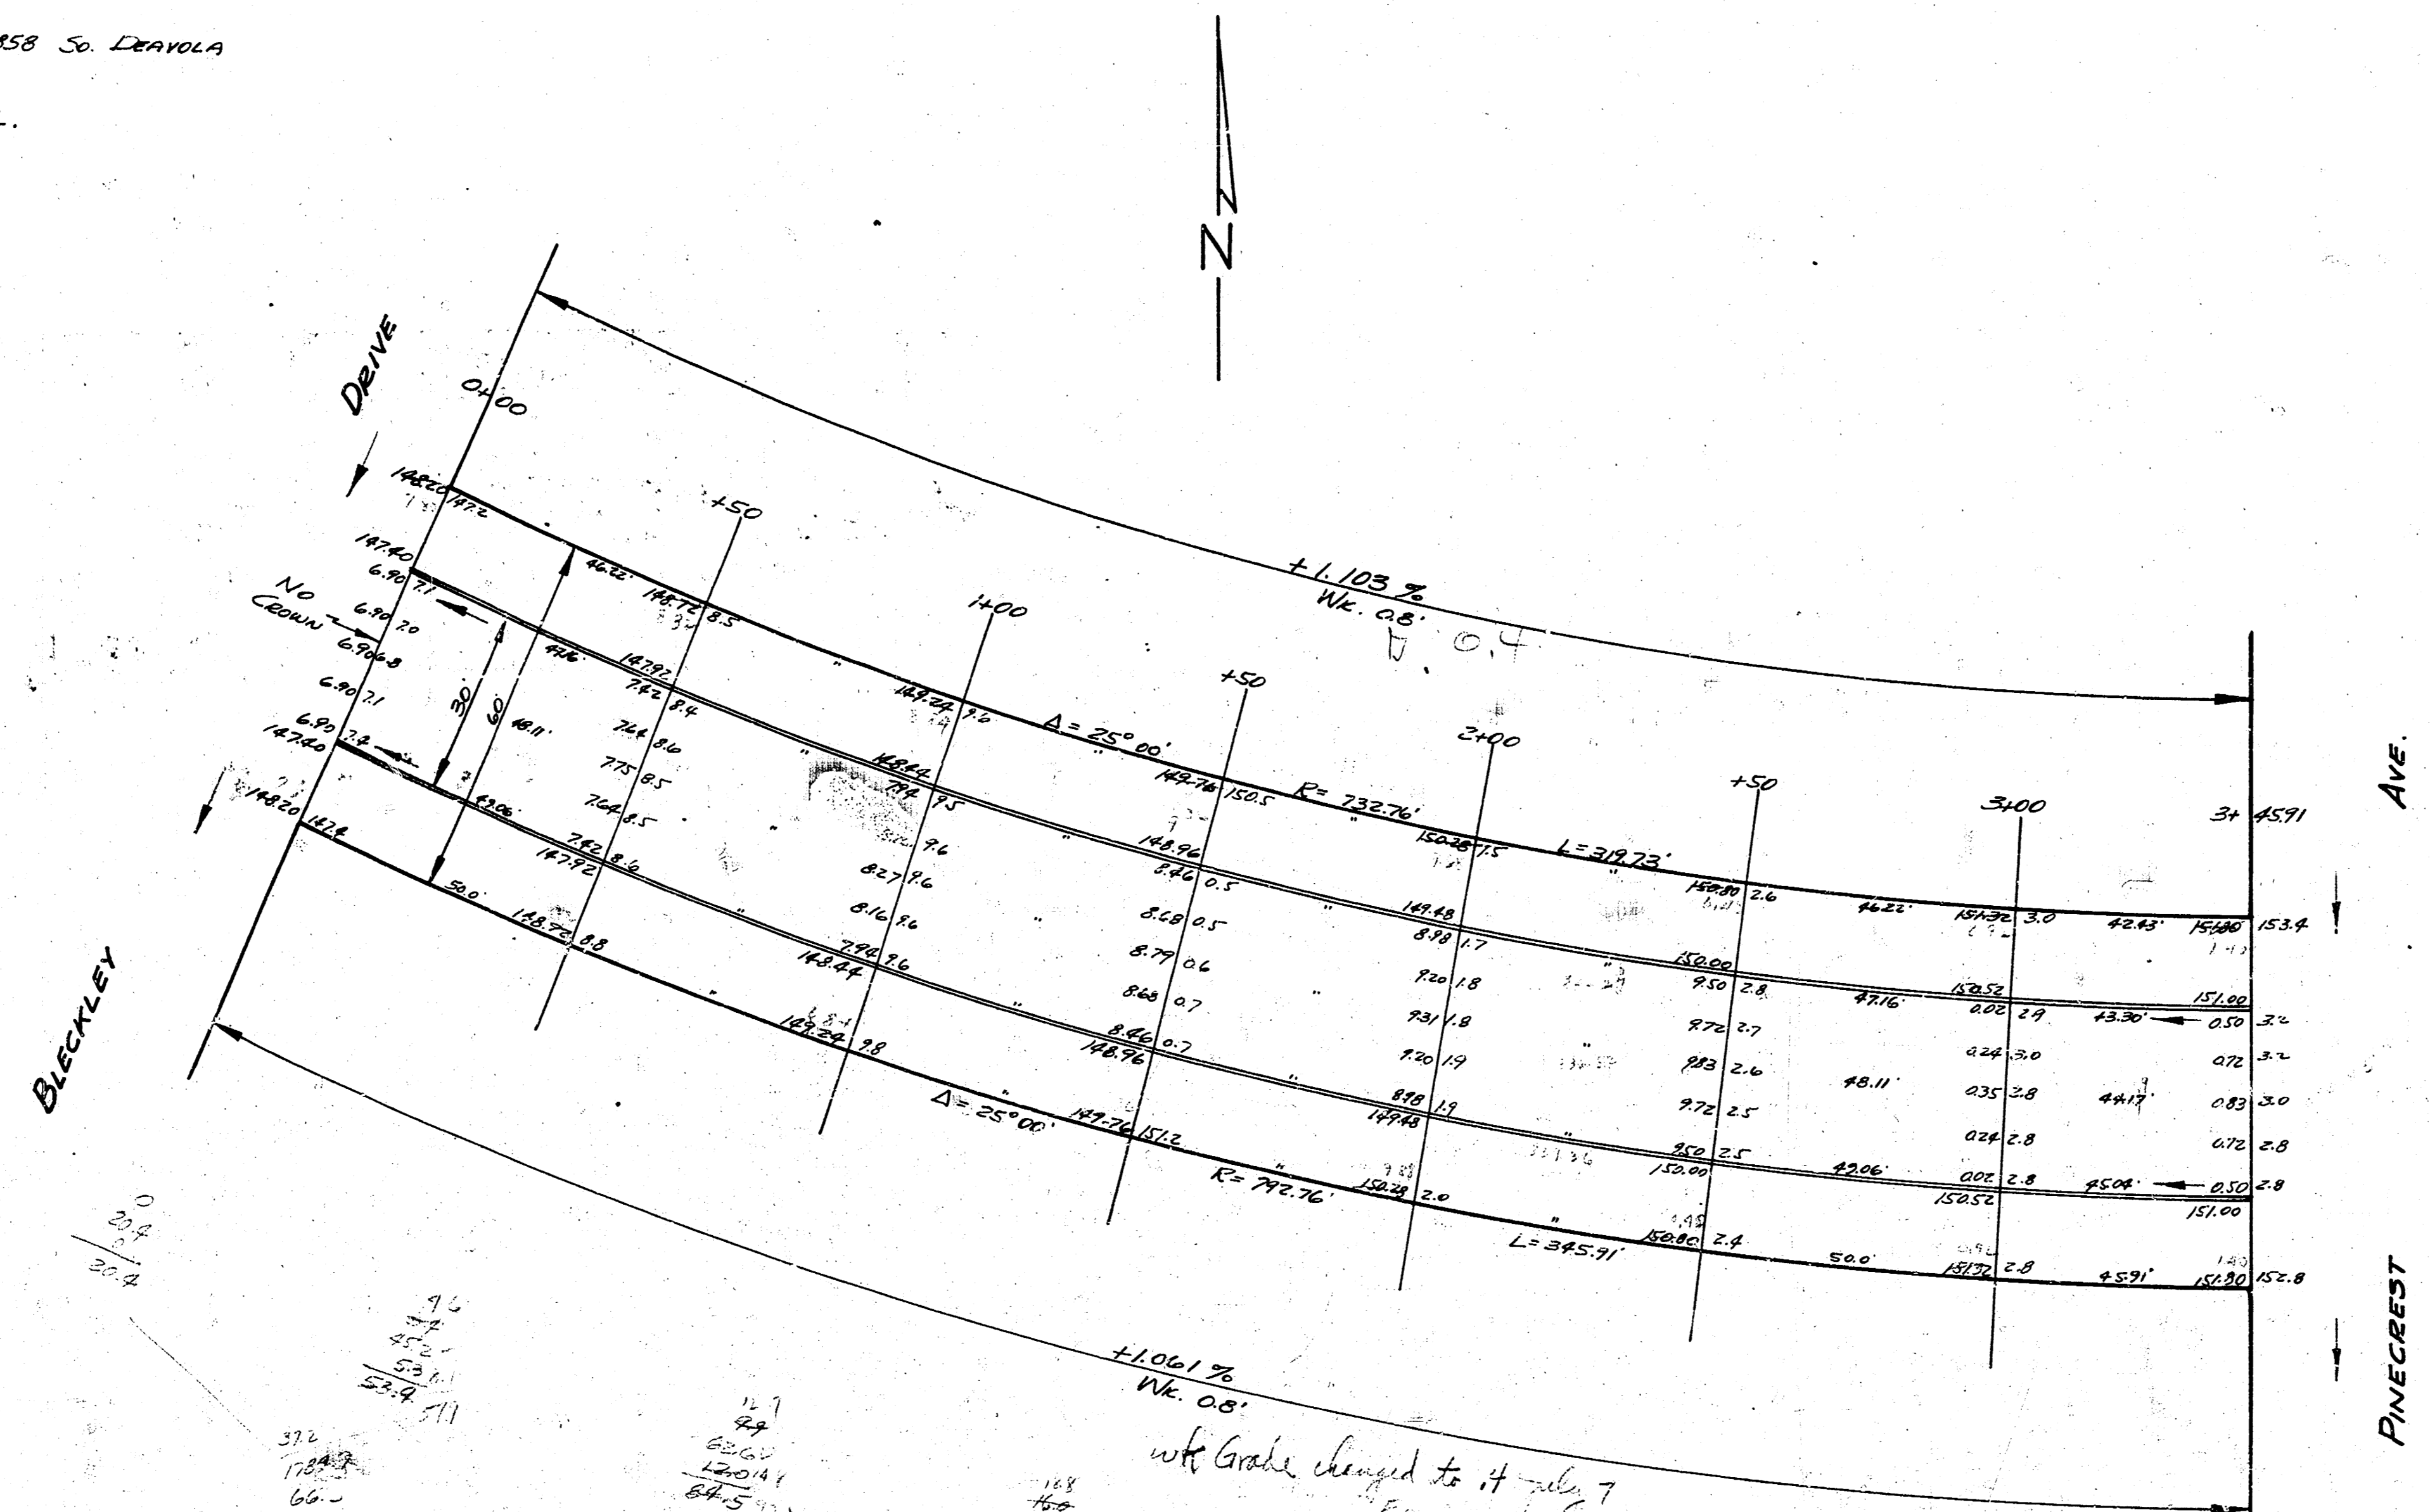

BLECKLEY

PINECREST AVE.

PINECREST

Wk Grade changed to it only 7  
Expansion embankment & soil

BAYLEY ST.  
W.L. PINECREST TO EL. BLECKLEY  
30' CONC. & CO.  
CITY OF WICHITA, KANSAS  
L. K. WHITE CITY ENGINEER  
SEPT. 1951 PROJ. C-11-54

