

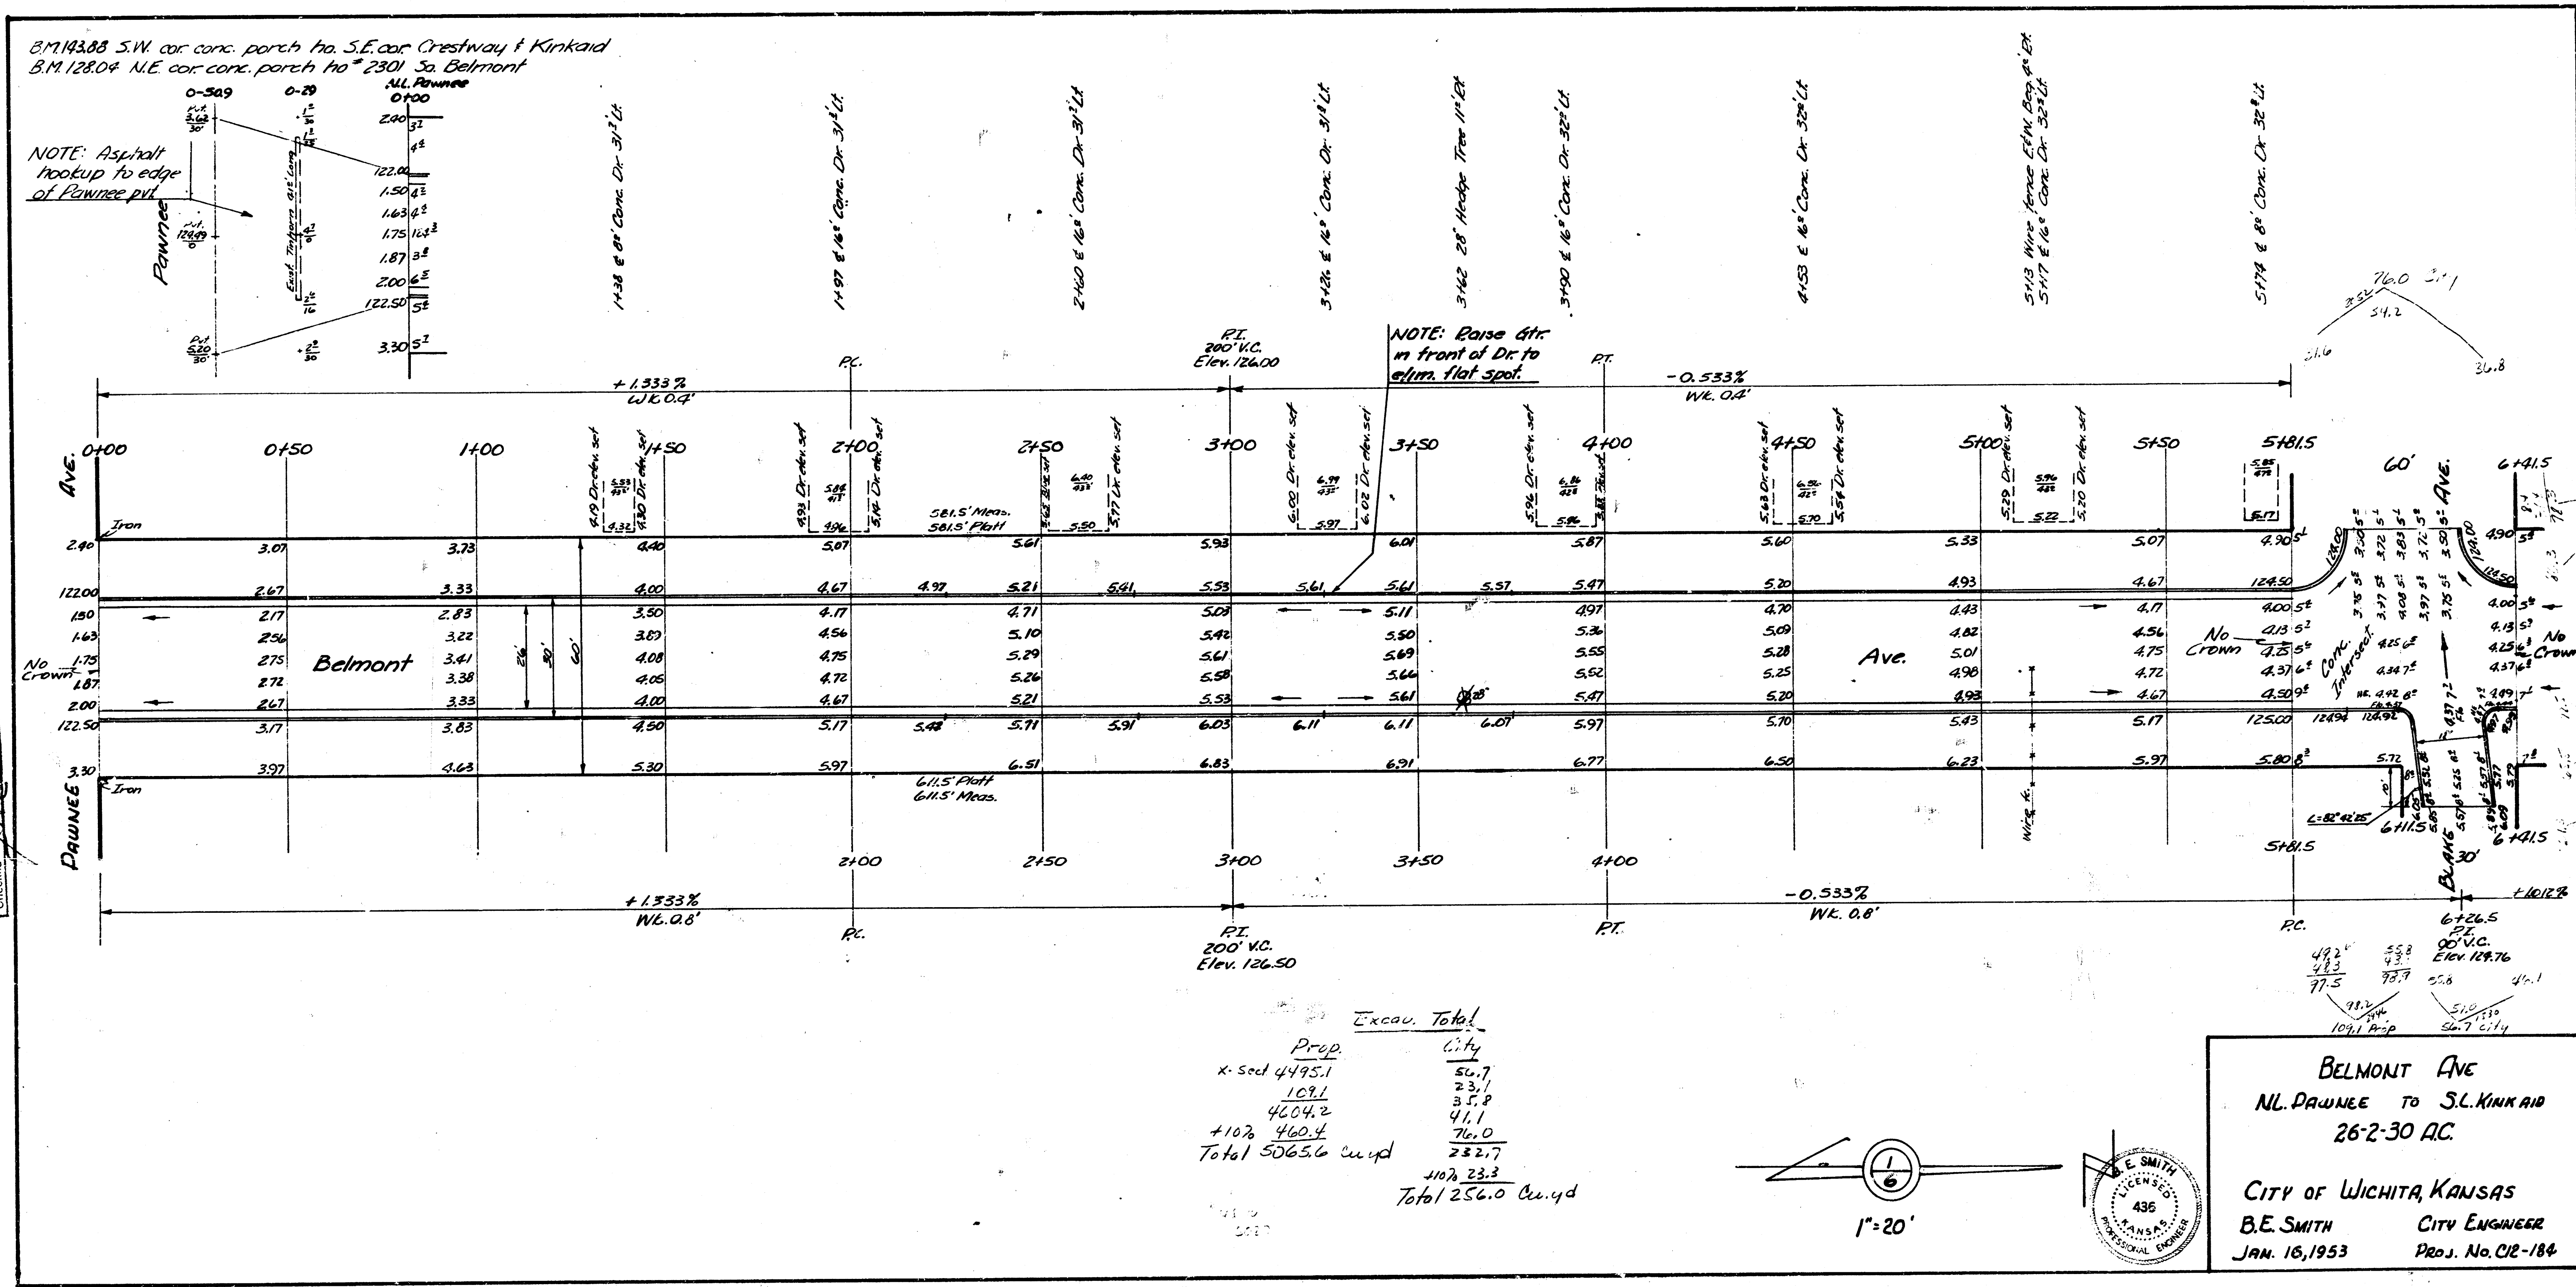


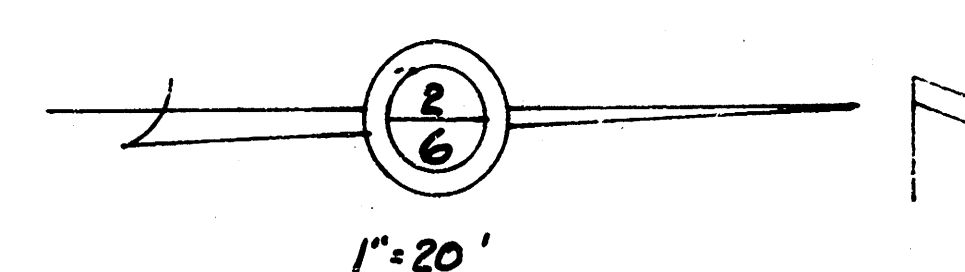

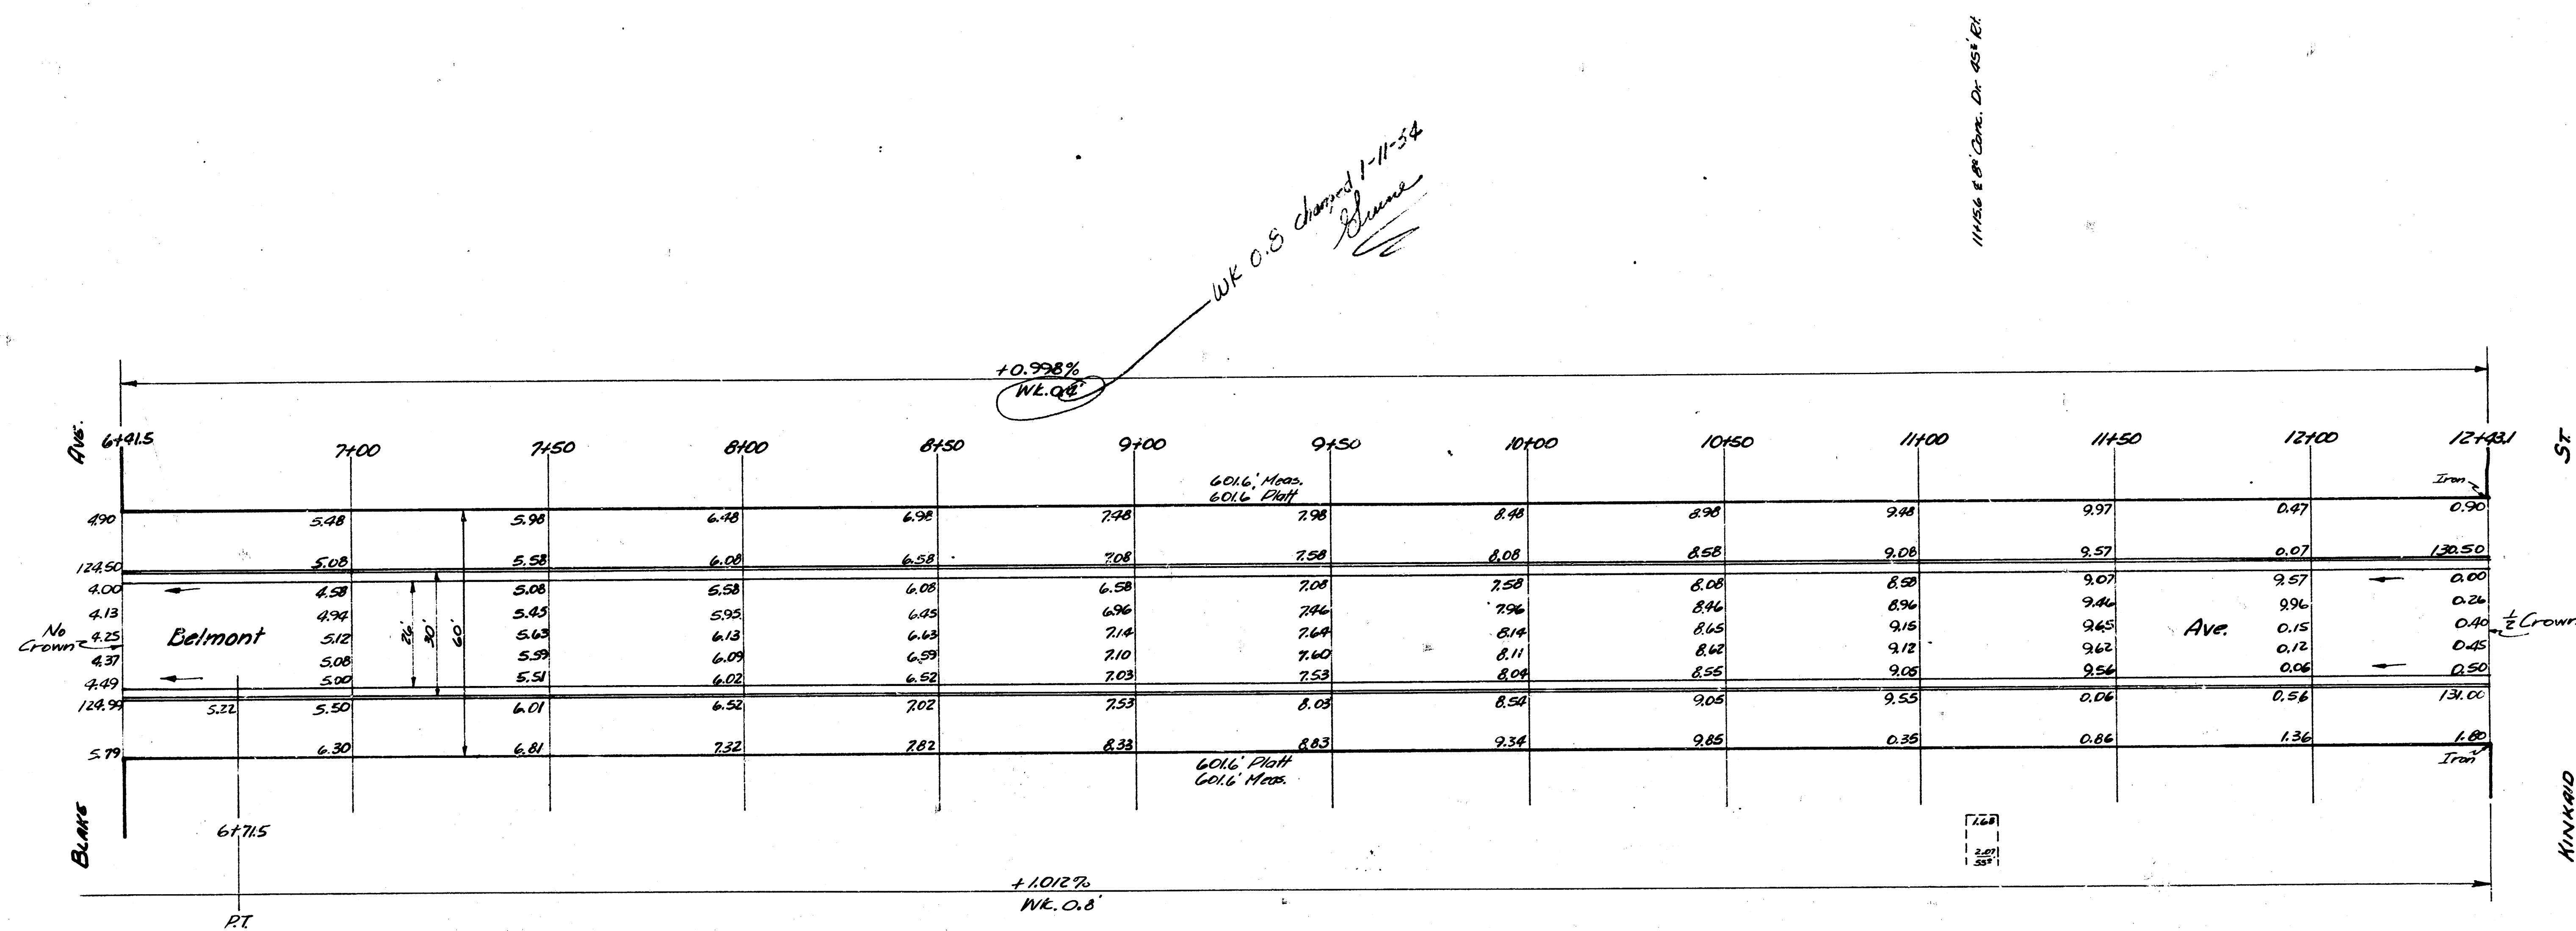

BELMONT AVE.