




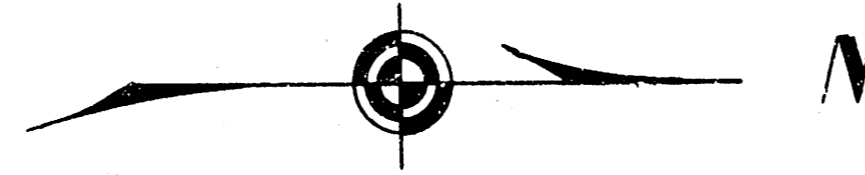

Stationing on west Prop. Line.

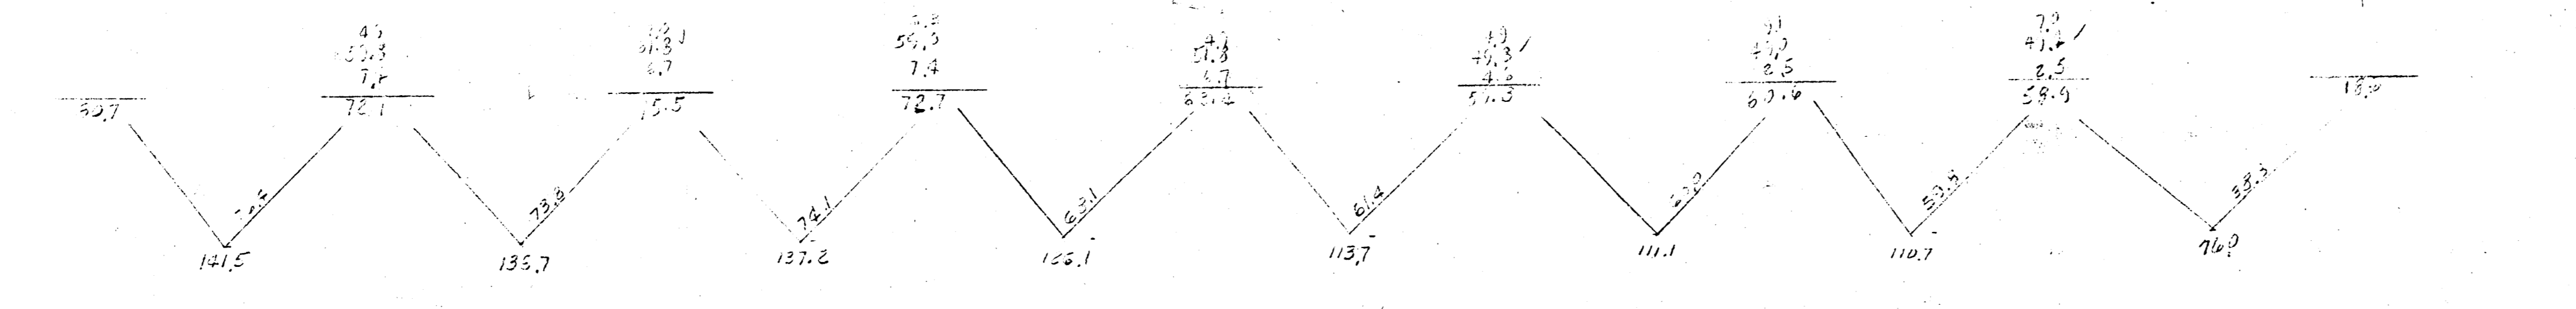


B.M. 10003 SE cor. Park Rd. # 2100 W. 29th.

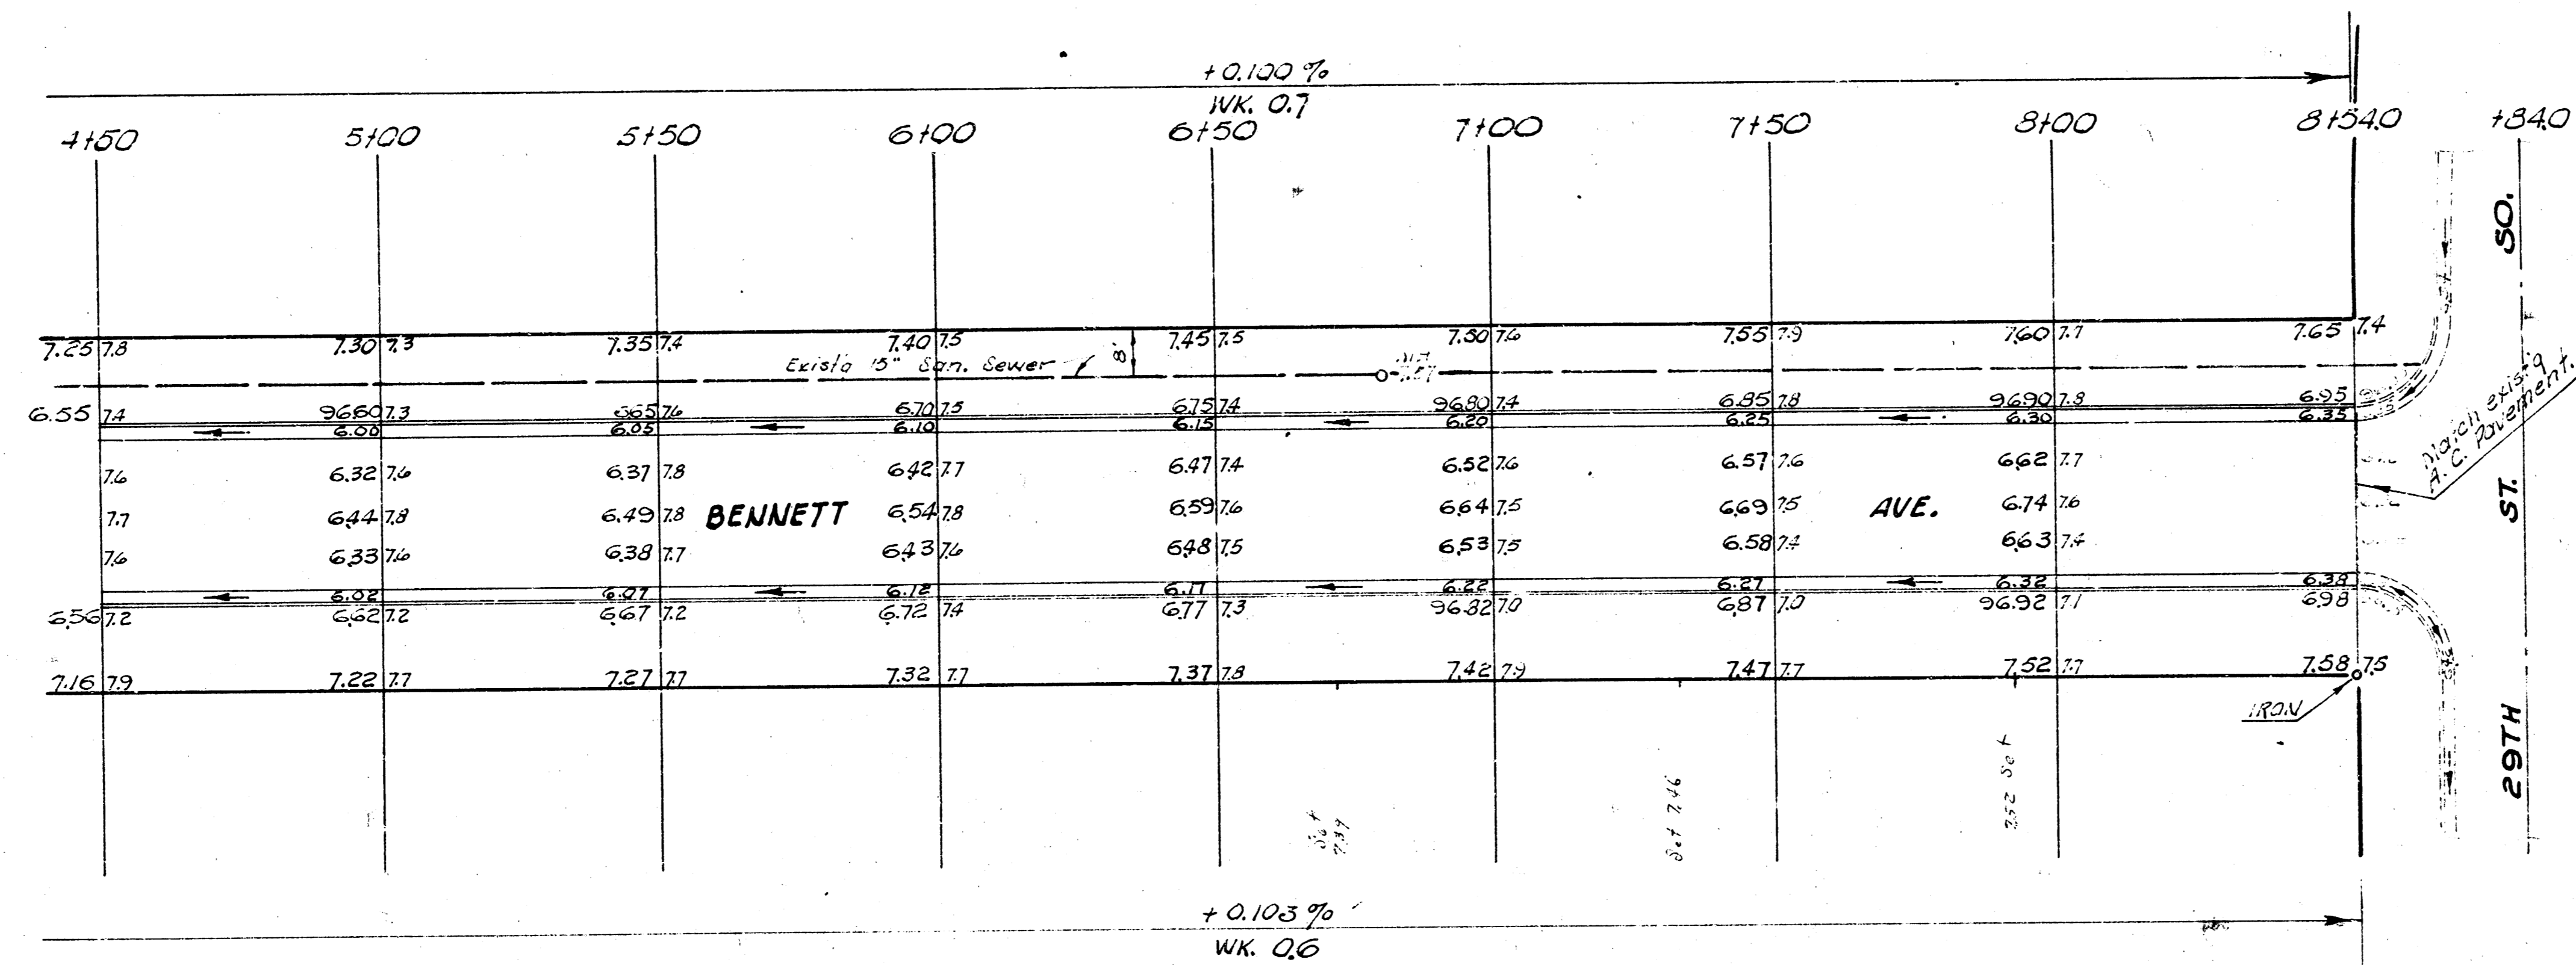

**BENNETT AVE.**  
30TH ST. SO. TO 29TH ST. SO.

PROJ. NO. C14-270

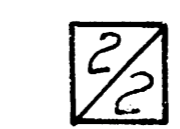

10 9 1 9