


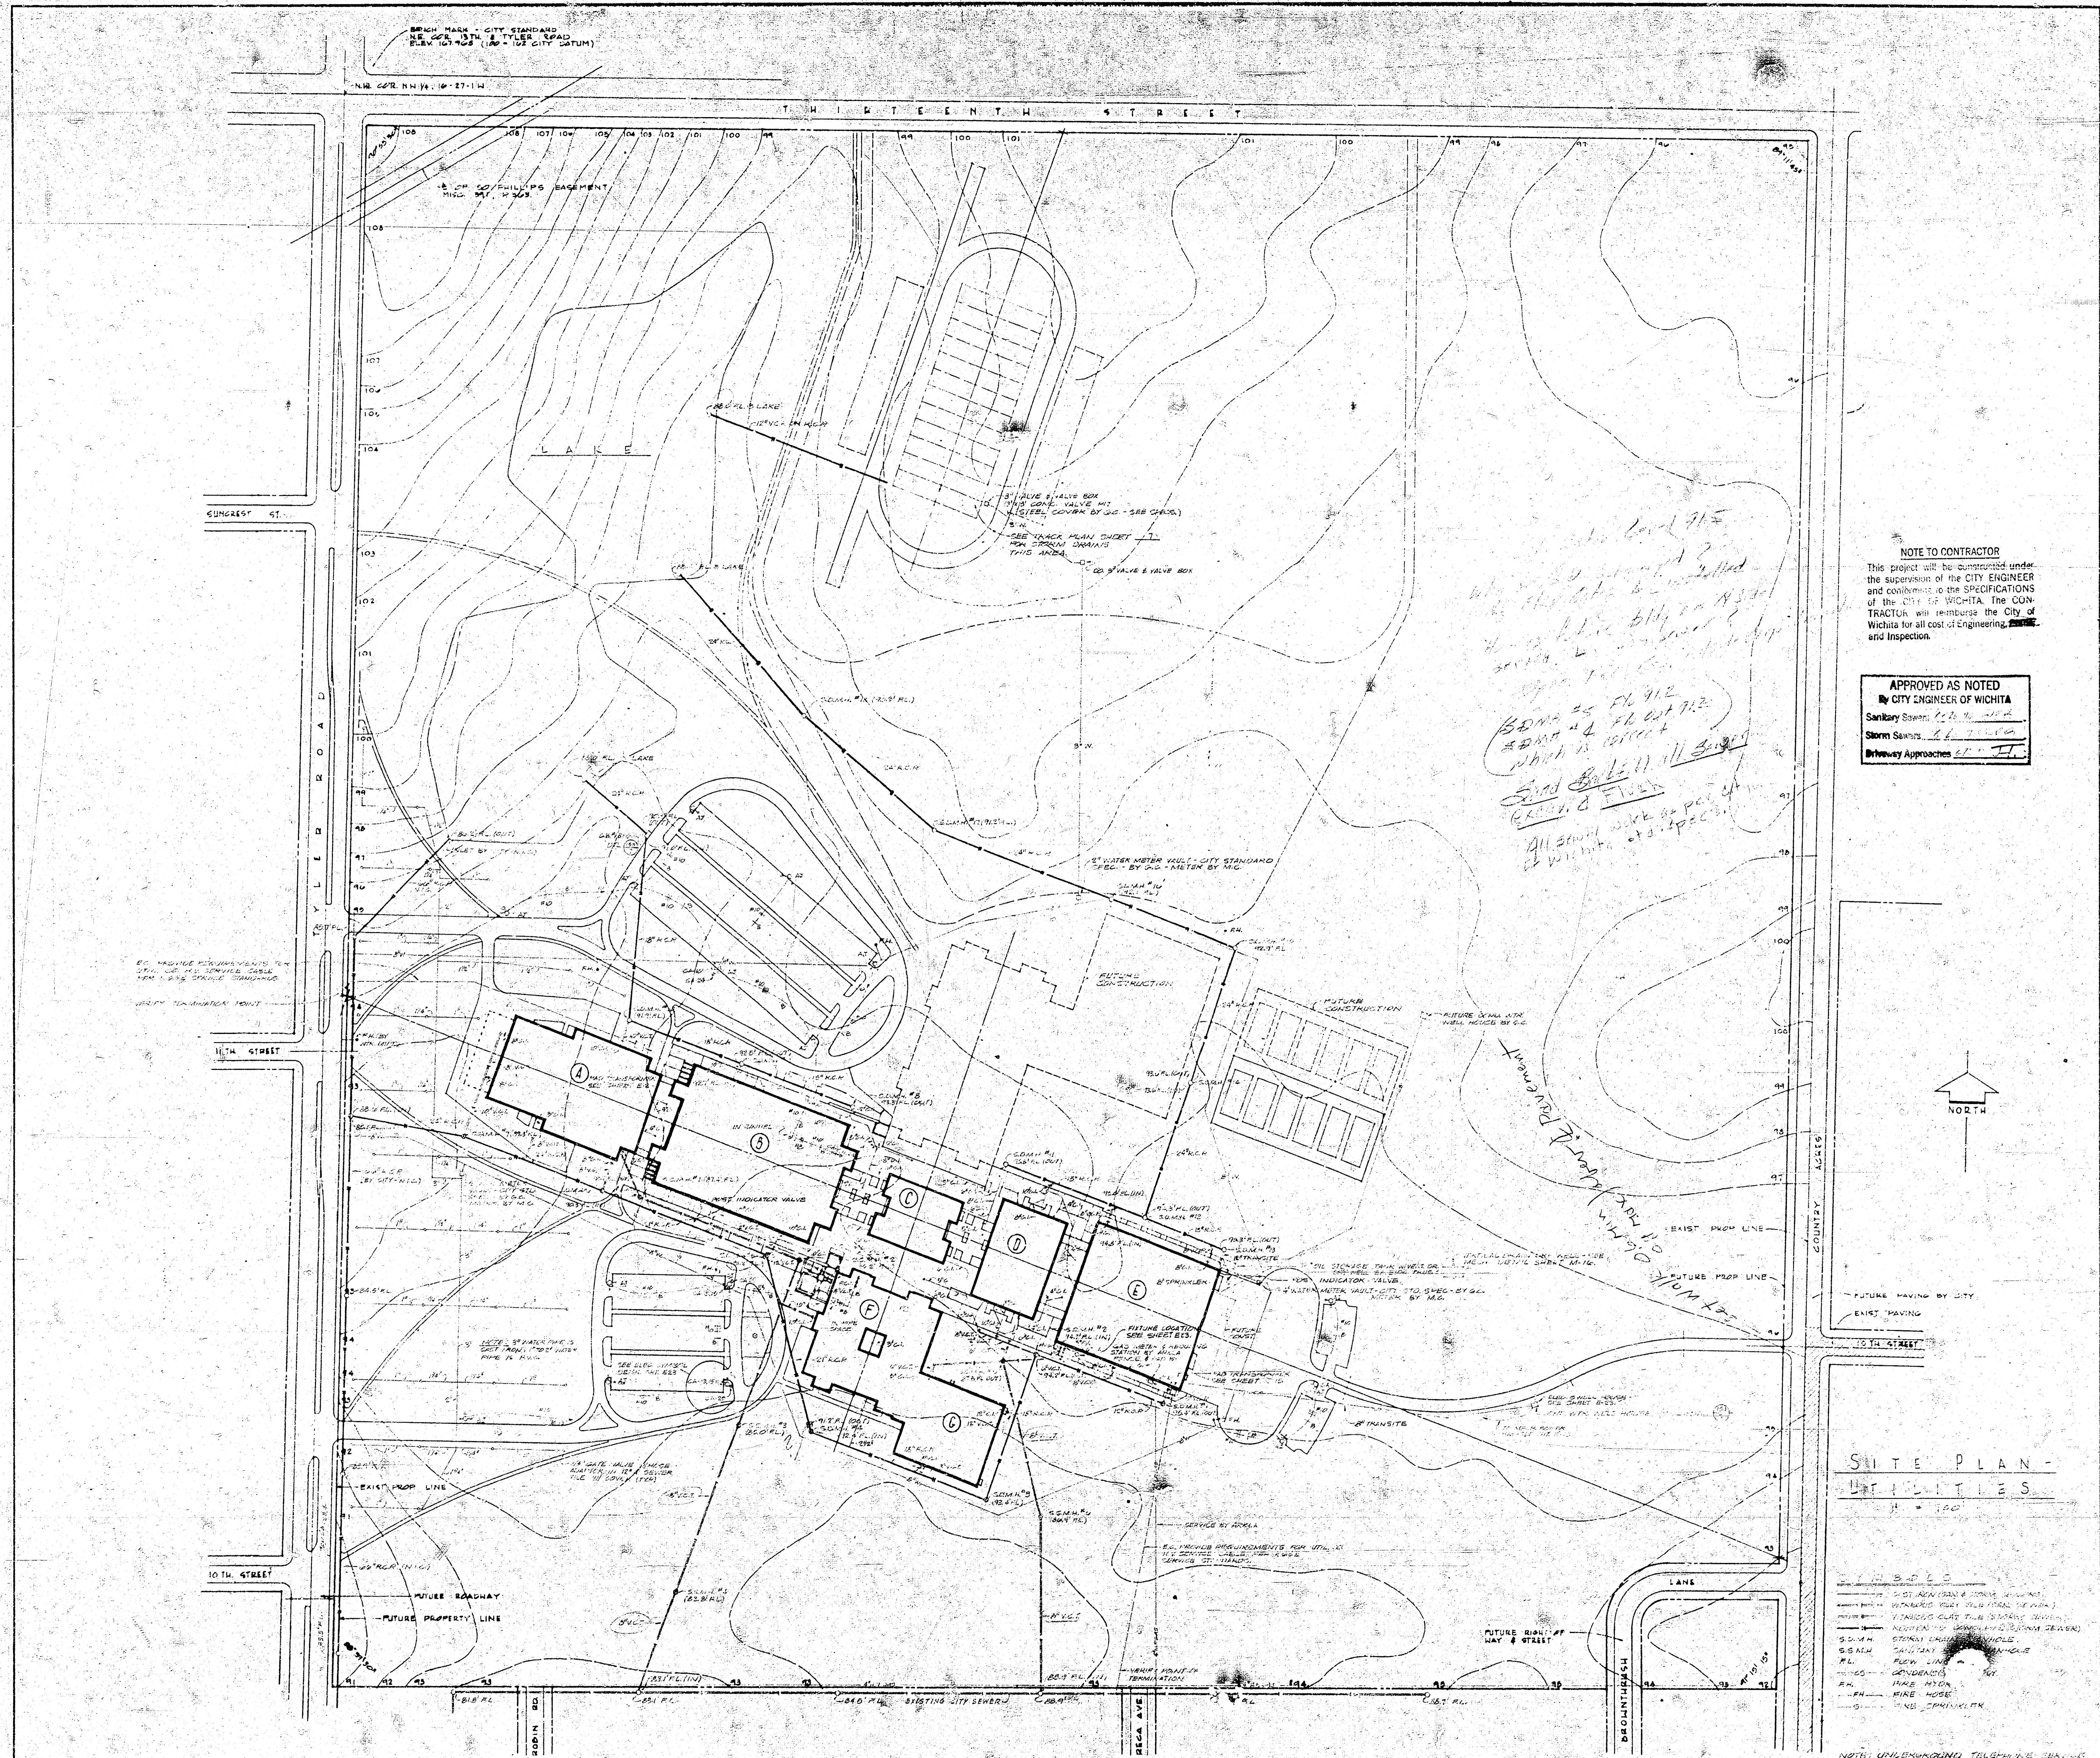

NOTE TO CONTRACTOR
This project will be constructed under the supervision of the CITY ENGINEER and conform to the SPECIFICATIONS of the CITY OF WICHITA. The CONTRACTOR will reimburse the City of Wichita for all cost of Engineering, and Inspection.

APPROVED AS NOTED
By CITY ENGINEER OF WICHITA
Sanitary Sewers: 12.12.10
Storm Sewers: 12.12.10
Highway Approaches: 12.12.10

U.S.D. NO. 259
PHASE ONE
NORTHWEST SECONDARY SCHOOLS
THIRTEENTH STREET AT TYLER ROAD, WICHITA, KANSAS

FILE NO. 7000
DATE DR. CR

GLENN E. BENDICK
architect
ALL 1830 LAURA WICHITA
KANSAS
SHEET 4 OF 60



U.S.D. NO. 259

PHASE ONE

NORTHWEST SECONDARY SCHOOLS

THIRTEENTH STREET AT TYLER ROAD, WICHITA, KANSAS


FILE NO.
DATE
DR. CH



SHEET

3

60

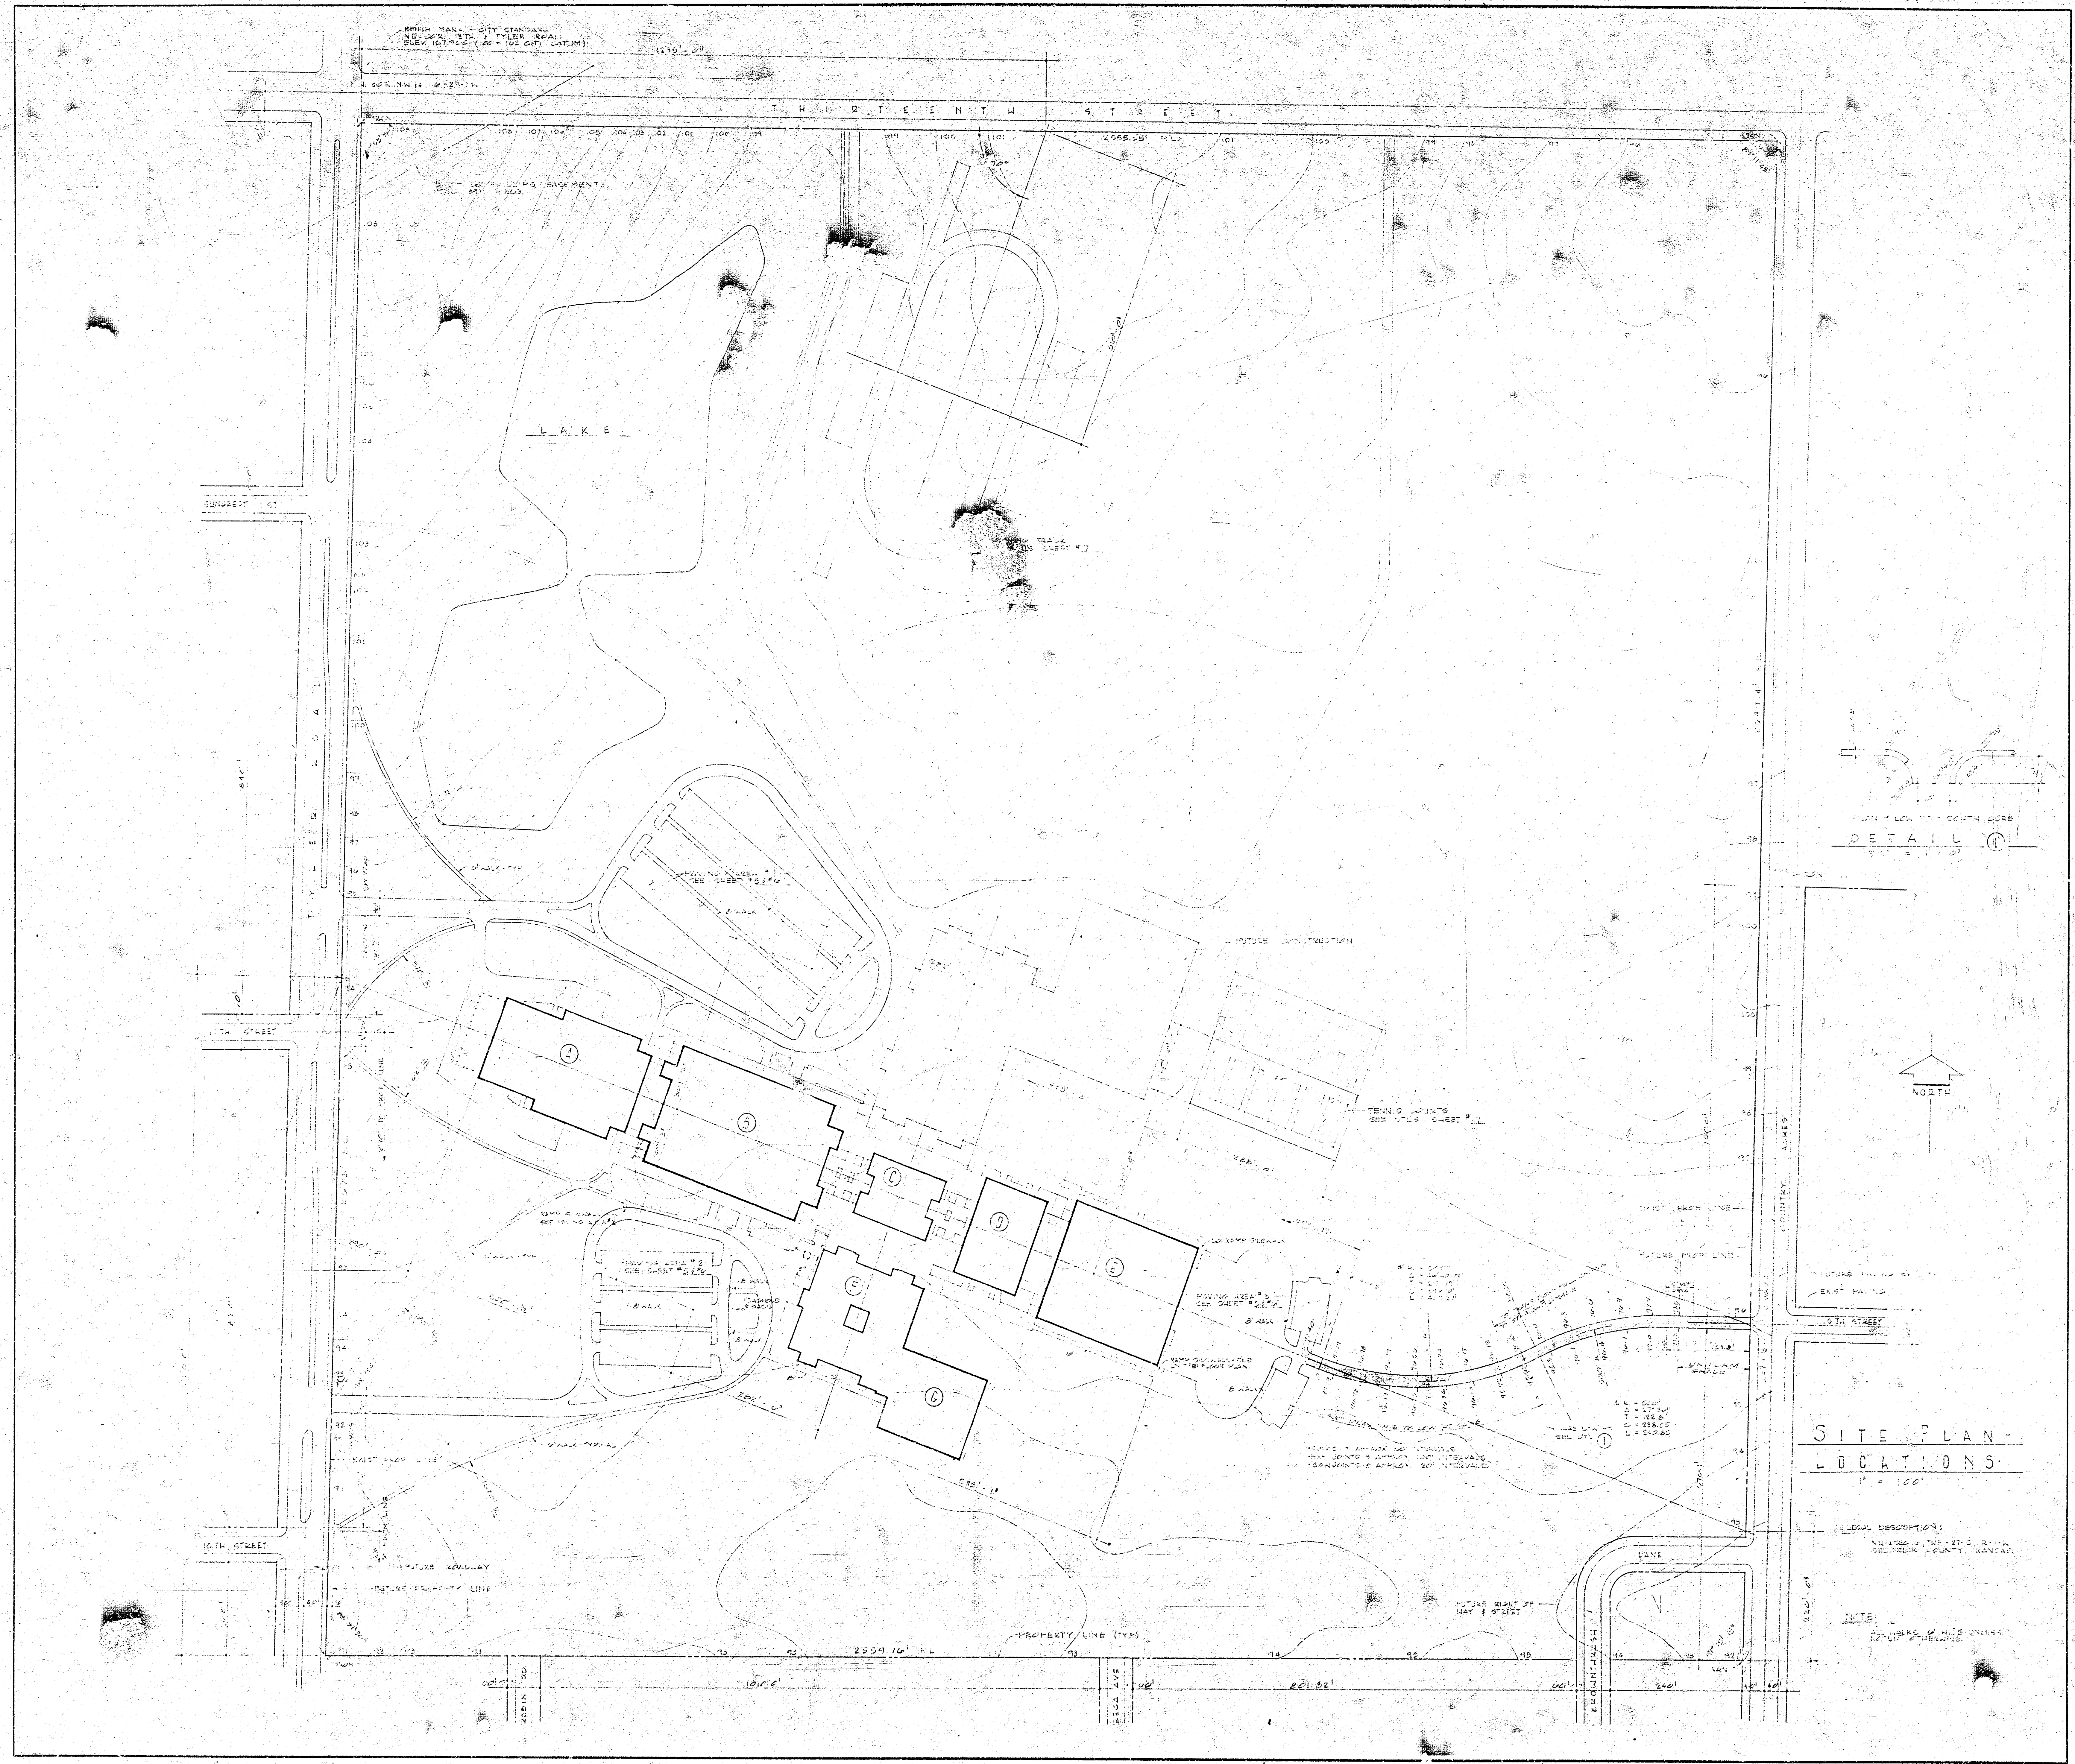

PHASE ONE
NORTHWEST SECONDARY SCHOOLS
THIRTEENTH STREET AT TYLER ROAD, WICHITA, KANSAS

FILE NO.
DATE
DR. CK.
GLENN E. BENEDICK
architect
AIA 230-1400 WICHITA
SHEET **2** OF 50