


1/10/10
1/10/10
1/10/10

FLOOR PLAN OF CITY HALL
WICHITA, KANSAS
SOUTH HALF OF THIRD FLOOR
CITY ENGINEER'S OFFICE DEC. 7, 1917

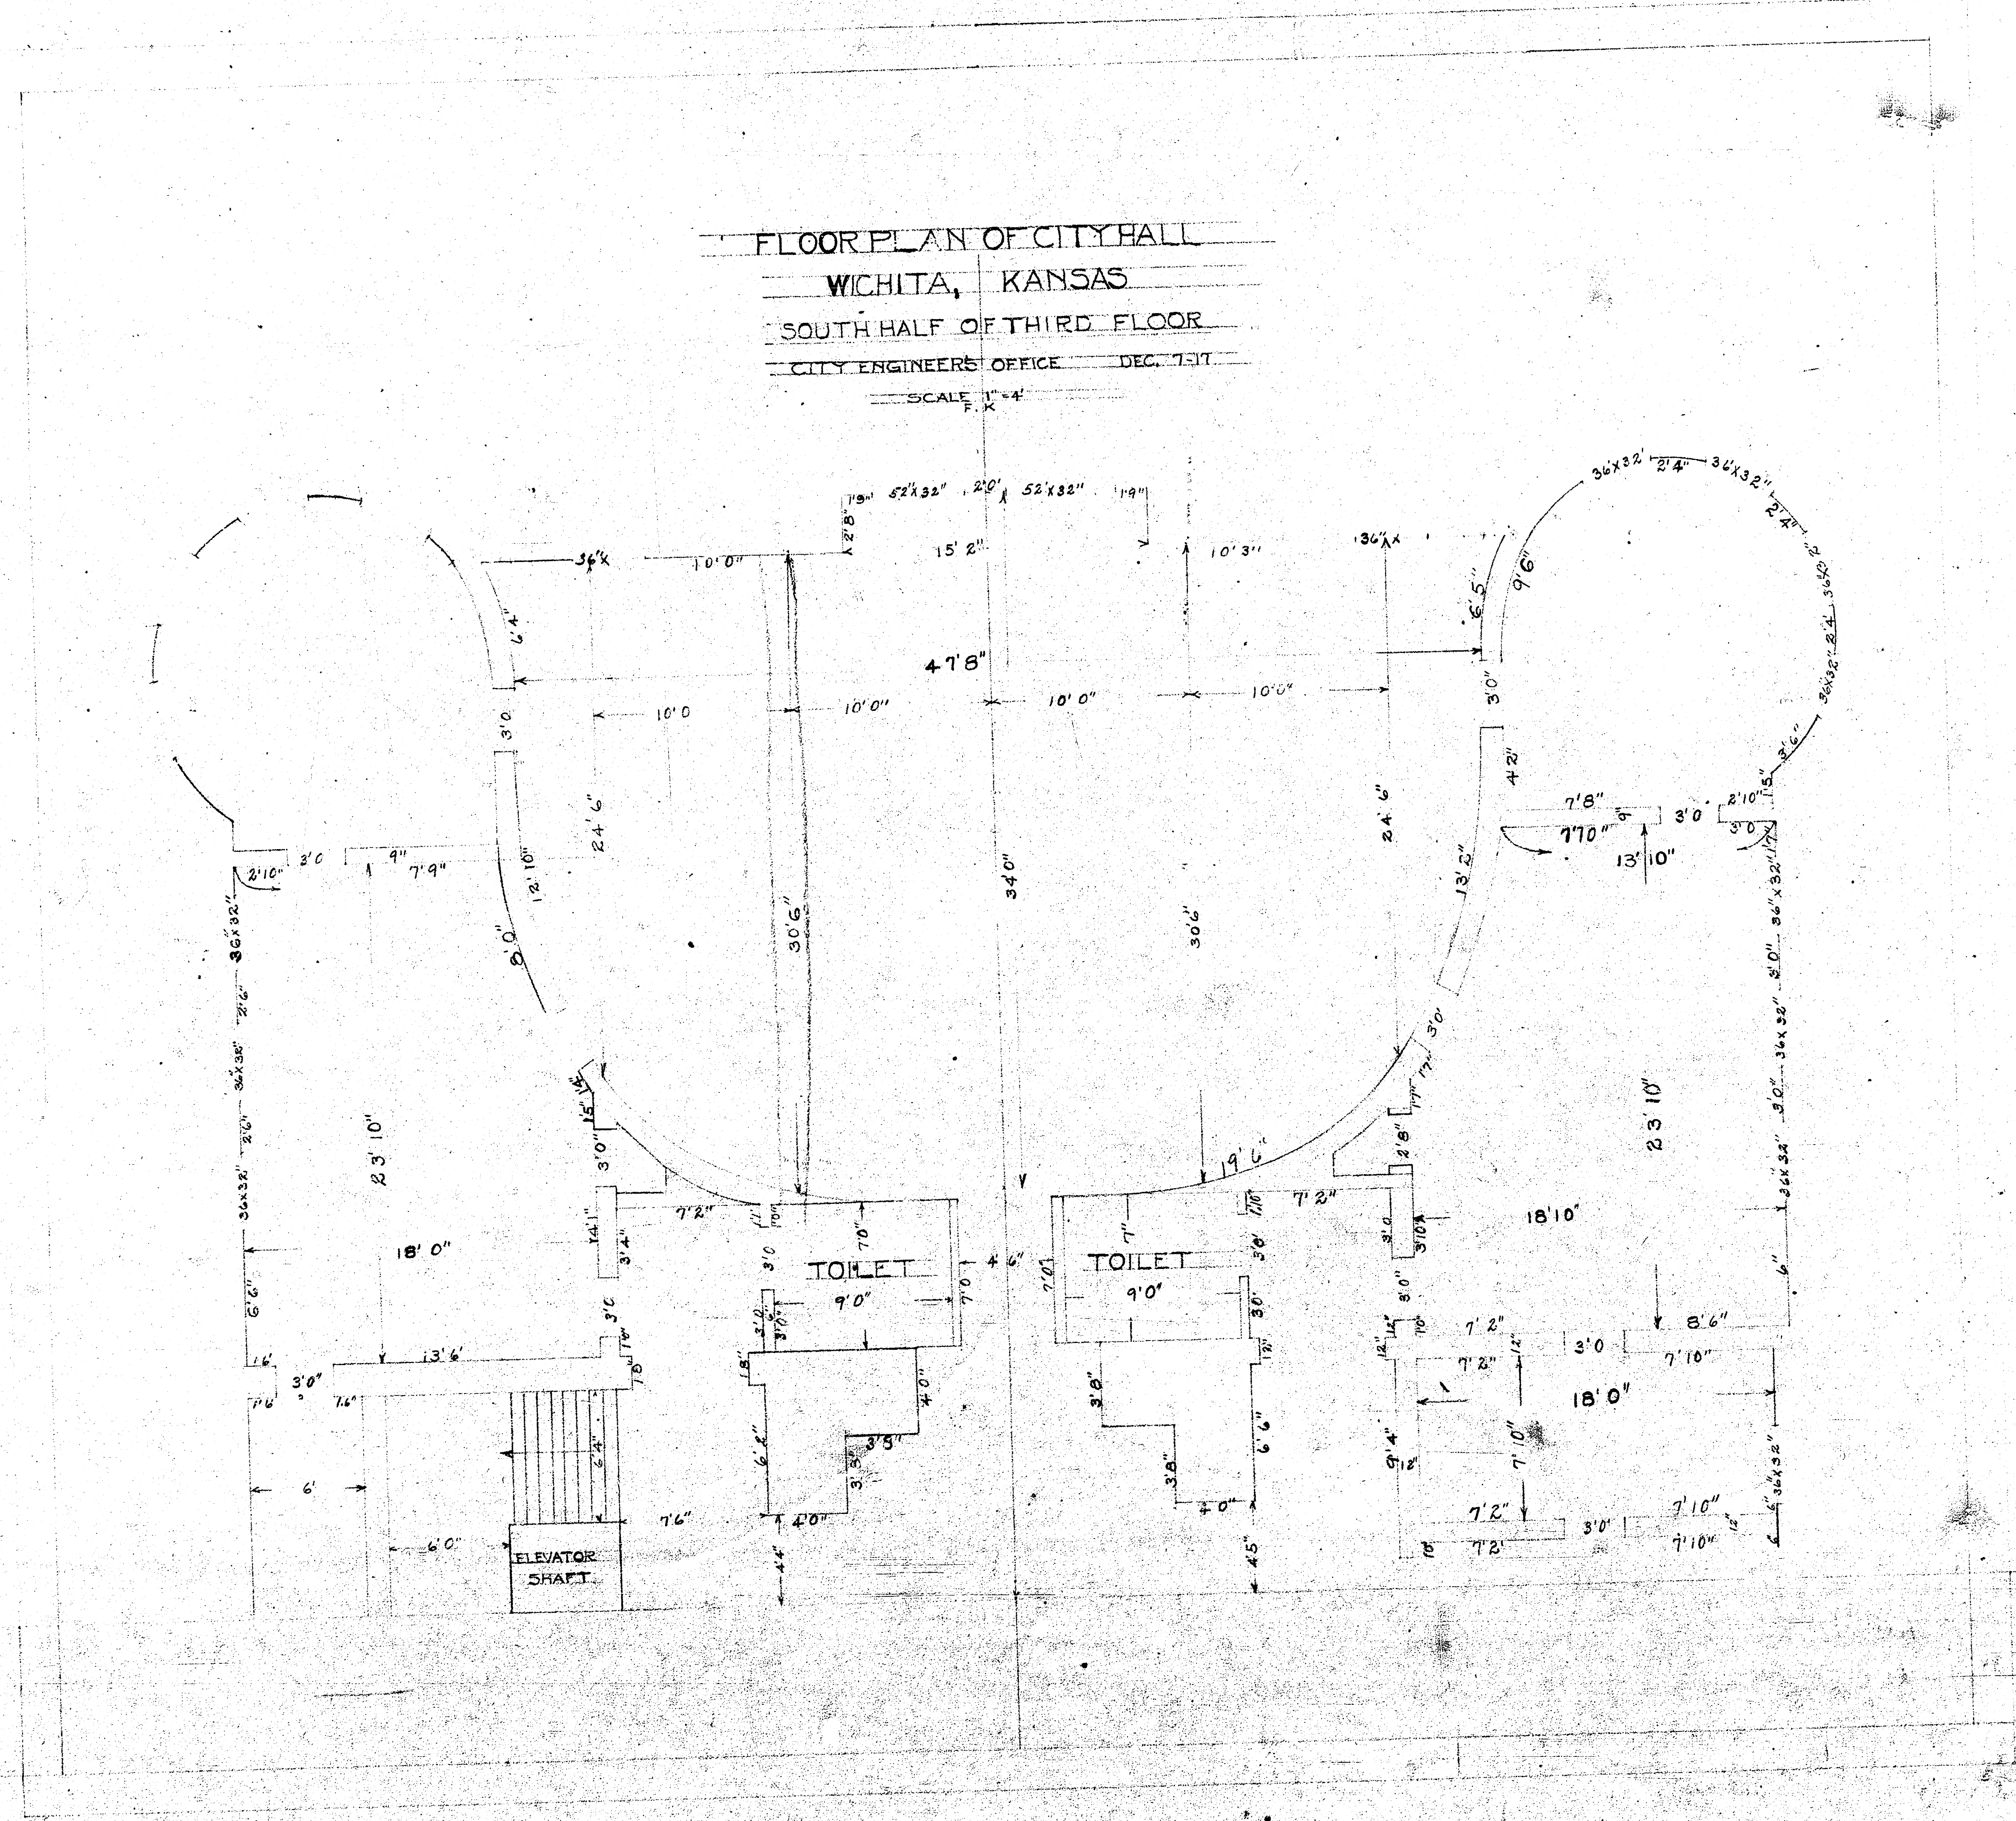

[illegible]

SOUTH HALF OF SECOND FLOOR
CITY ENGINEERS OFFICE DEC 8-7
SCALE 1"=4'
FK

