



1/10/10
1/10/10
1/10/10

FLOOR PLAN OF CITY HALL
WICHITA, KANSAS
SOUTH HALF OF THIRD FLOOR
CITY ENGINEER'S OFFICE DEC. 7, 1917
SCALE 1/4" = 1'-0"

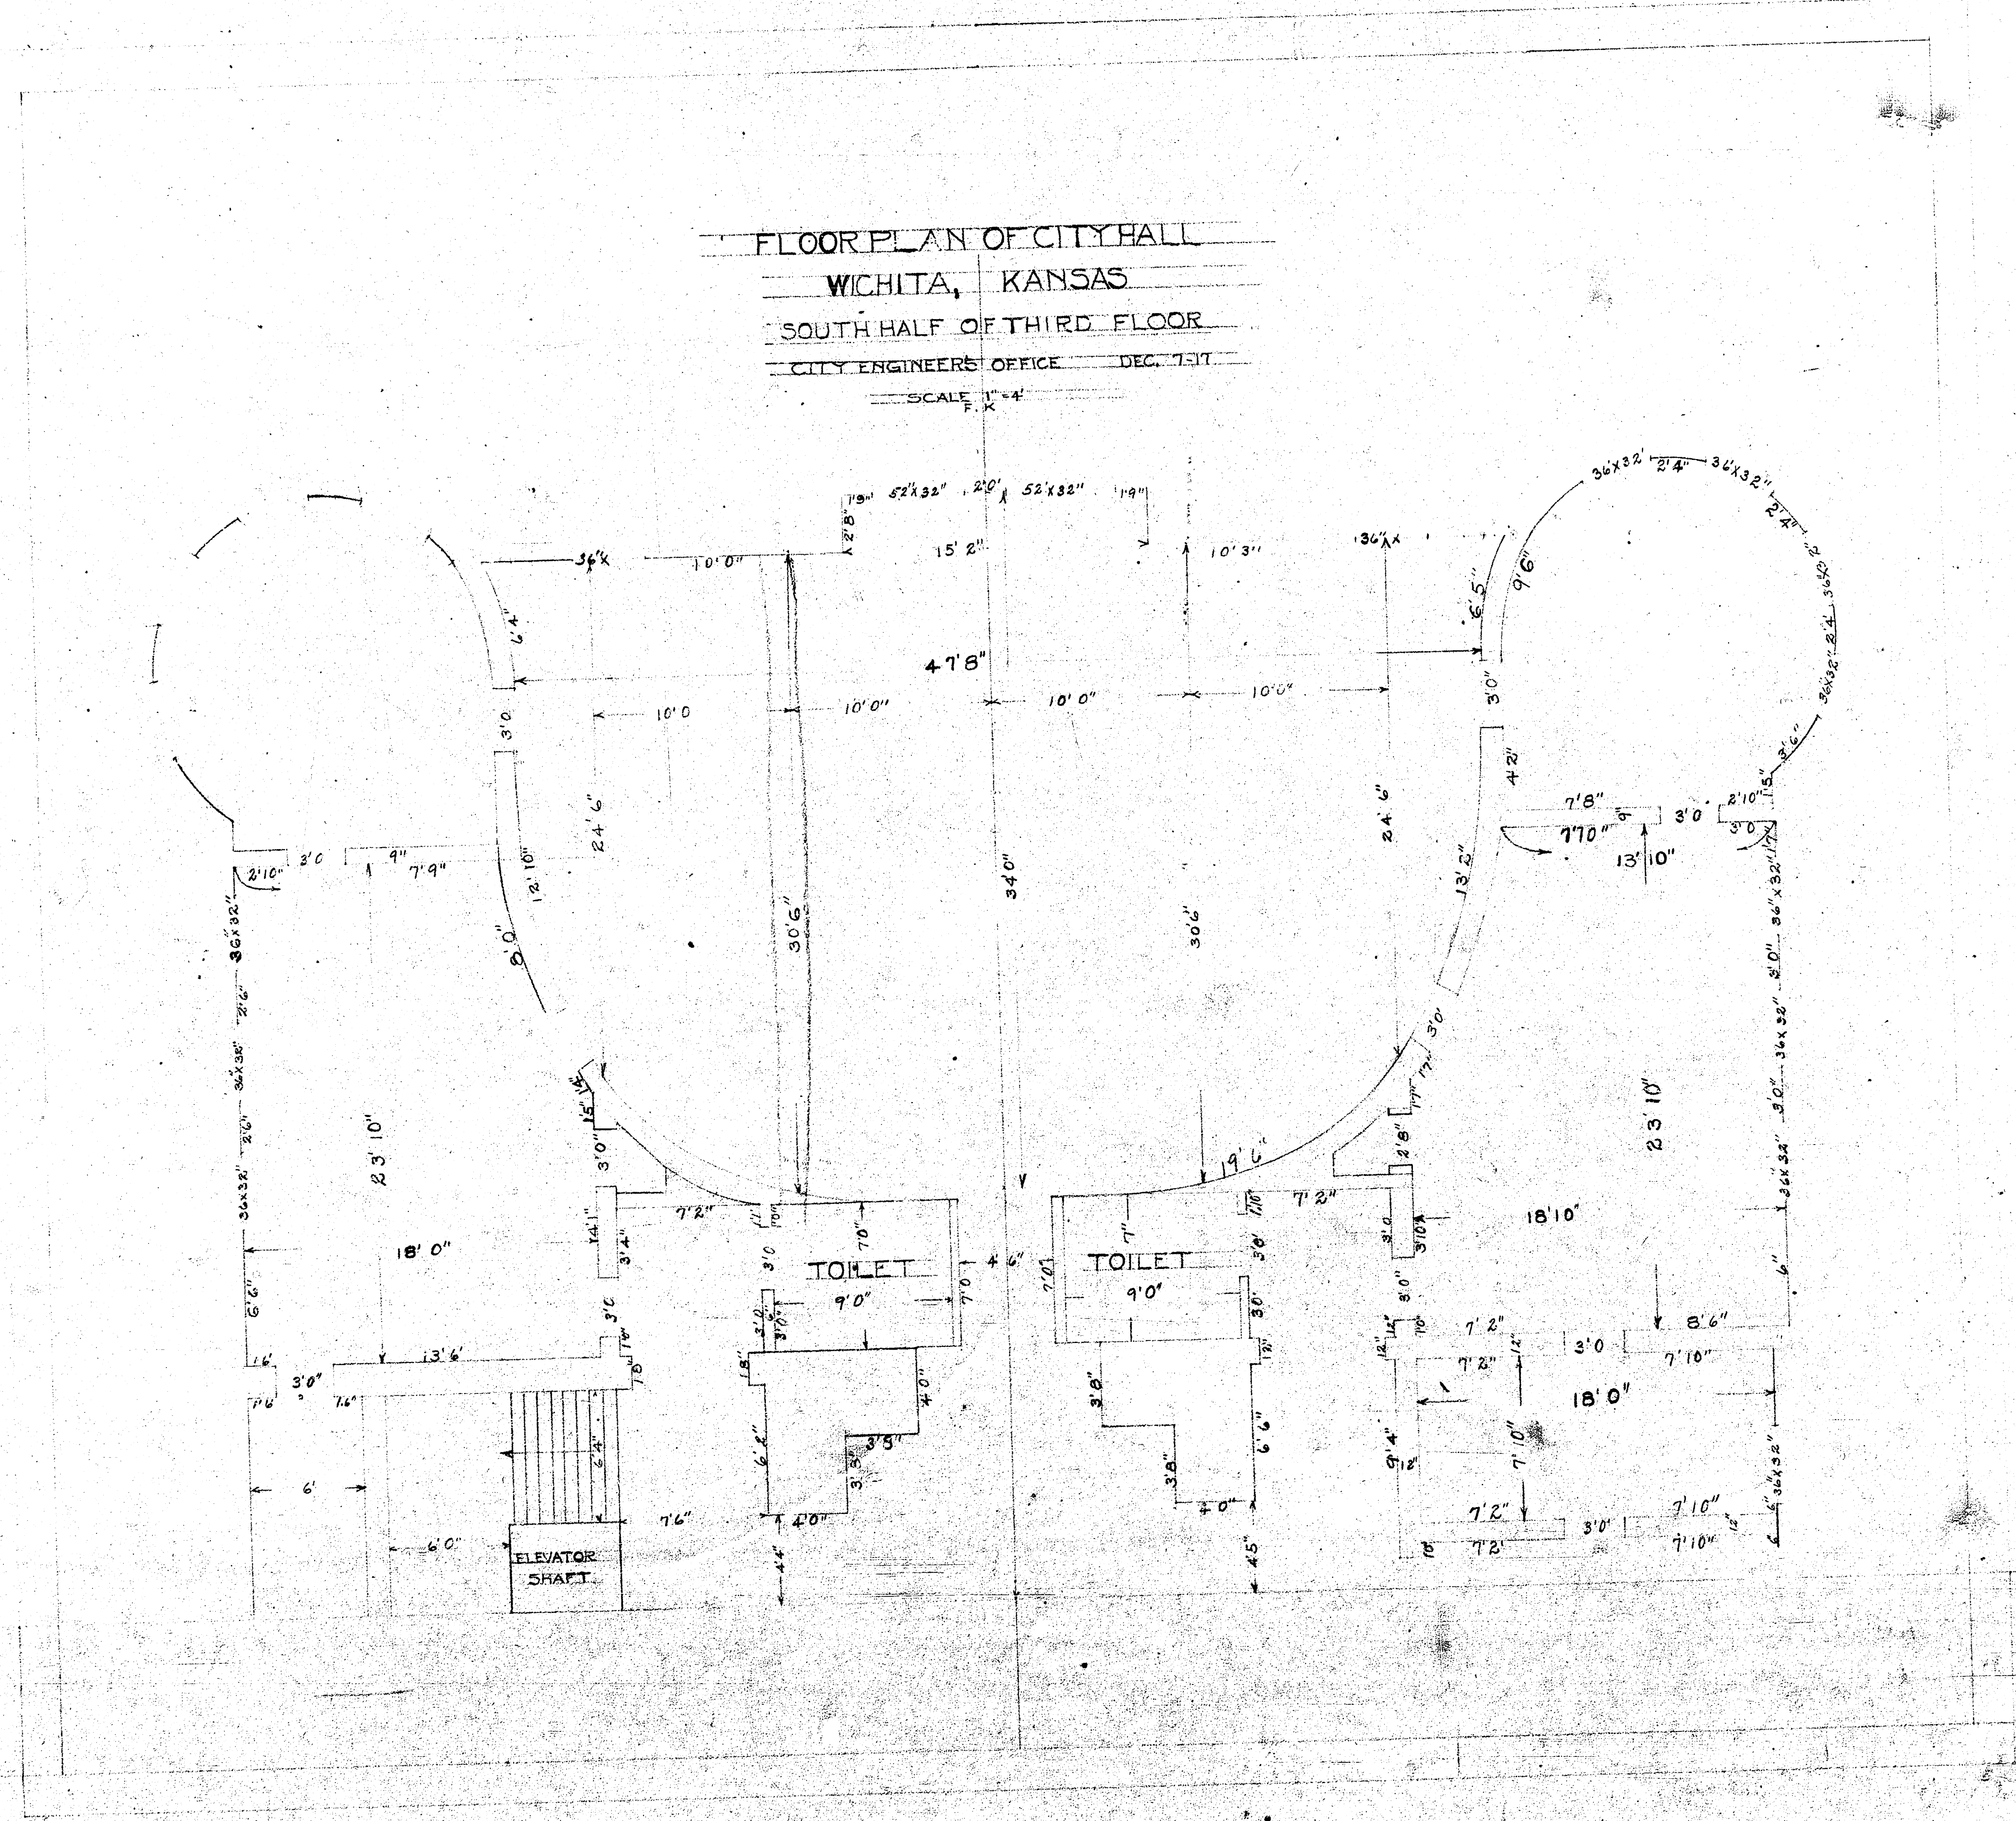

FLOOR PLAN OF CITY HALL
 WICHITA, KANSAS
 SOUTH HALF OF FOURTH FLOOR
 CITY ENGINEERS OFFICE DEC 10-17
 SCALE 1"=4'
 F.K.

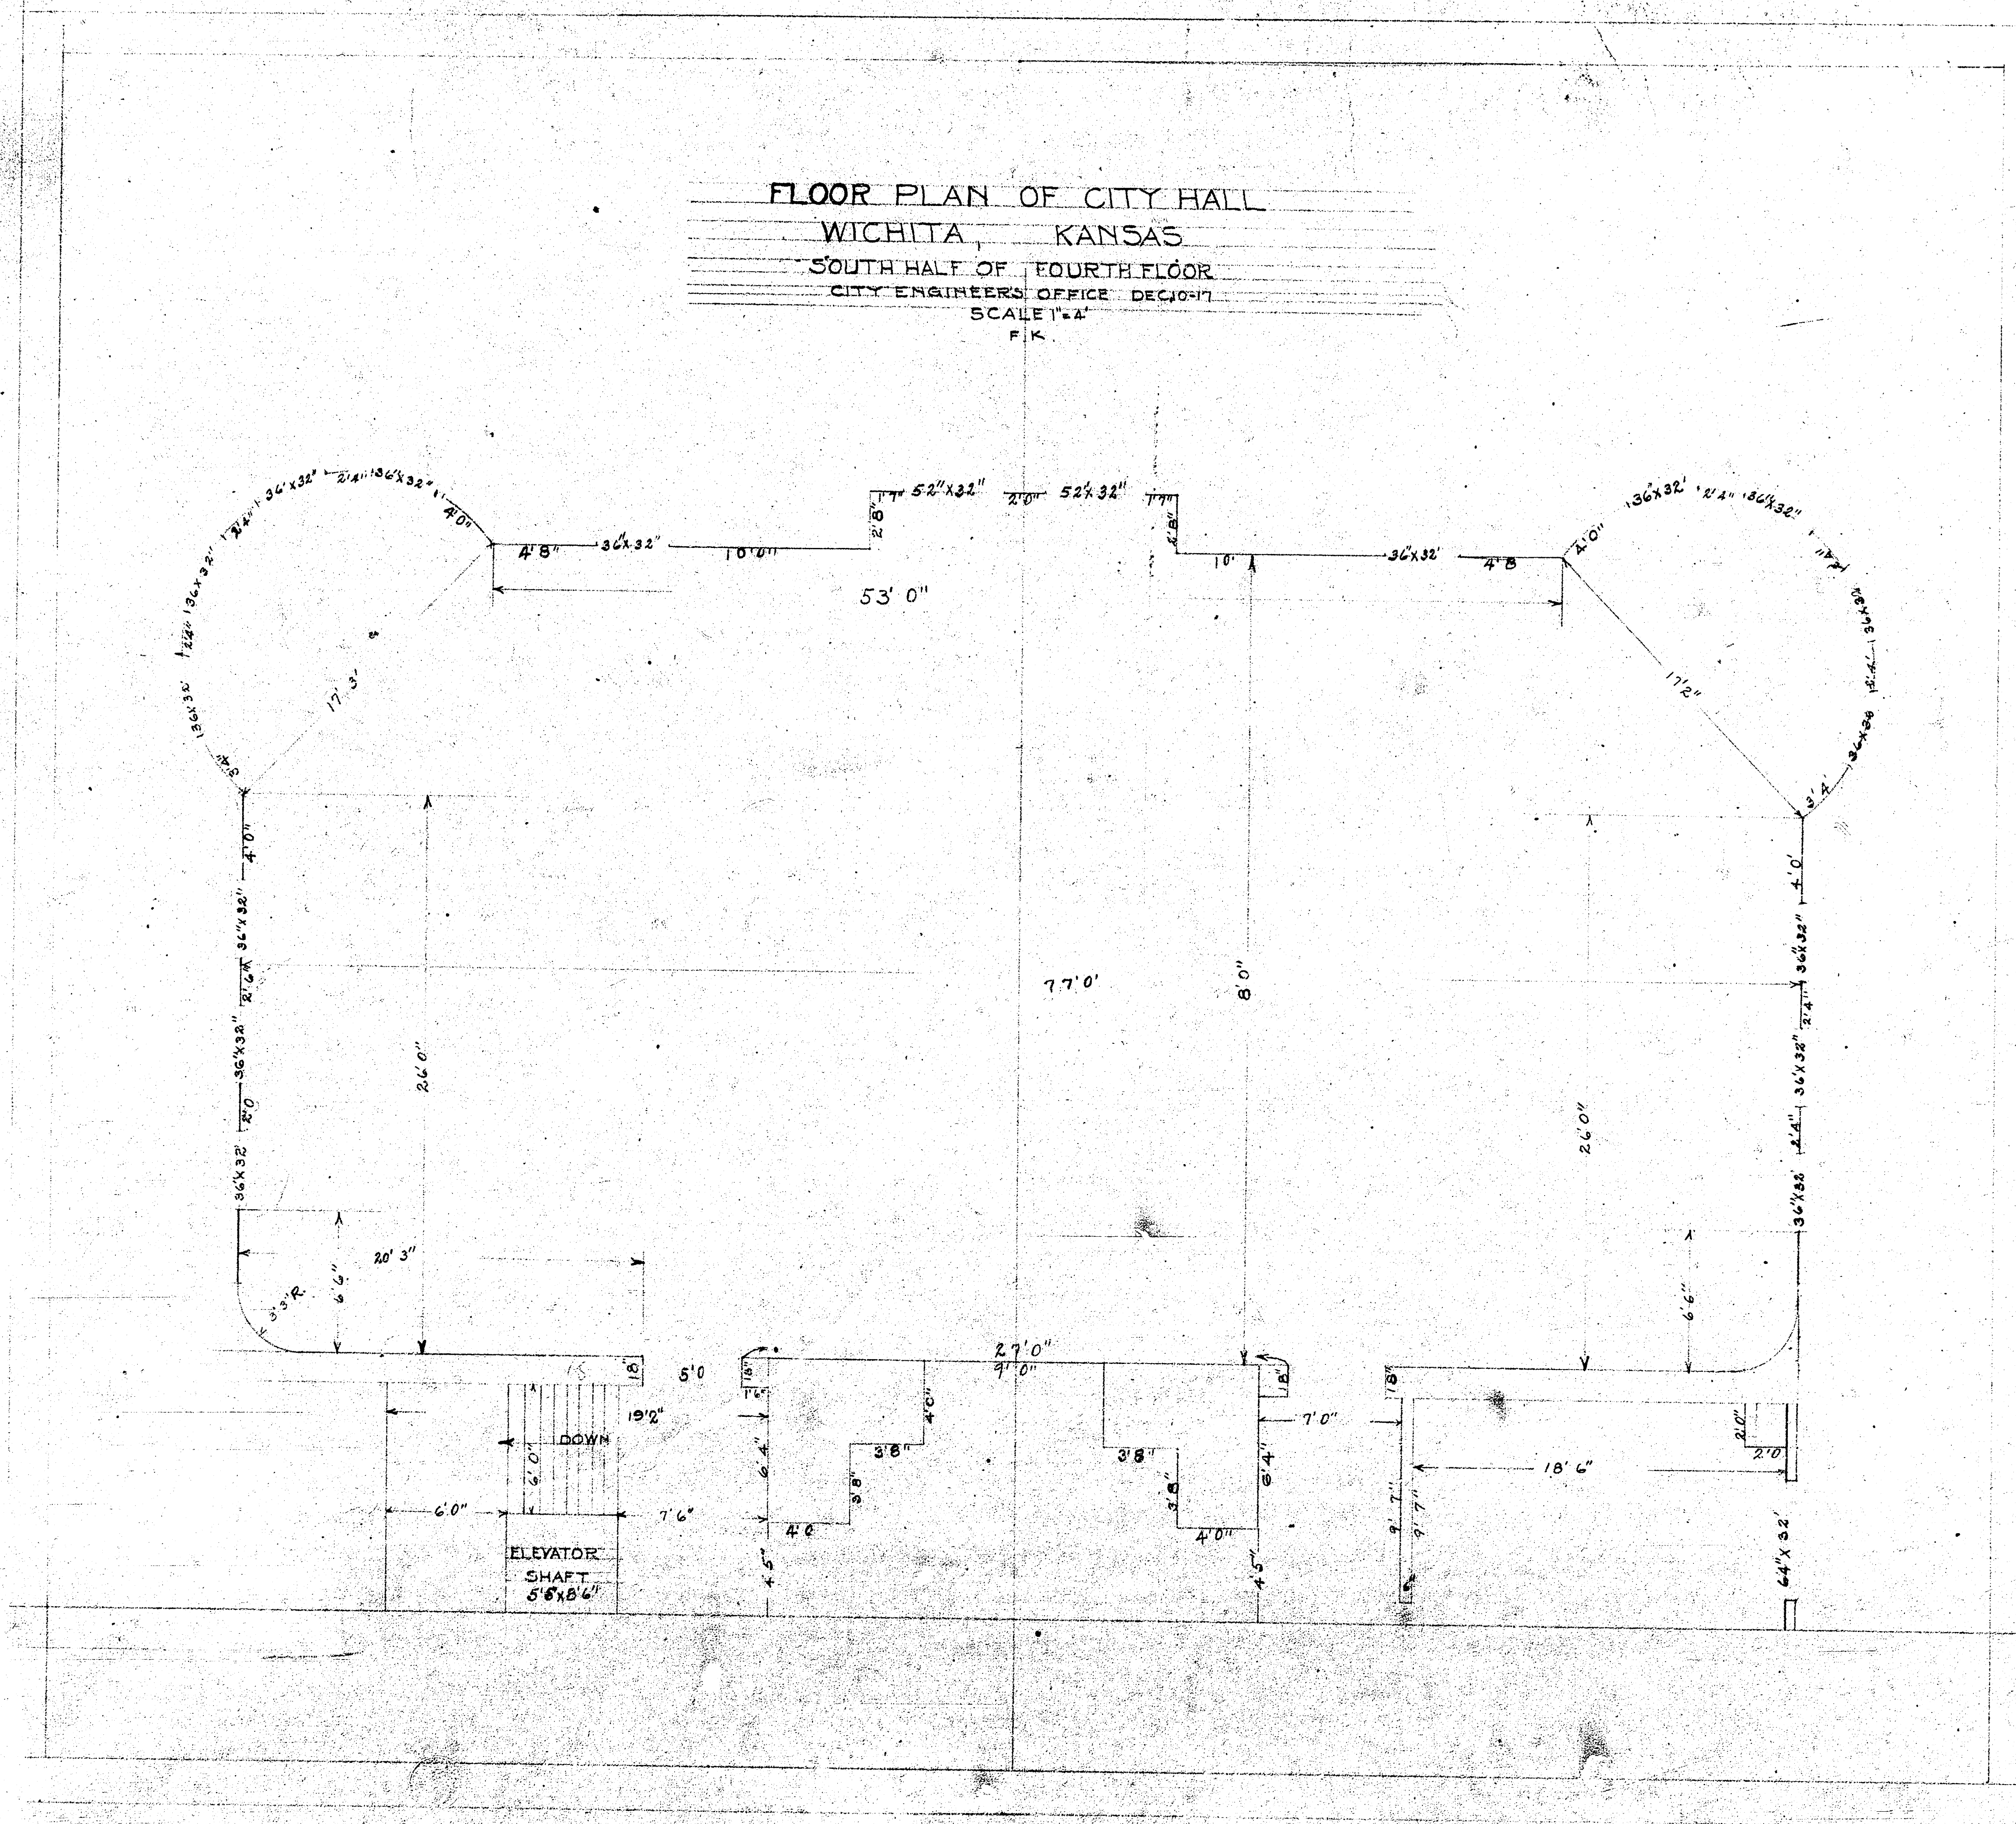

FLOOR PLAN OF CITY HALL
WICHITA, KANSAS

SOUTH HALF OF SECOND FLOOR
CITY ENGINEER'S OFFICE DEC. 8, 1907
SCALE 1"=4'
F.K.

