


NOTE  
 Topography by Servis, Van Doren & Hazard, Engineers of Topeka, Kansas, by a standard photogrammetric process from aerial photographs taken by Aerial Photo Service of Tulsa, Oklahoma on 17 March 1963.

UTILITIES  
 W WATER  
 SS SANITARY SEWER  
 → FIRE HYDRANT

EXISTING UTILITIES  
 CIVIC CENTER  
 FOR THE  
 URBAN RENEWAL AGENCY OF THE WICHITA, KANSAS  
 METROPOLITAN AREA PROJECT KANS. R-19

K.O. TAYLOR, P.E. MAY, 1963 SHEET 2

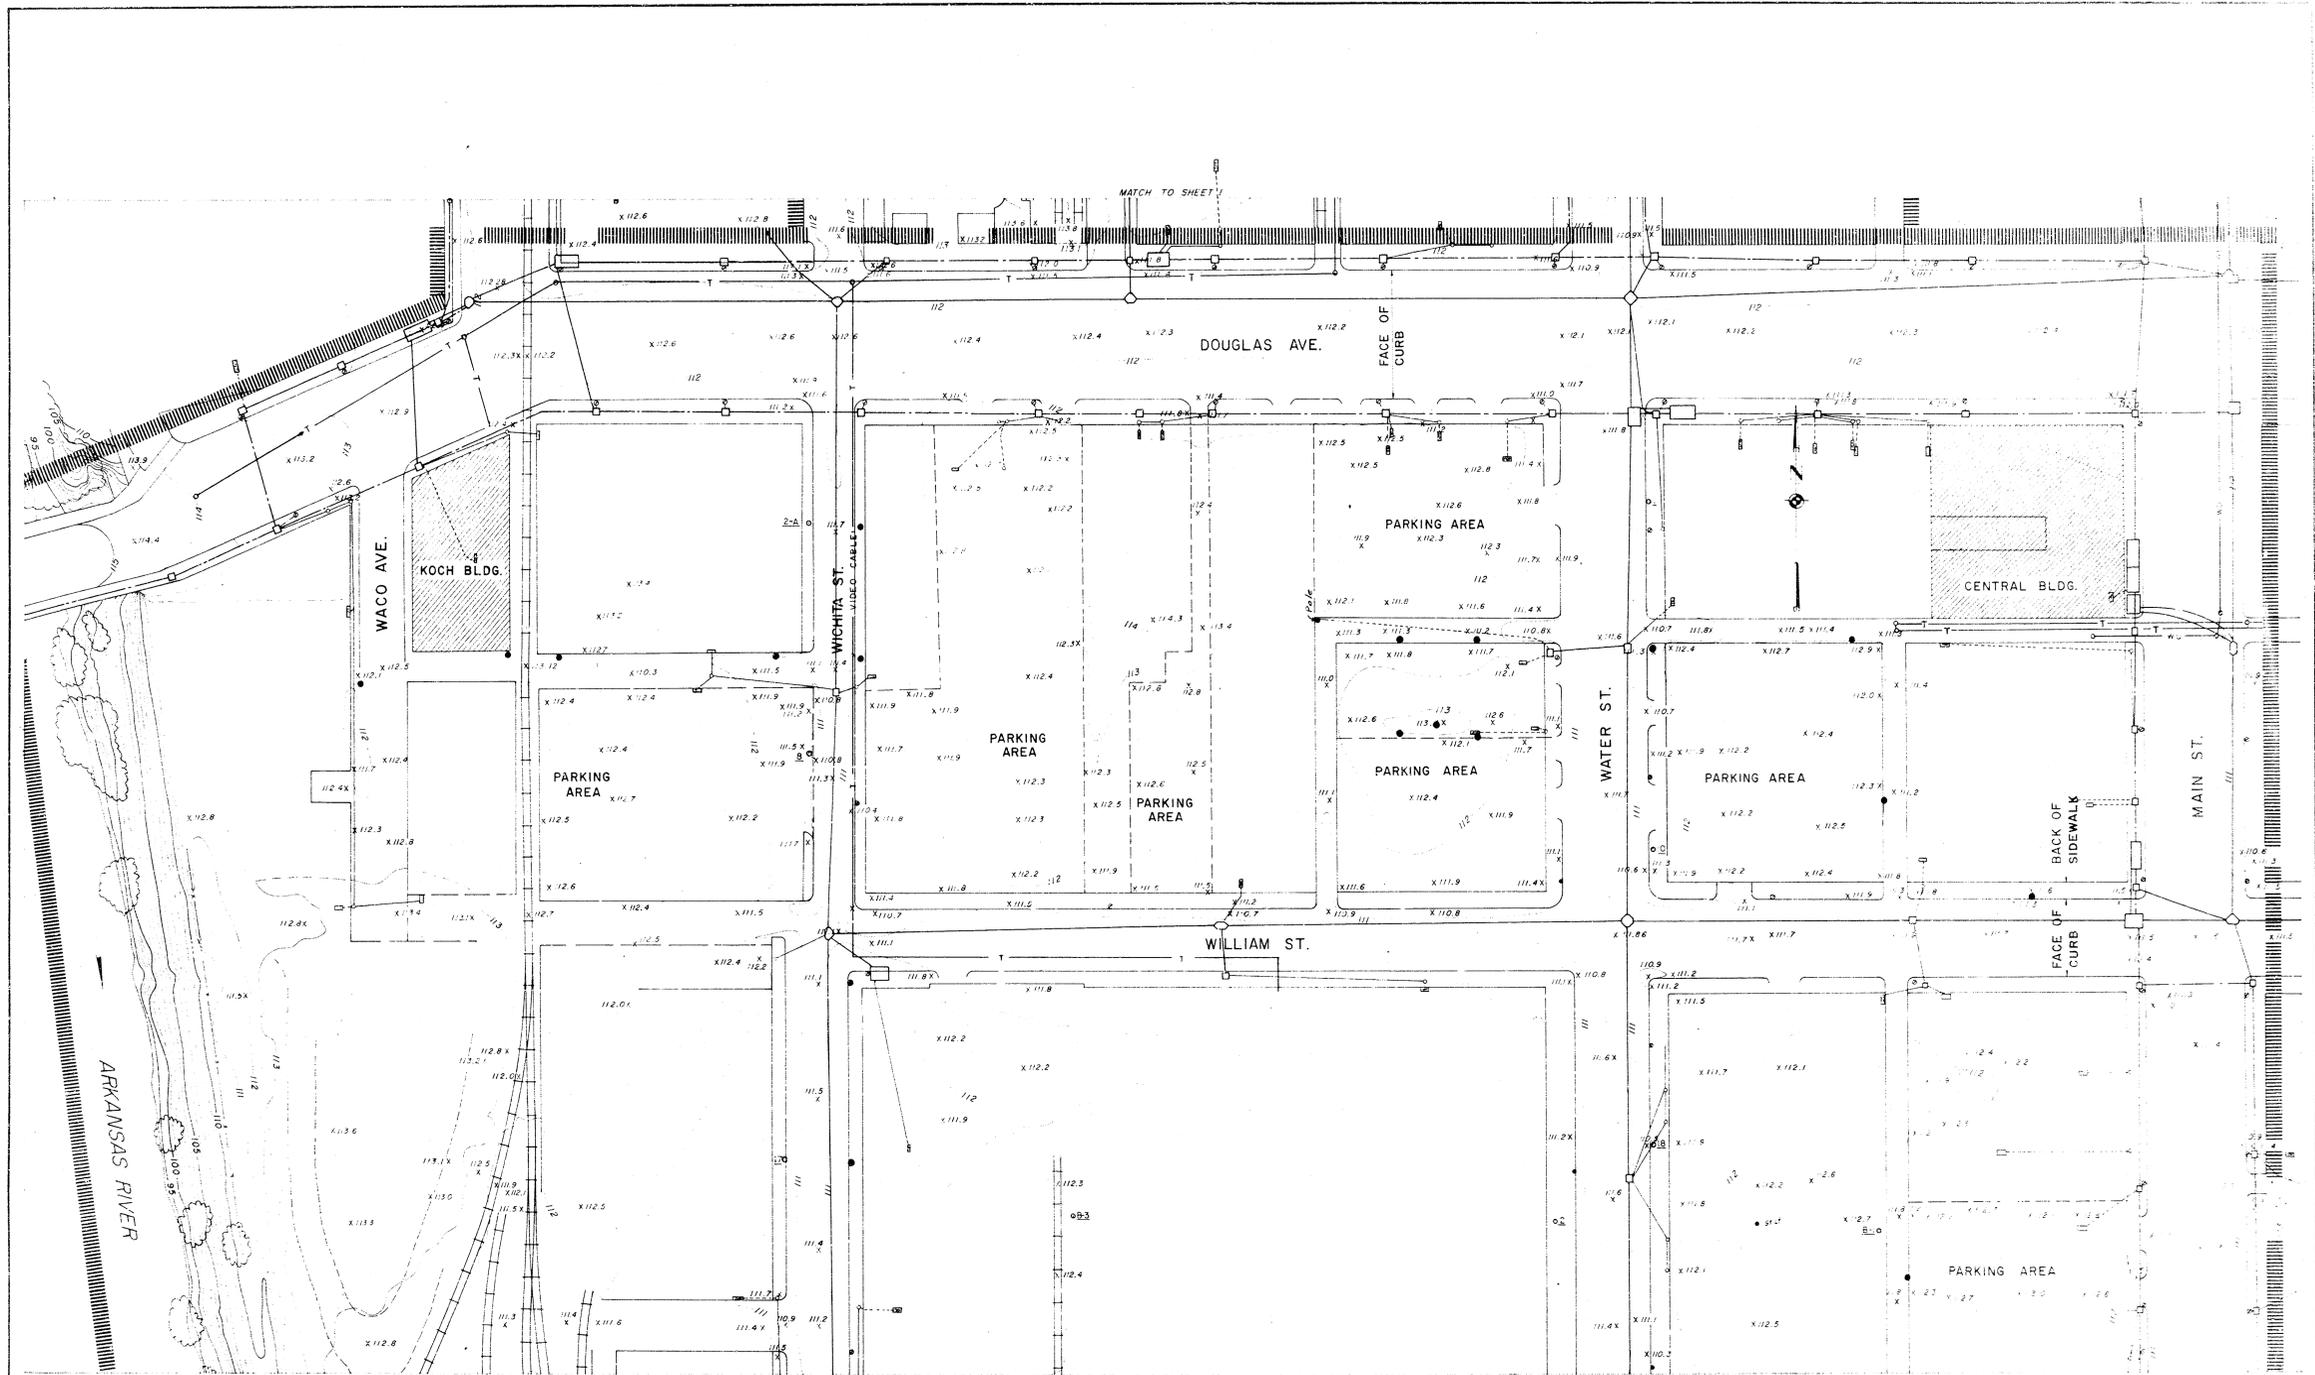


NOTE  
 Topography by Servis, Van Doren & Hazard, Engineers of Topeka, Kansas, by a standard photogrammetric process from aerial photographs taken by Aerial Photo Service of Tulsa, Oklahoma on 17 March 1963.

NOTE  
 ALL LINES NOT OTHERWISE DESIGNATED ARE K.G.B.E. UNDERGROUND ELECTRIC UTILITIES.

- UTILITIES**
- K.G.B.E. UNDERGROUND ELECTRIC LINES
  - STREET LIGHT
  - K.G.B.E. VAULTS
  - ⊙ METER
  - UTILITY POLES
  - SW BELL TELE. CO. UNDERGROUND LINES
  - WU WESTERN UNION UNDERGROUND LINES

**EXISTING UTILITIES  
 CIVIC CENTER**  
 FOR THE  
 URBAN RENEWAL AGENCY OF THE WICHITA, KANSAS  
 METROPOLITAN AREA PROJECT KAN 5 R-19

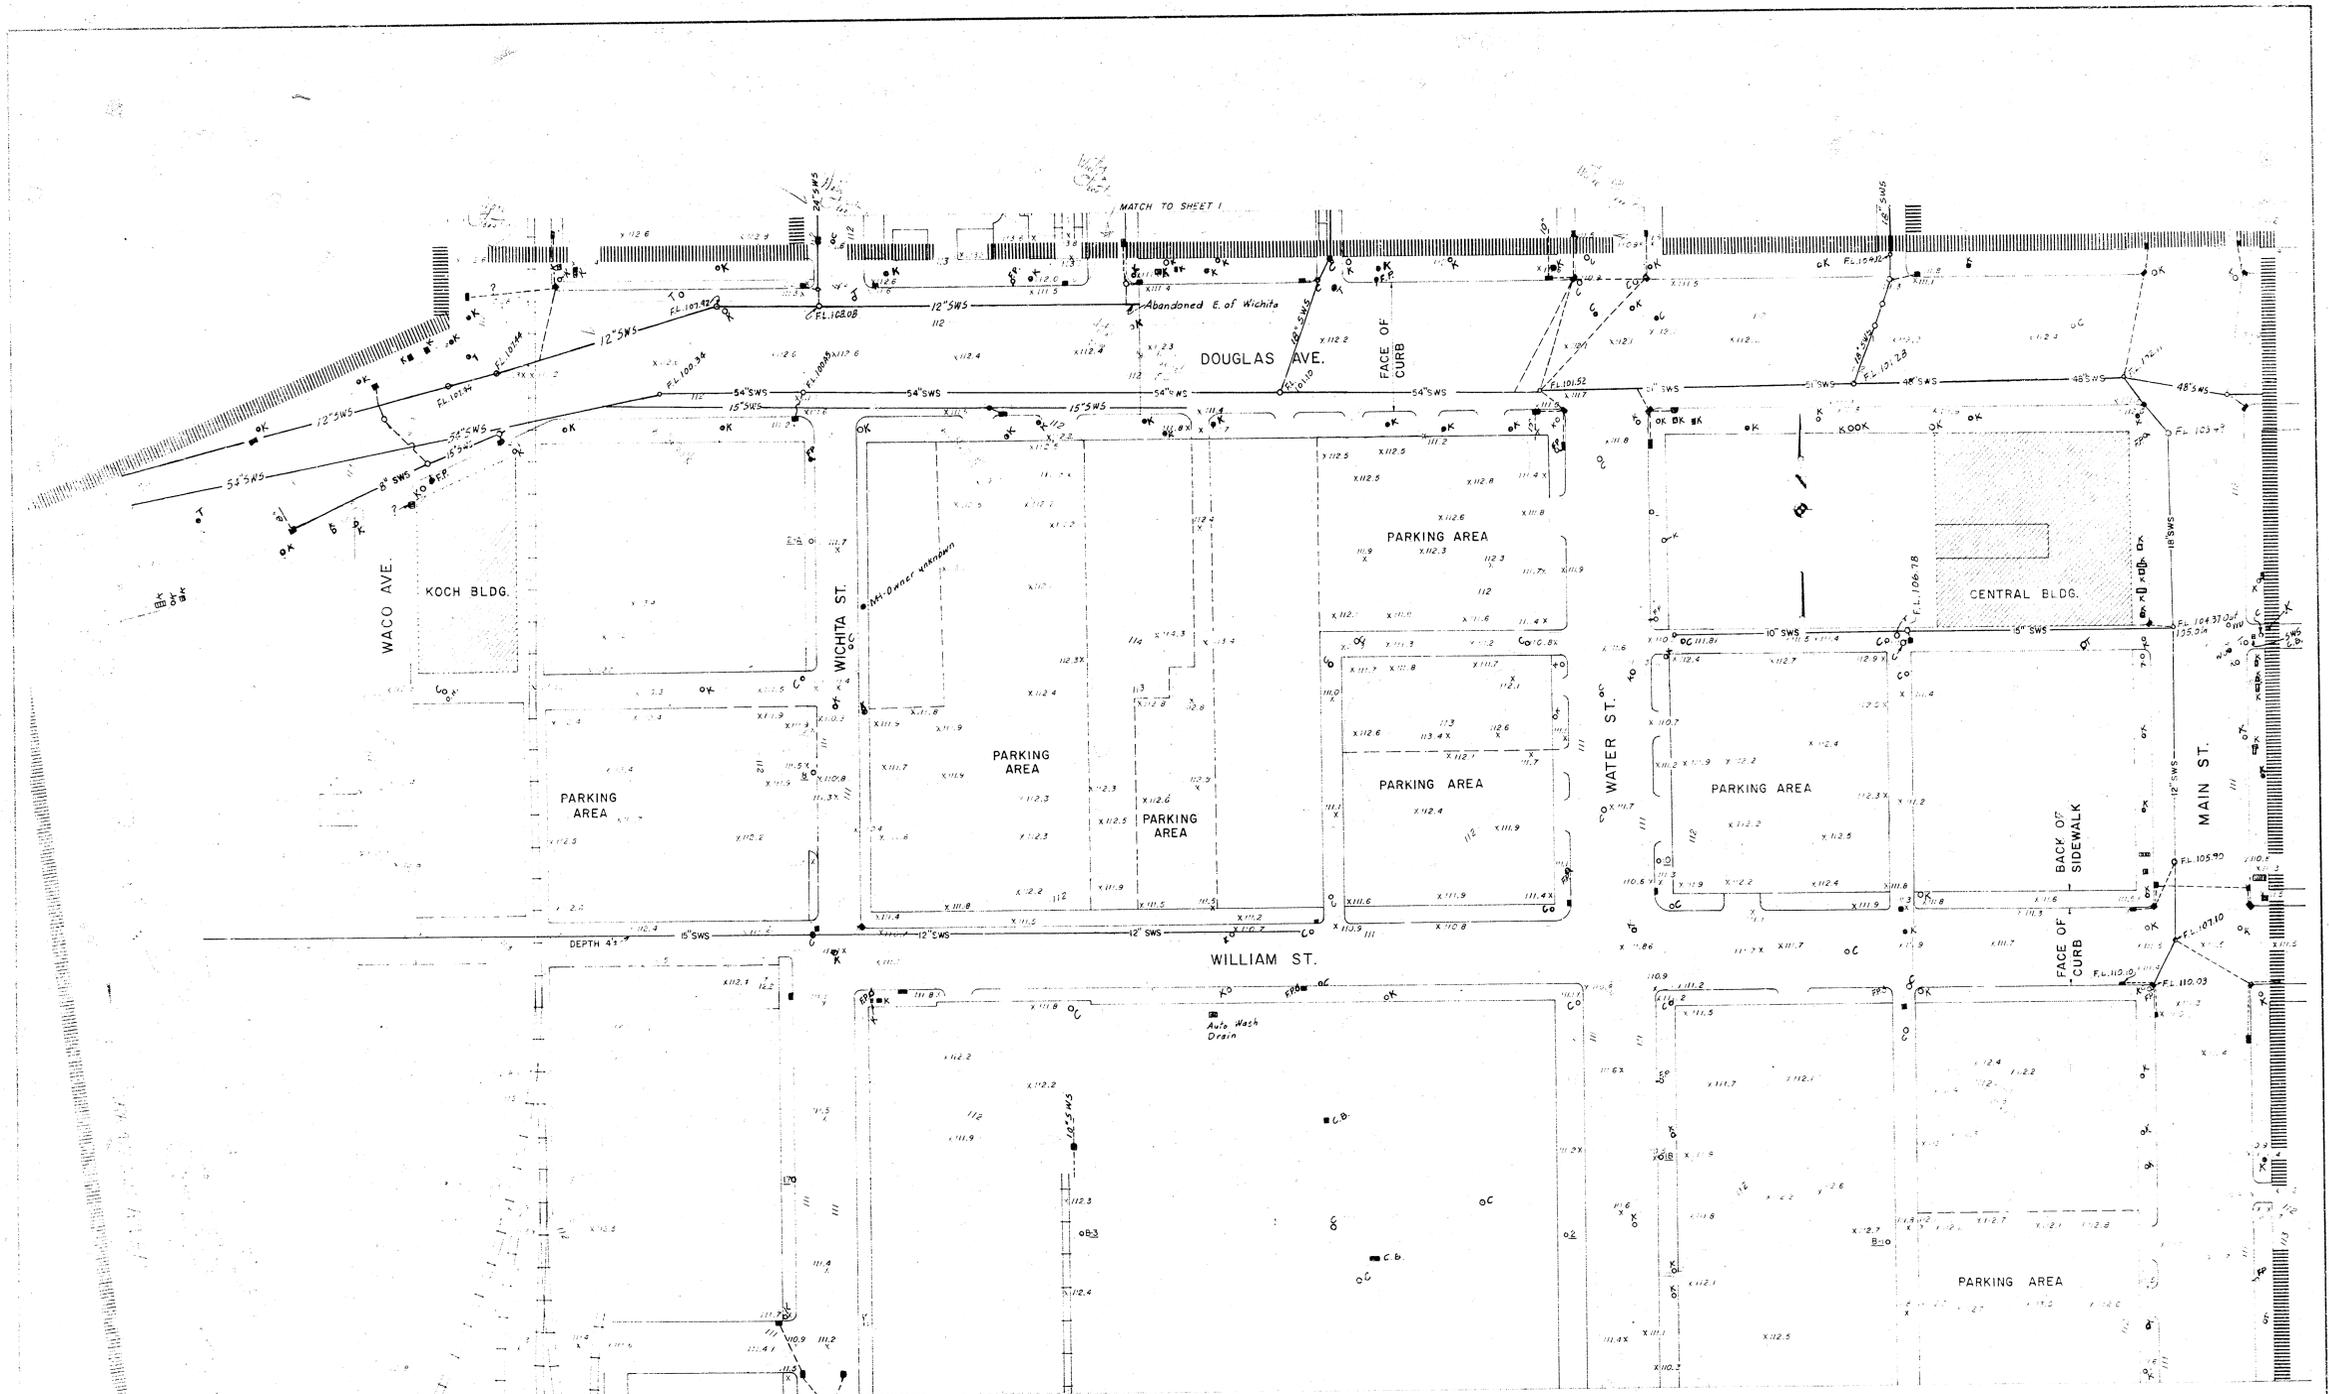


NOTE  
 Topography by Servis, Von Doren & Hazard, Engineers of Topeka, Kansas, by a standard photogrammetric process from aerial photographs taken by Aerial Photo Service of Tulsa, Oklahoma on 17 March 1963.

- LEGEND**
- MANHOLE
  - STORM WATER CATCH BASIN
  - STEEL GRATE
  - PP FIRE PLUG
  - SWS — STORM WATER SEWER
- OWNERS**
- WESTERN UNION TELEGRAPH COMPANY
  - CITY OF WICHITA
  - KANSAS GAS AND ELECTRIC COMPANY
  - SOUTHWESTERN BELL TELEPHONE COMPANY

**STORM WATER SEWERS  
 AND  
 LOCATION OF EXPOSED  
 MANHOLES AND GRATES**

**EXISTING UTILITIES  
 CIVIC CENTER**  
 FOR THE  
 URBAN RENEWAL AGENCY OF THE WICHITA, KANSAS  
 METROPOLITAN AREA PROJECT KANS. R-19

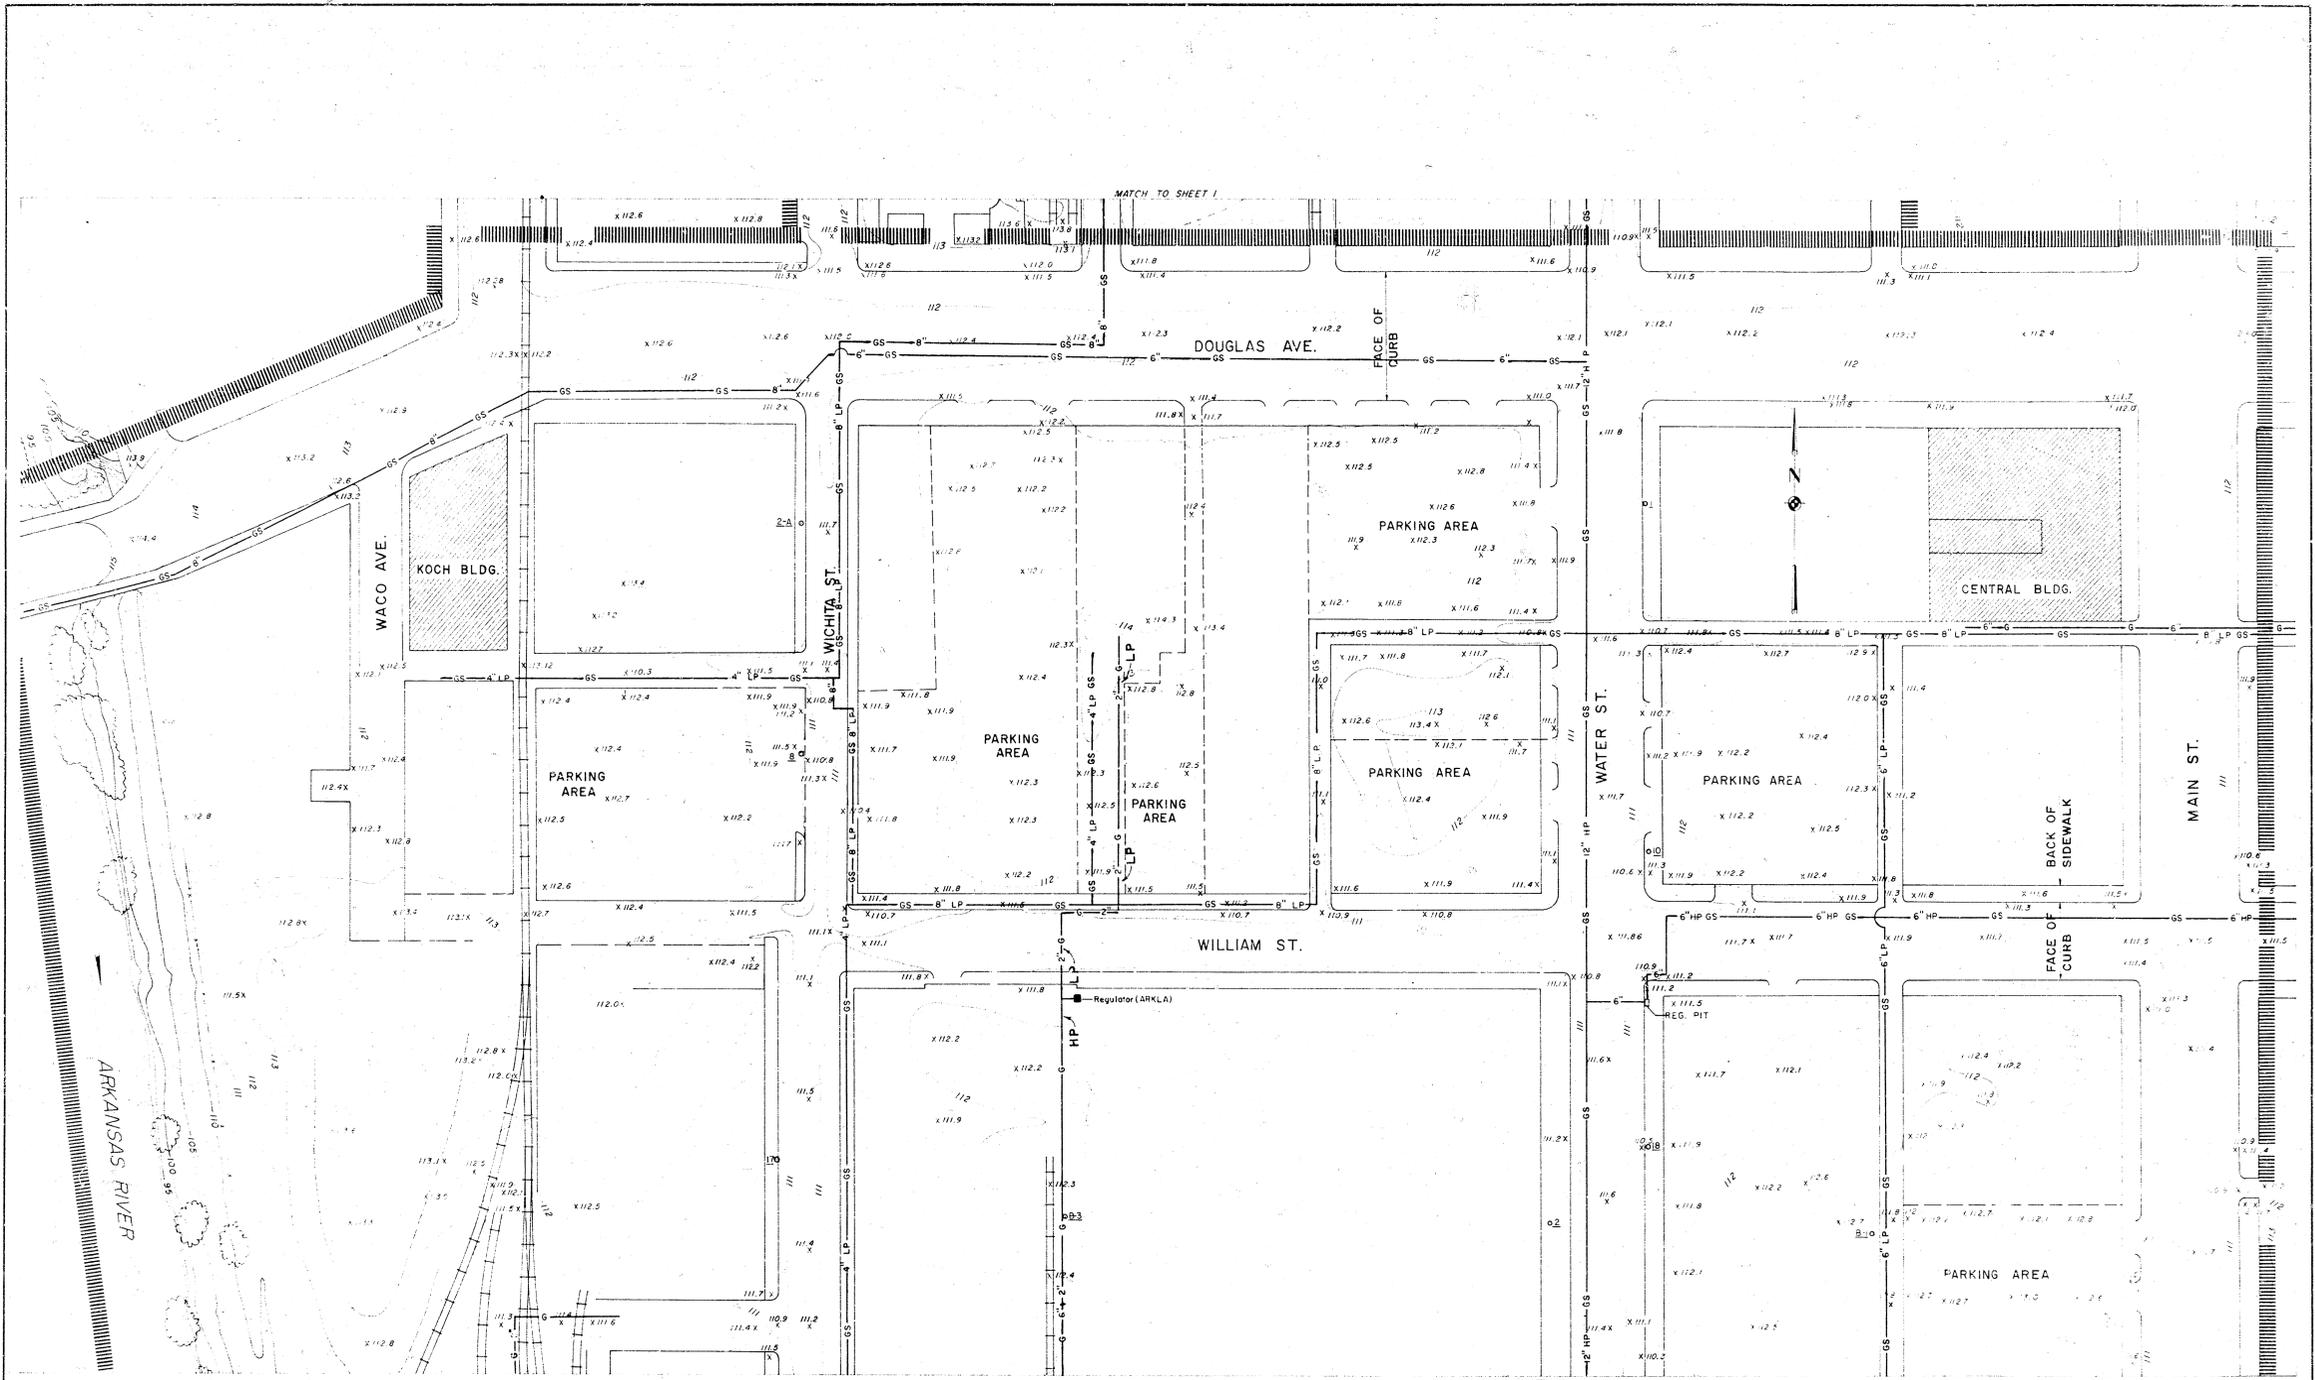

NOTE  
 Topography by Servis, Van Doren & Hazard, Engineers of Topeka, Kansas, by a standard photogrammetric process from aerial photographs taken by aerial Photo Service of Tulsa, Oklahoma on 17 March 1963.

NOTE  
 ALL ARKLA GAS LINES SHOWN ON THIS SHEET ARE HIGH PRESSURE EXCEPT AS NOTED

UTILITIES  
 GAS LINES  
 GS = GAS SERVICE COMPANY  
 G = ARKLA GAS COMPANY

EXISTING UTILITIES  
 CIVIC CENTER  
 FOR THE  
 URBAN RENEWAL AGENCY OF THE WICHITA, KANSAS  
 METROPOLITAN AREA PROJECT KANS. R-19