

12 DOUGLAS AVENUE

check elevations

part of Douglas prop?

KOCH BUILDING

144.84'

24.0' 11' 10.00"

15.0'

150.65'

12.0' 12.0' 19.00"

TOP OF RAMP 1
117.11'

MISAPPLICATED PAVERS
BALANCED RIGHT SIDE WAY

Handwritten notes and arrows pointing to paver areas.

AREA DRAIN
DET. RES.
11.00'

AREA DRAIN
DET. RES.
11.00'

MANHOLE
DET. RES.

PLANTER

18.00'

TERRACE

TERRACE RAMP (4.00')

SIDE WALK

MATCH LINE 1


MATCH LINE 2

PLAN # 1

CIVIC CULTURAL CENTER
CITY OF WICHITA, KANSAS



E DOUGLAS AVENUE

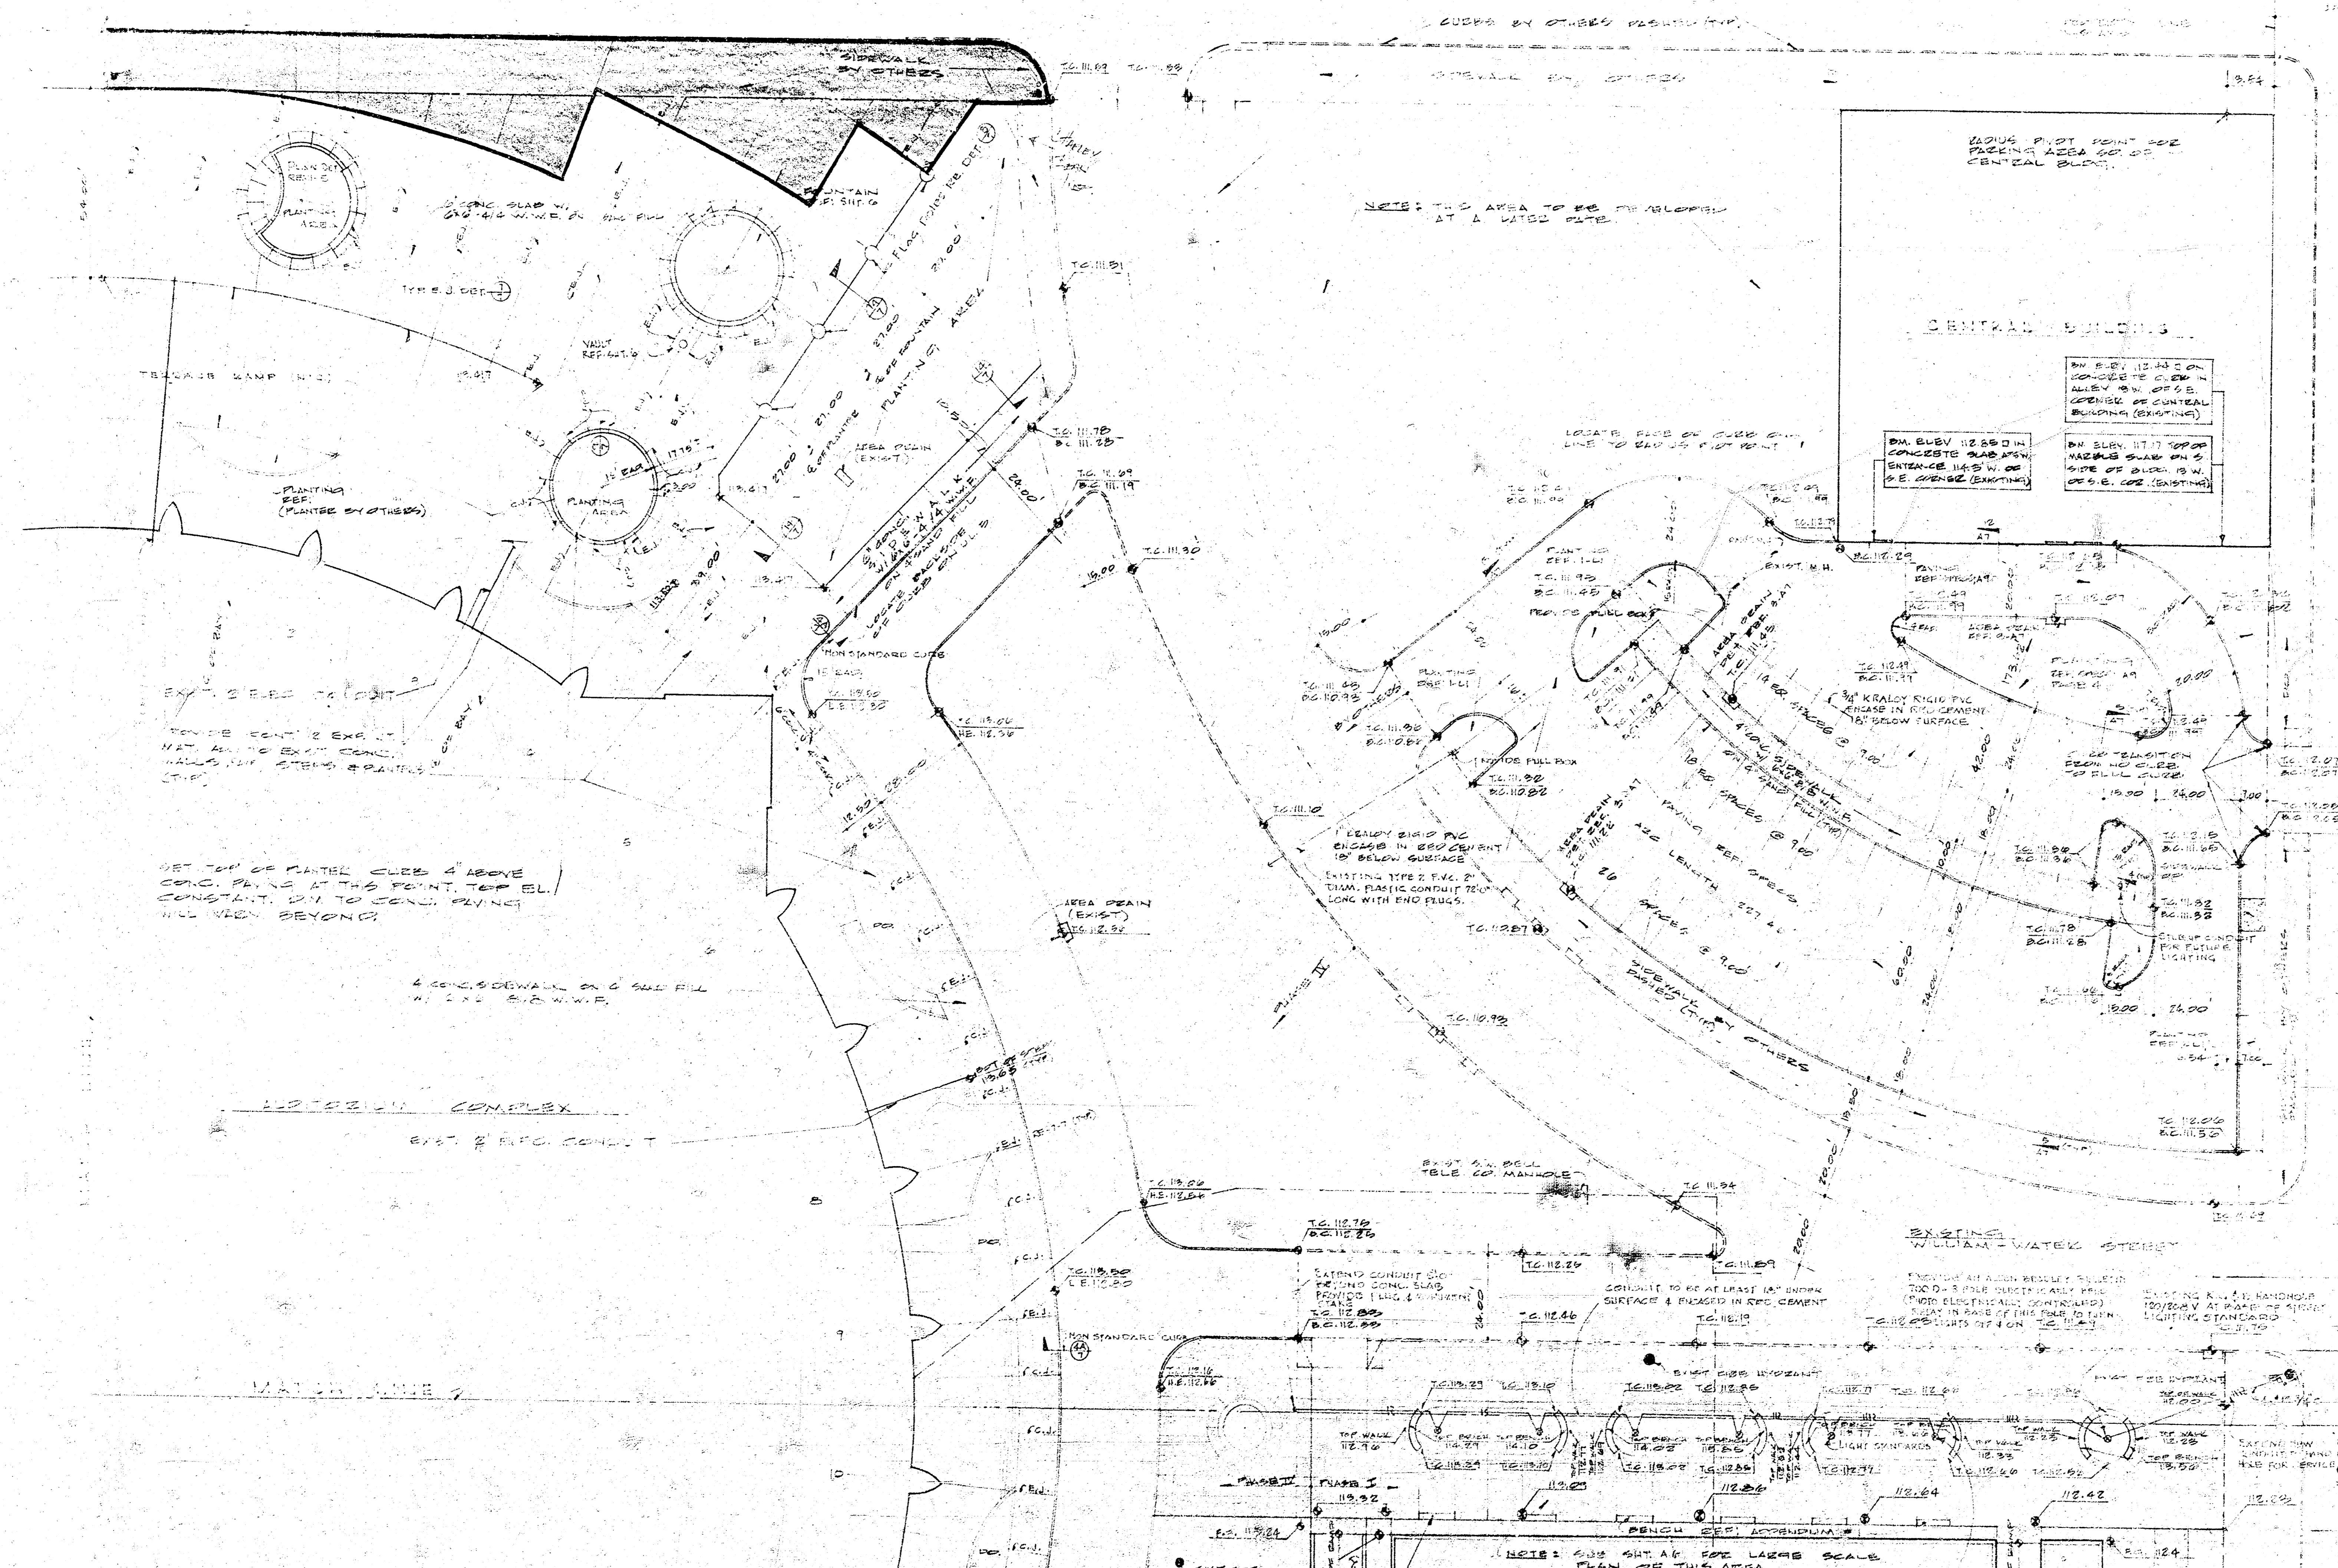

NOT TOP OF MATHE. CURB & ABOVE CONC. PAVES AT THIS POINT, TOP EL. CONSTANT. 12" TO 15" CONC. PAVING ALL WREN BEYOND.

4 CONC. SIDEWALK ON 4 SIDE HILL AT 2 X 2 SIDE W.W.P.



NOTING POINT POINT FOR PARKING AREA FOR CENTRAL BUILDING.

CENTRAL BUILDING


ON ELEV. 11.80 ON CONC. PAVES ON 4 SIDE HILL AT 2 X 2 SIDE W.W.P.

ON ELEV. 11.75 ON CONC. PAVES ON 4 SIDE HILL AT 2 X 2 SIDE W.W.P.

① PARTIAL SITE DEVELOPMENT PLAN

PROGRESS PRINT

DATE DEVELOPMENT PLAN

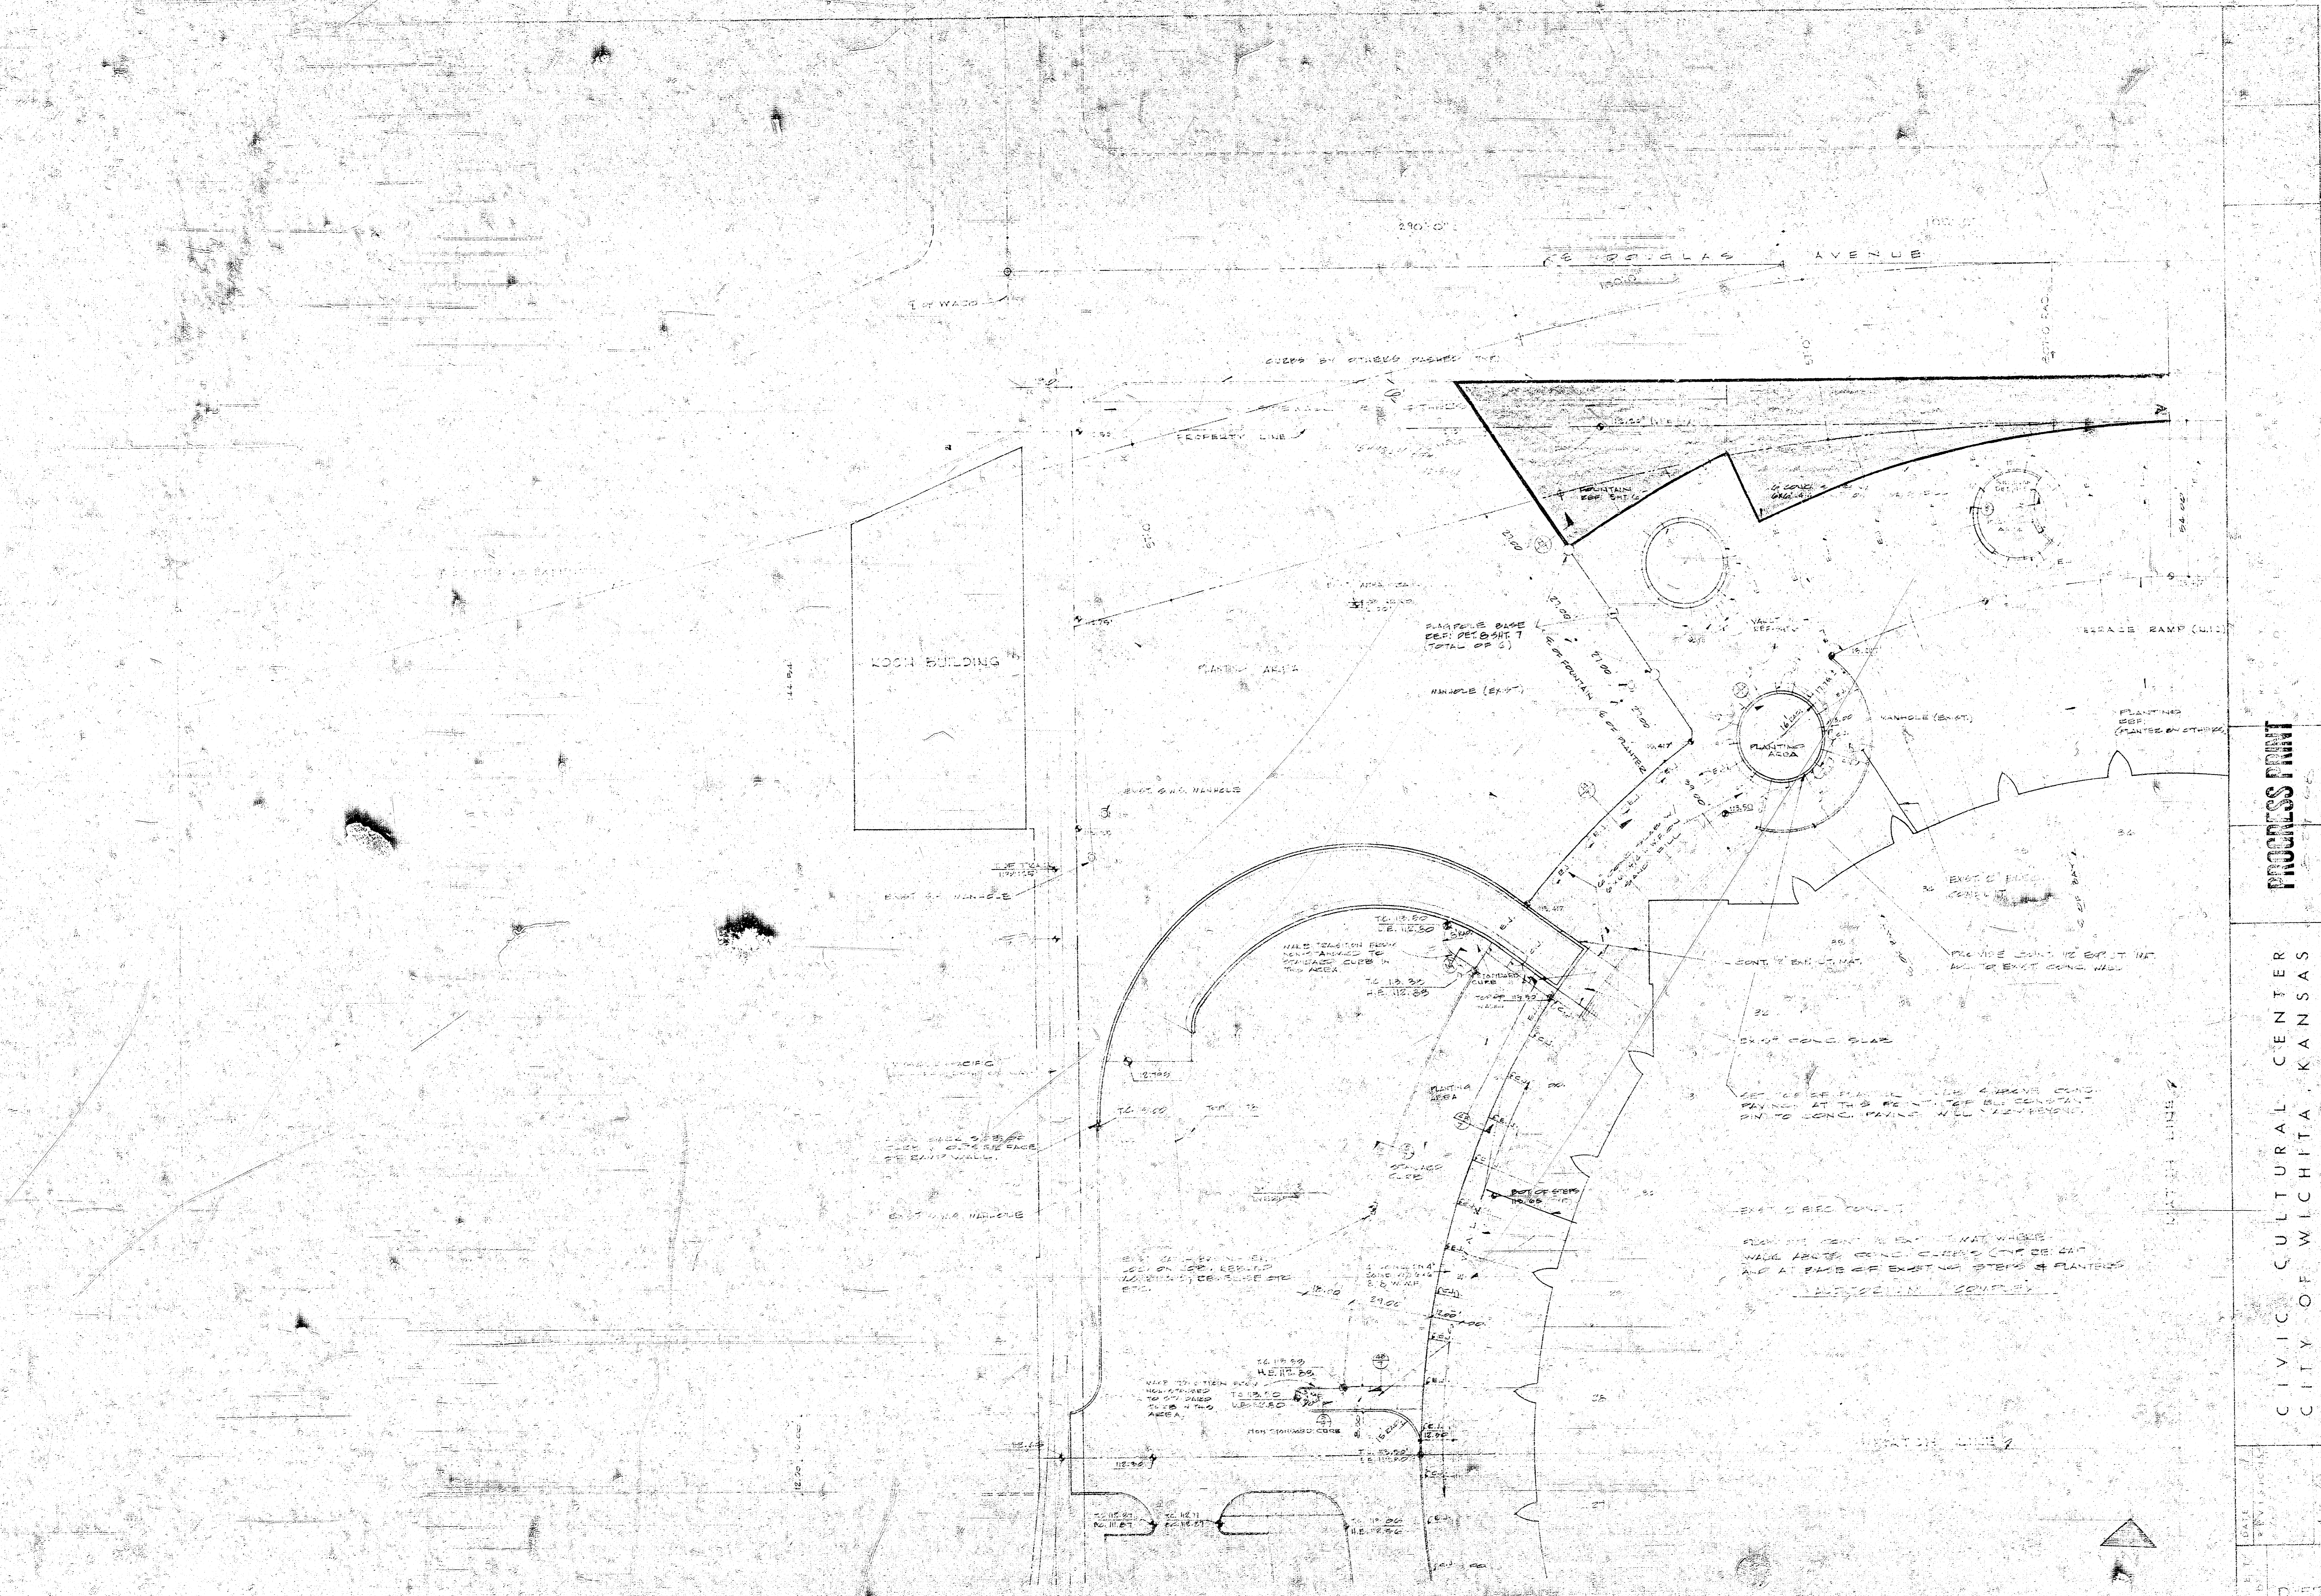

PARTIAL SITE DEVELOPMENT PLAN

1-25-70

PROCESS PRINT

CIVIC CULTURAL CENTER
CITY OF WICHITA, KANSAS

DATE: 1-25-70
BY: [Signature]