


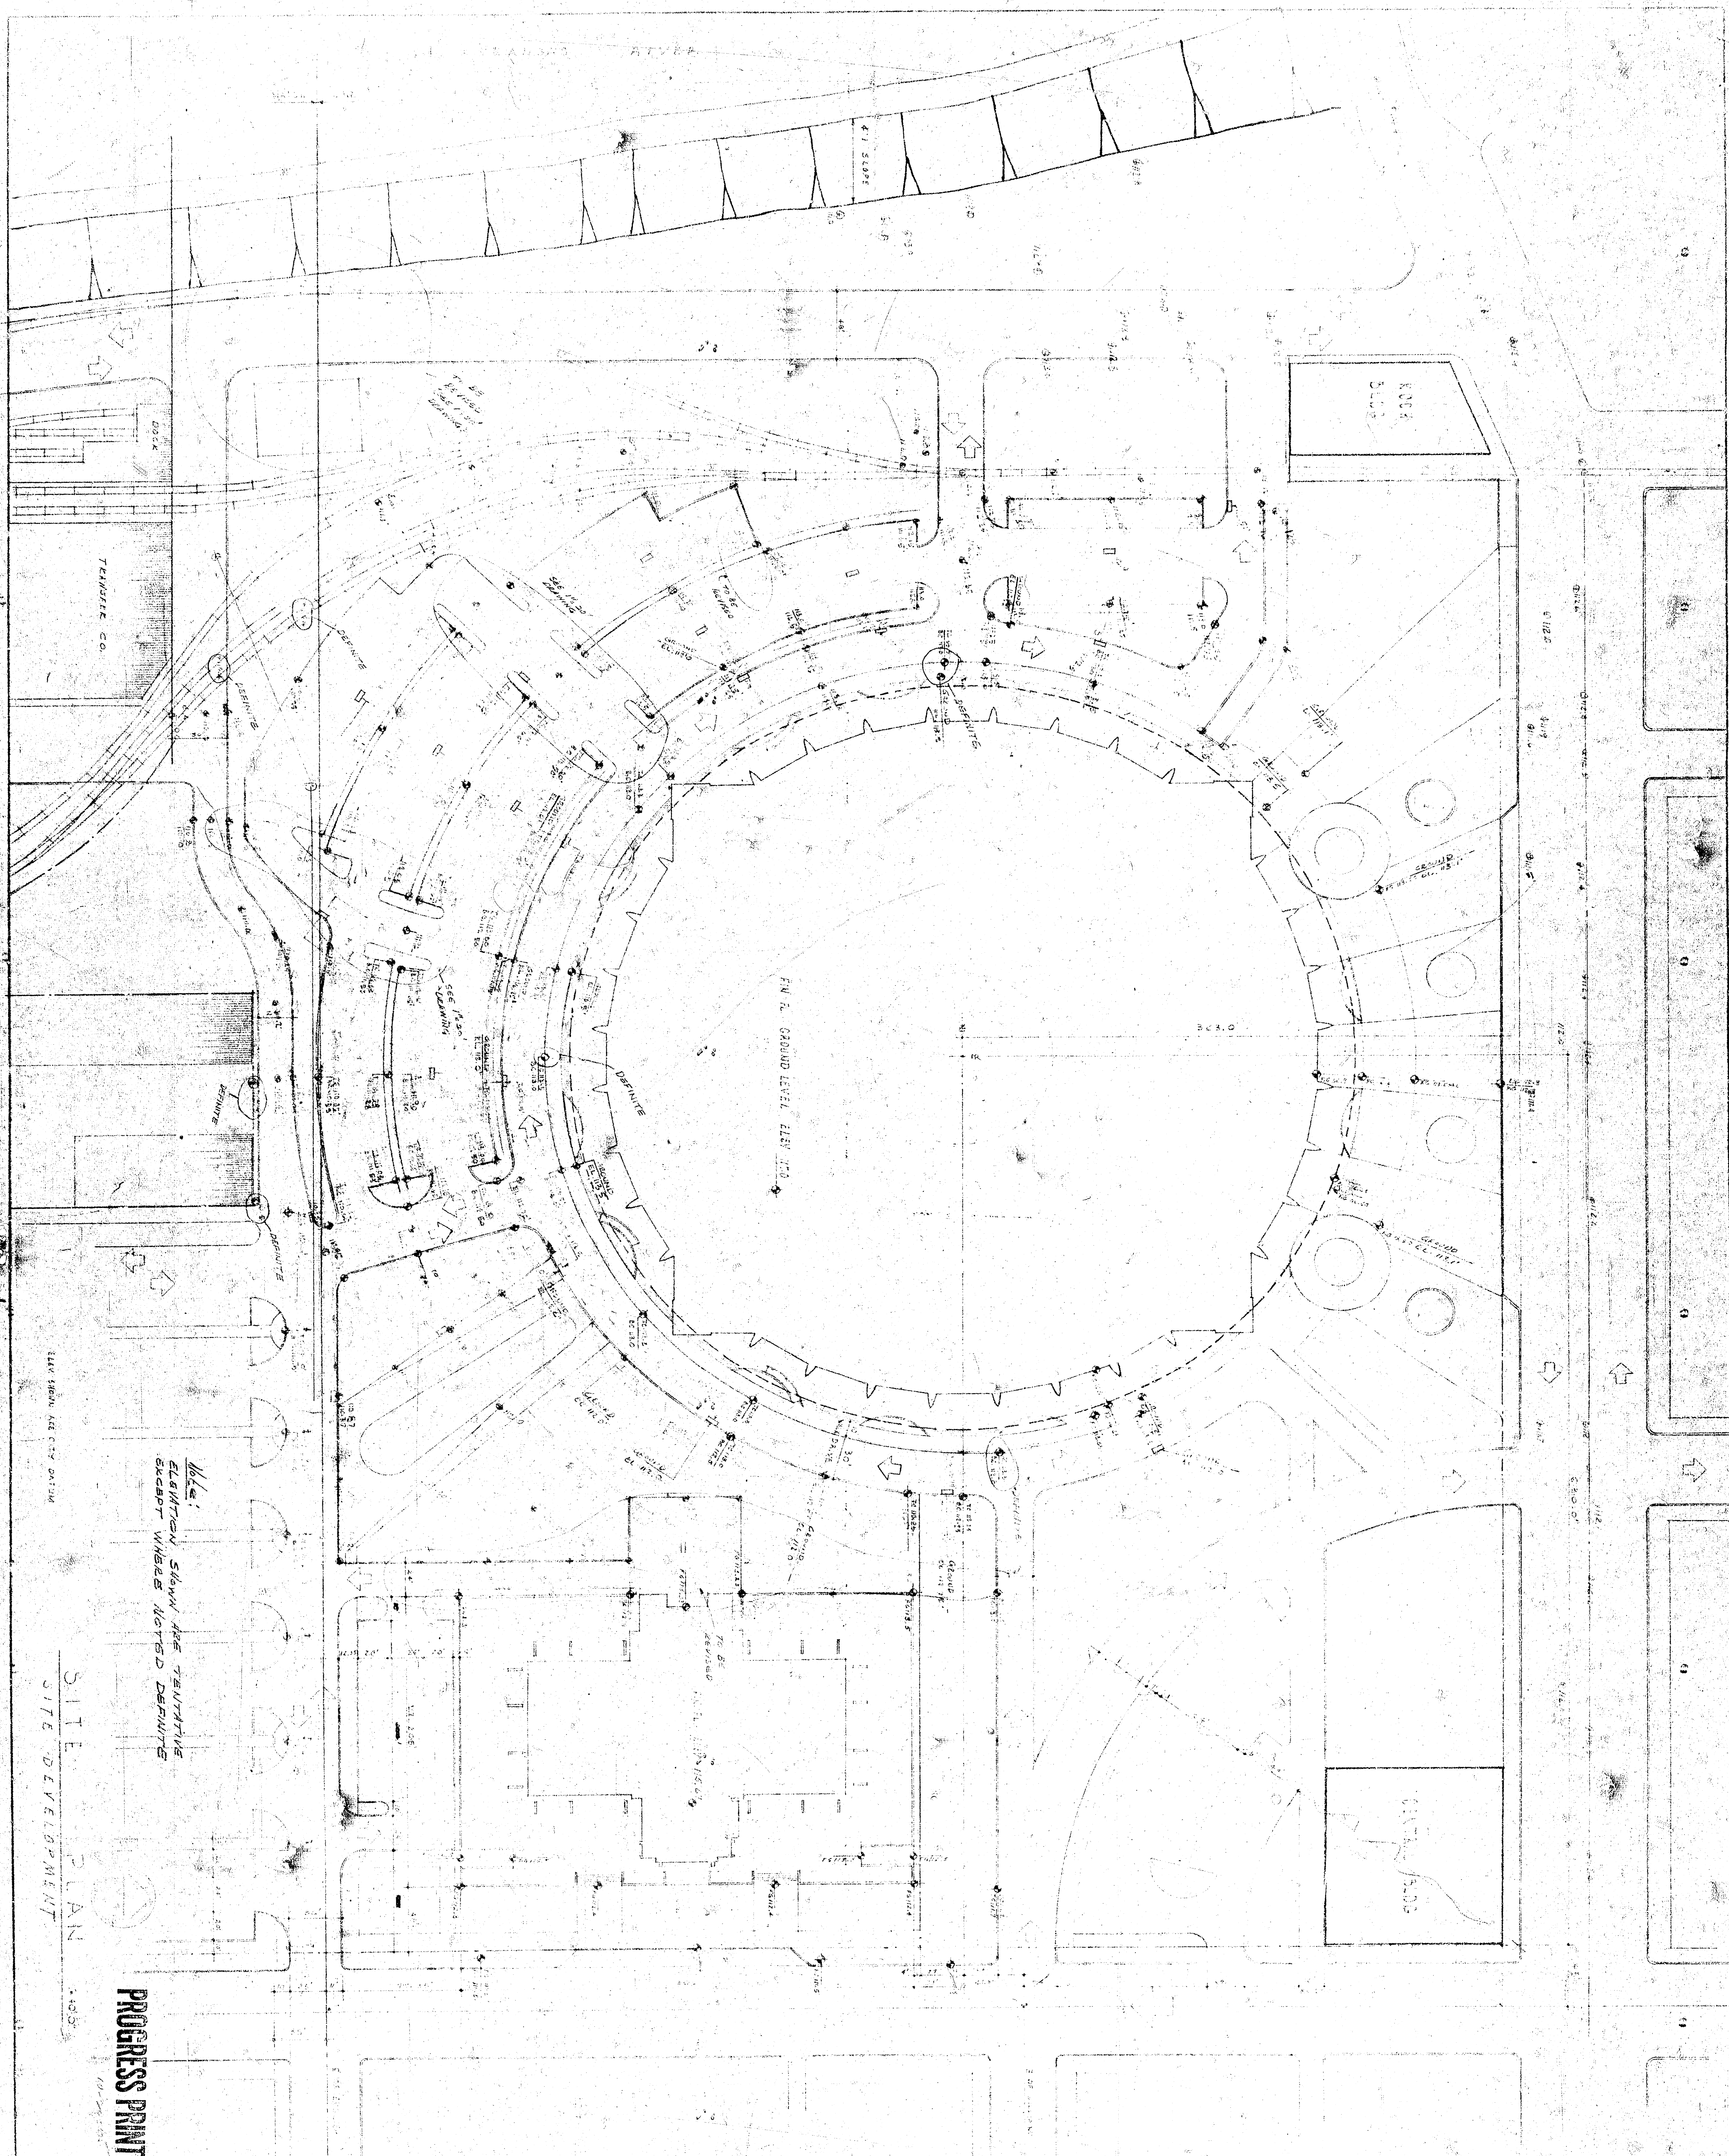

Notes:
ELEVATION SHOWN ARE TENTATIVE

PROGRESS PRINT
SITE PLAN
SITE DEVELOPMENT

CITY DEVELOPMENT
AUDITORIUM COMPLEX
CIVIC CULTURAL CENTER
CITY OF WICHITA, KANSAS

JOHN M. HICKMAN ASSOCIATES
PROJECT ARCHITECTS
PROJECT MANAGER
ASSOCIATE ARCHITECT

