



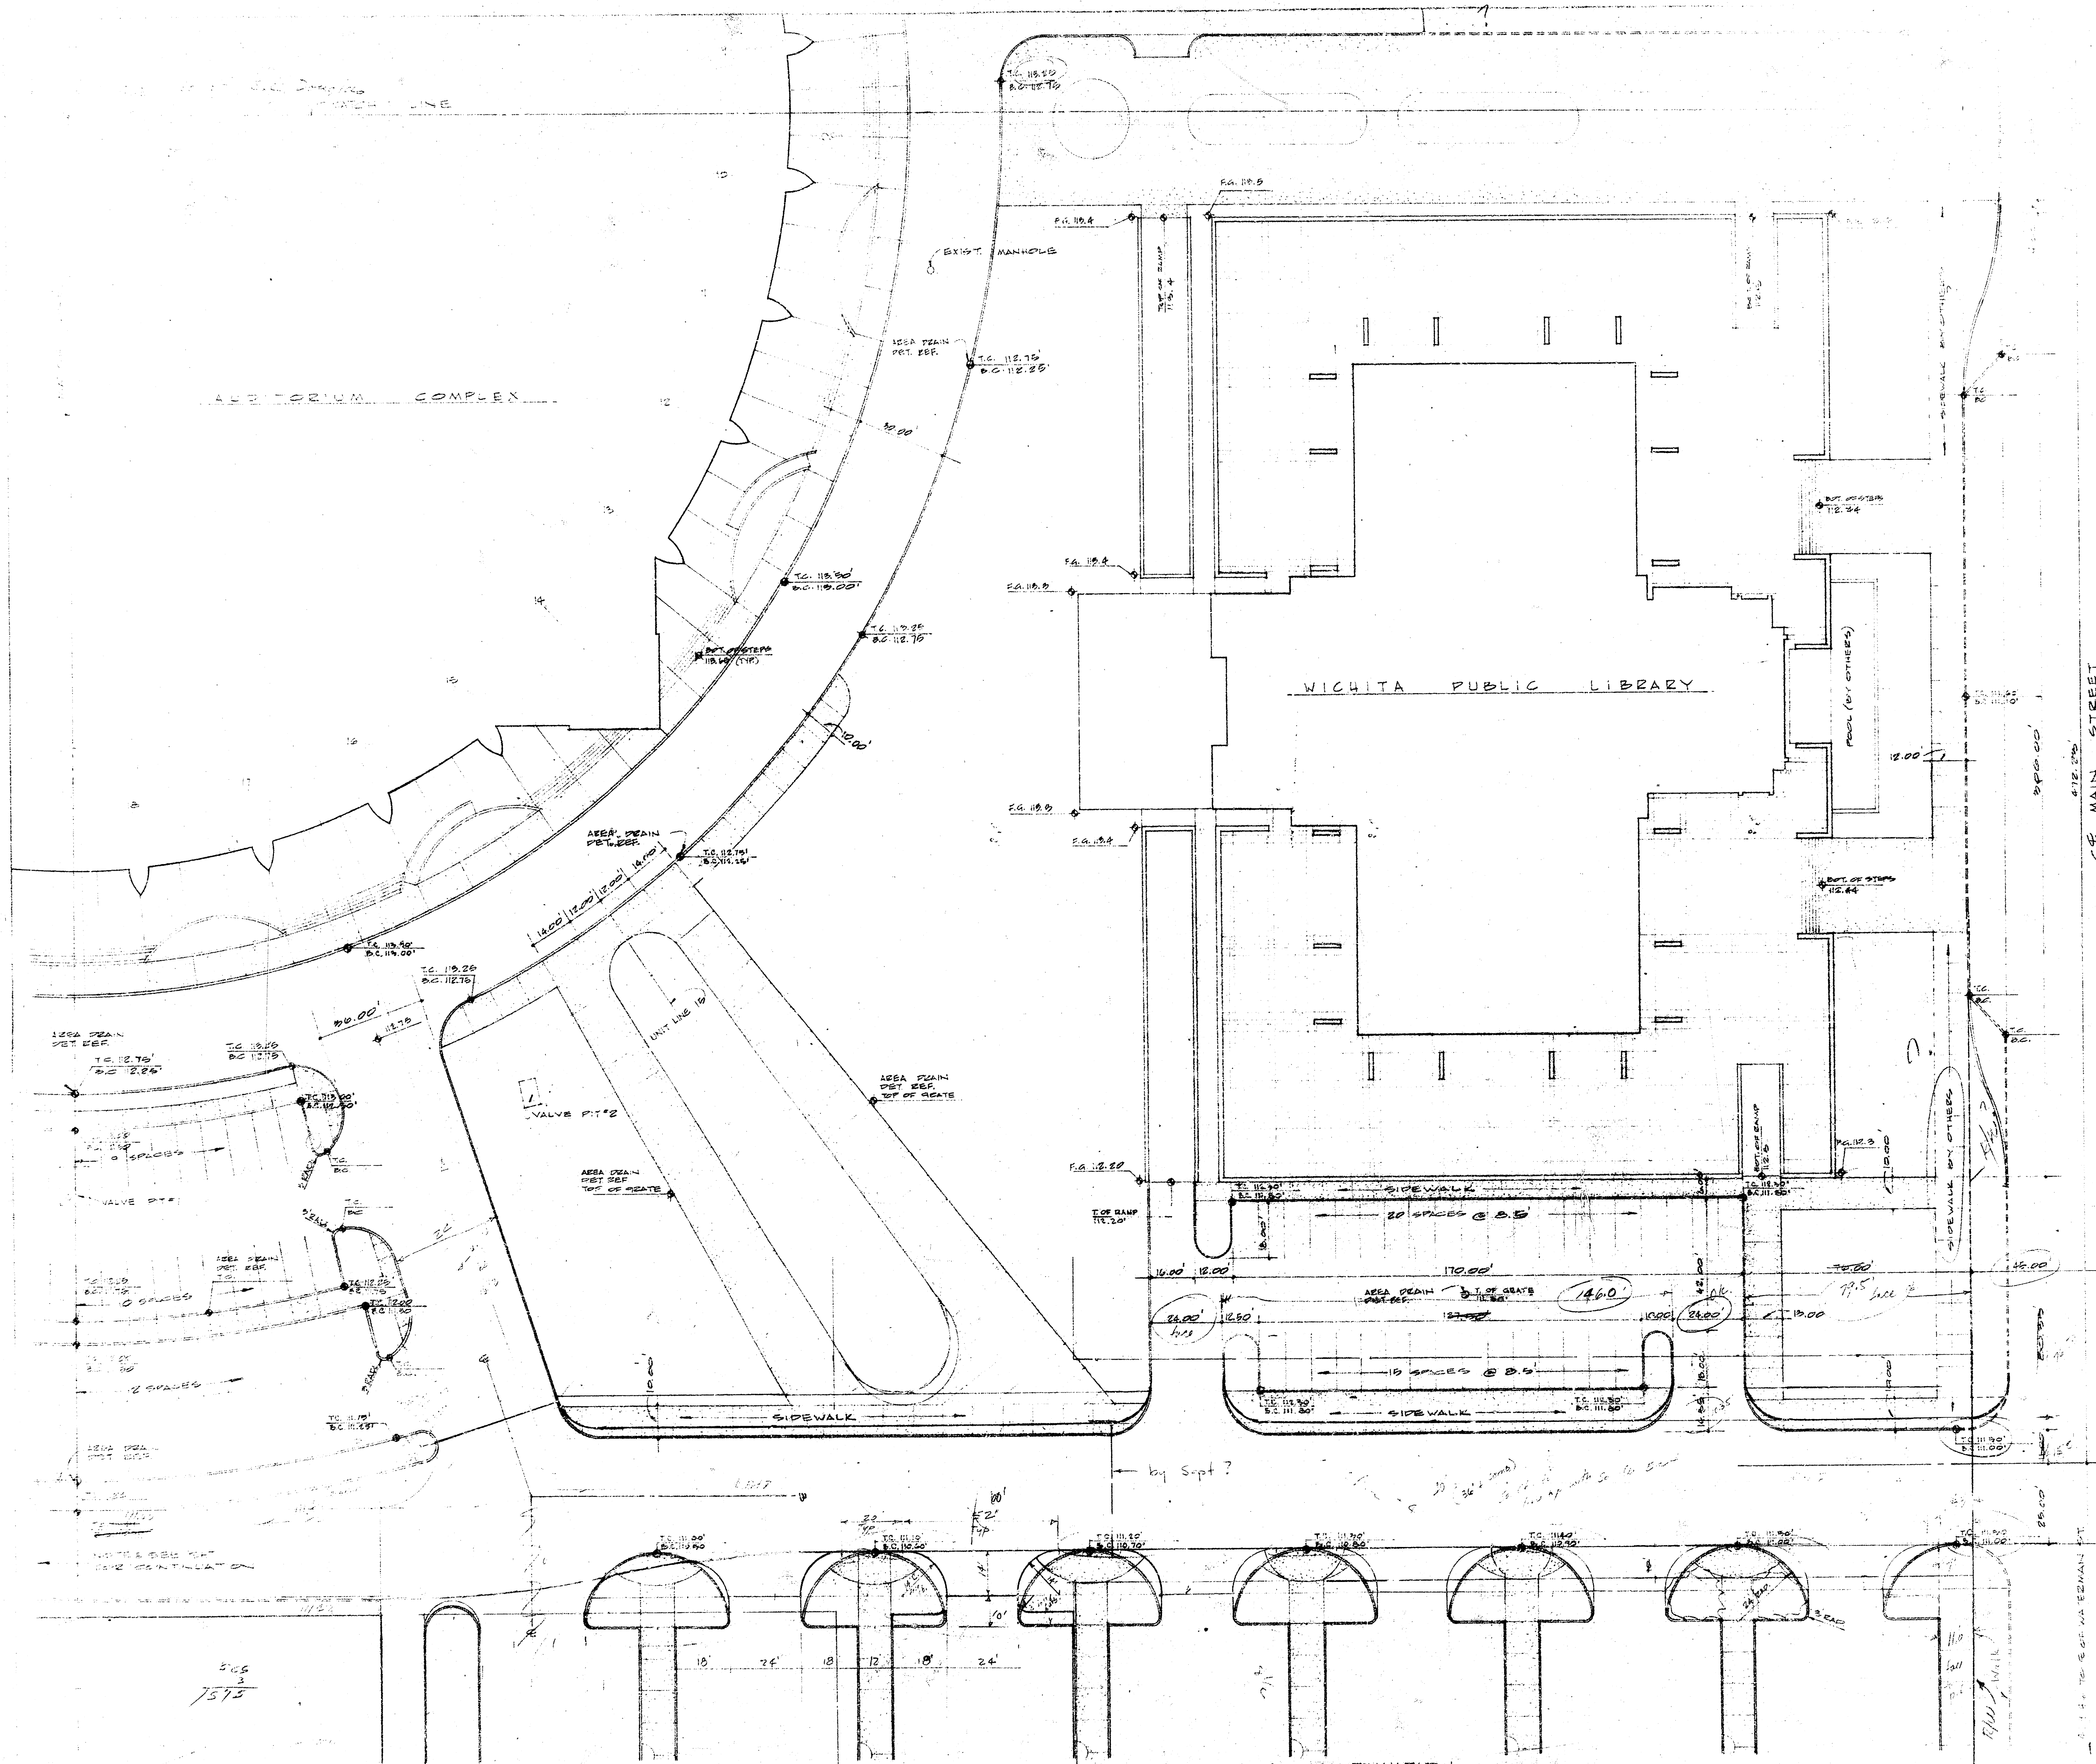

(27) (15)

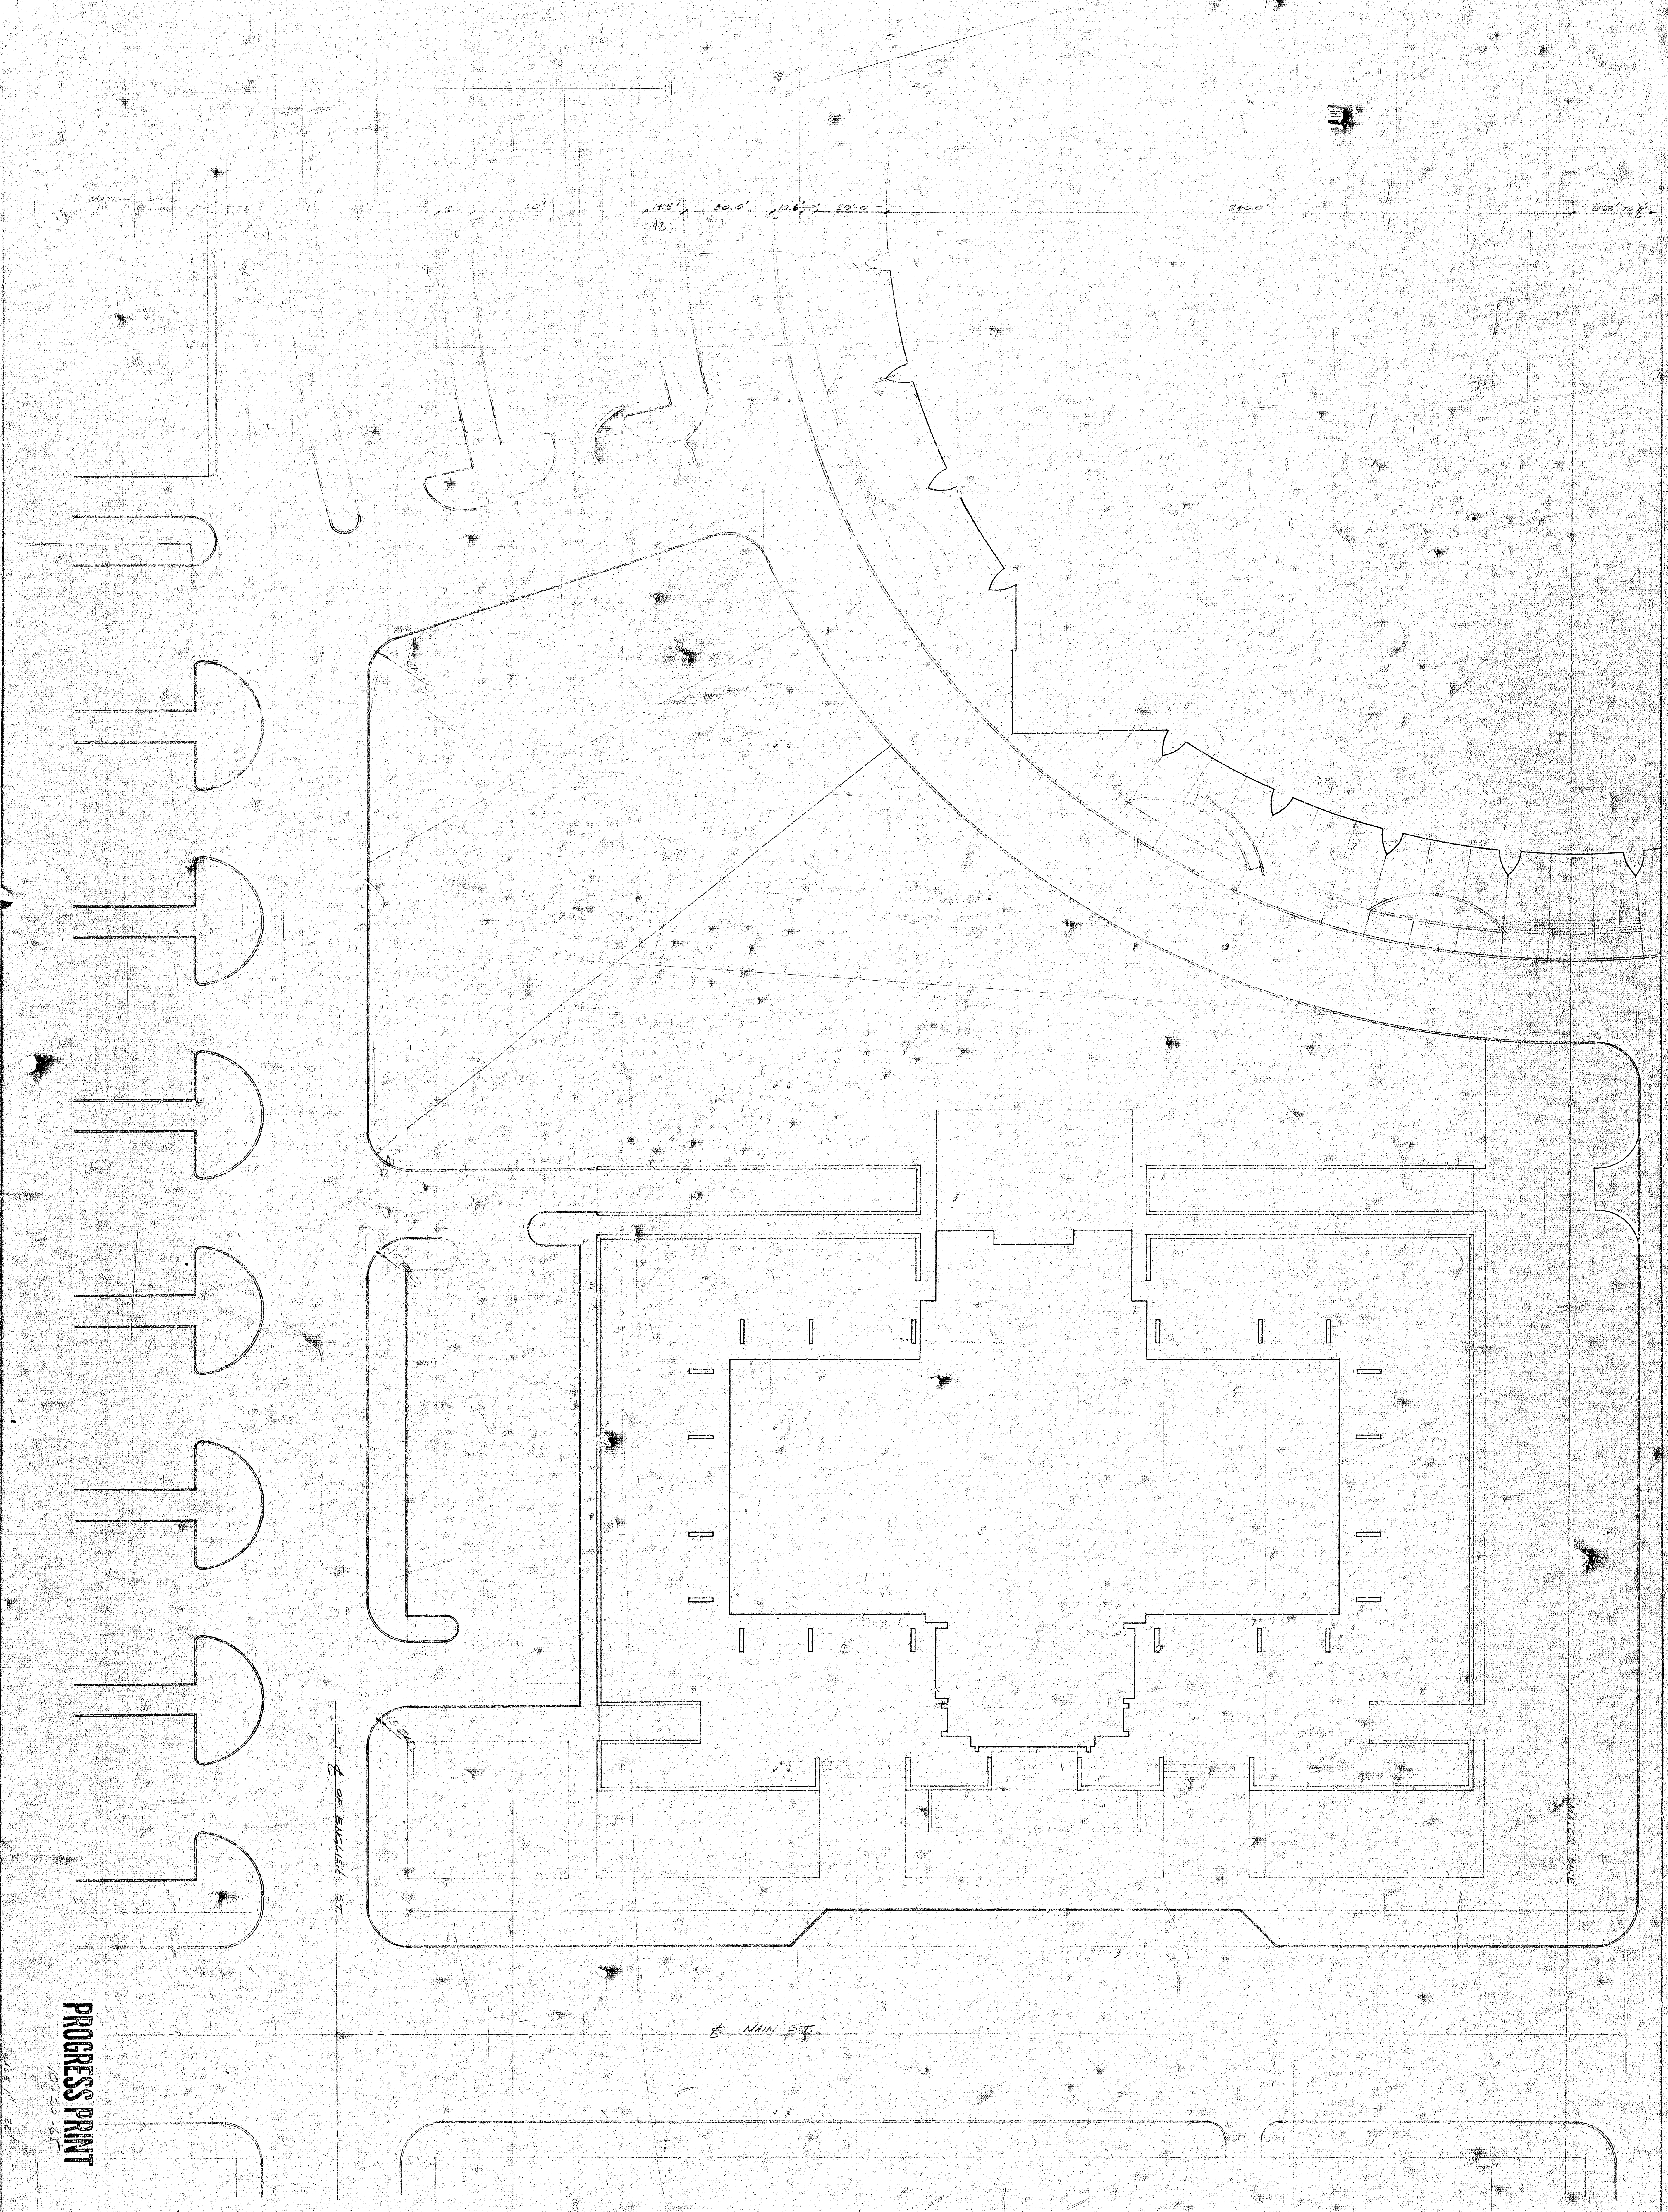

10-20-65

SHEET NO.	DATE REVISIONS	SITE DEVELOPMENT CIVIC CULTURAL CENTER CITY OF WICHITA, KANSAS		JOHN M. HICKMAN ASSOCIATES PROJECT ARCHITECTS KRUSE ROBERT SMITH ASSOCIATES ARCHITECTS	
--------------	-------------------	--	--	---	--

