


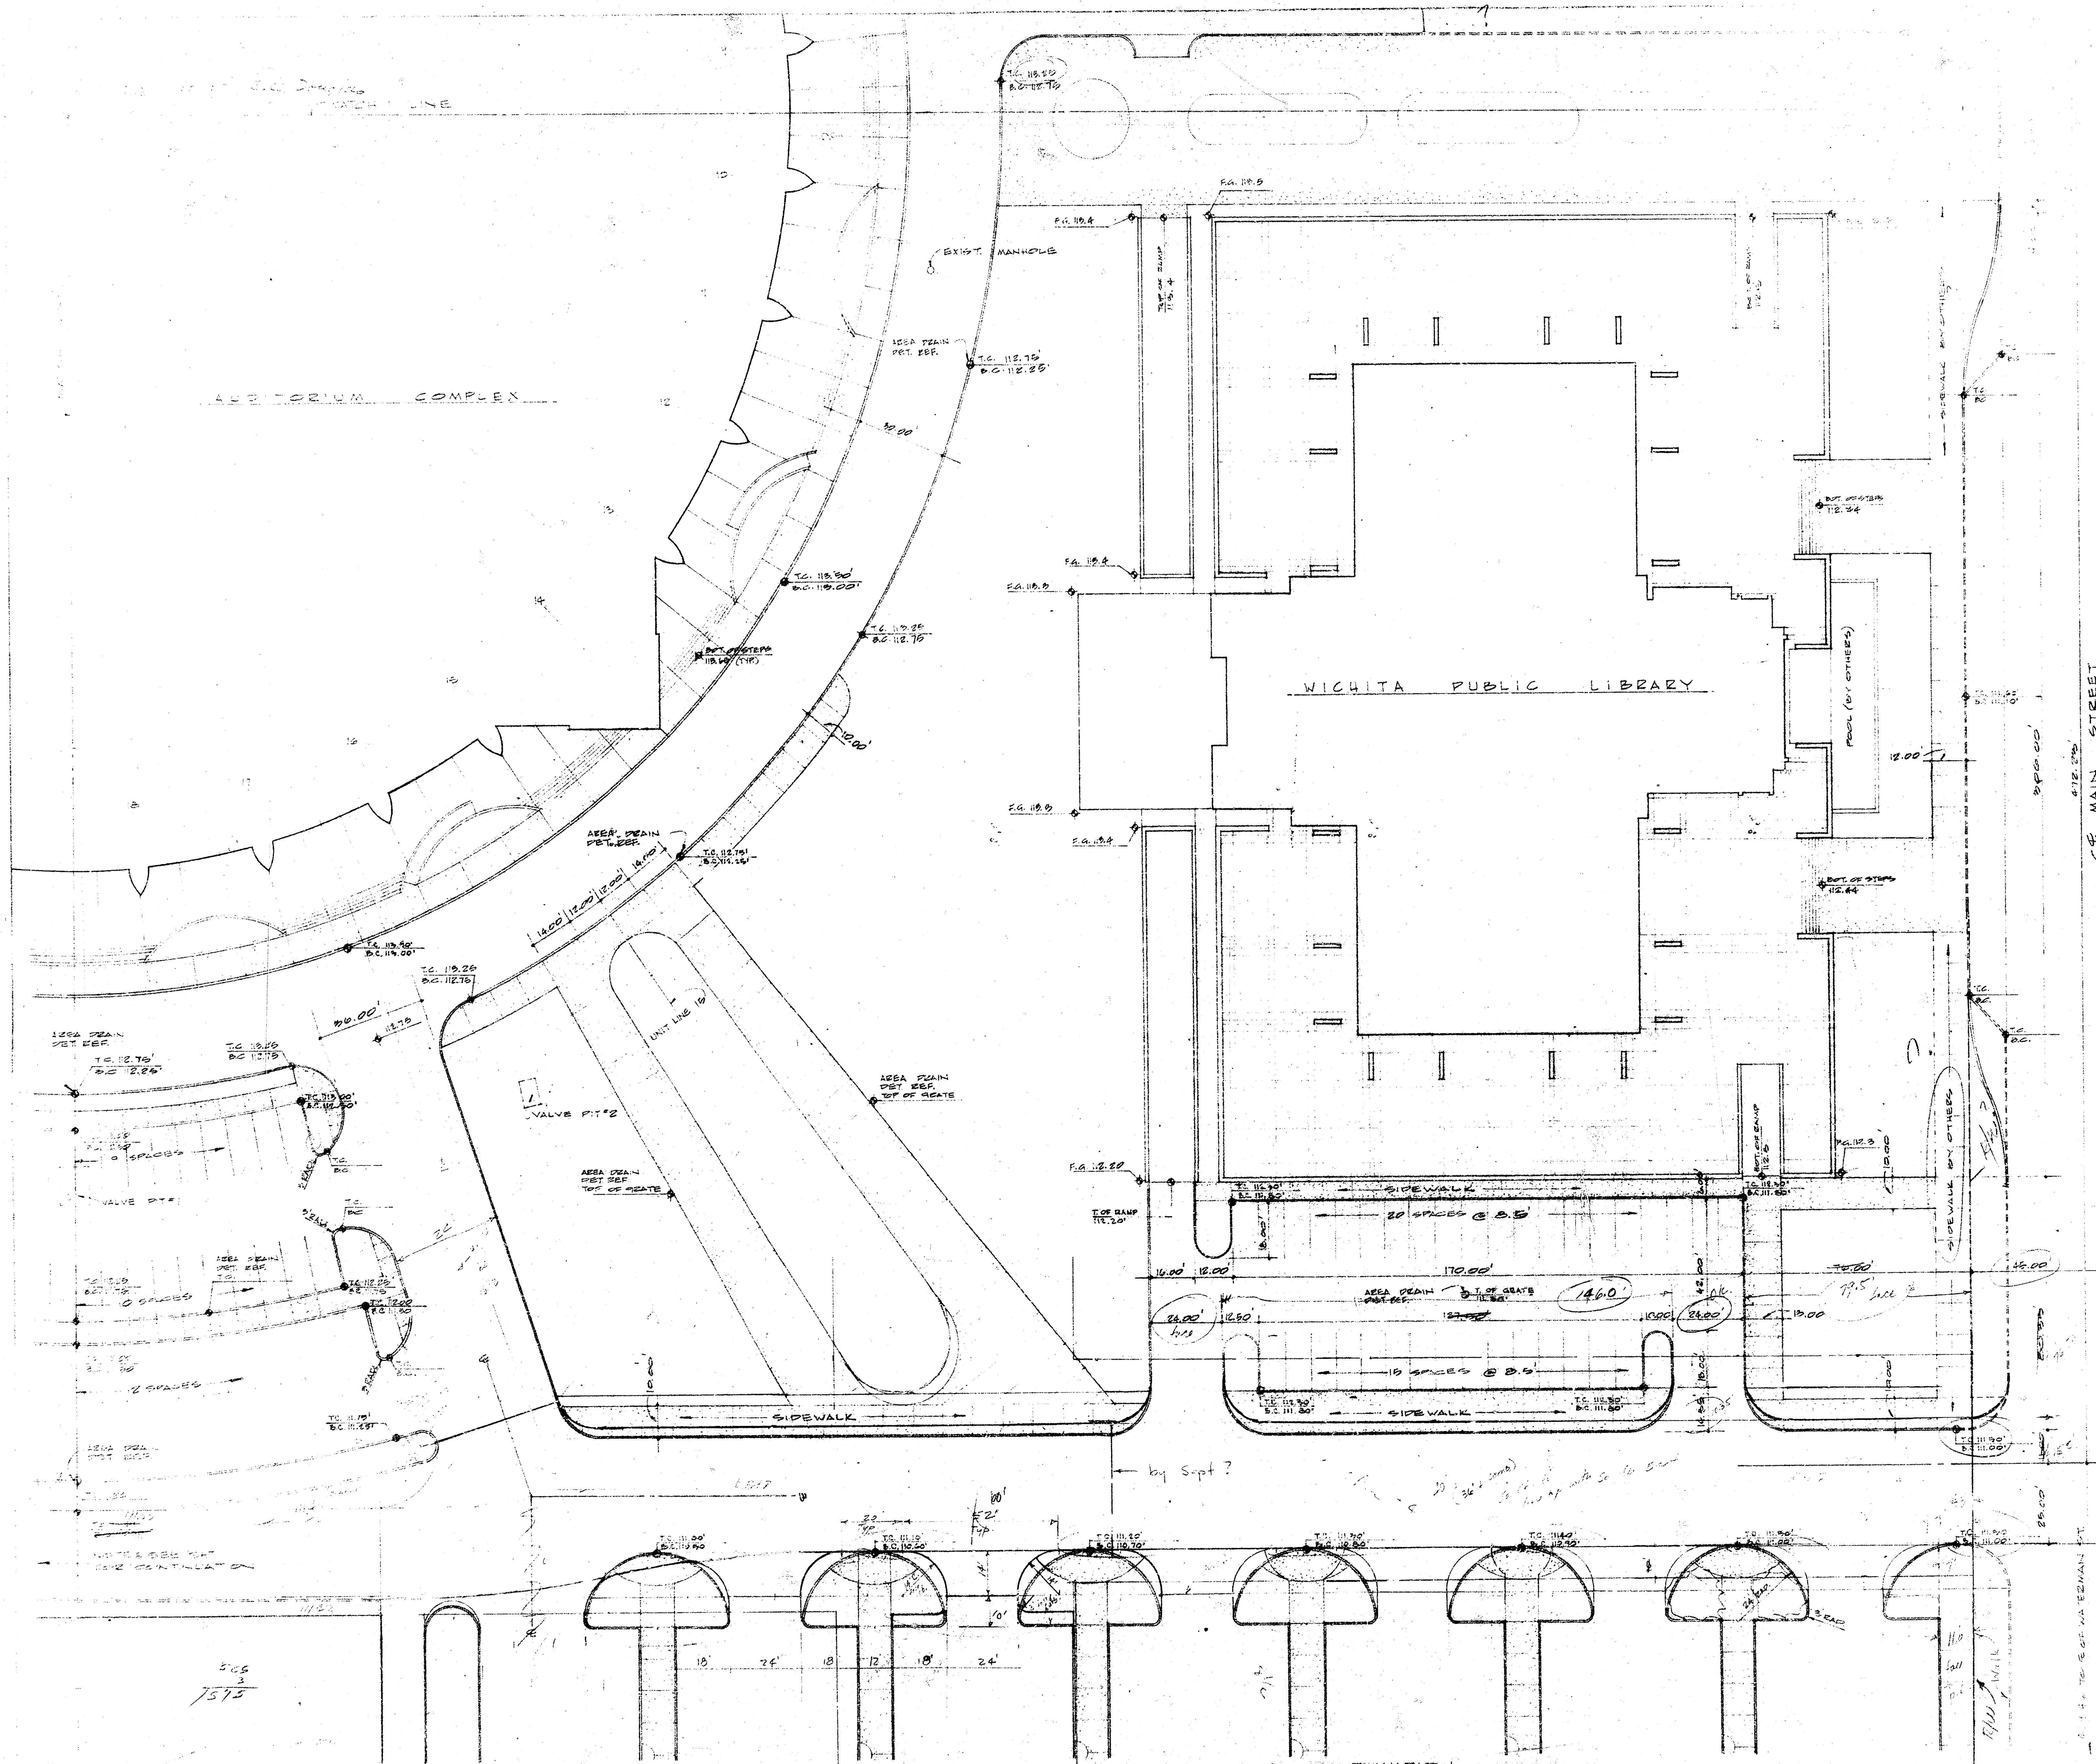


NOTE: SEE SHT. FOR CONTINUATION

PLAN

ARKANSAS RIVER

DOUGLAS AVE

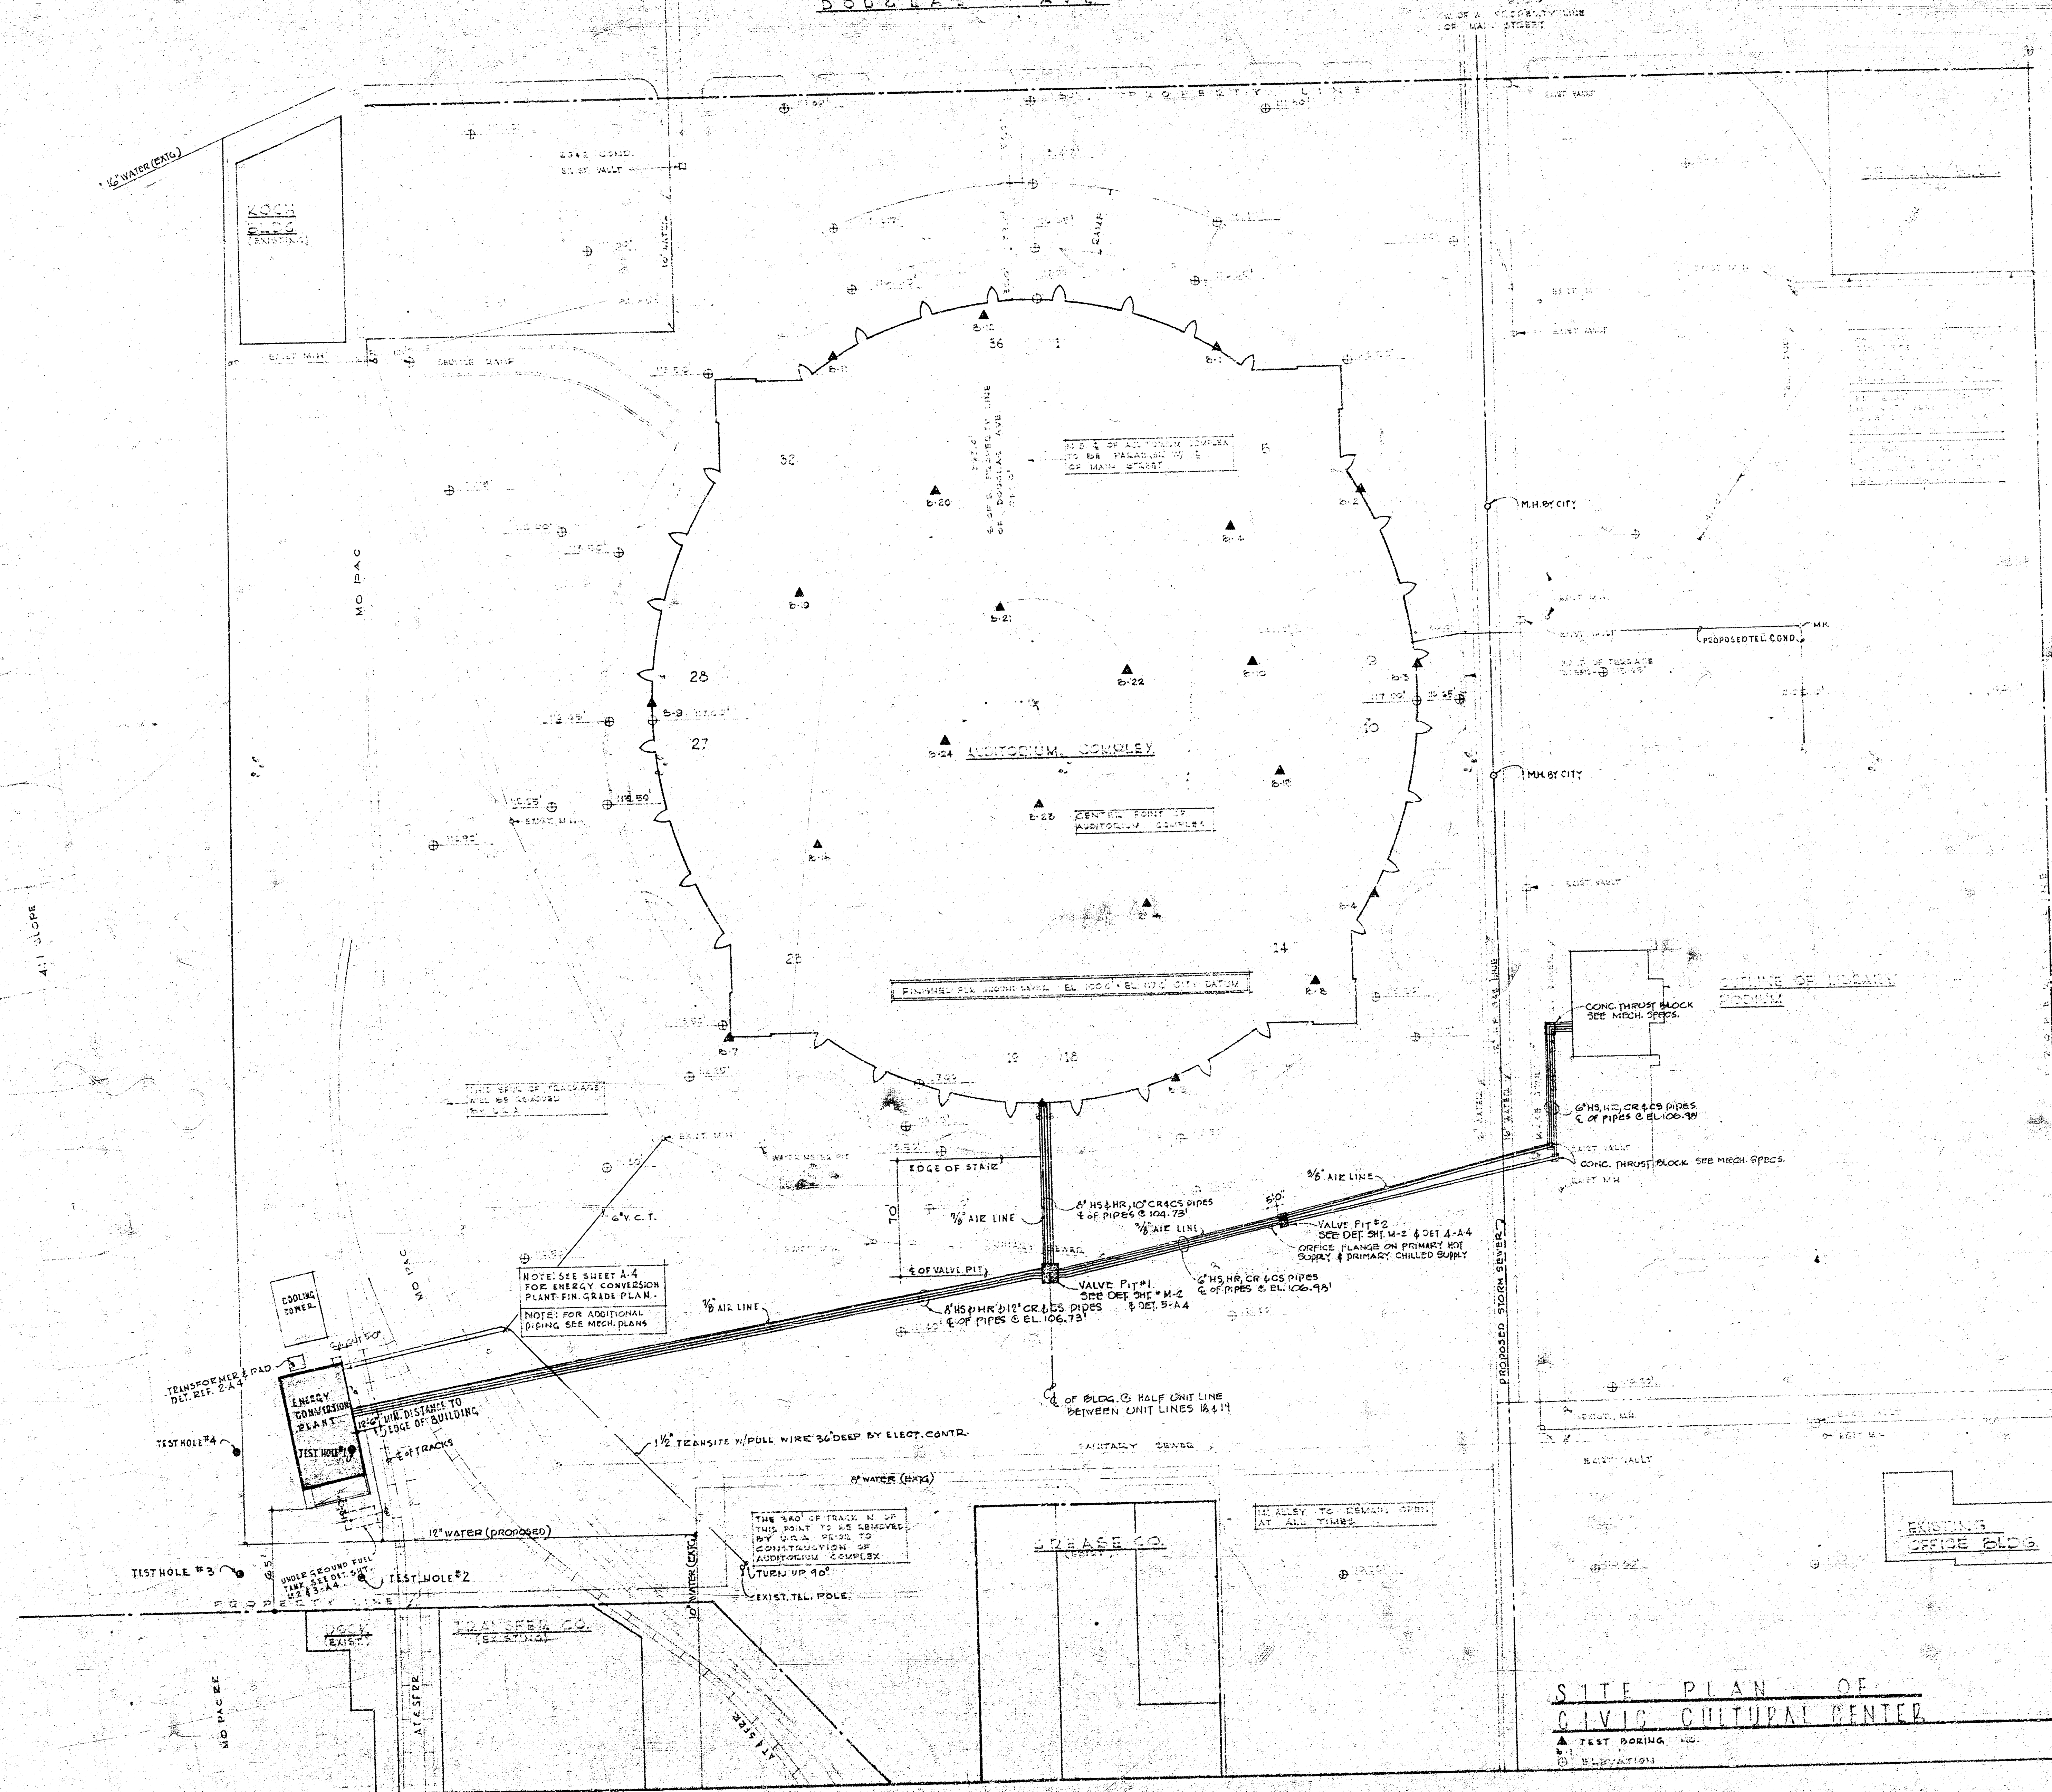

SITE PLAN OF
CIVIC CULTURAL CENTER

PROGRESS PRINT
12/1/85
N

CIVIC CULTURAL CENTER
CITY OF WICHITA, KANSAS