



WICHITA UNDERGROUND SYSTEM
CONDUIT CONSTRUCTION
 EXISTING SUB-SURFACE STRUCTURES
 ALLEY EAST OF PLANT
 APPROVED APRIL 1985 ENGINEER
 SCALE 1" = 40'
KANSAS GAS AND ELECTRIC COMPANY
WICHITA KANSAS
 KD-1751

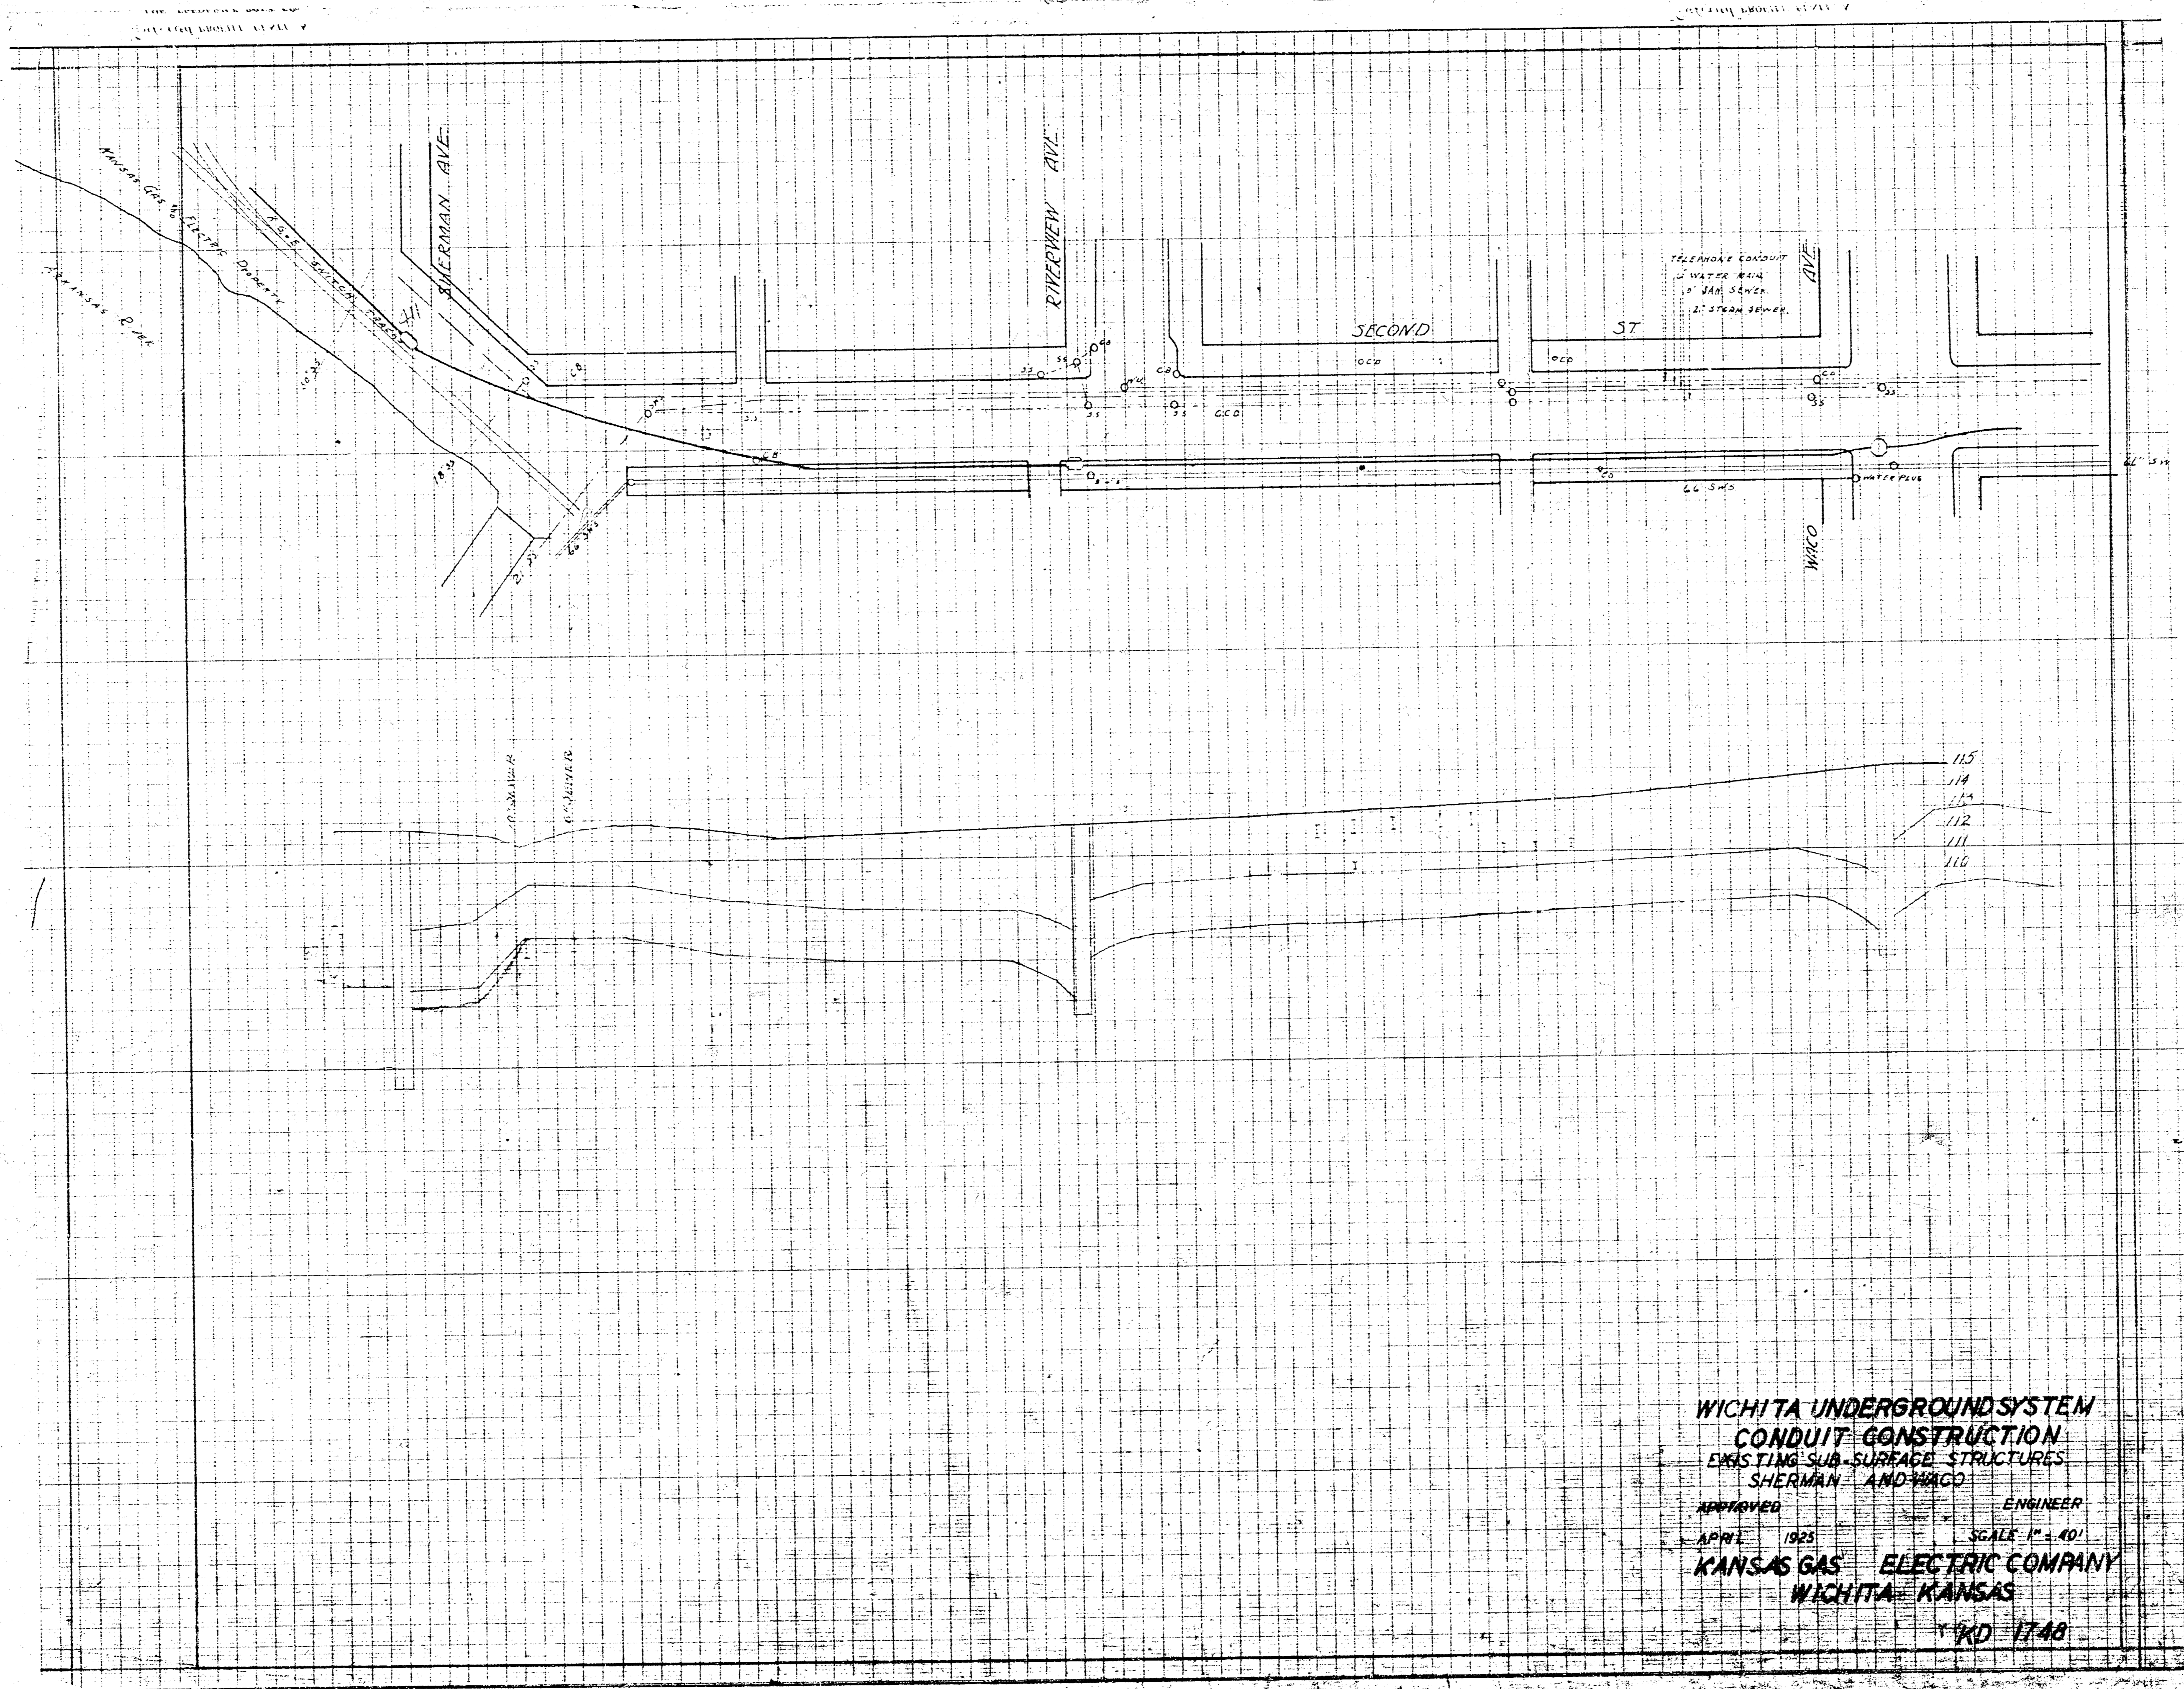

WICHITA UNDERGROUND SYSTEM
CONDUIT CONSTRUCTION
 EXISTING SUB-SURFACE STRUCTURES
 SHERMAN AND WACO
 APPROVED APRIL 1923 ENGINEER
 KANSAS GAS & ELECTRIC COMPANY
 WICHITA, KANSAS
 KD 1748

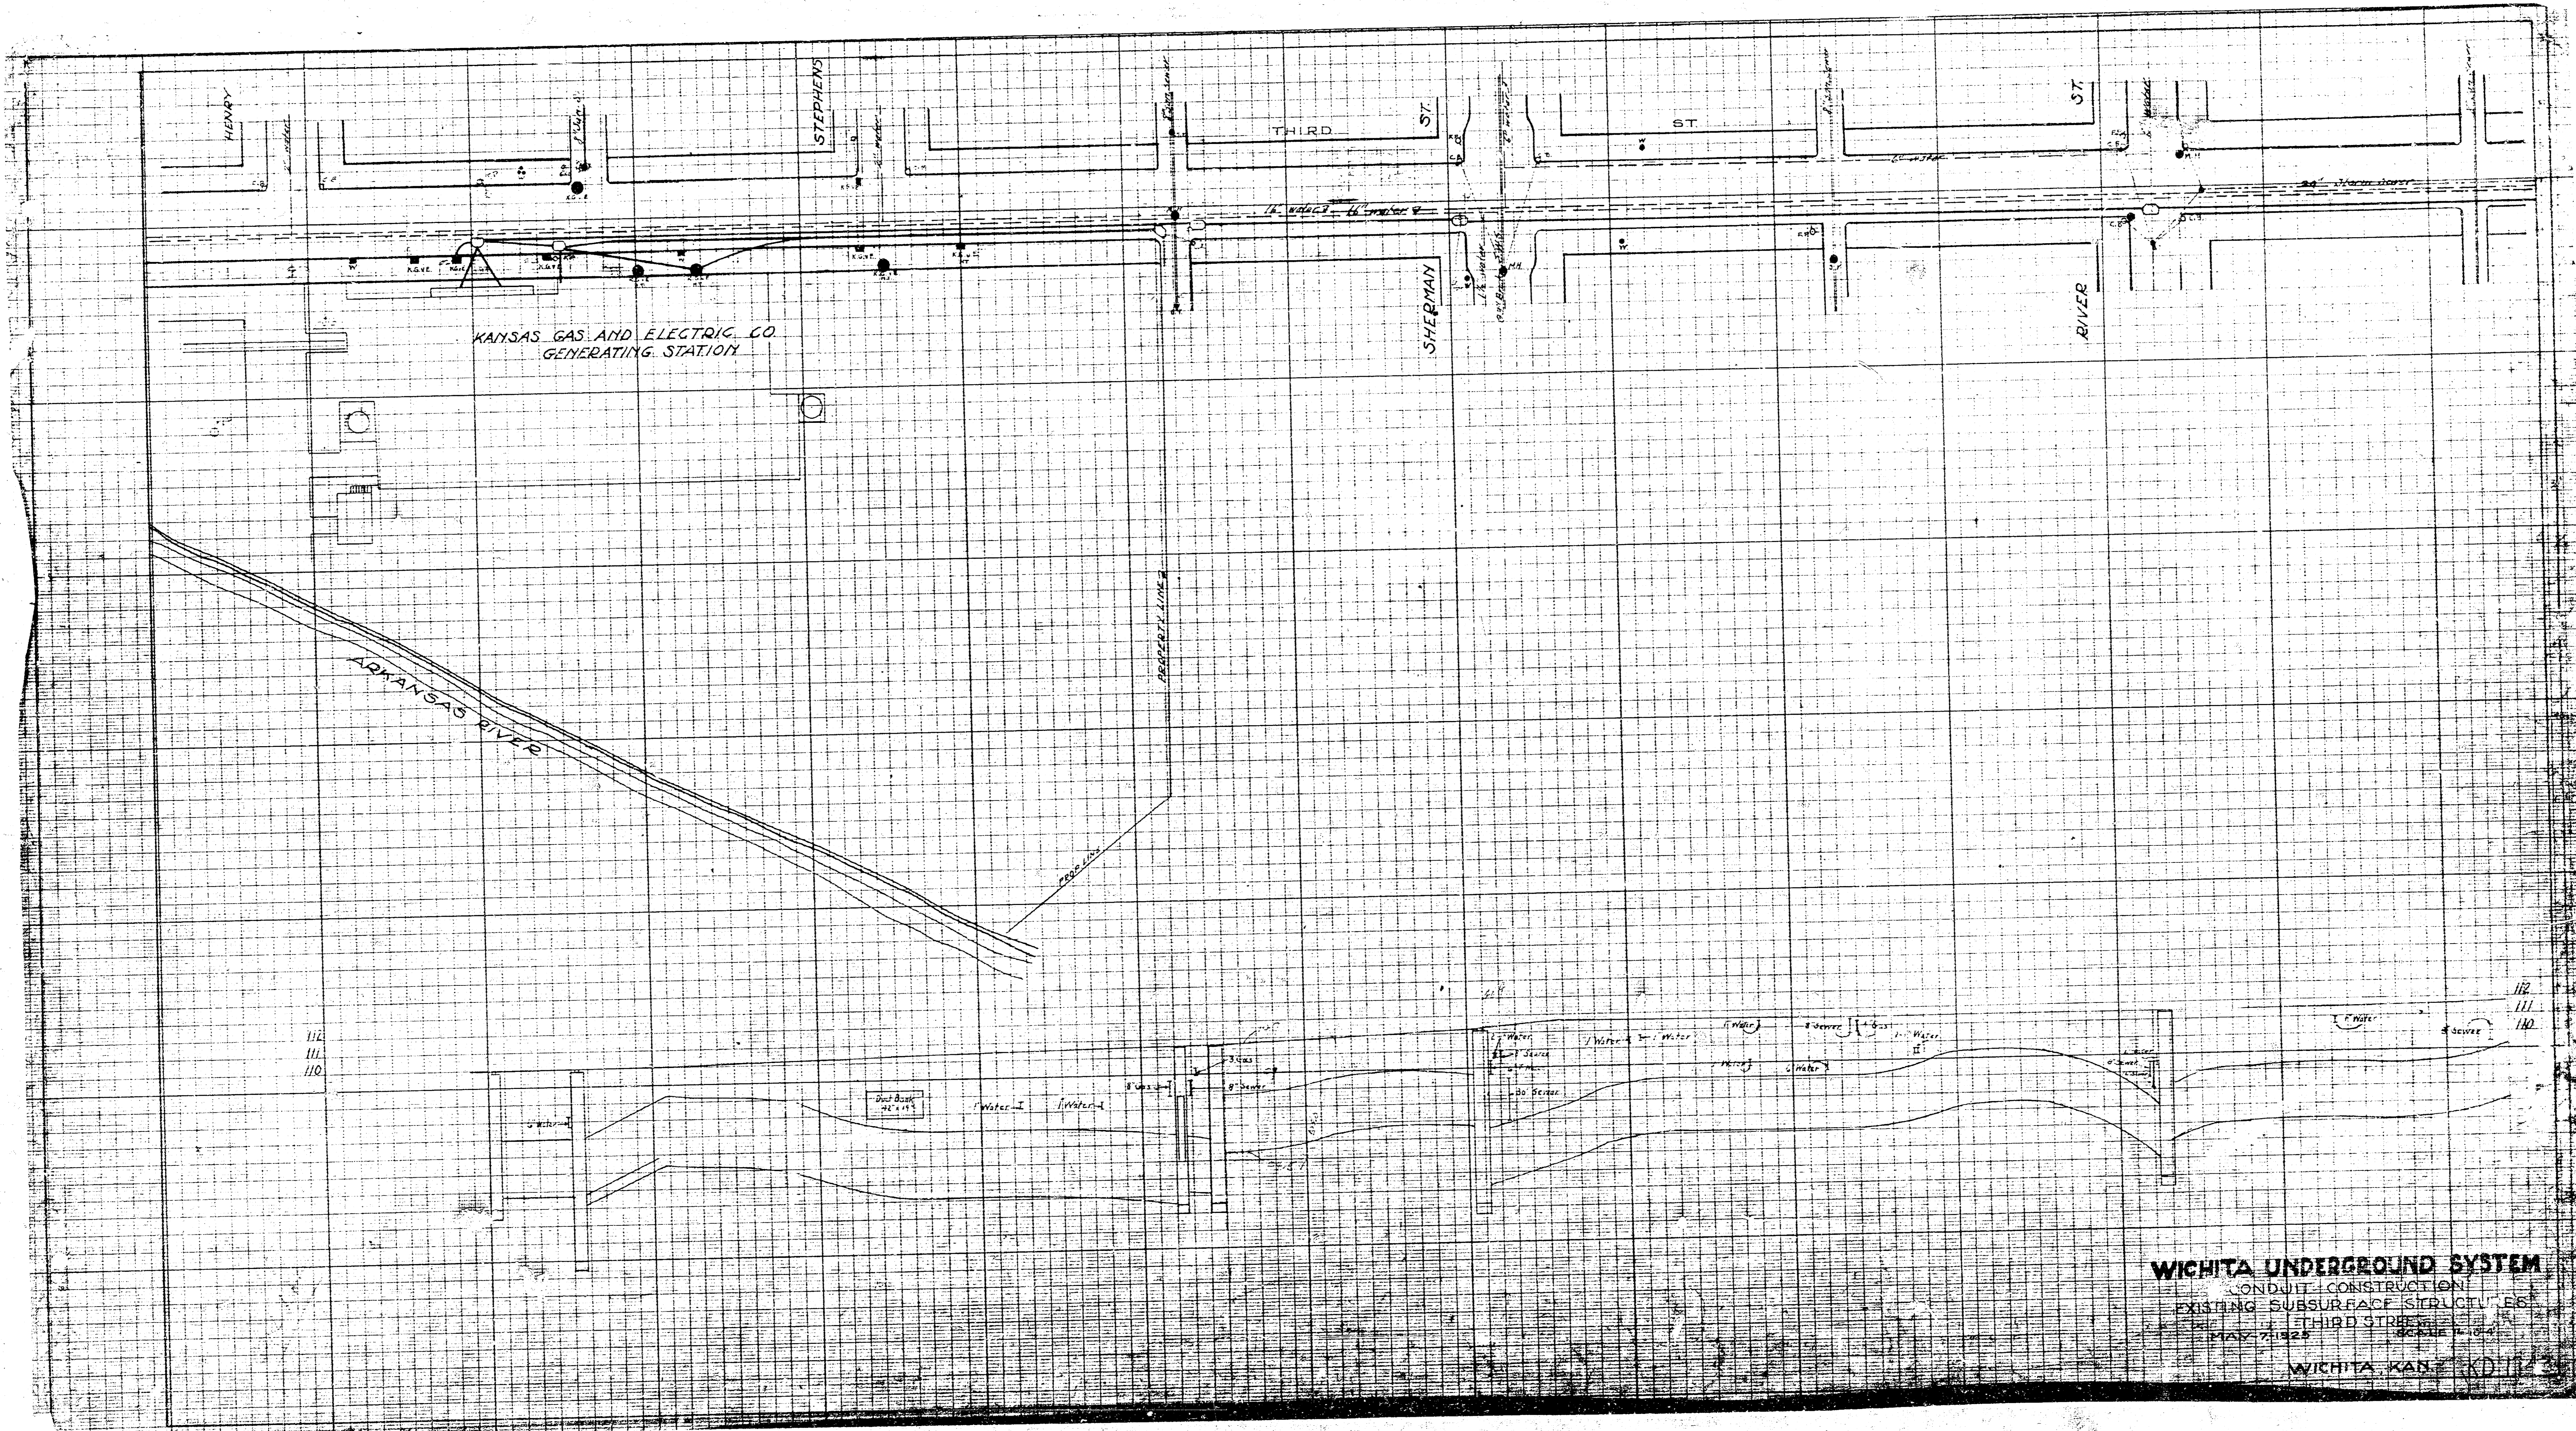

WICHITA UNDERGROUND SYSTEM
CONDUIT CONSTRUCTION
EXISTING SUBSURFACE STRUCTURES
THIRD STREET
MAY 7, 1925
WICHITA, KAN. KD 1123

