


RIVER	COUNTY	MILEAGE	SHEET	TOTAL

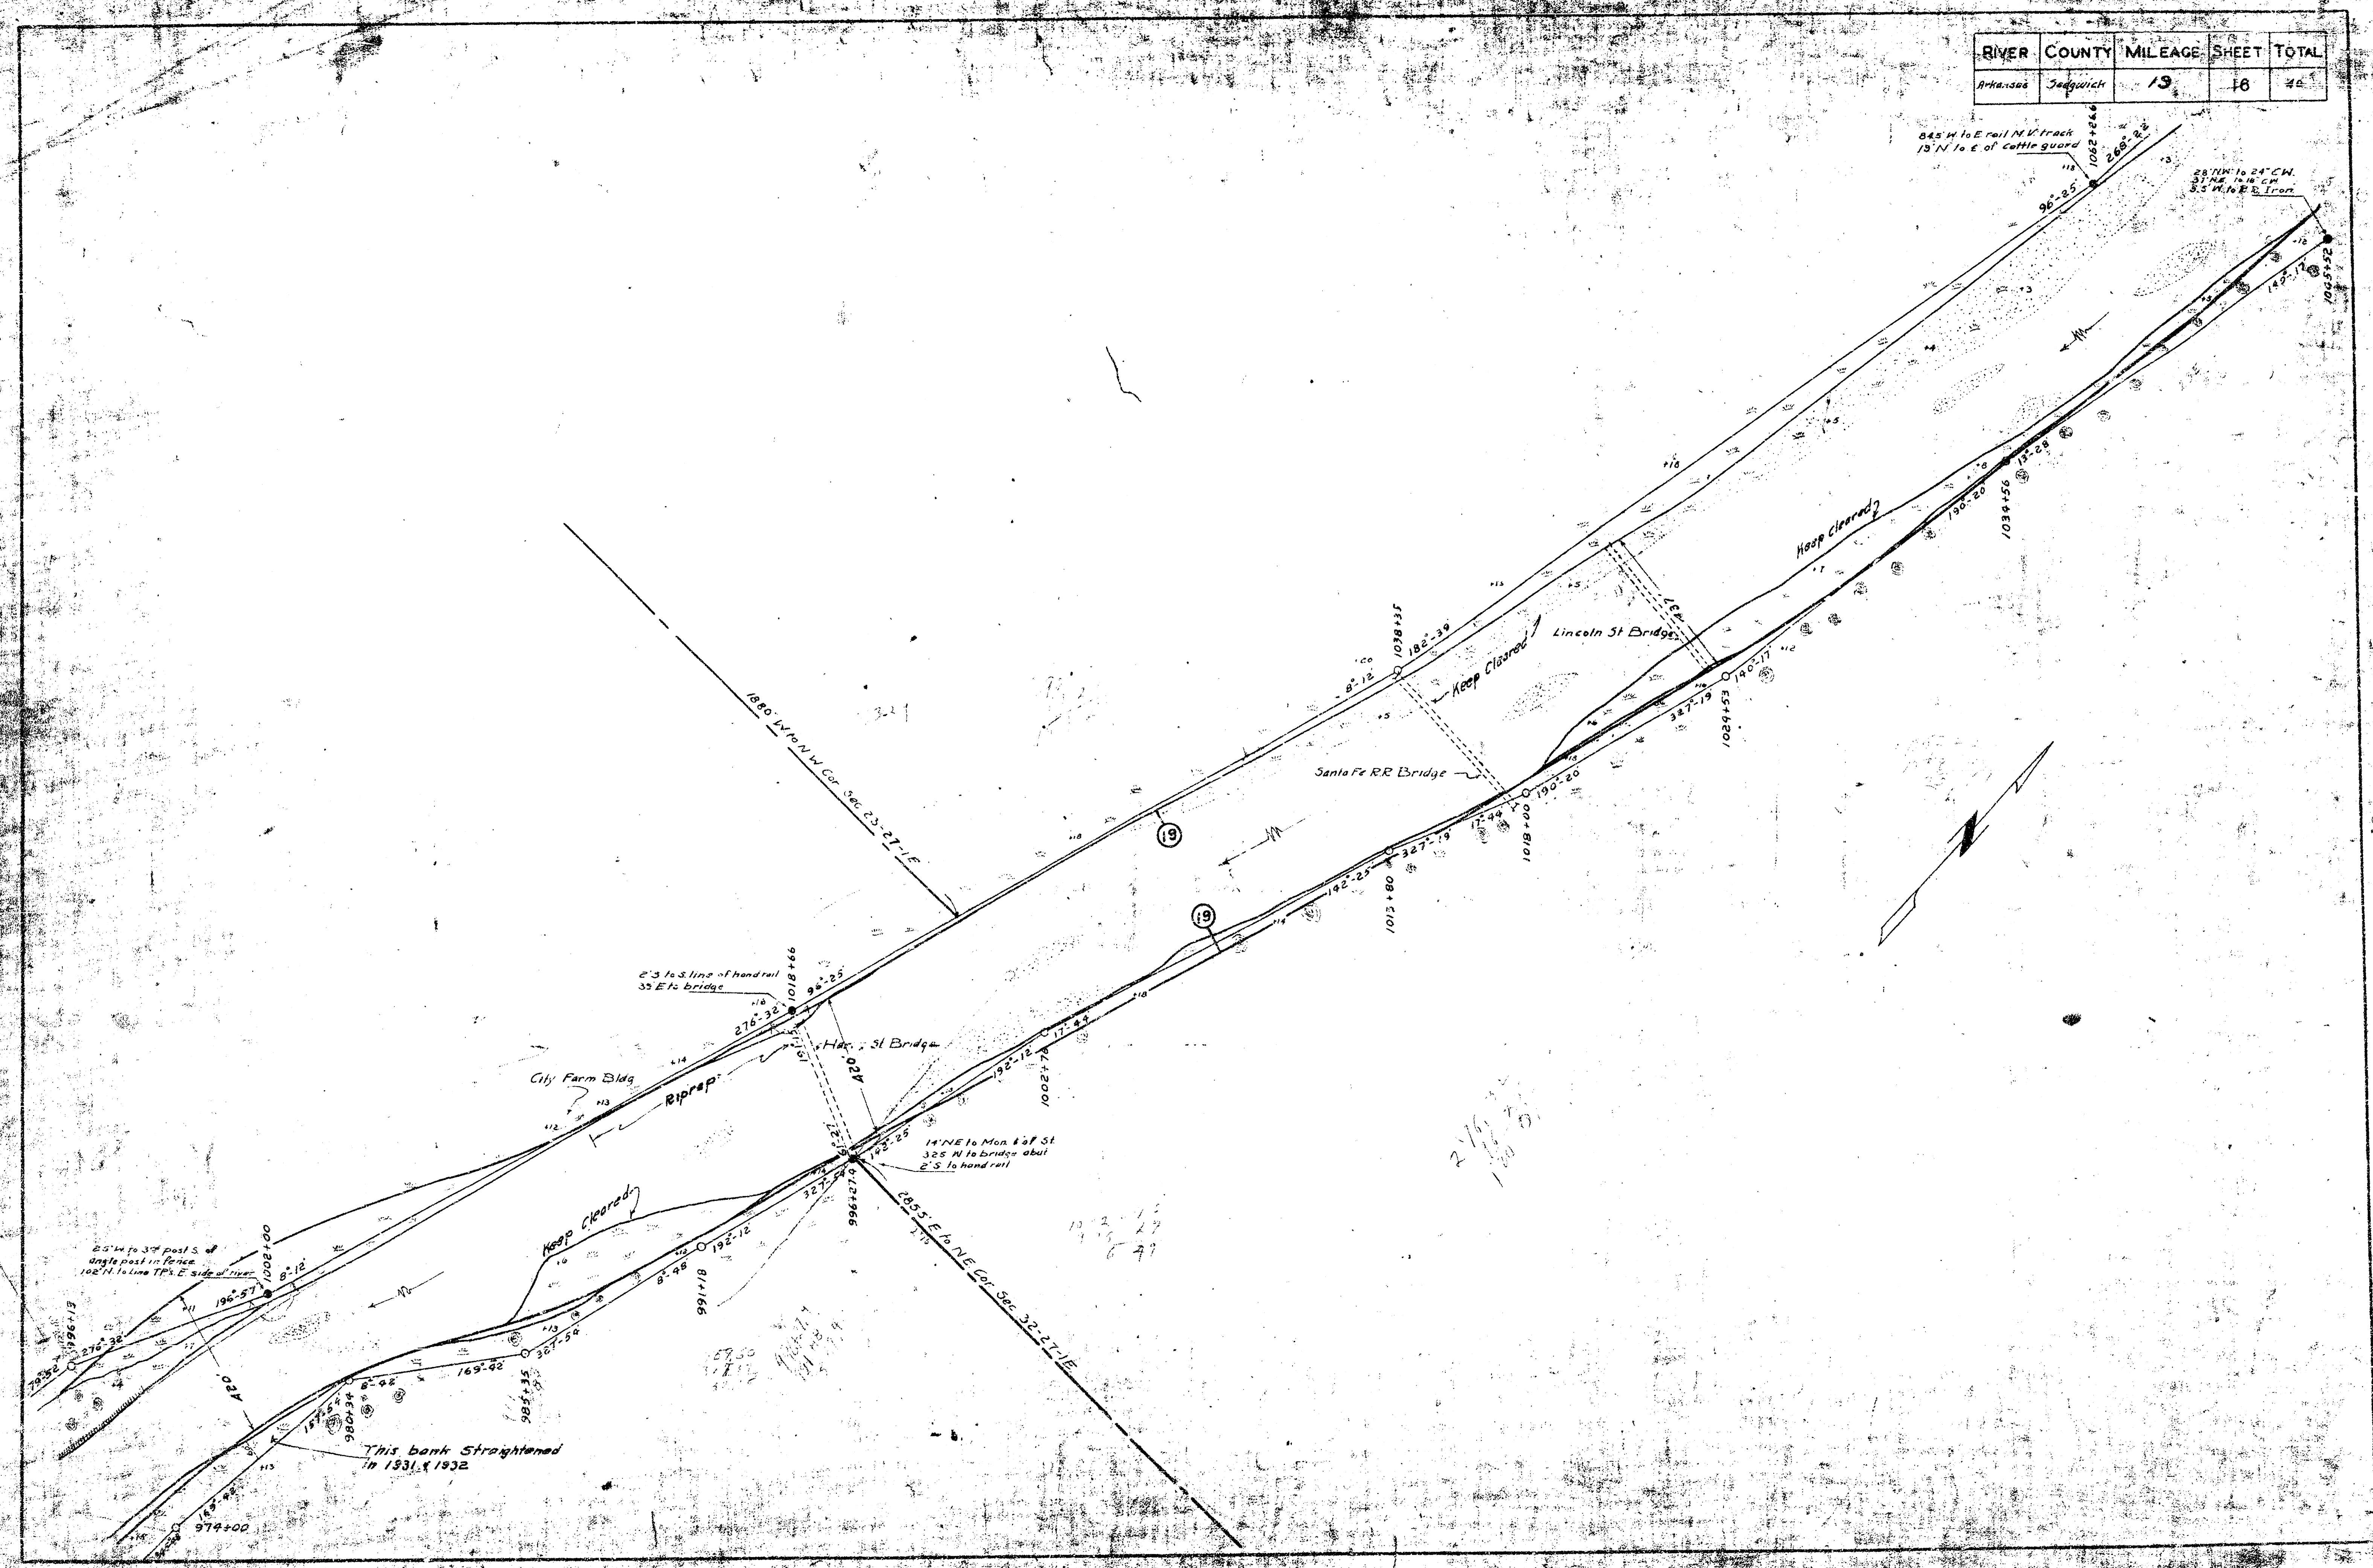

RIVER	COUNTY	MILEAGE	SHEET	TOTAL
Arkansas	Sedgwick	17 to 18	15	40

