


ARKANSAS RIVER

CHANNEL CHANGE
FLOOD OF APRIL 1944

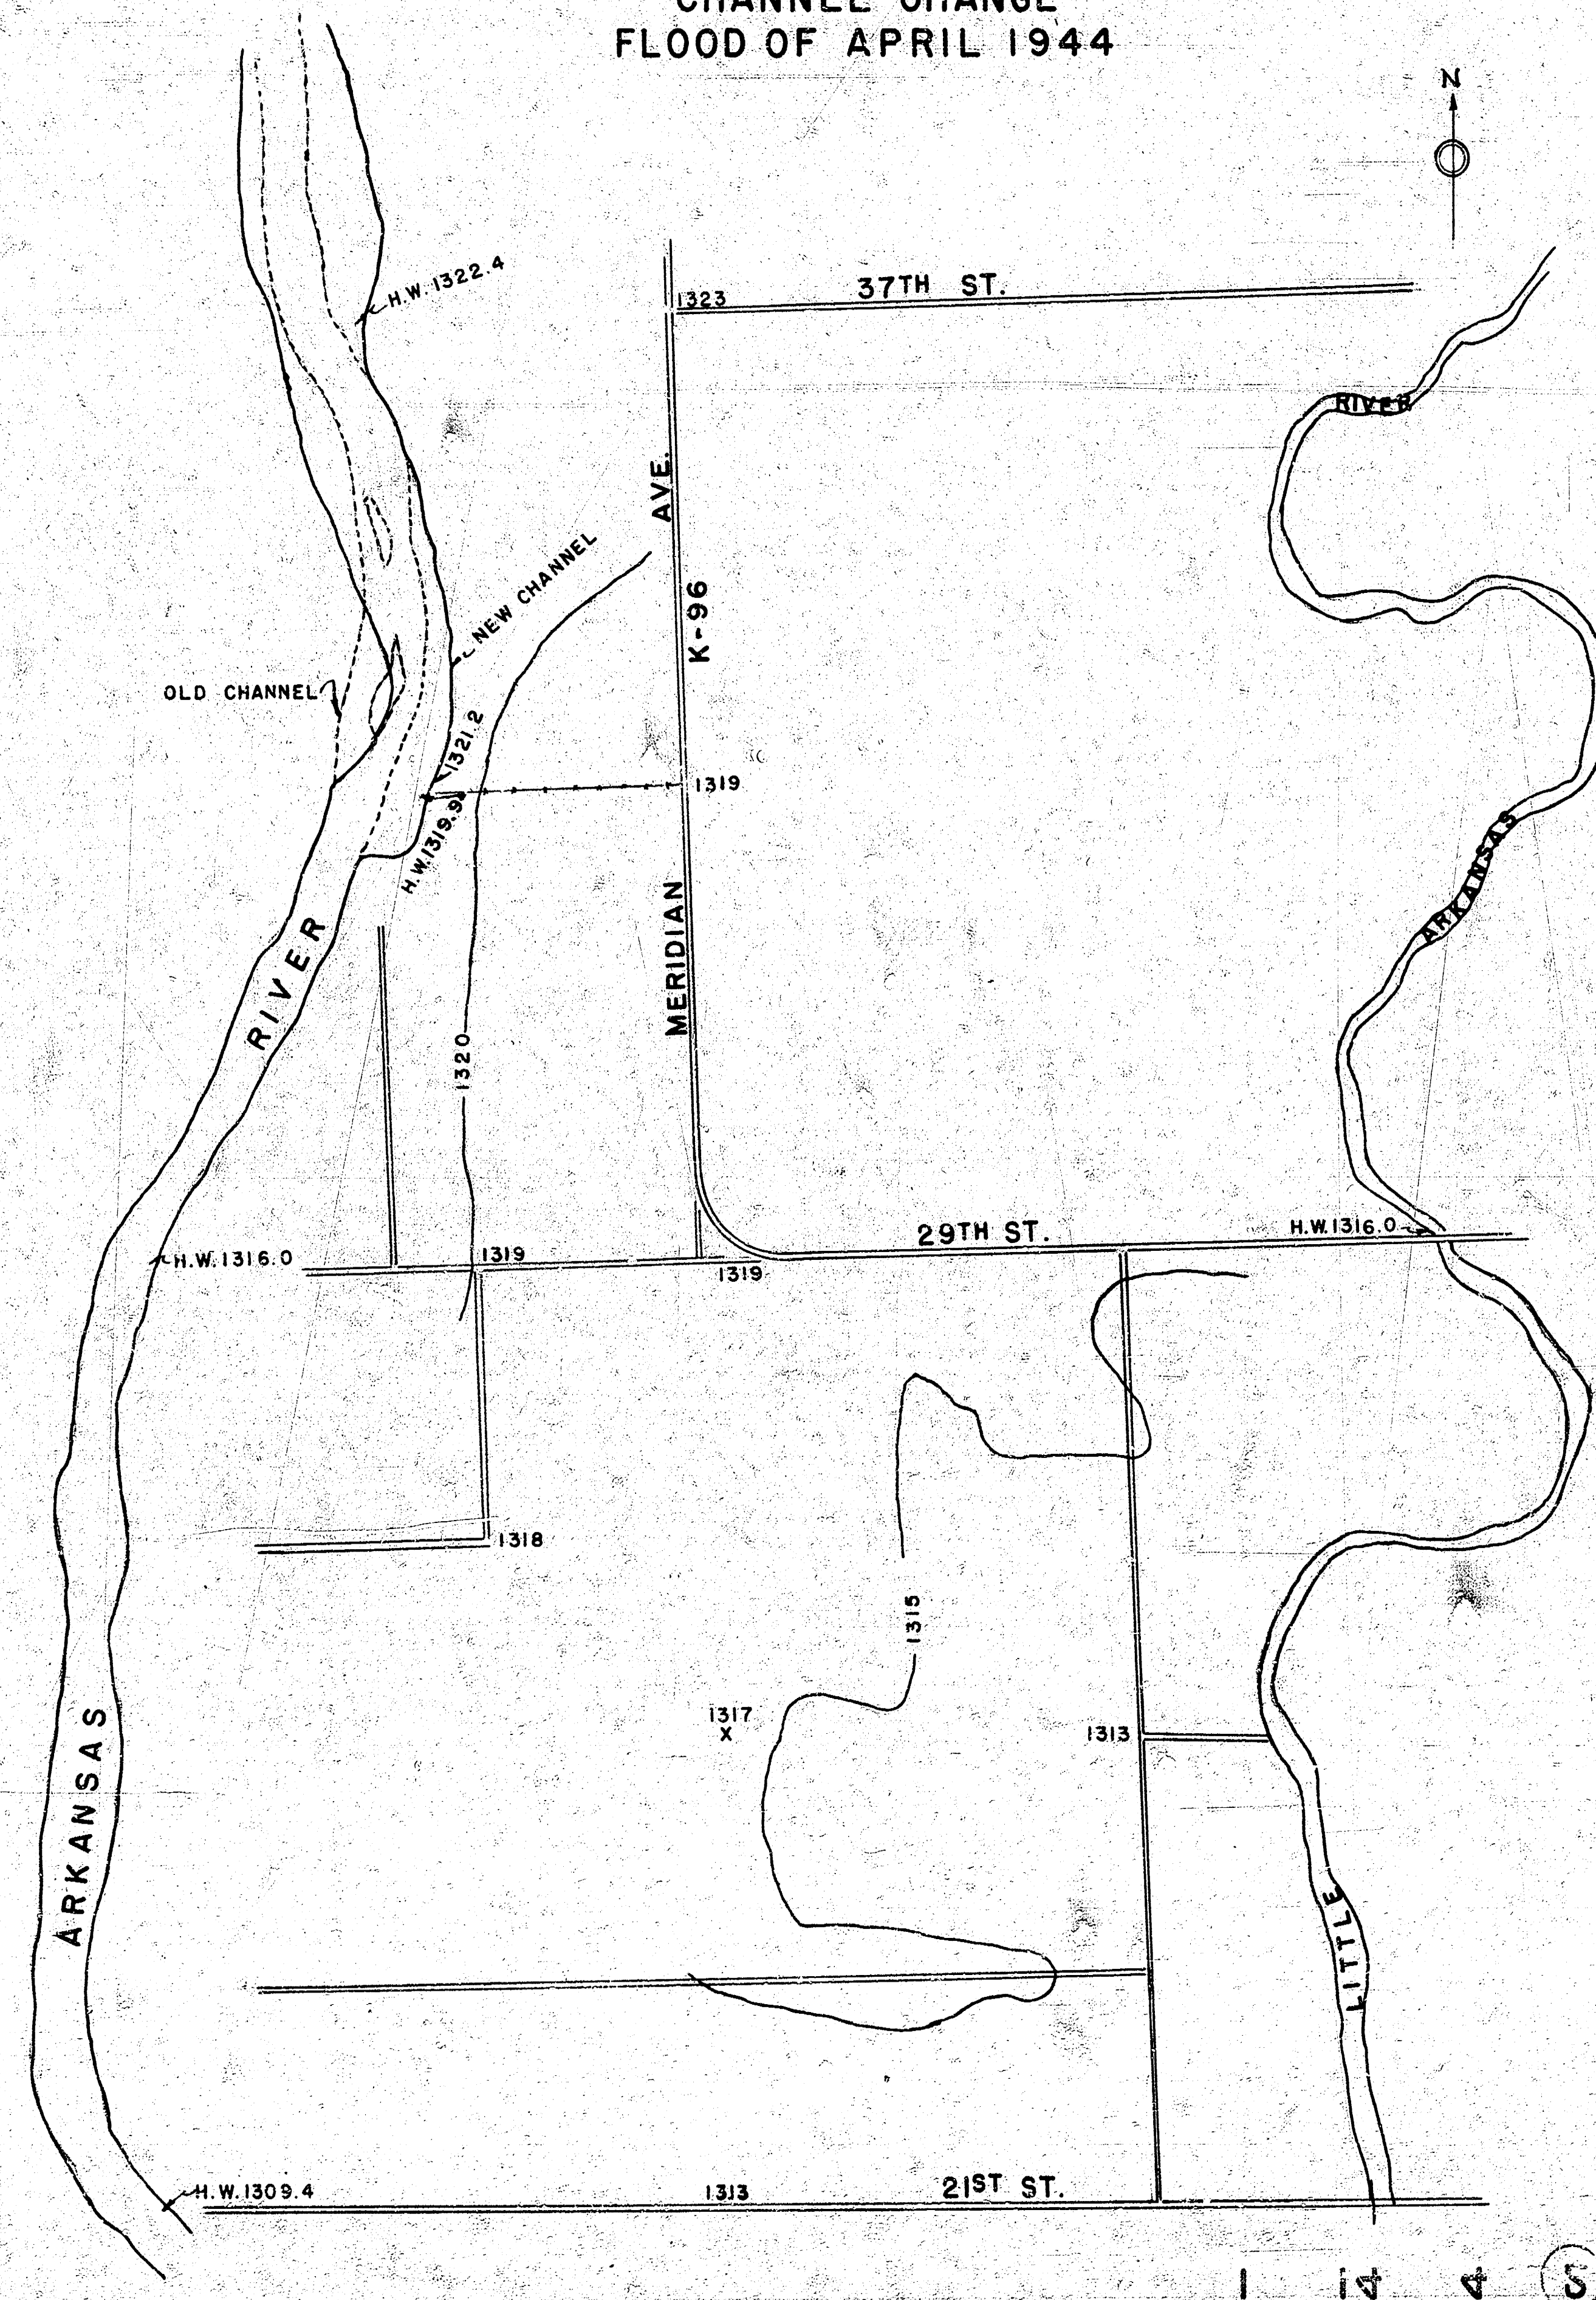

1 14 4 5