


NEIGHBORHOOD DEVELOPMENT PLAN
BICYCLE PATH IMPROVEMENT PROJECT
FOR

URBAN RENEWAL AGENCY
OF THE WICHITA, KANSAS METROPOLITAN AREA

PROJECT NO. KANS. A-5-2

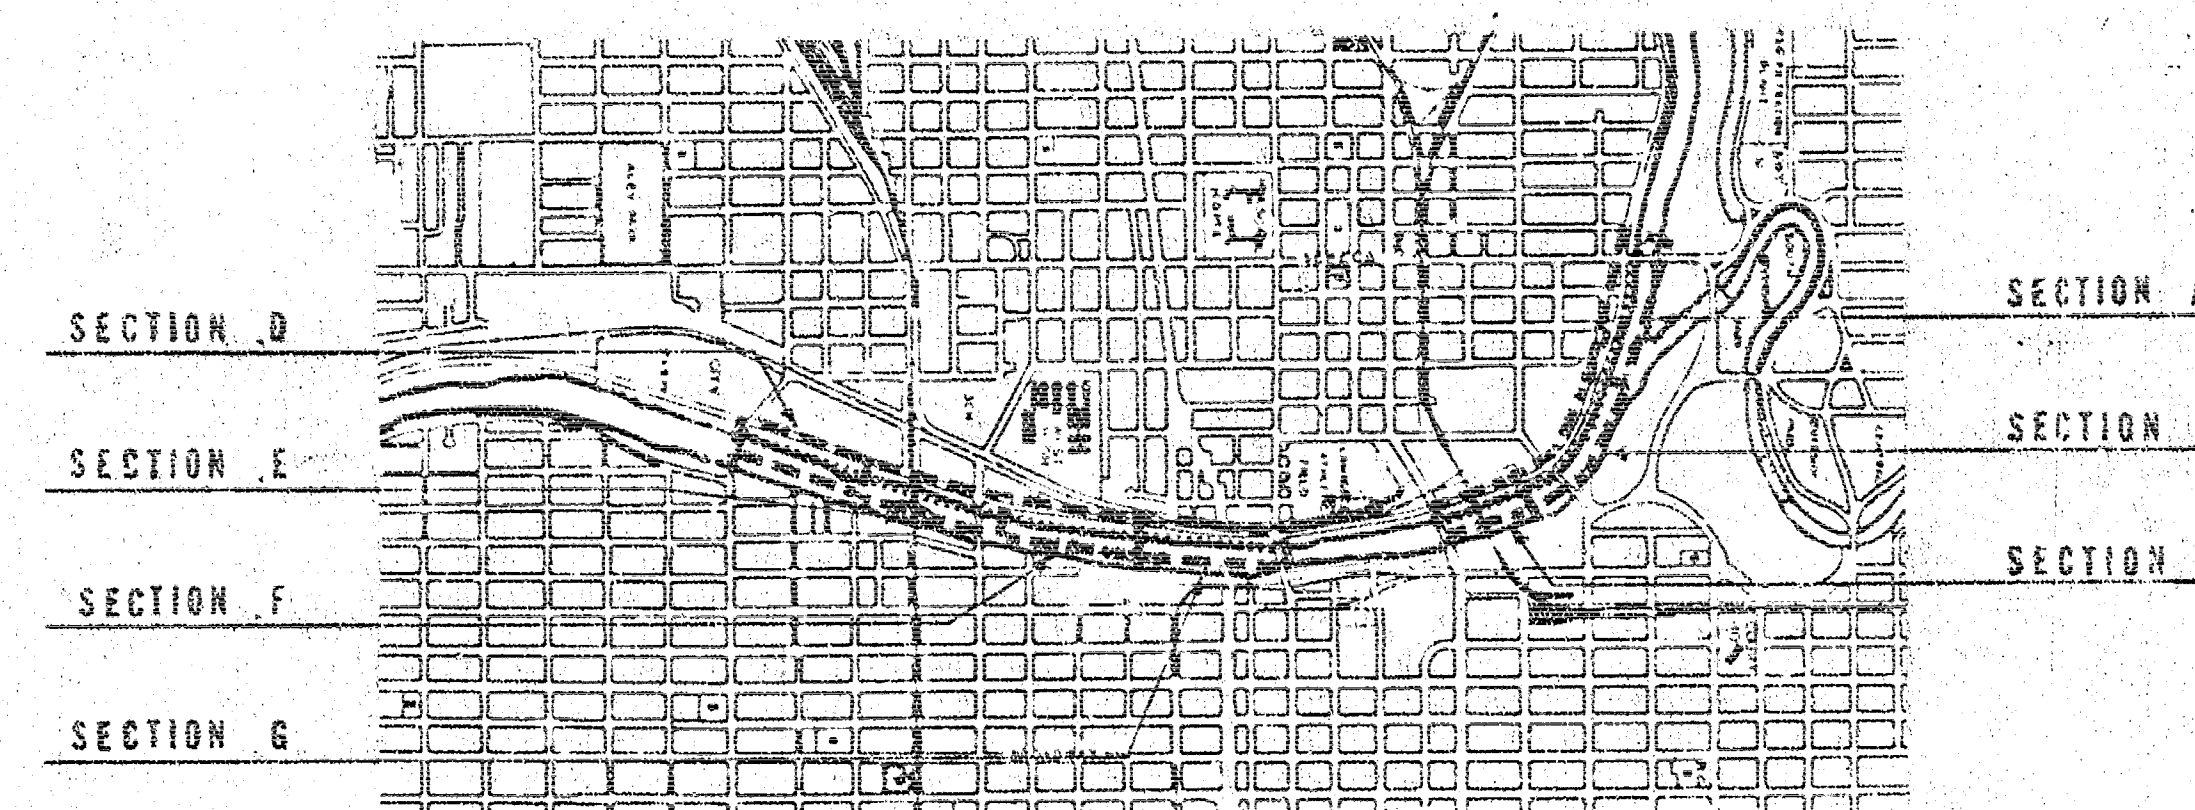

FLOOD CONTROL
OFFICE COPY
BOARD OF COMMISSIONERS

DR. O. H. CURRY
CHAIRMAN

DONALD H. ALLDRITT
COMMISSIONER

WILLIAM D. ANDERSON
COMMISSIONER

JAMES L. GARDNER
COMMISSIONER

ALBERT L. KAMAS
COMMISSIONER

KENNETH H. KITCHEN
EXECUTIVE DIRECTOR

Revised Plans.
(This plan sent to Cof's for Approval.)
2-10-71


JOHN GATES
Architect
805 East National Blvd.
Wichita, Kansas 67203


oblinger-smith
Planning Consultants /
Landscape Architects
1000 East Main Building
Wichita, Kansas

REVISIONS
SHEET TITLE
TITLE SHEET
DATE

PROJECT
BICYCLE PATH
URBAN RENEWAL
KANS A-5-2
SHEET
NUMBER 1 OF 8
SCALE

APPROVED
DATE

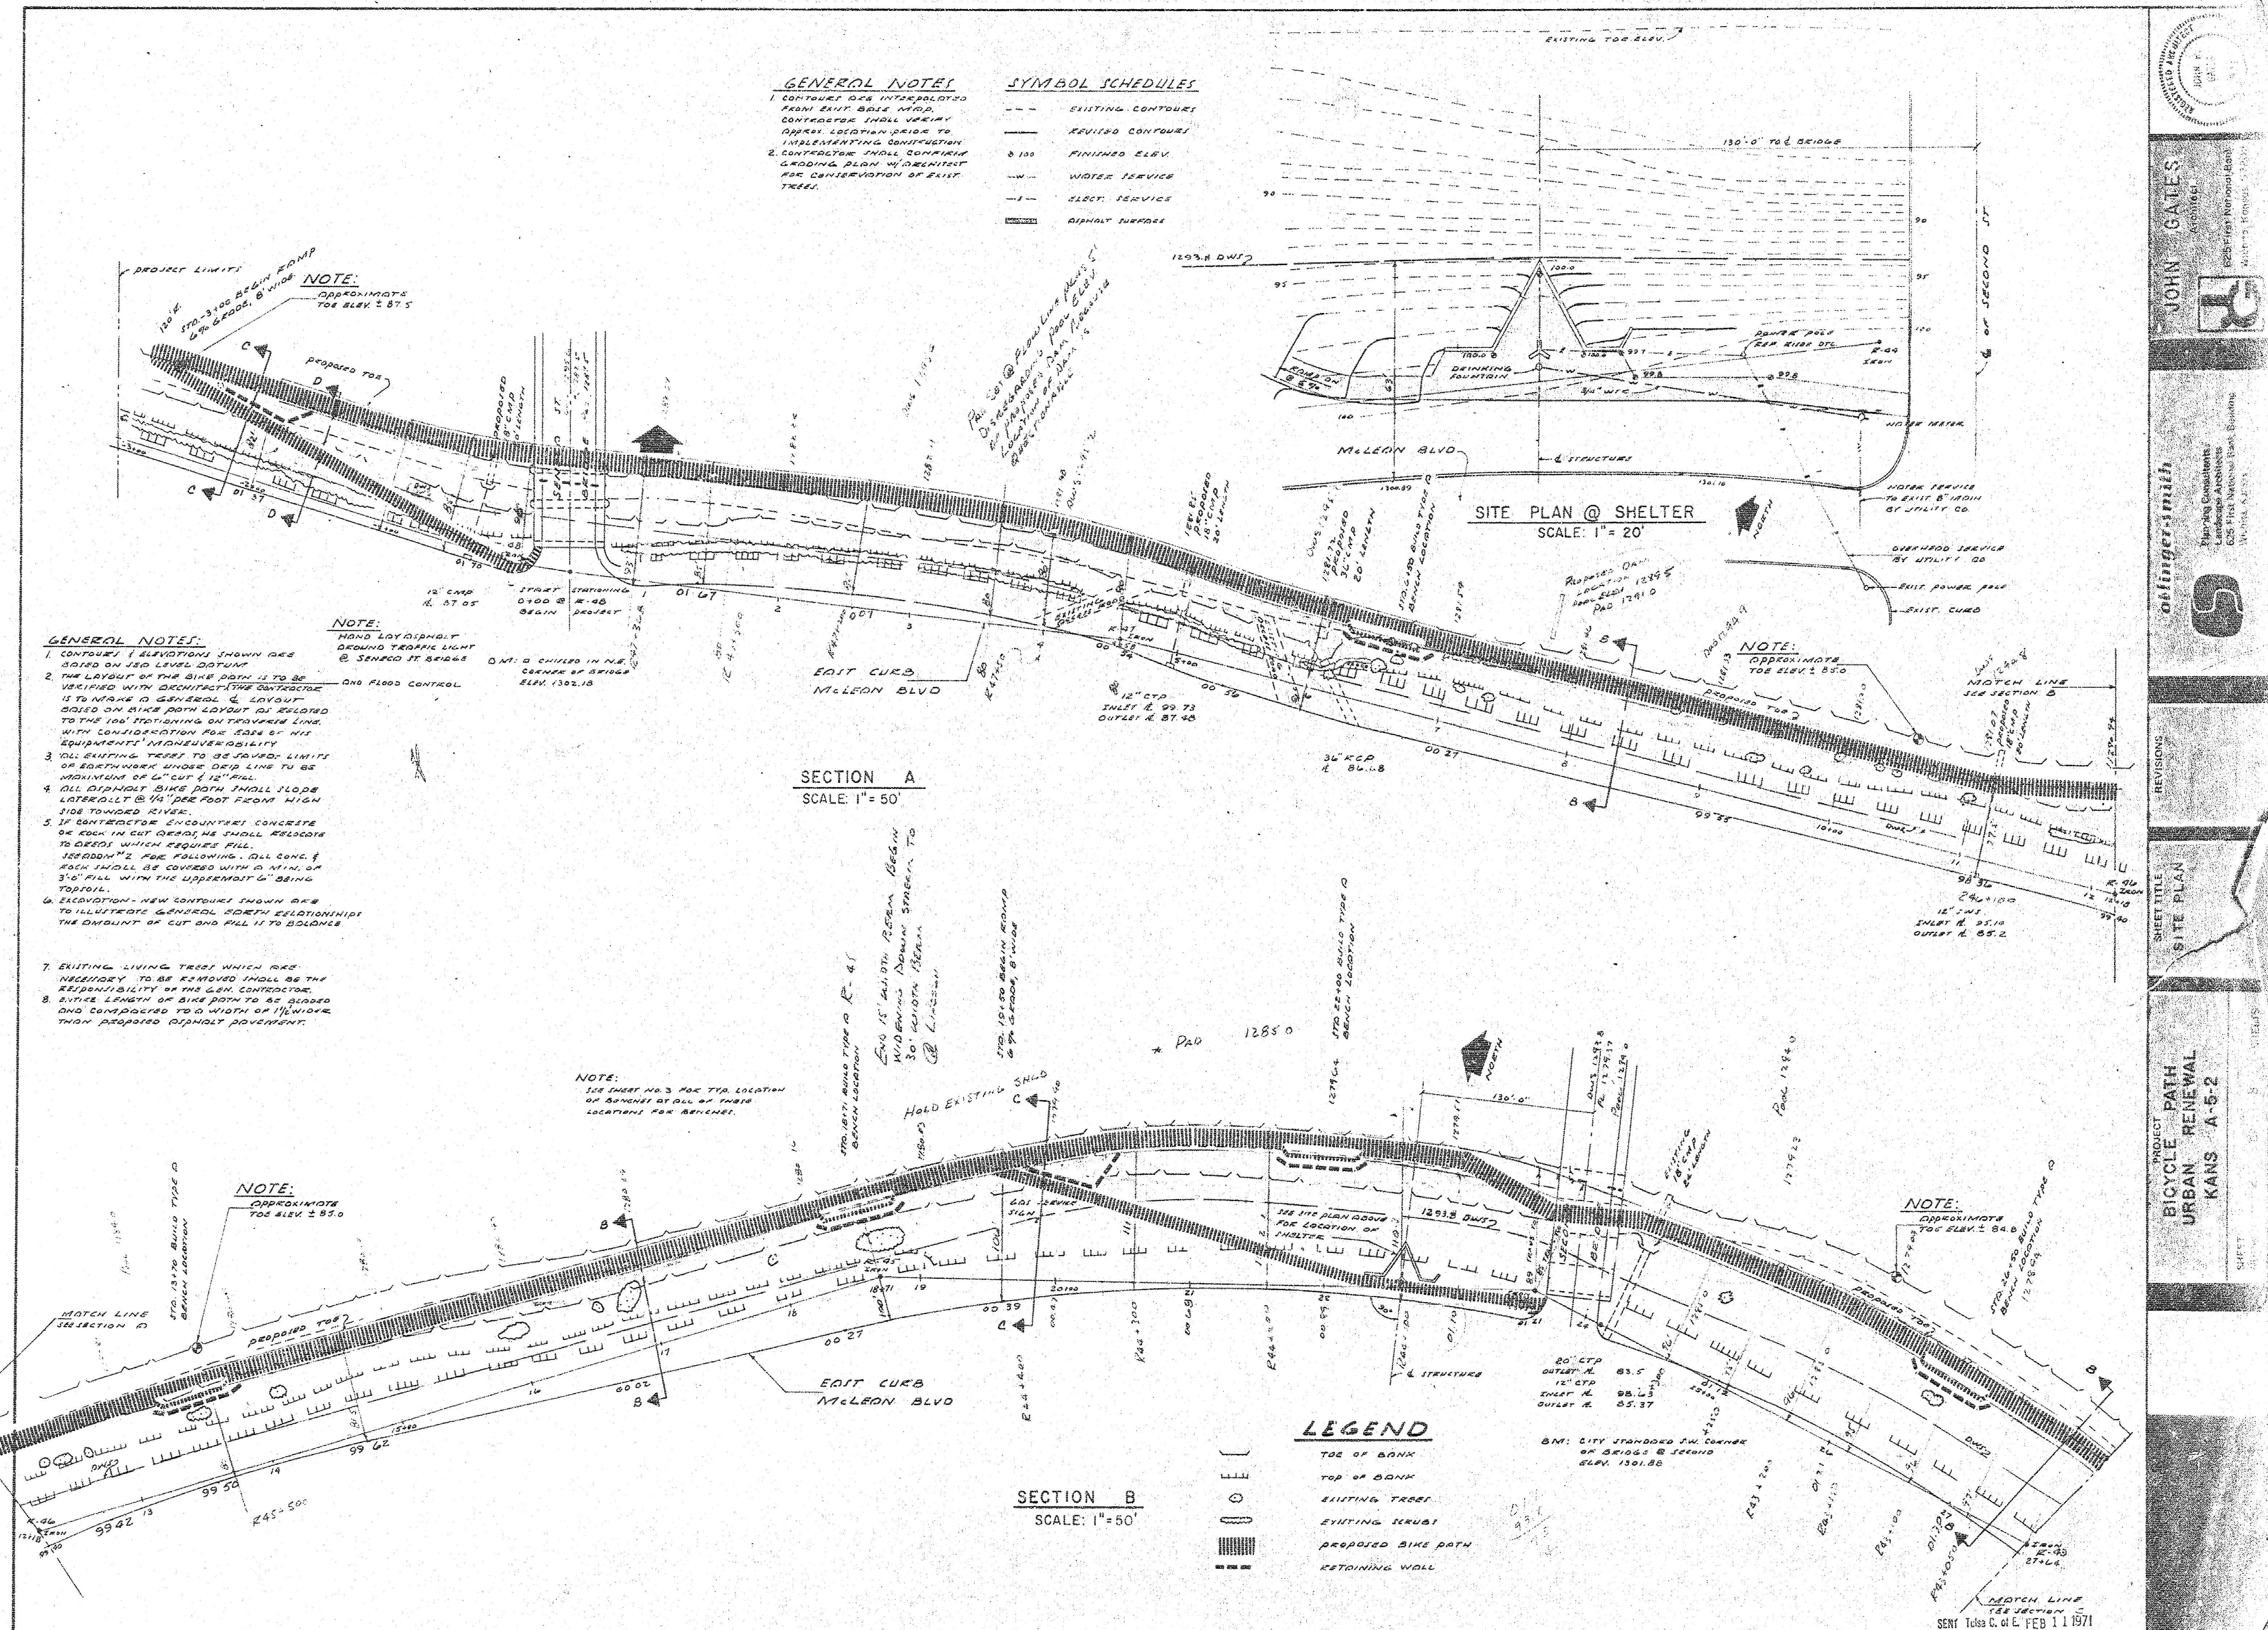

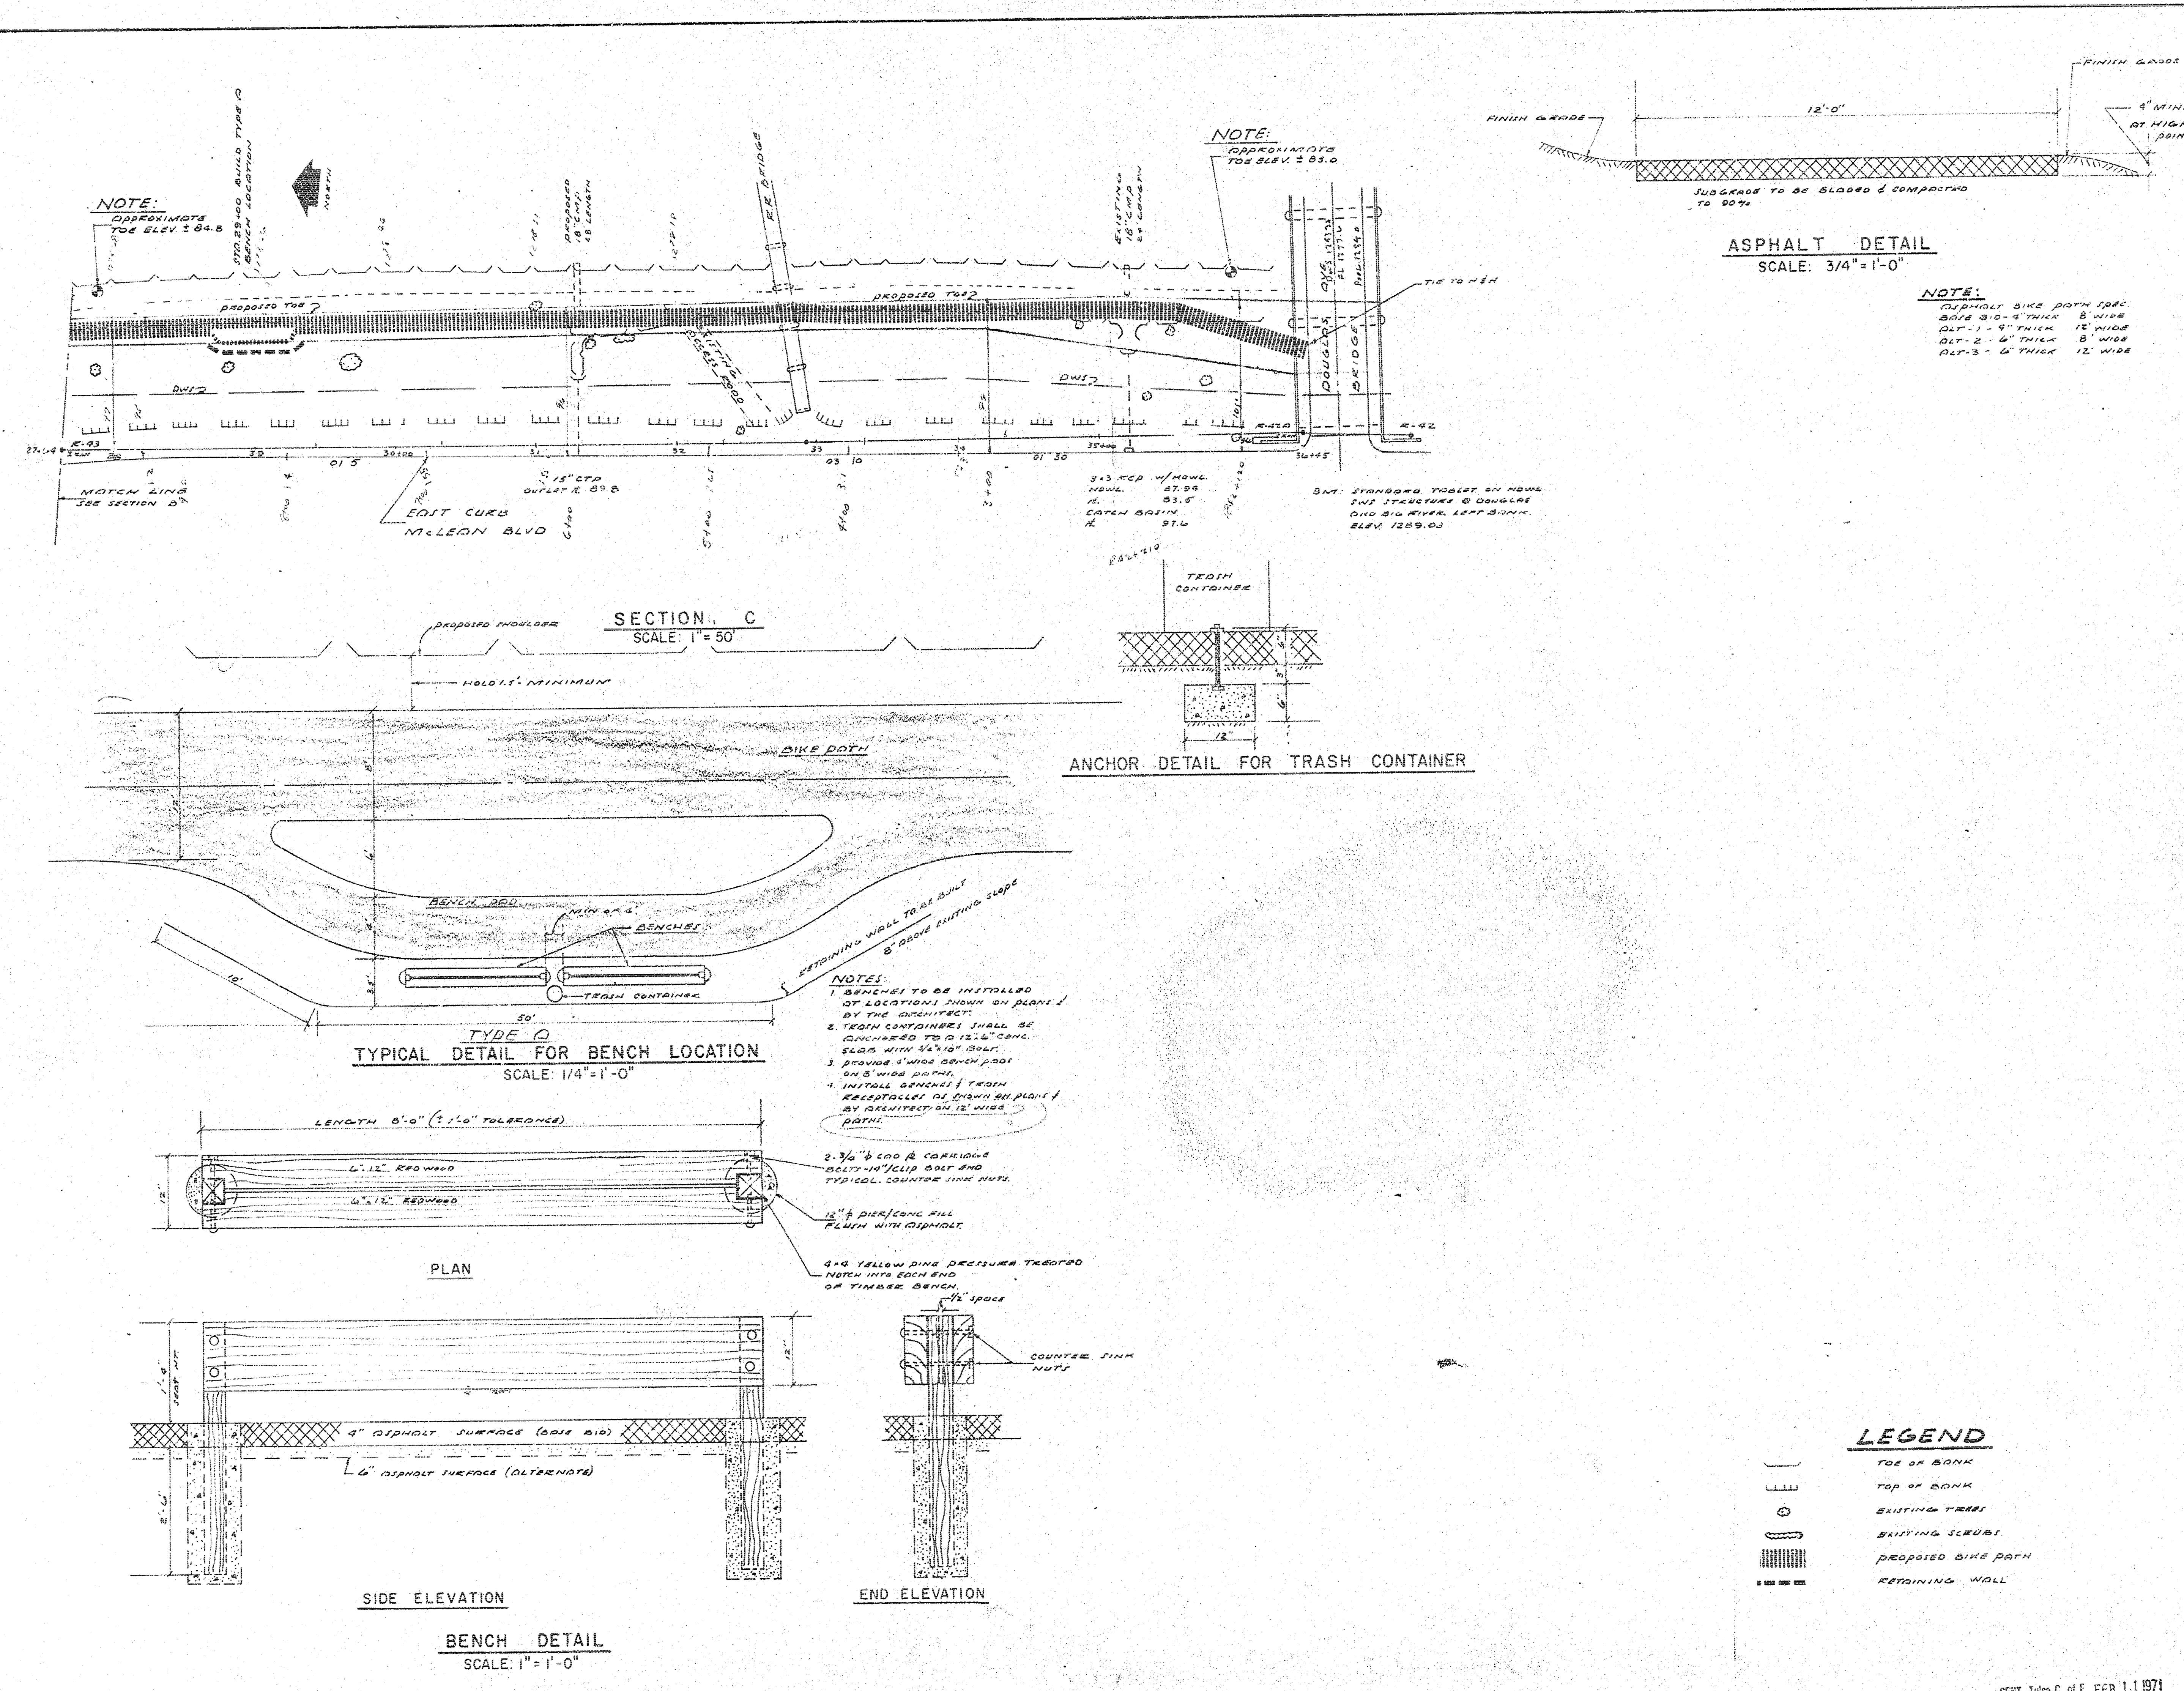

JOHN GATES
Architect

oblinger-smith
Planning Consultants /
Landscape Architects
225 F. J. Hall Bank Building
Wichita, Kansas 67202


REVISIONS

SHEET TITLE
BICYCLE PATH
SITE PLAN
AND DETAILS
KANSAS A-5-2


DATE
1-5-71

SHEETS
3 OF 3

SENT Table C. of E. FEB 11 1971

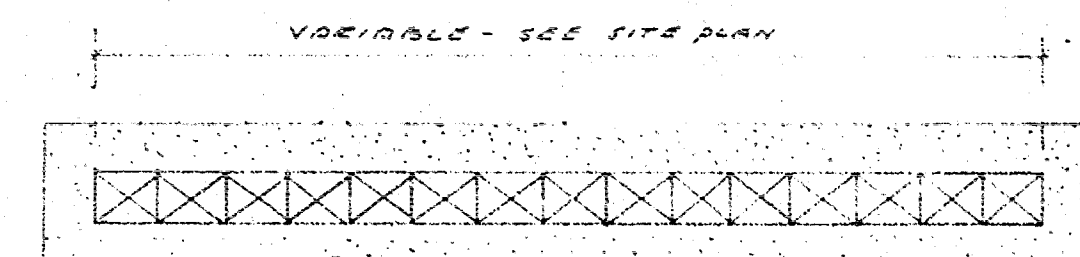


PLAN

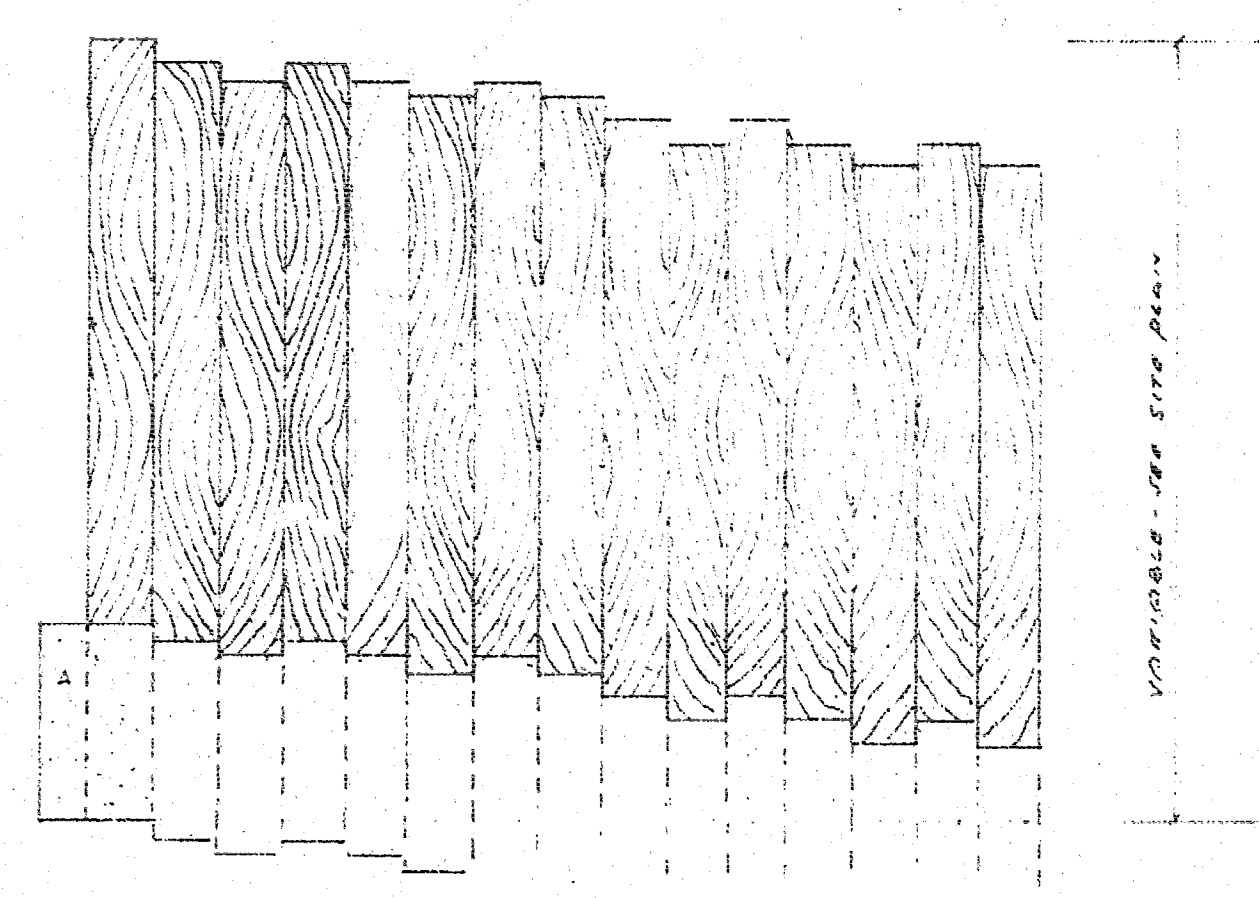



SIDE ELEVATION

RETAINING WALL DETAIL @ BIKE PATH
SCALE: 1/2" = 1'-0"

- GENERAL NOTES**
1. CONTOURS ARE INTERPOLATED FROM EXISTING DATA.
 2. CONTRACTOR SHALL VERIFY SPARK LOCATION PRIOR TO IMPLEMENTING CONSTRUCTION.
 3. CONTRACTOR SHALL CONFIRM EXISTING PLUM W/DEVELOPER FOR CONSERVATION OF EXISTING TREES.
- SYMBOL SCHEDULE**
- EXISTING CONTOUR
 - EXISTING CONTOUR
 - FINISHED ELEV.
 - WATER SERVICE
 - SLOPE INDICATOR
 - ASPHALT SURFACE

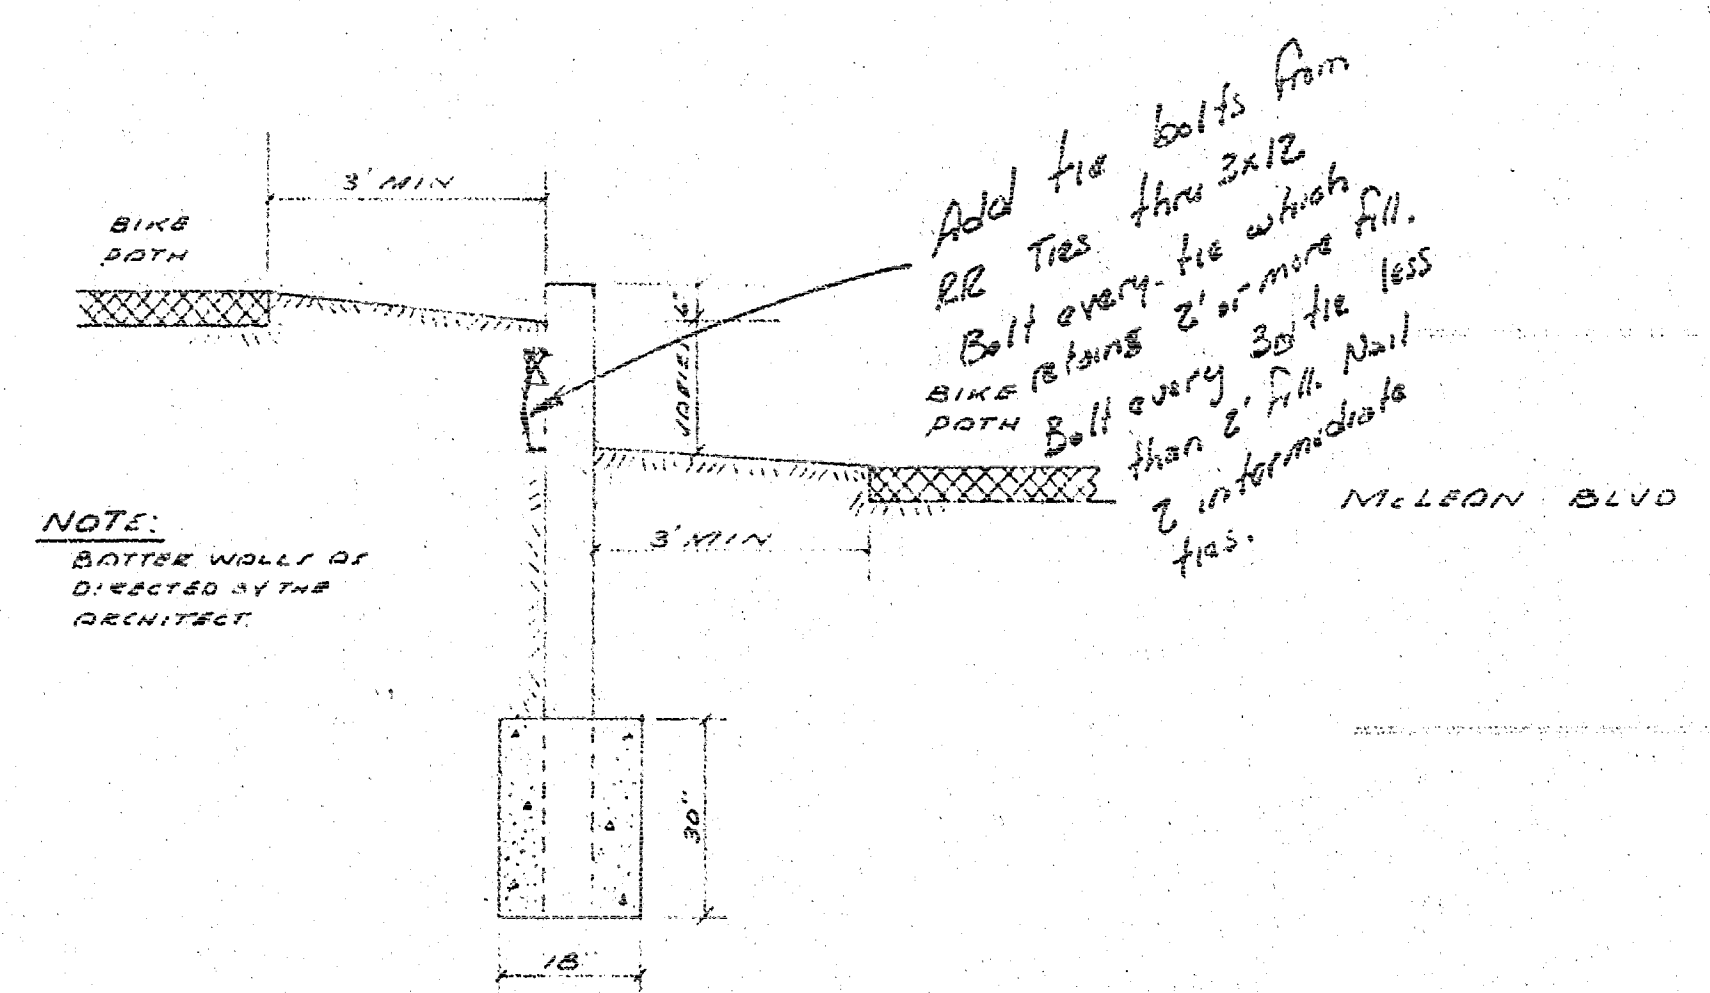

TYP. SECTION RETAINING WALL DETAIL
SCALE: 1/2" = 1'-0"

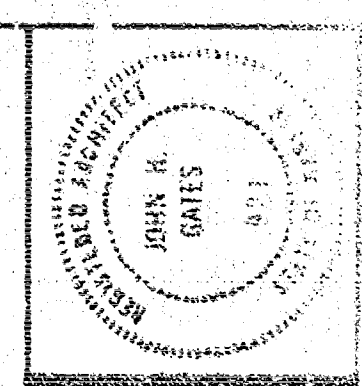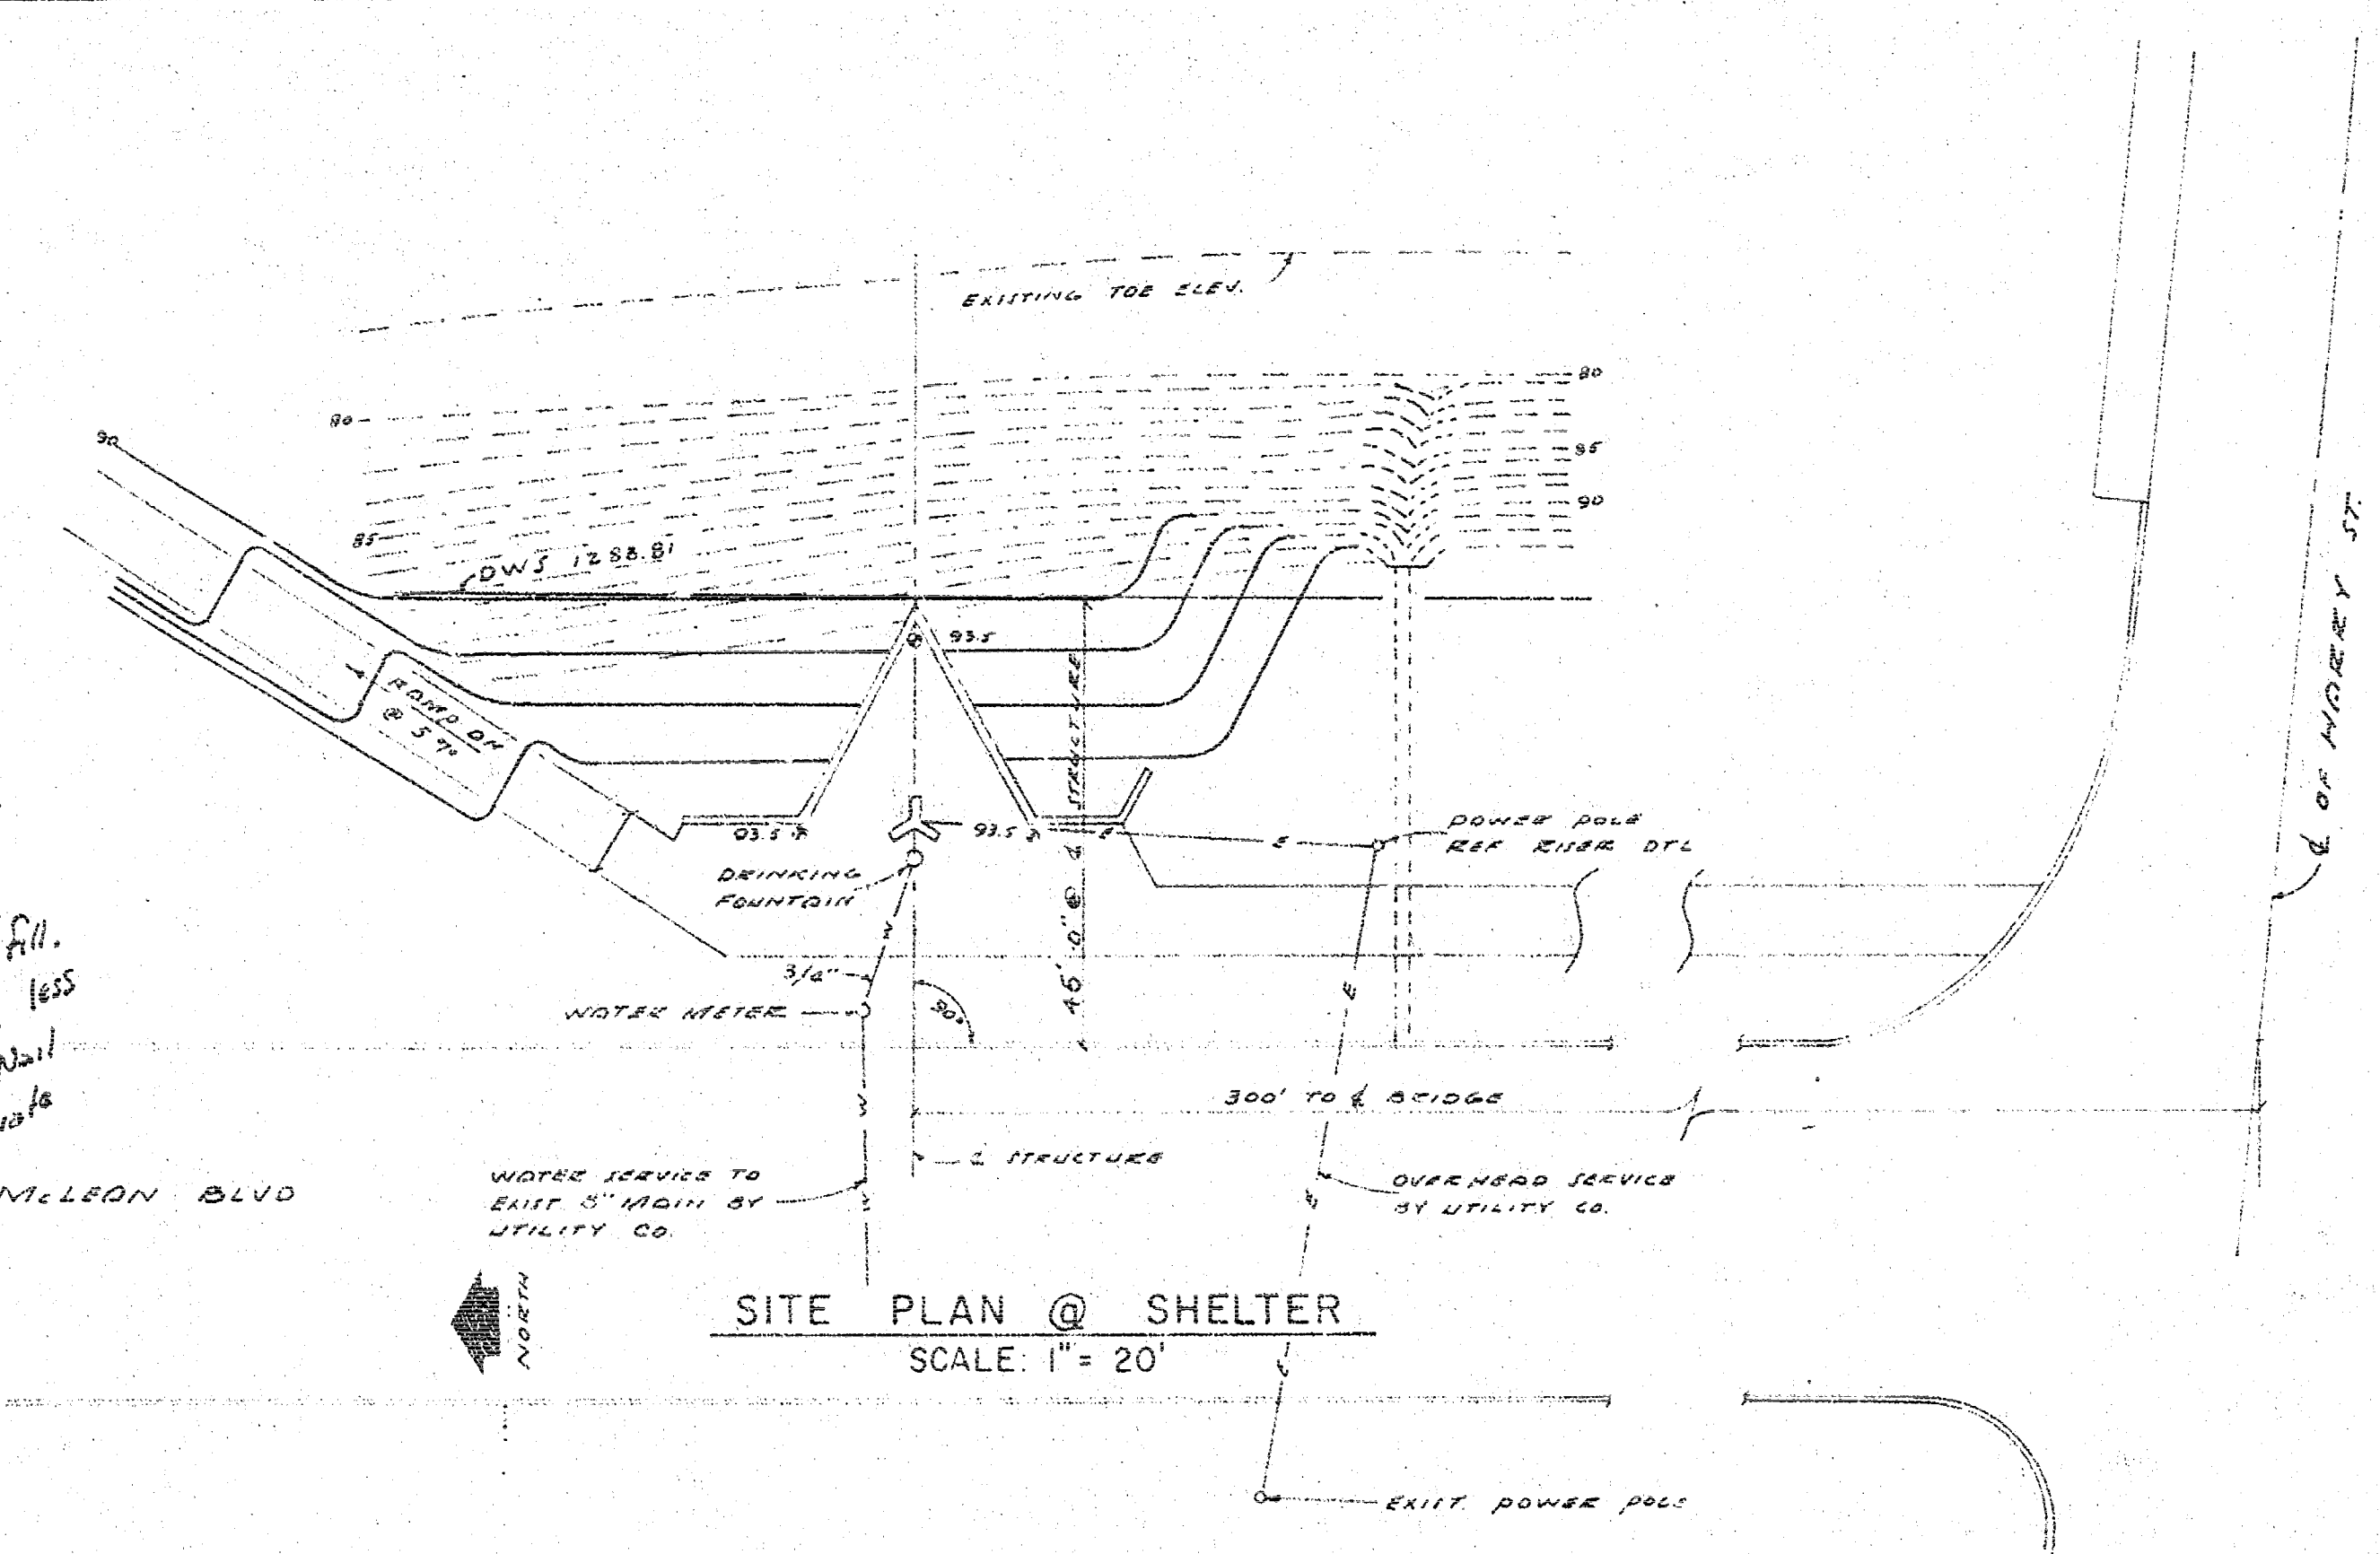

JOHN R. GATES
Engineer
825 First National Bank
Wichita, Kansas 67202

odlinger-smith
Planning Consultants
625 First National Bank Building
Wichita, Kansas

REVISIONS

SHEET TITLE
SITE PLAN
AND DETAILS
DATE
1-5-71

PROJECT
BICYCLE PATH
URBAN RENEWAL
KANSAS
A-5-2
SHEET NUMBER 6 OF 8 SHEETS