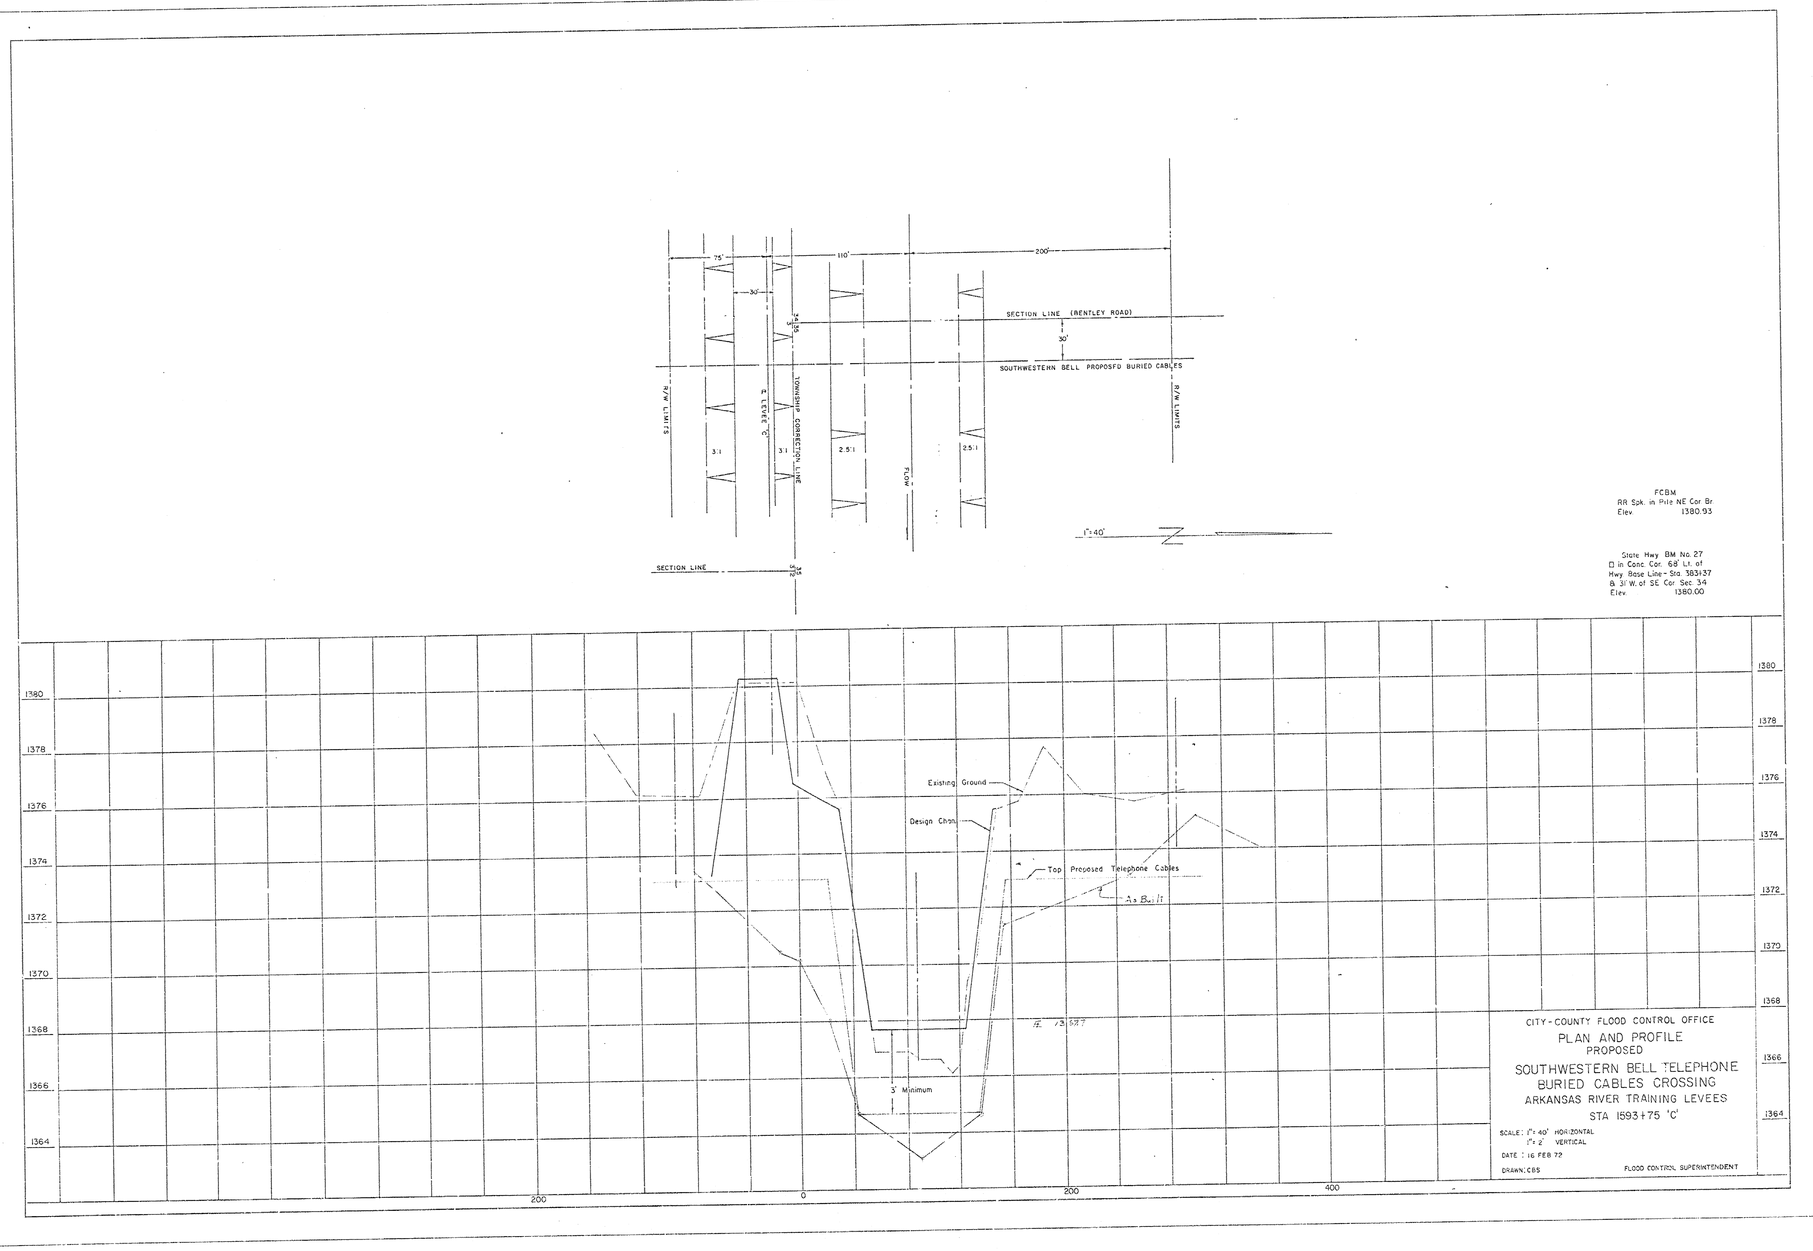
75'
110'
200'
30'
SECTION LINE (BENTLEY ROAD)
30'
SOUTHWESTERN BELL PROPOSED BURIED CABLES
R/W LIMITS
℄ LEVEE "C"
TOWNSHIP CORRECTION LINE
3:1
3:1
2.5:1
FLOW
2.5:1
R/W LIMITS
1"=40'
SECTION LINE
FCBM
RR Spk. in Pile NE Cor Br.
Elev. 1380.93
State Hwy BM No. 27
□ in Conc. Cor. 68' Lt. of
Hwy Base Line - Sta. 383+37
& 31' W. of SE Cor. Sec. 34
Elev. 1380.00
1380
1378
1376
1374
1372
1370
1368
1366
1364
Existing Ground
Design Chan.
Top Proposed Telephone Cables
As Built
℄ 13.57.7
3' Minimum
200
0
200
400
CITY-COUNTY FLOOD CONTROL OFFICE
PLAN AND PROFILE
PROPOSED
SOUTHWESTERN BELL TELEPHONE
BURIED CABLES CROSSING
ARKANSAS RIVER TRAINING LEVEES
STA 1593+75 'C'
SCALE: 1" = 40' HORIZONTAL
1" = 2' VERTICAL
DATE : 16 FEB 72
DRAWN: CBS
FLOOD CONTROL SUPERINTENDENT