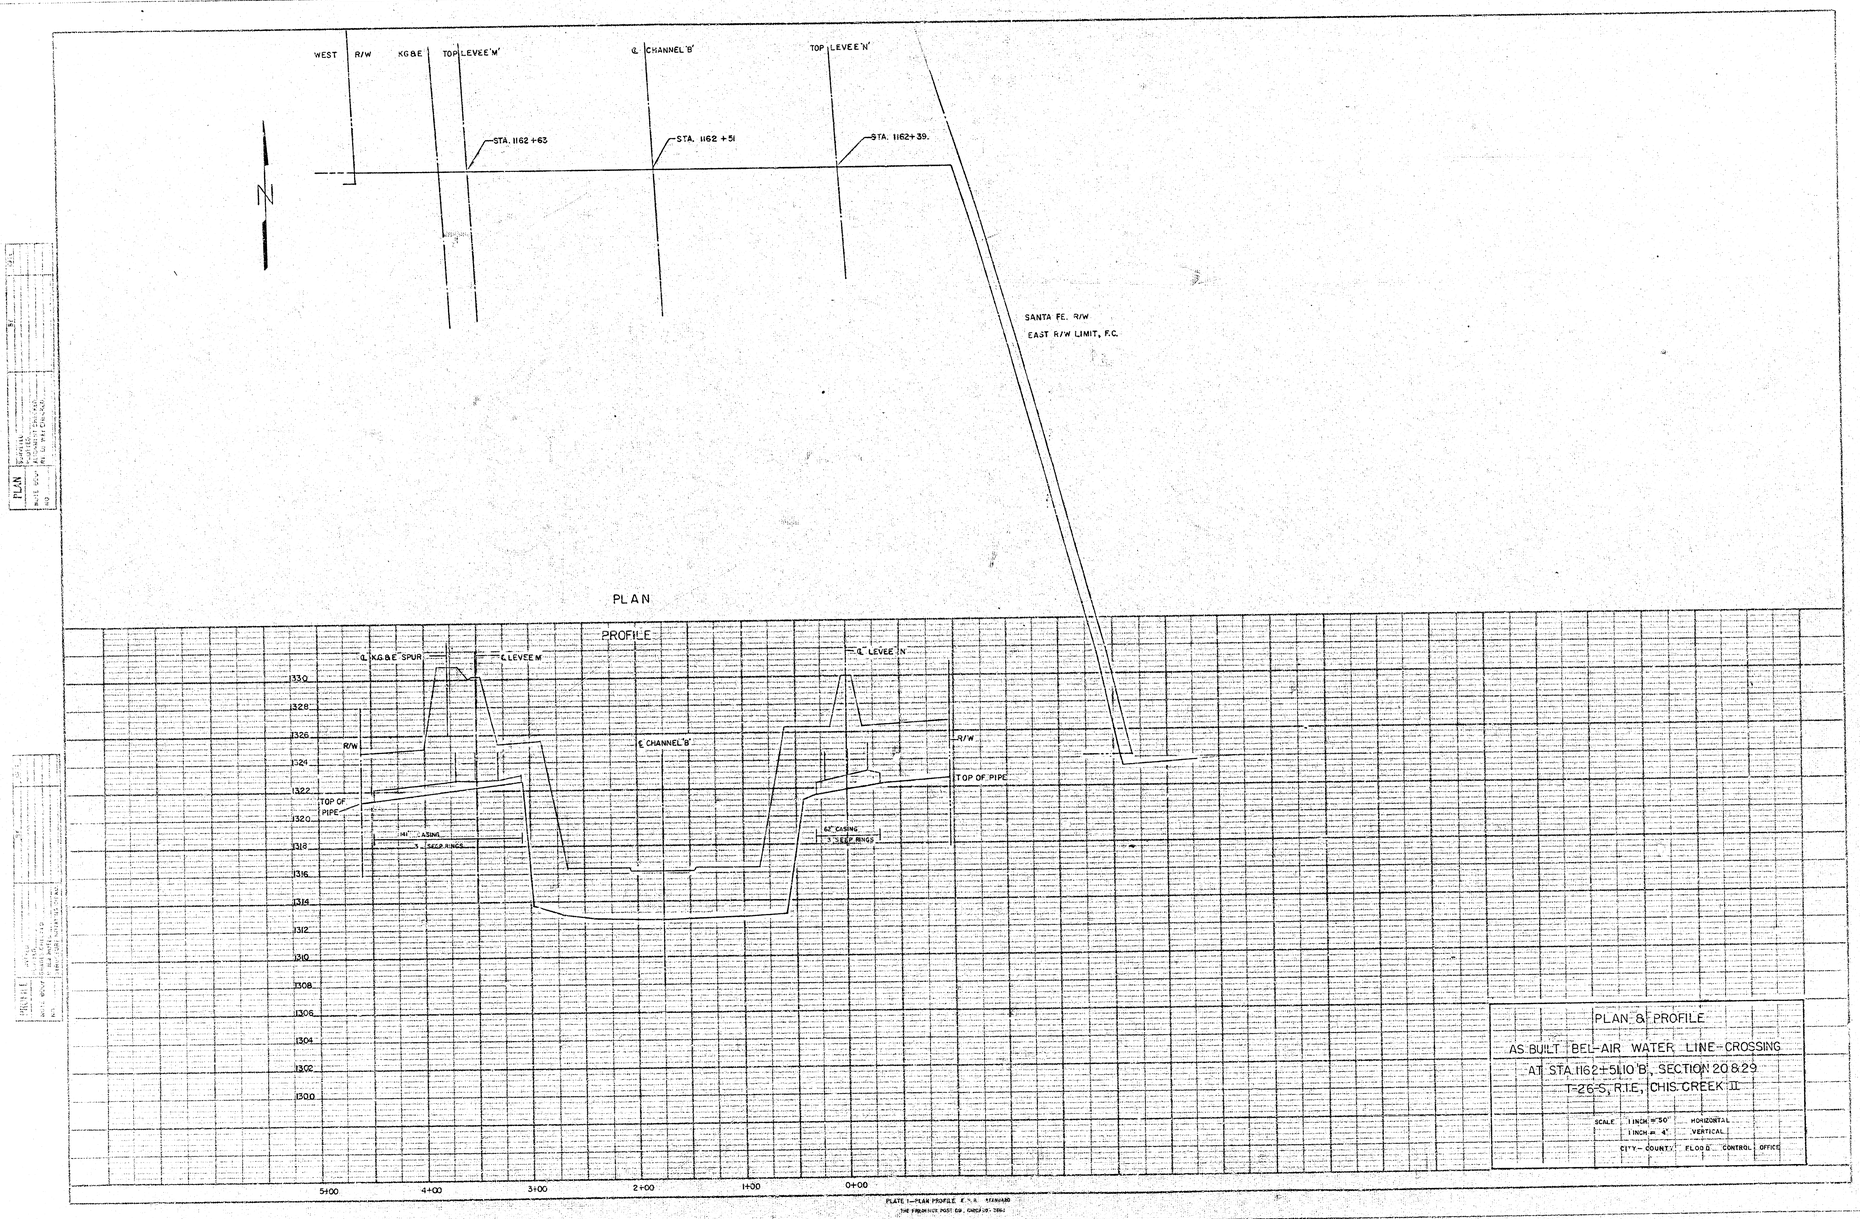

PLAN & PROFILE

AS BUILT BEL-AIR WATER LINE-CROSSING

AT STA 1162+51.10 'B', SECTION 20 & 29

T-26-S, R.1.E., CHIS CREEK II

SCALE 1 INCH = 50' HORIZONTAL

1 INCH = 4' VERTICAL

CITY - COUNTY FLOOD CONTROL OFFICE

PLATE 1—PLAN PROFILE K.C.F.C. STANDARD

THE FRED NICE POST CO., CHICAGO, 1964

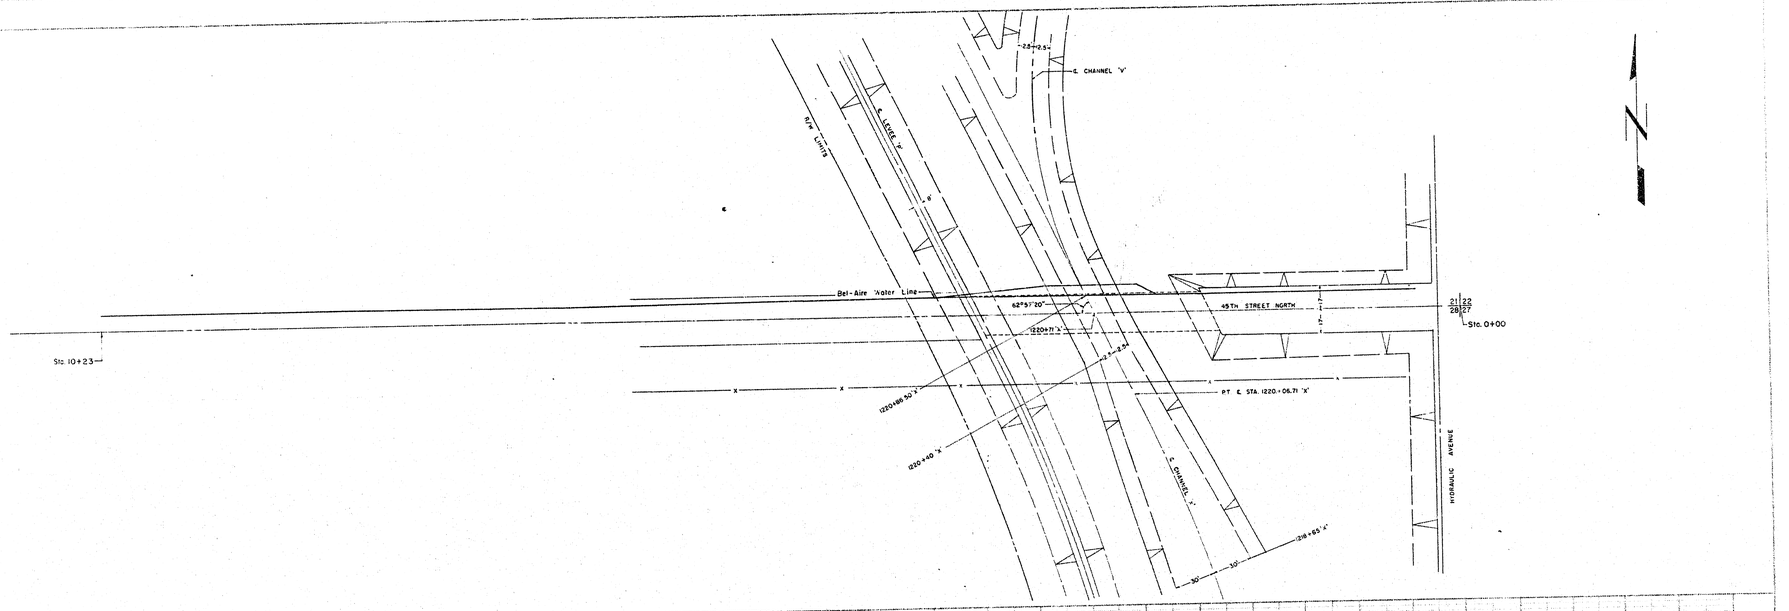

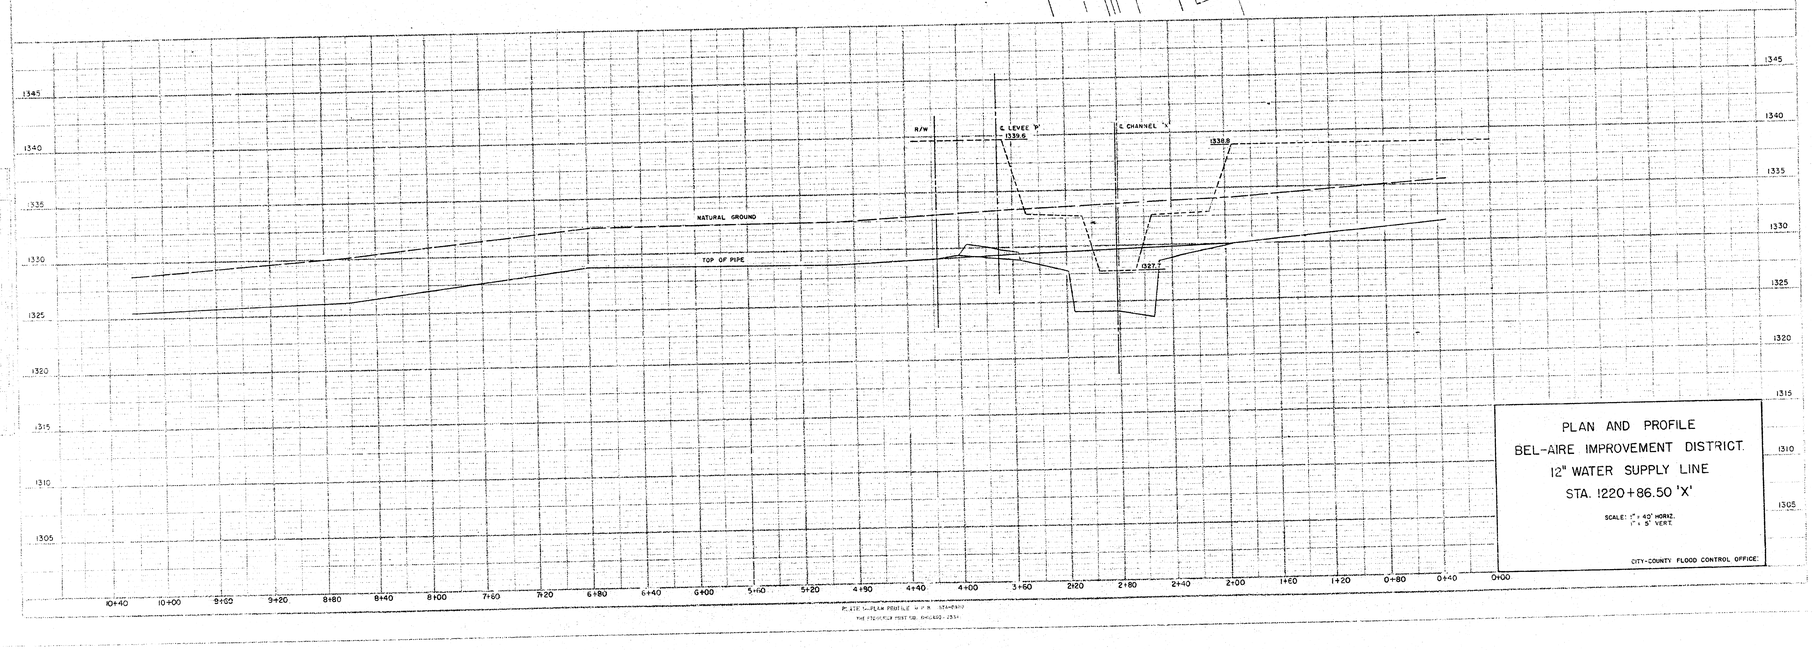

PLAN AND PROFILE
BEL-AIRE IMPROVEMENT DISTRICT
12" WATER SUPPLY LINE
STA. 1220+86.50 'X'

SCALE: 1" = 40' HORIZ.
1" = 5' VERT.

CITY-COUNTY FLOOD CONTROL OFFICE

PLATE 1-PLAN PROFILE W.P.R. STANDARD
