


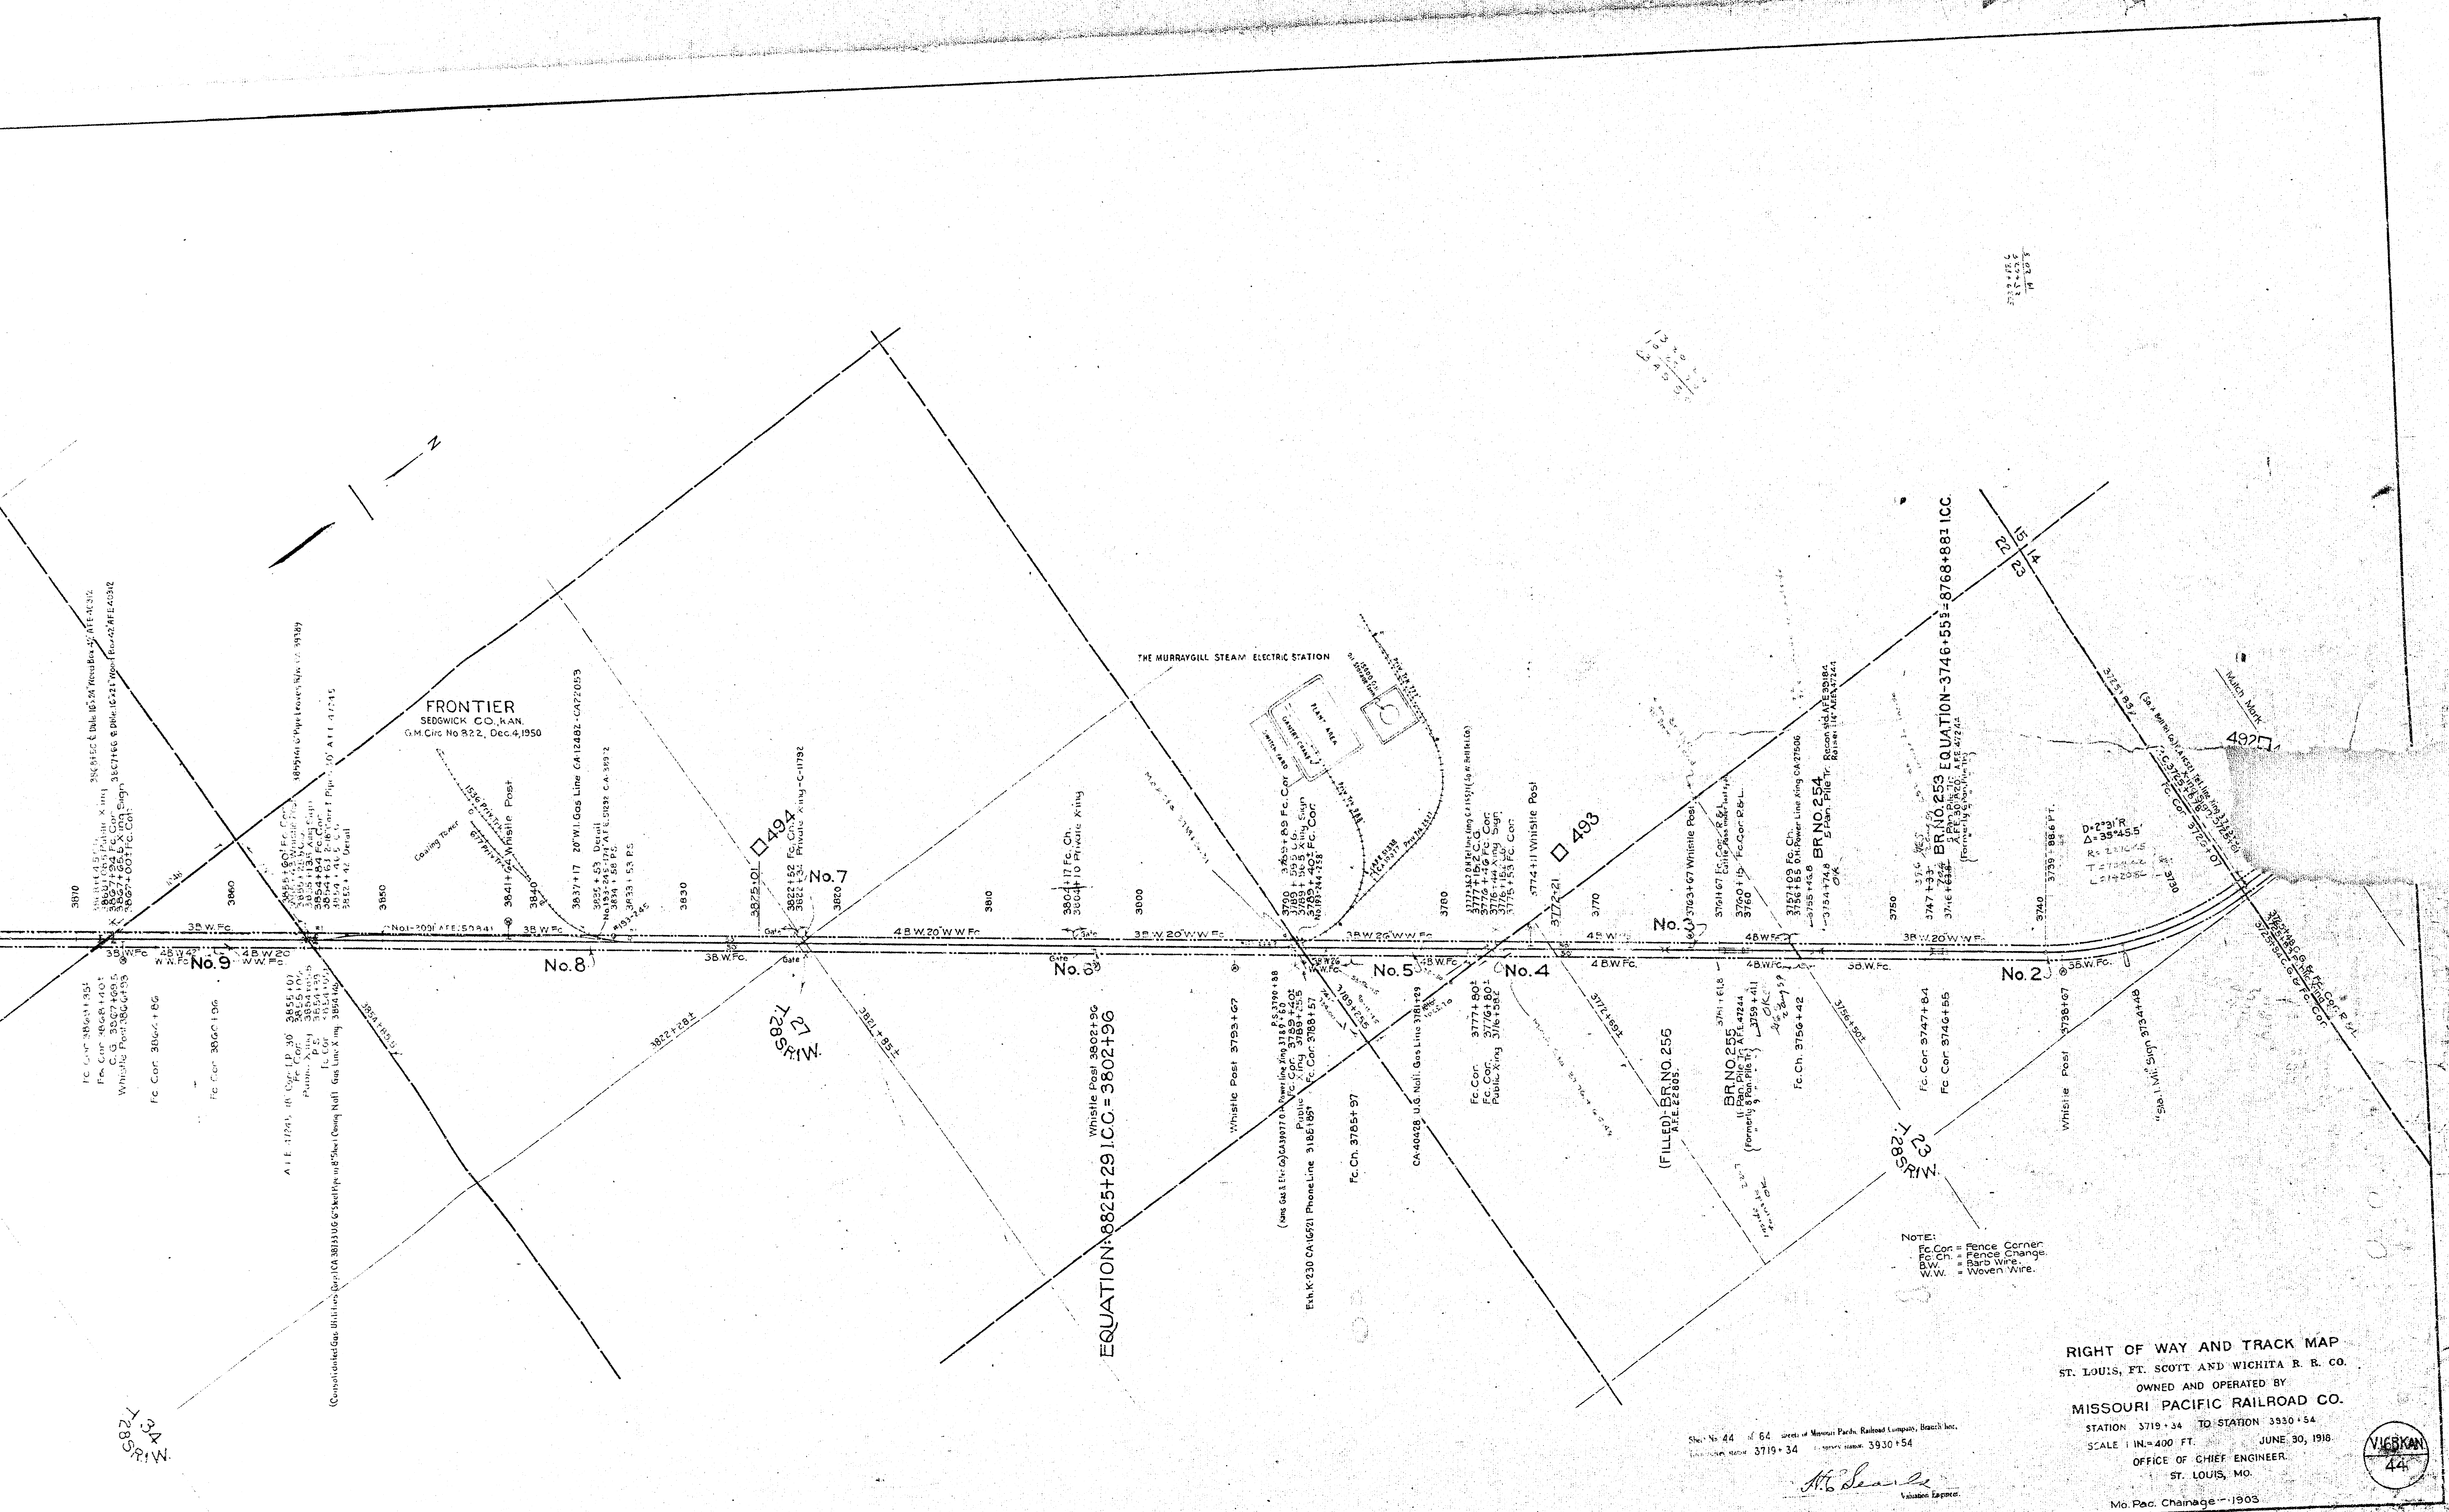



RIGHT OF WAY AND TRACK MAP
 ST. LOUIS, FT. SCOTT AND WICHITA R. R. CO.
 OWNED AND OPERATED BY
 MISSOURI PACIFIC RAILROAD CO.
 STATION 3719+34 TO STATION 3930+54
 SCALE 1 IN. = 400 FT. JUNE 30, 1918
 OFFICE OF CHIEF ENGINEER
 ST. LOUIS, MO.
 Mo. Pac. Chainage - 1903

Sheet No. 44 of 64 covers of Missouri Pacific Railroad Company, Beach, Mo.
 Date of map 3719+34 to station 3930+54

At. L. L. L.
 Valuation Engineer


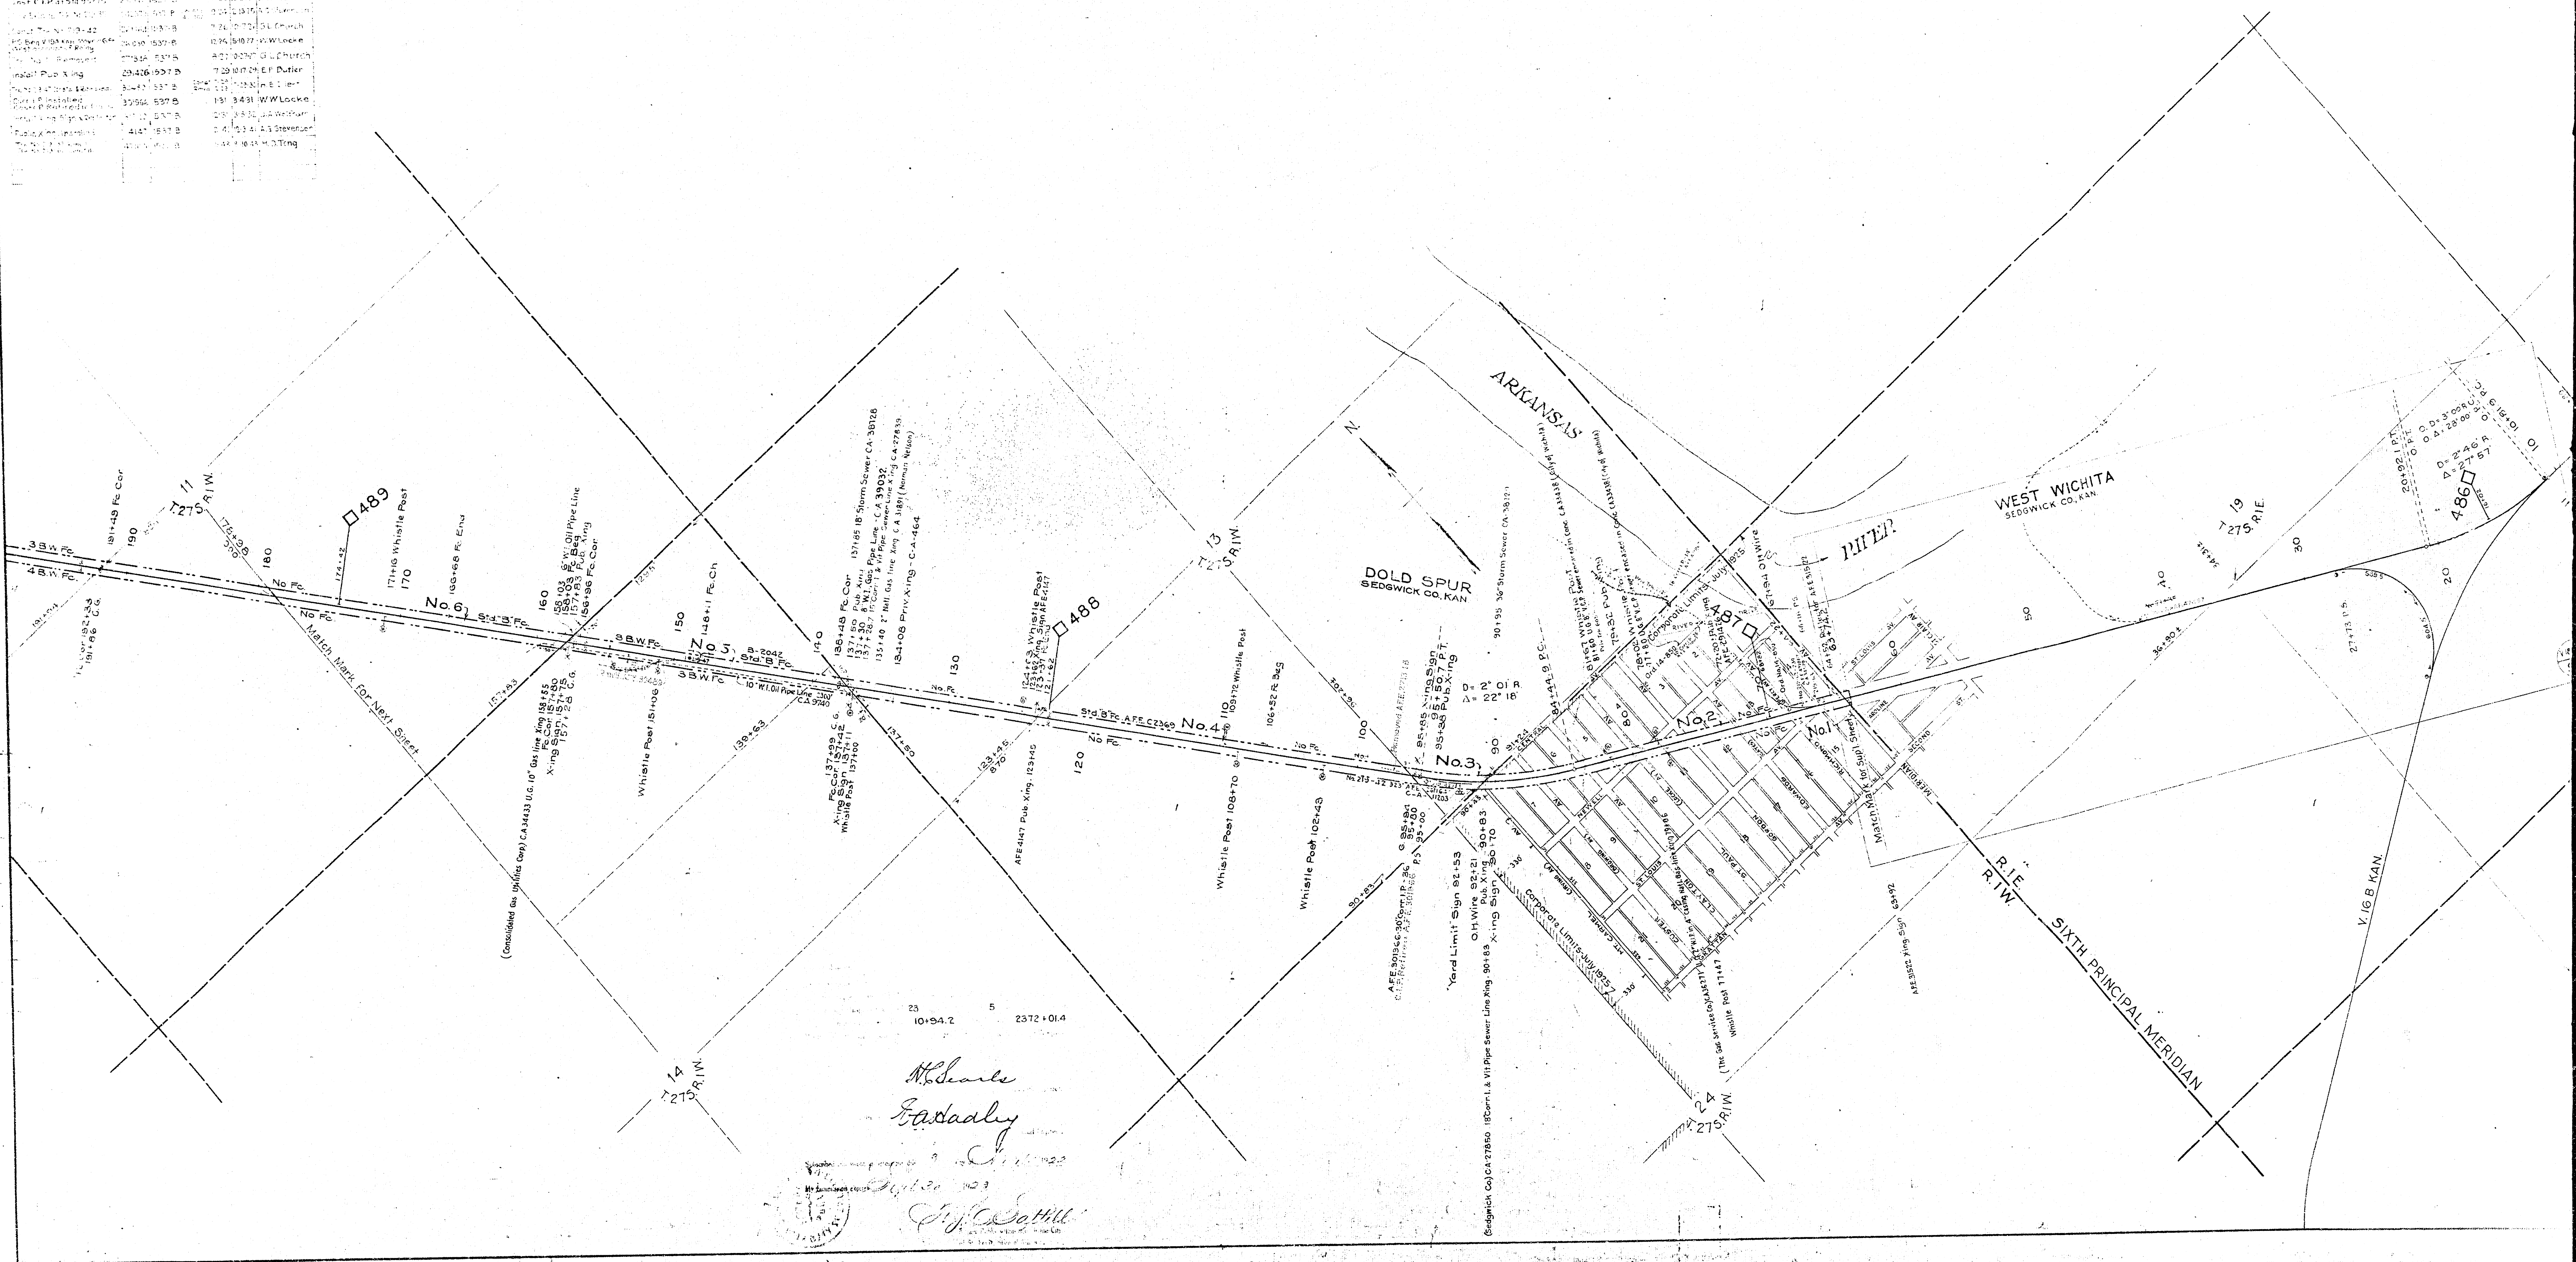

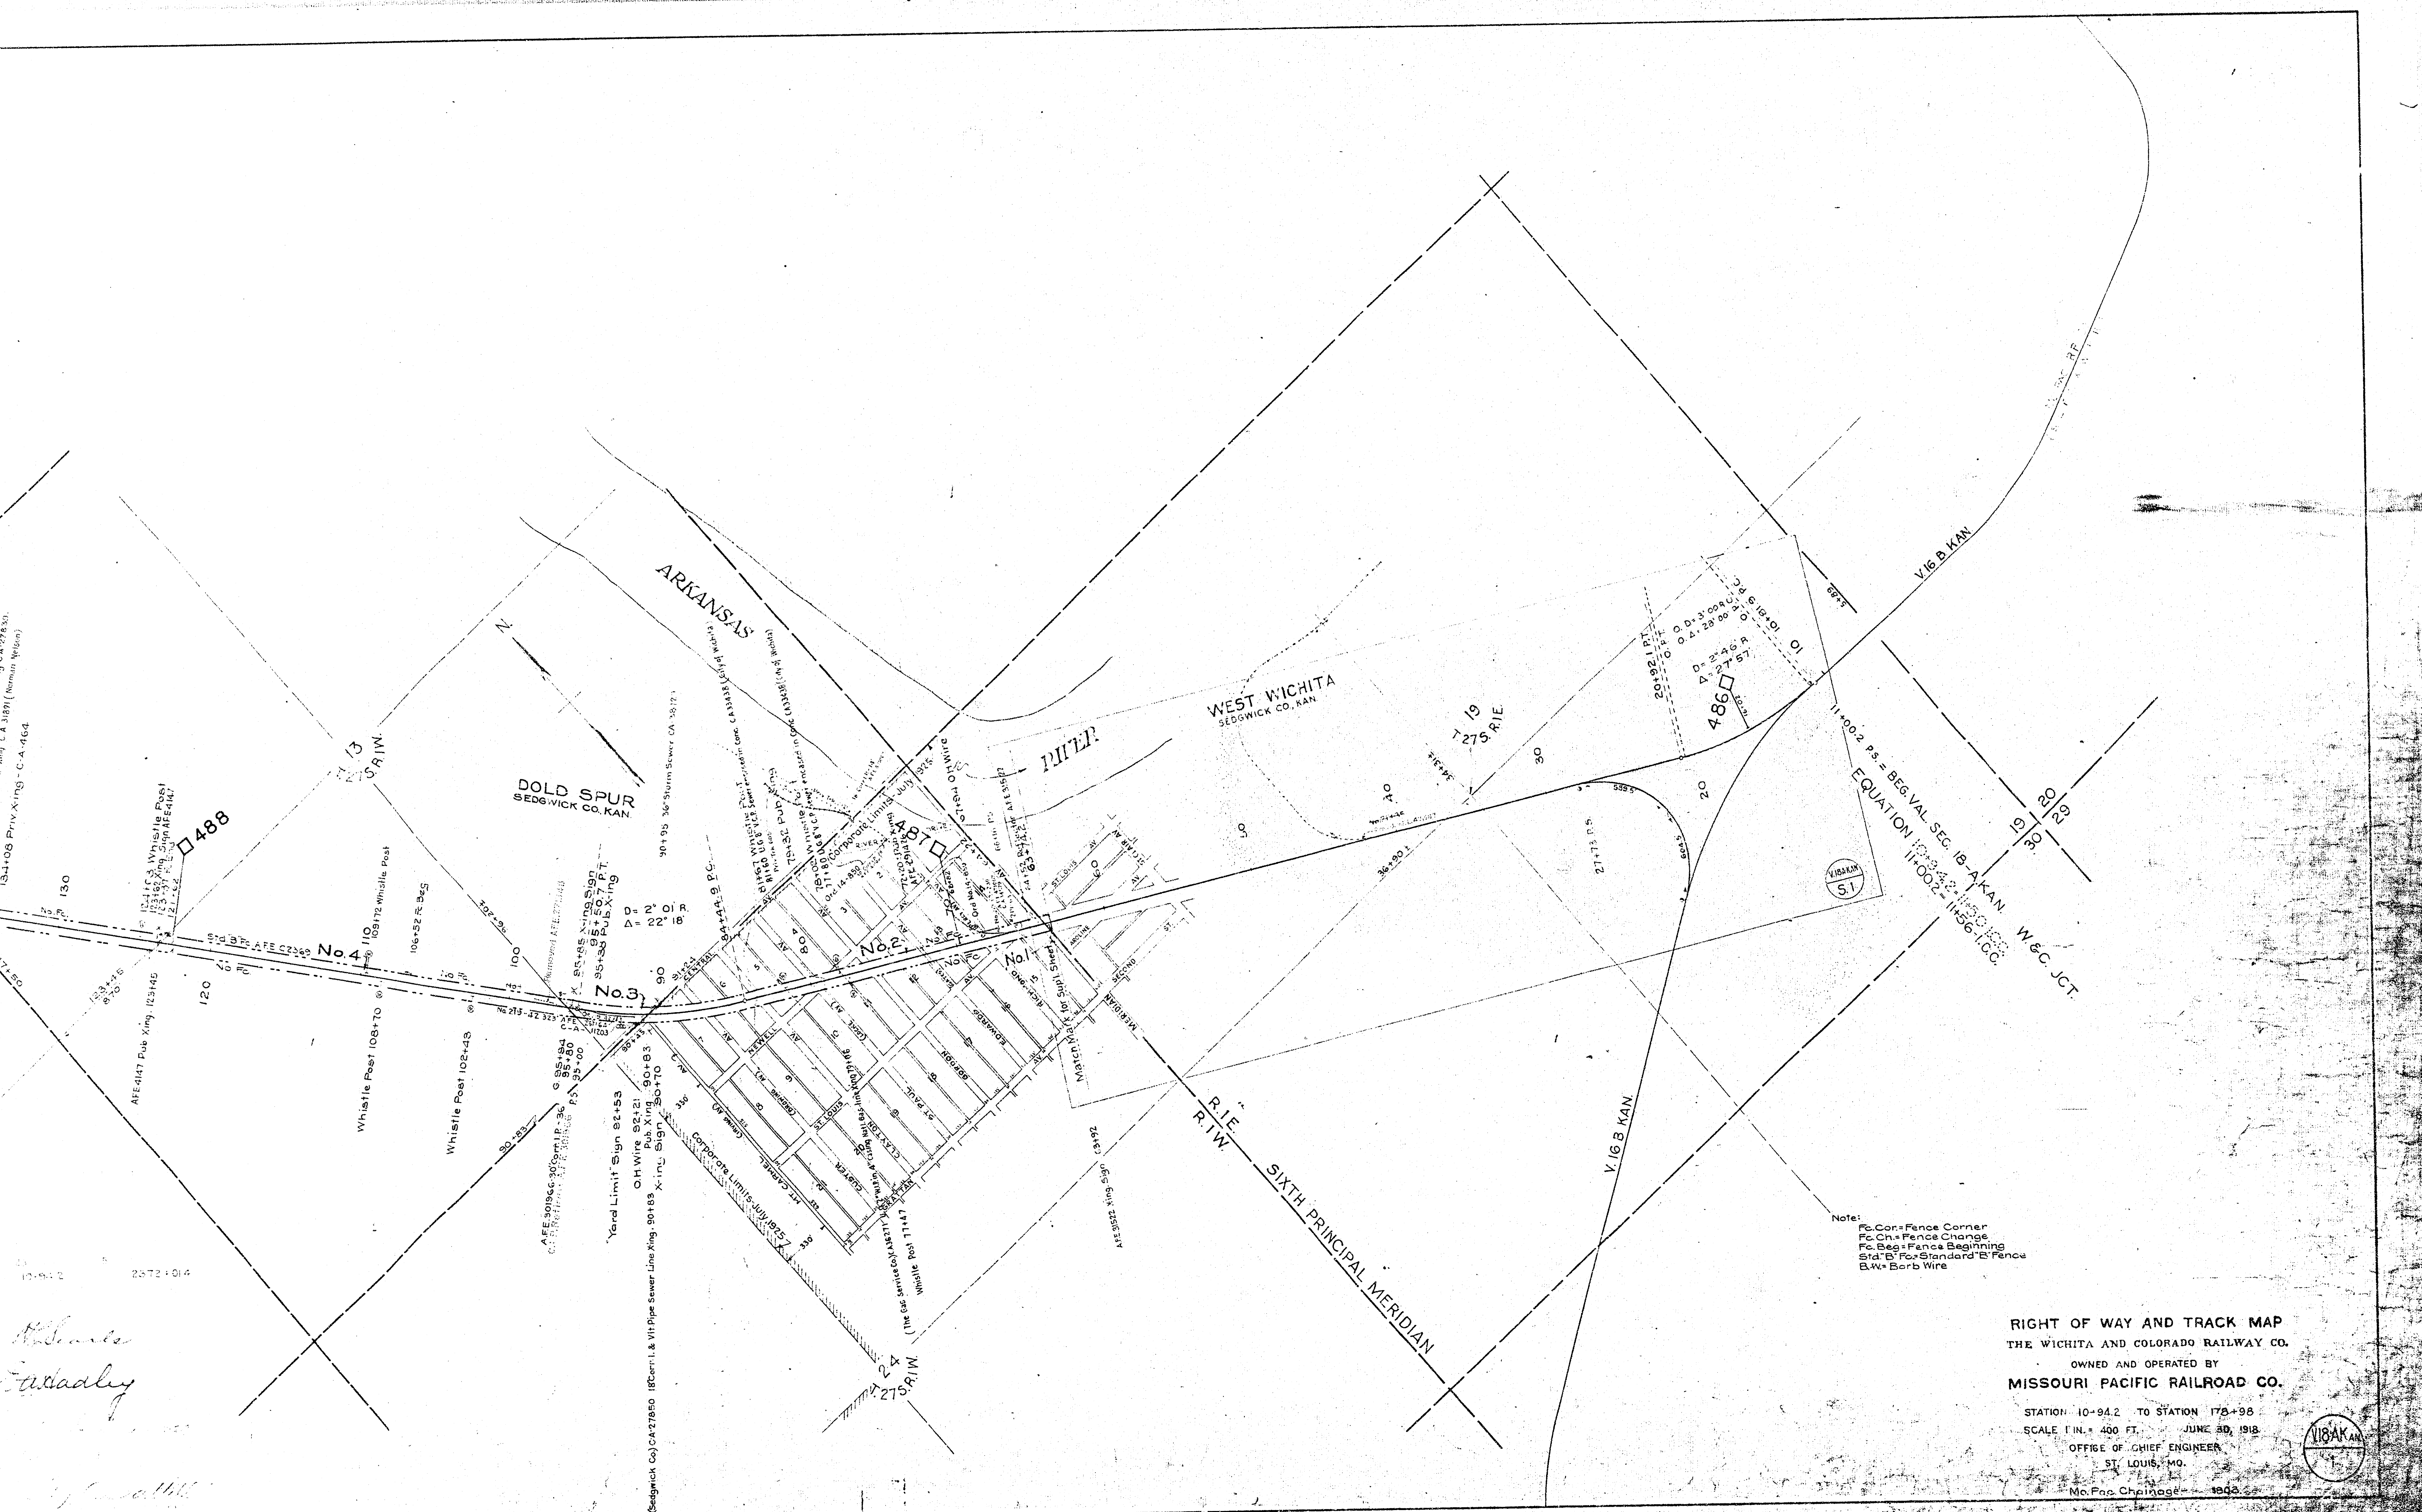

REVISED AS TO	SOURCE	DATE	DRAFTSMAN



3600+32
26.49

