


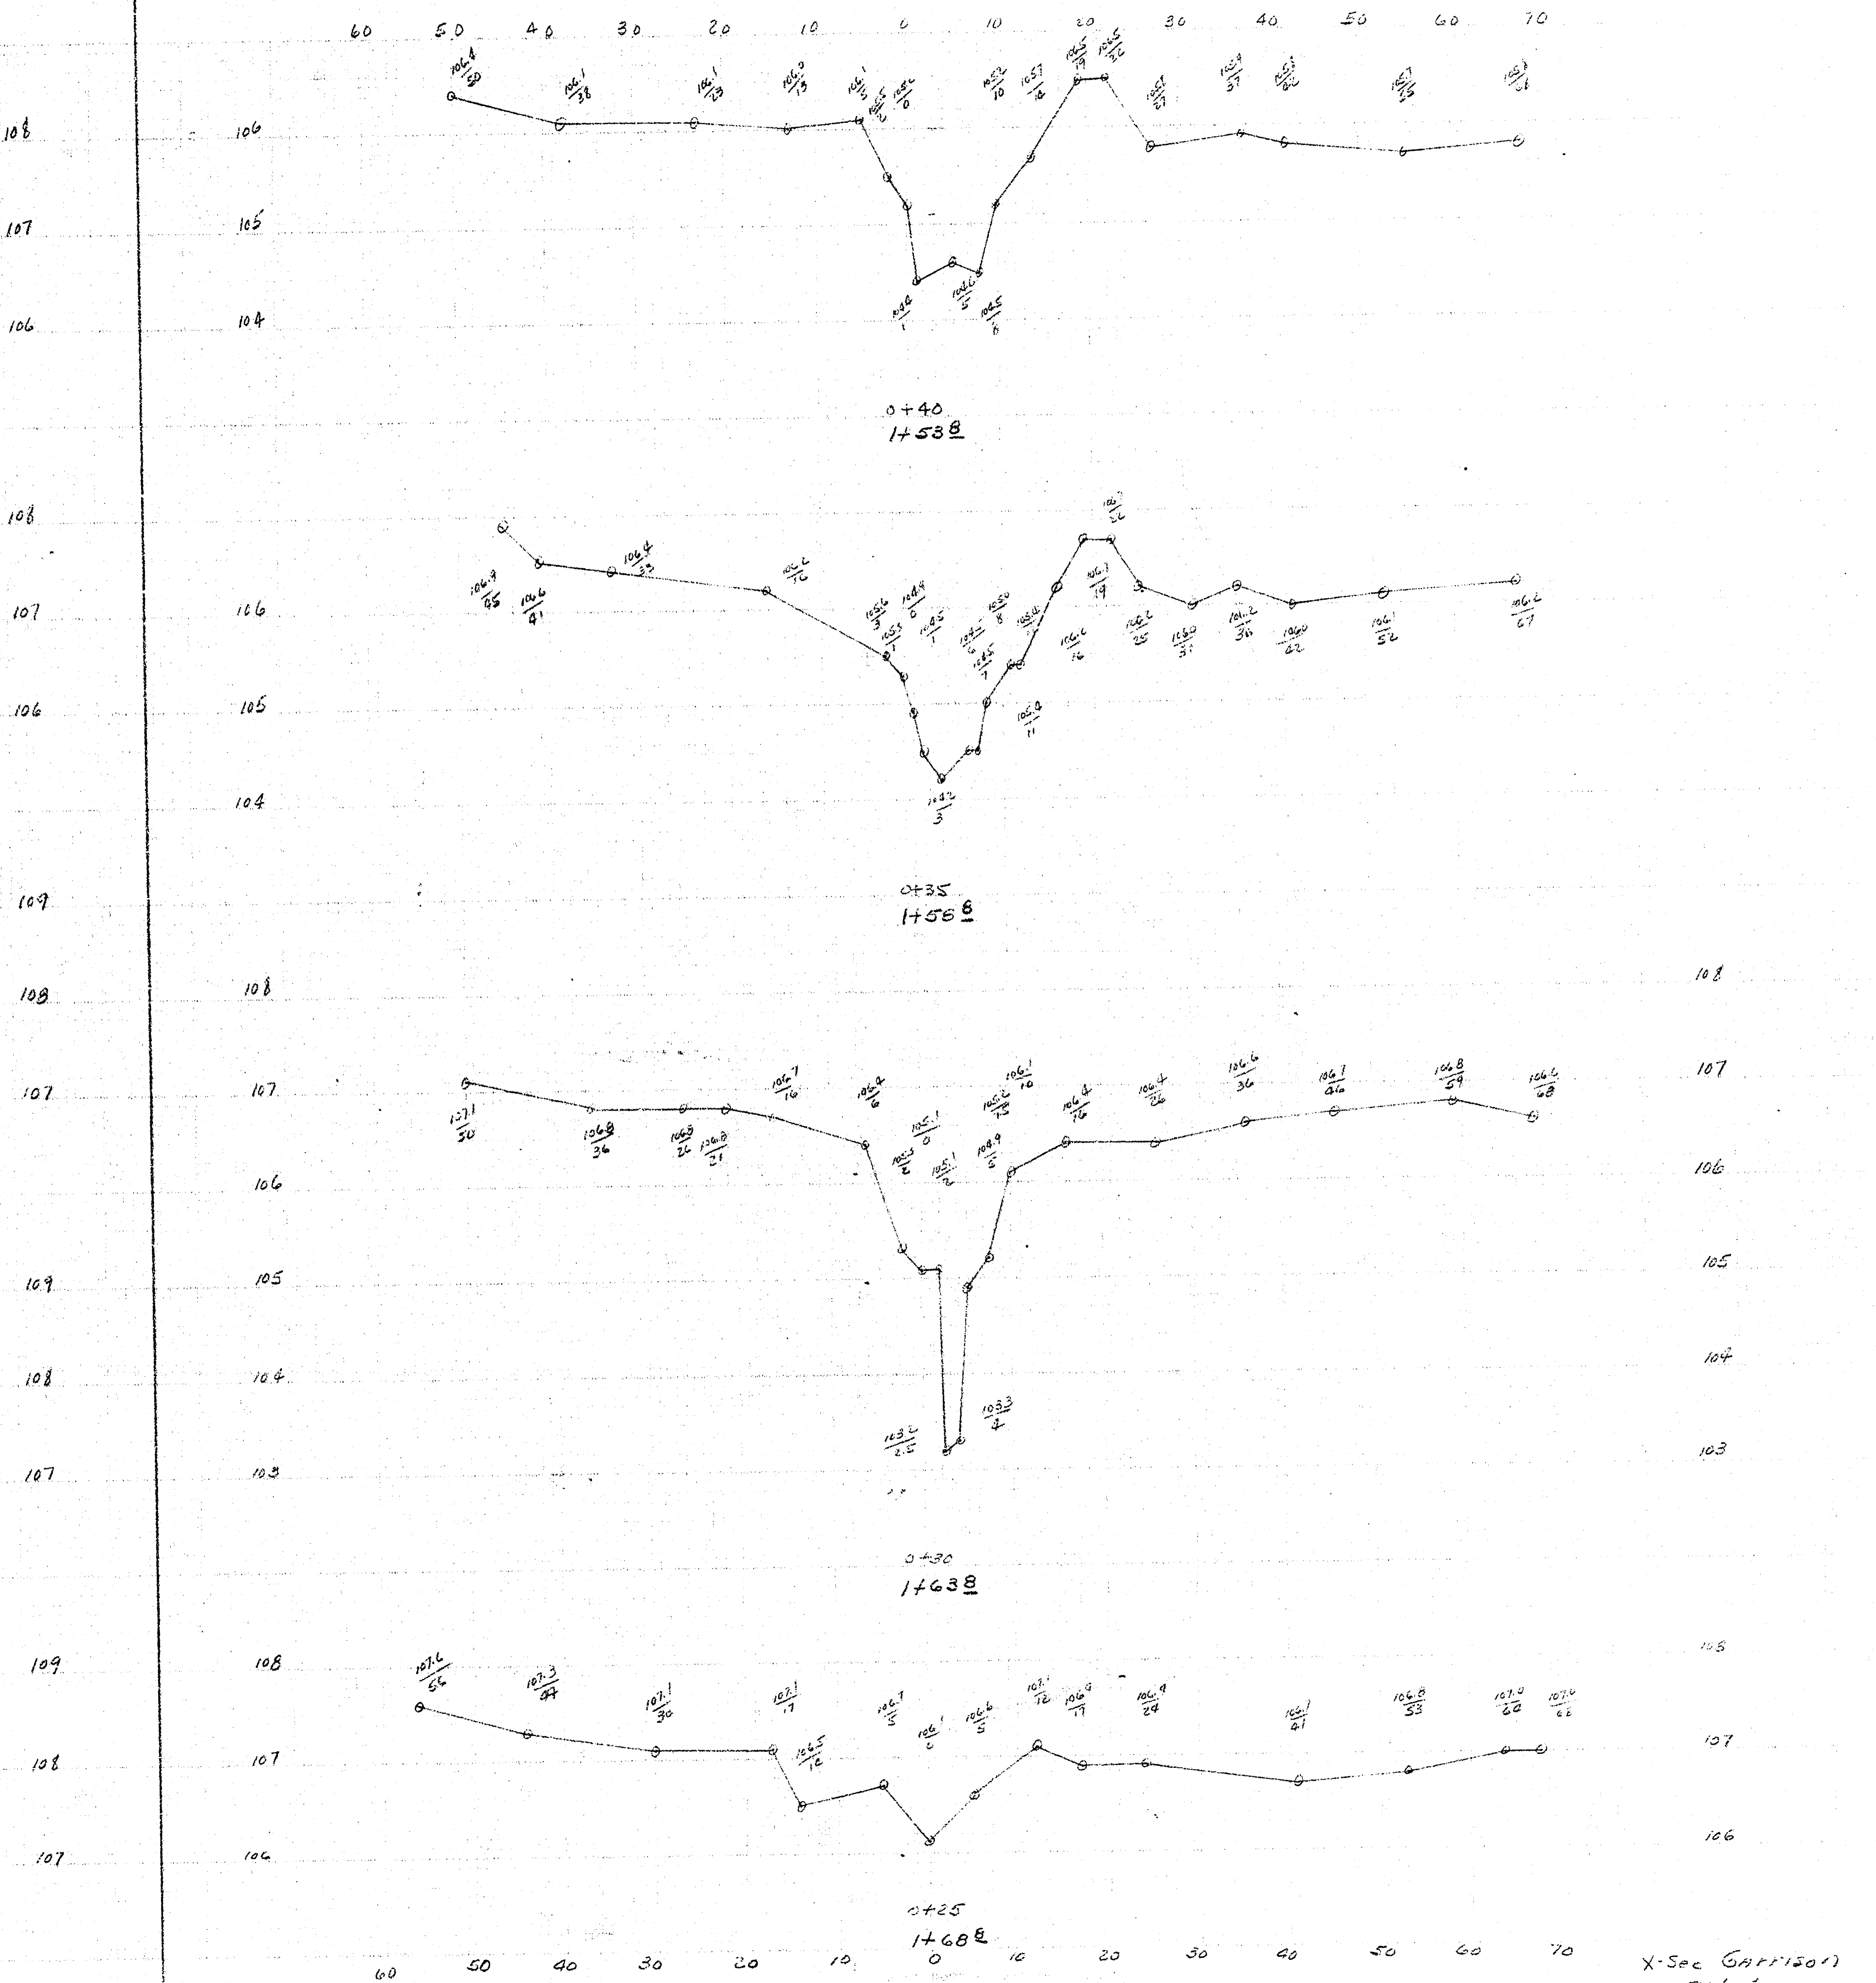
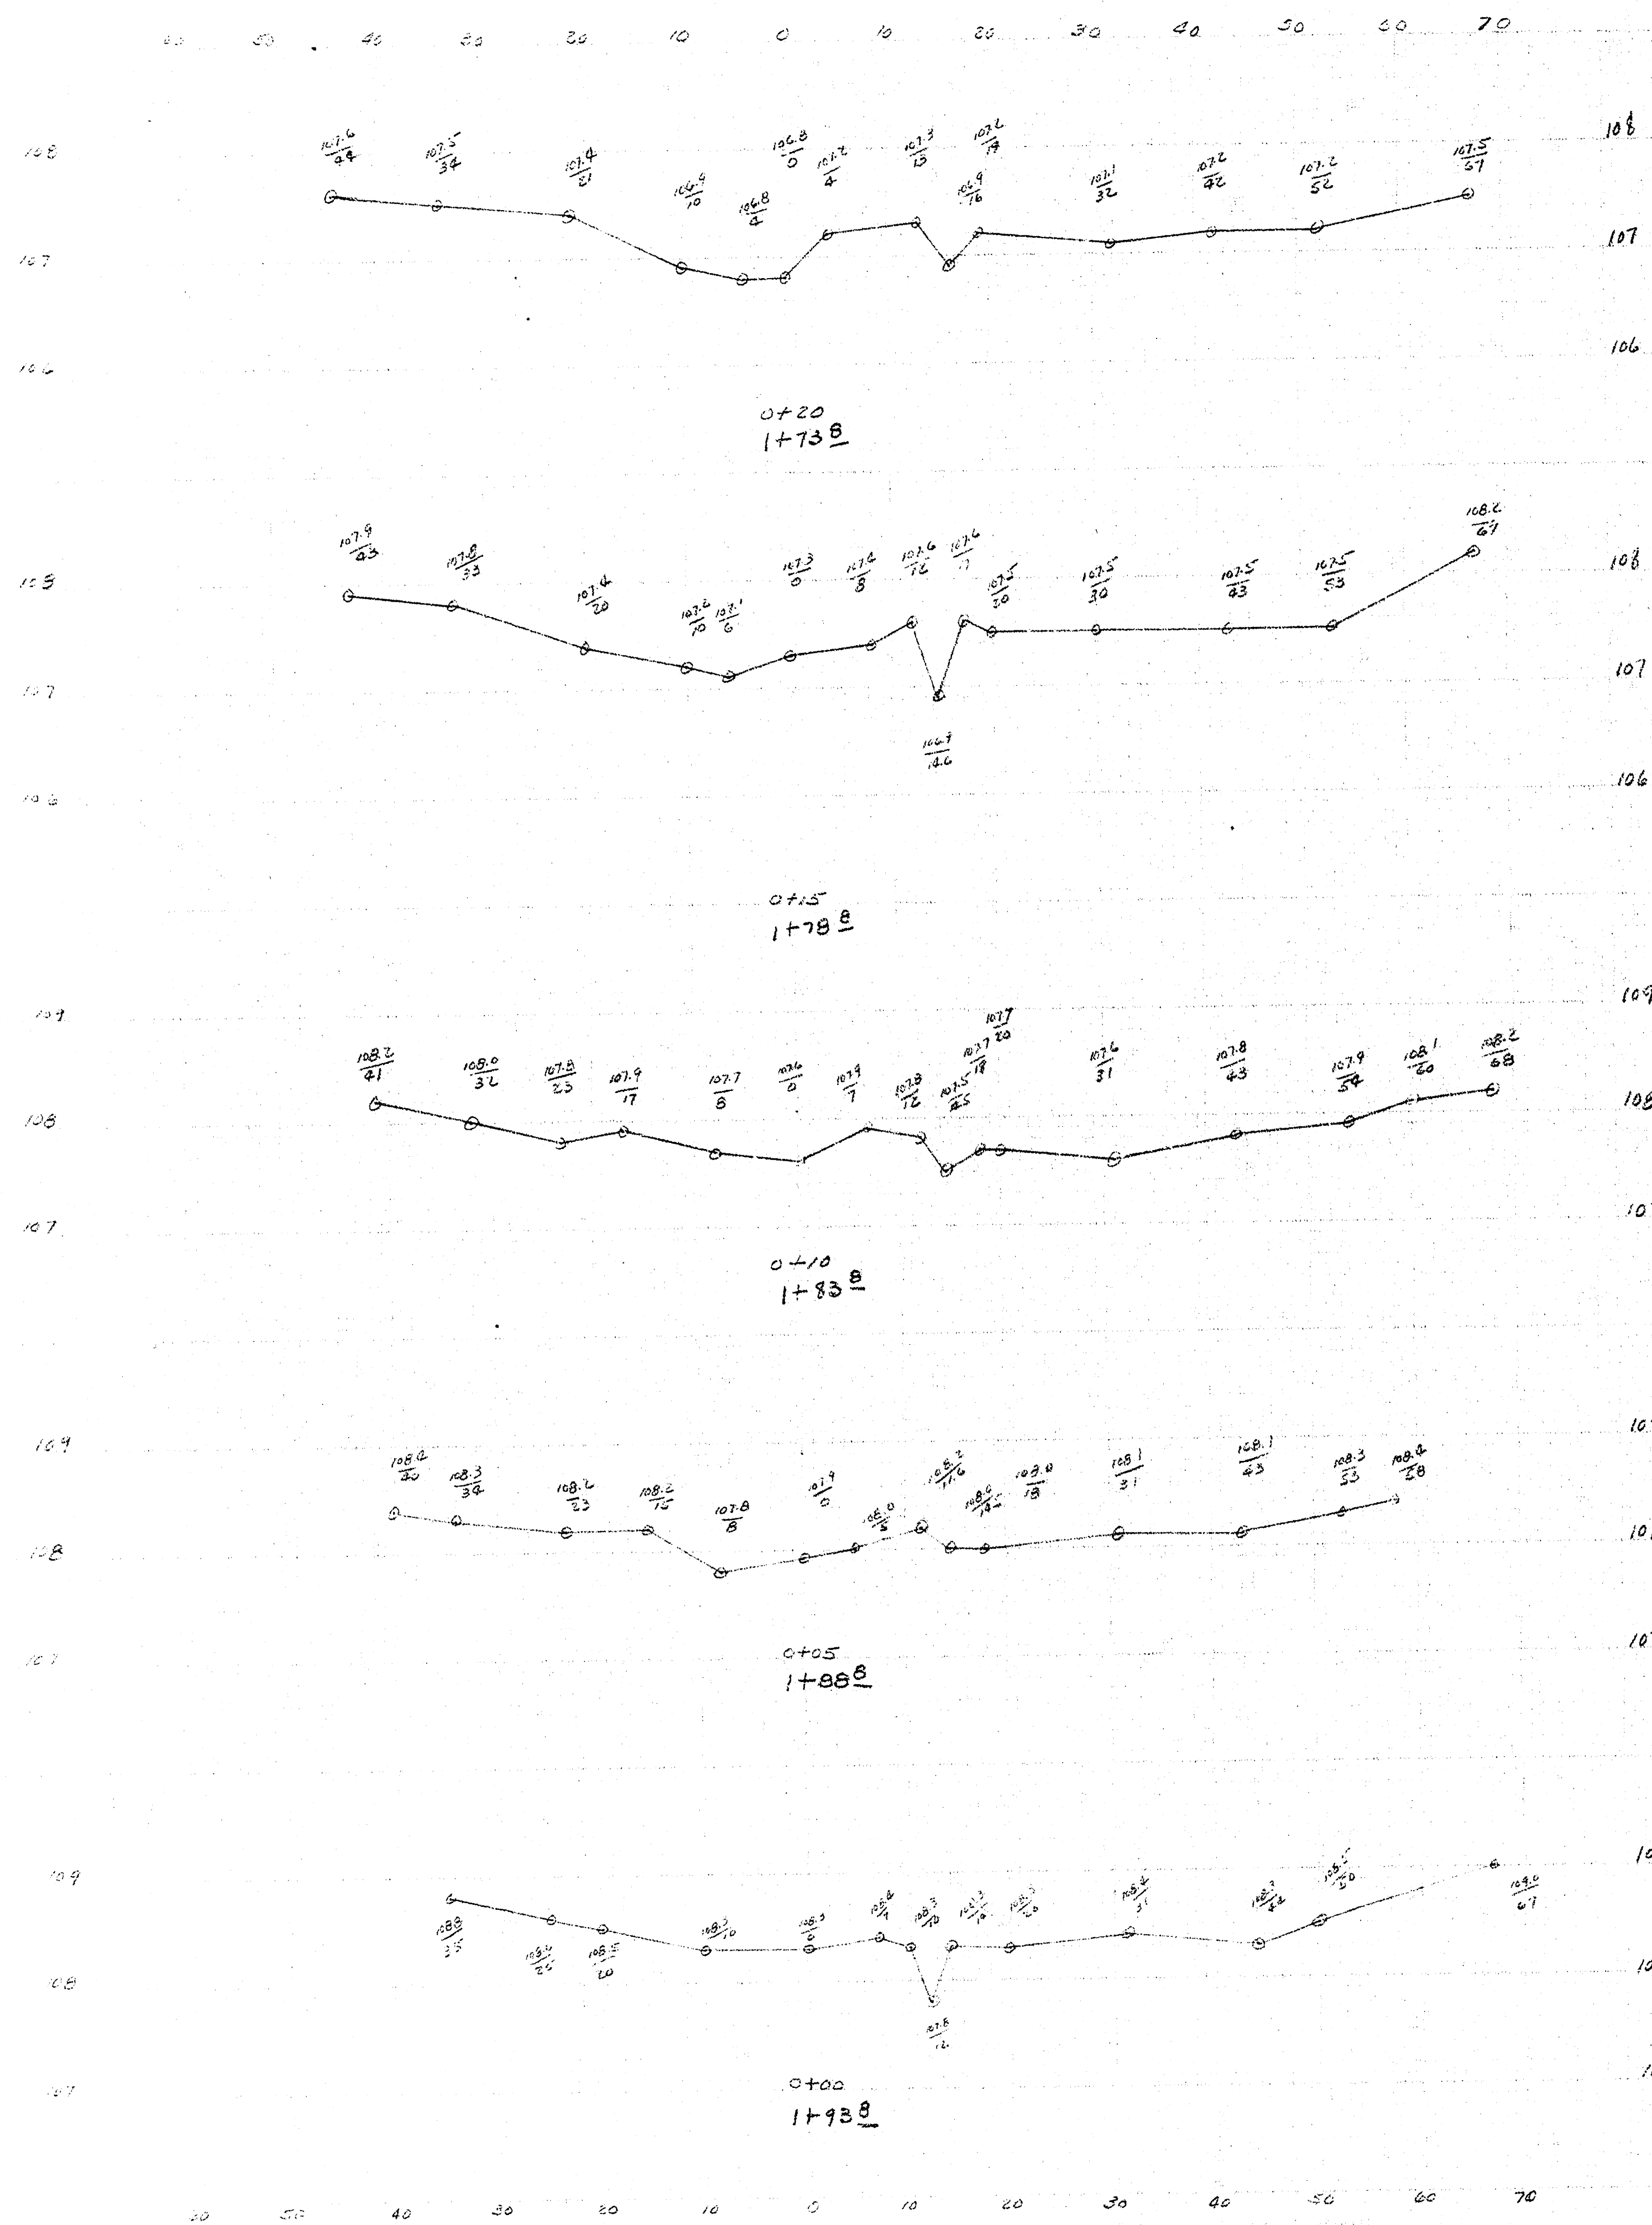
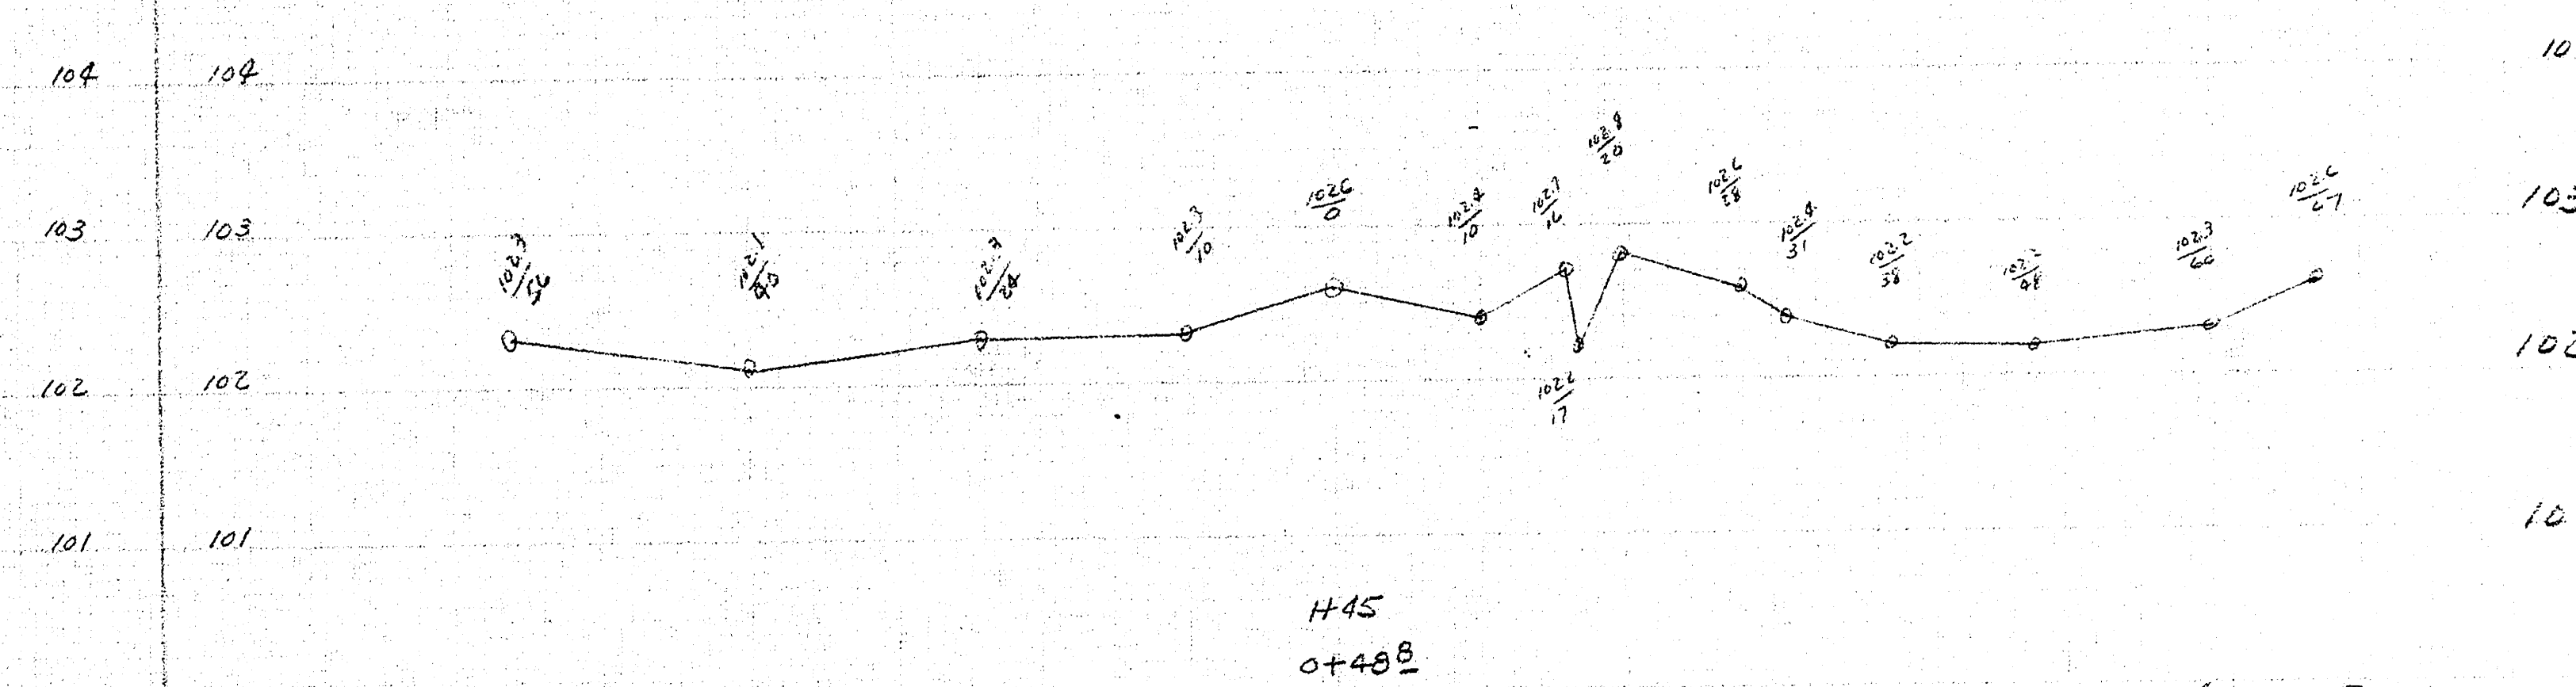
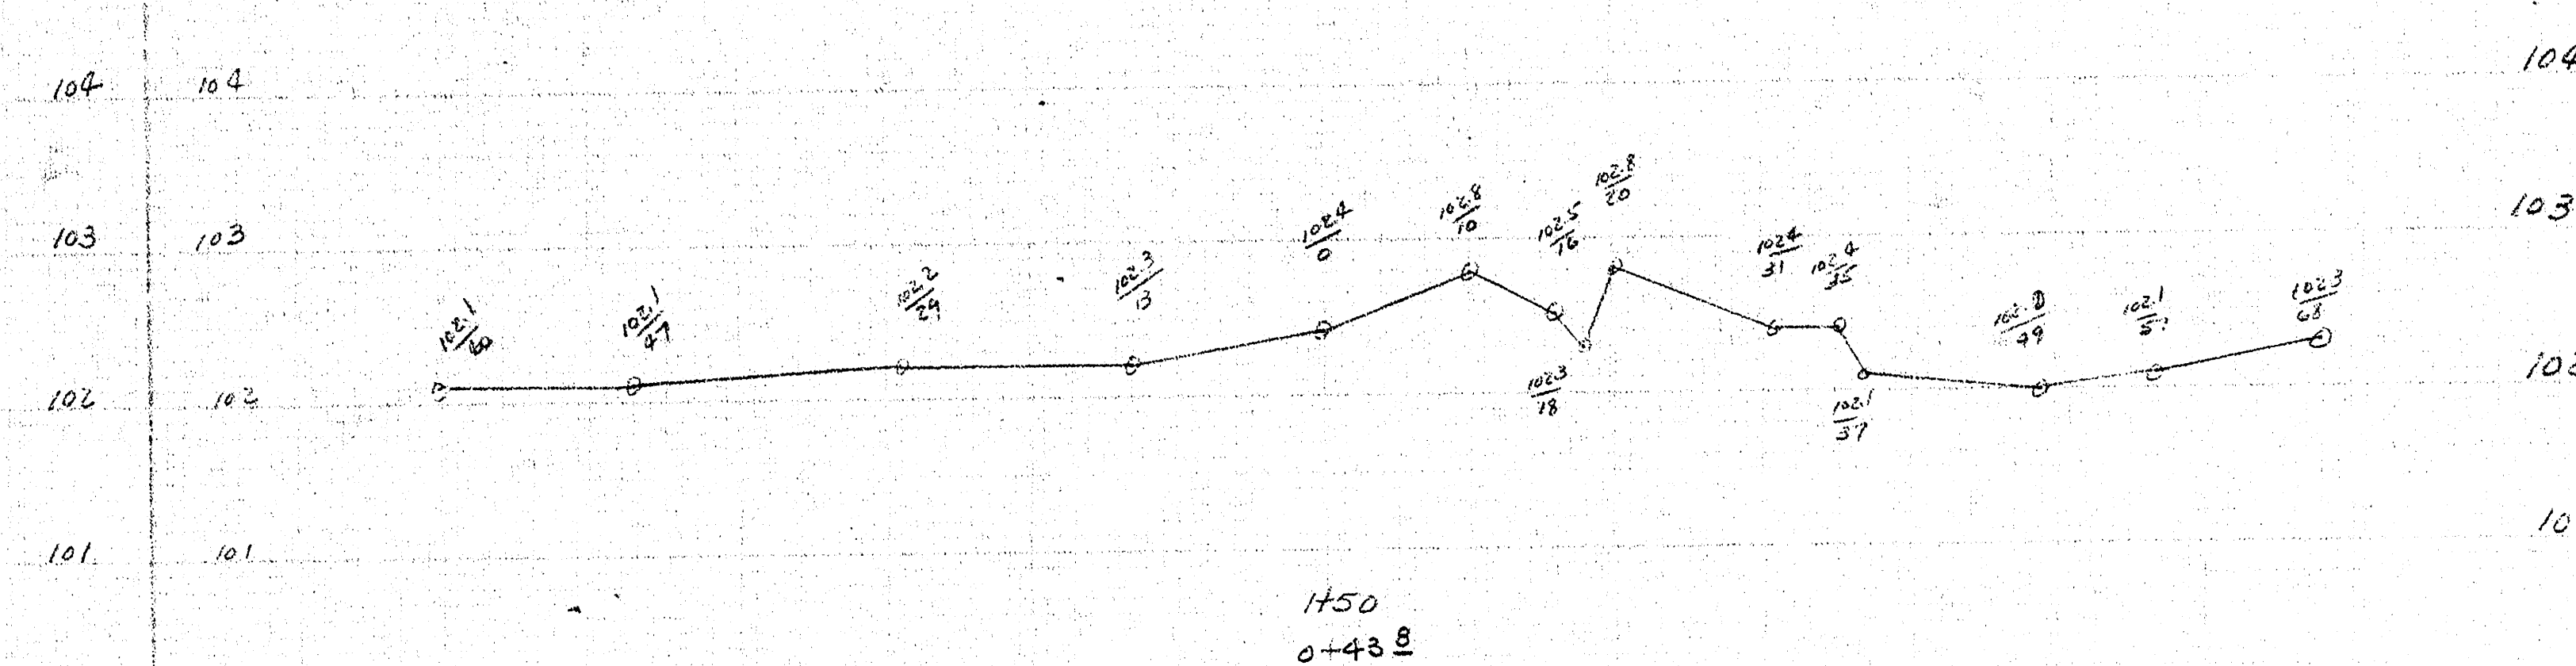
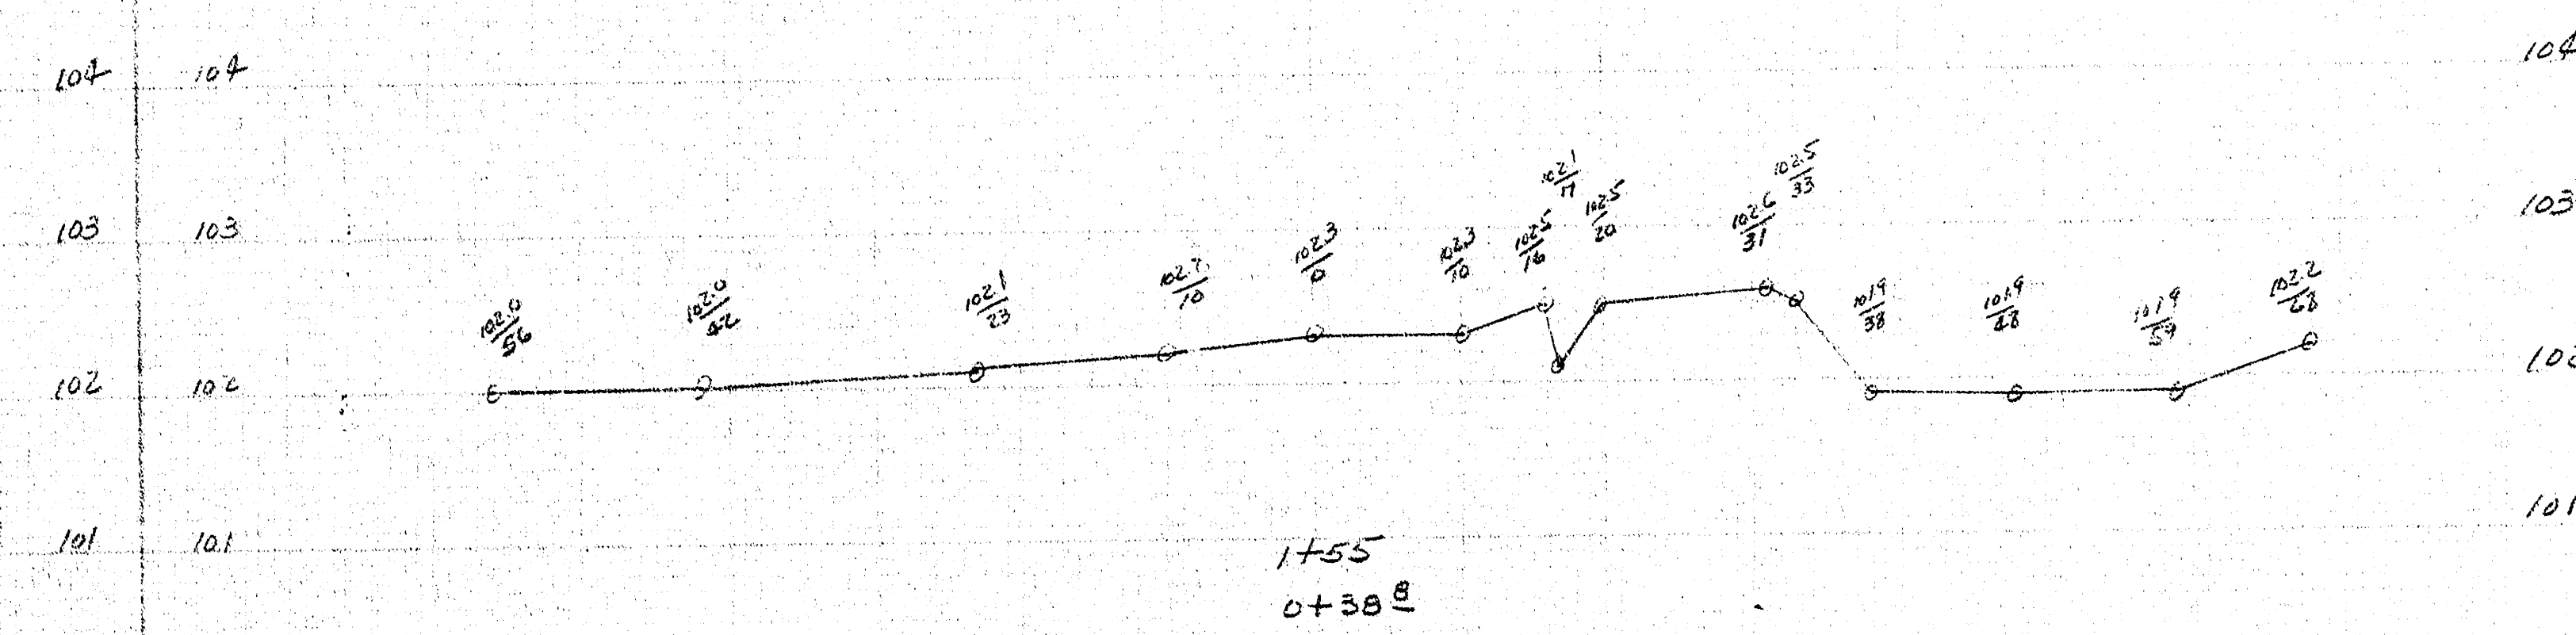
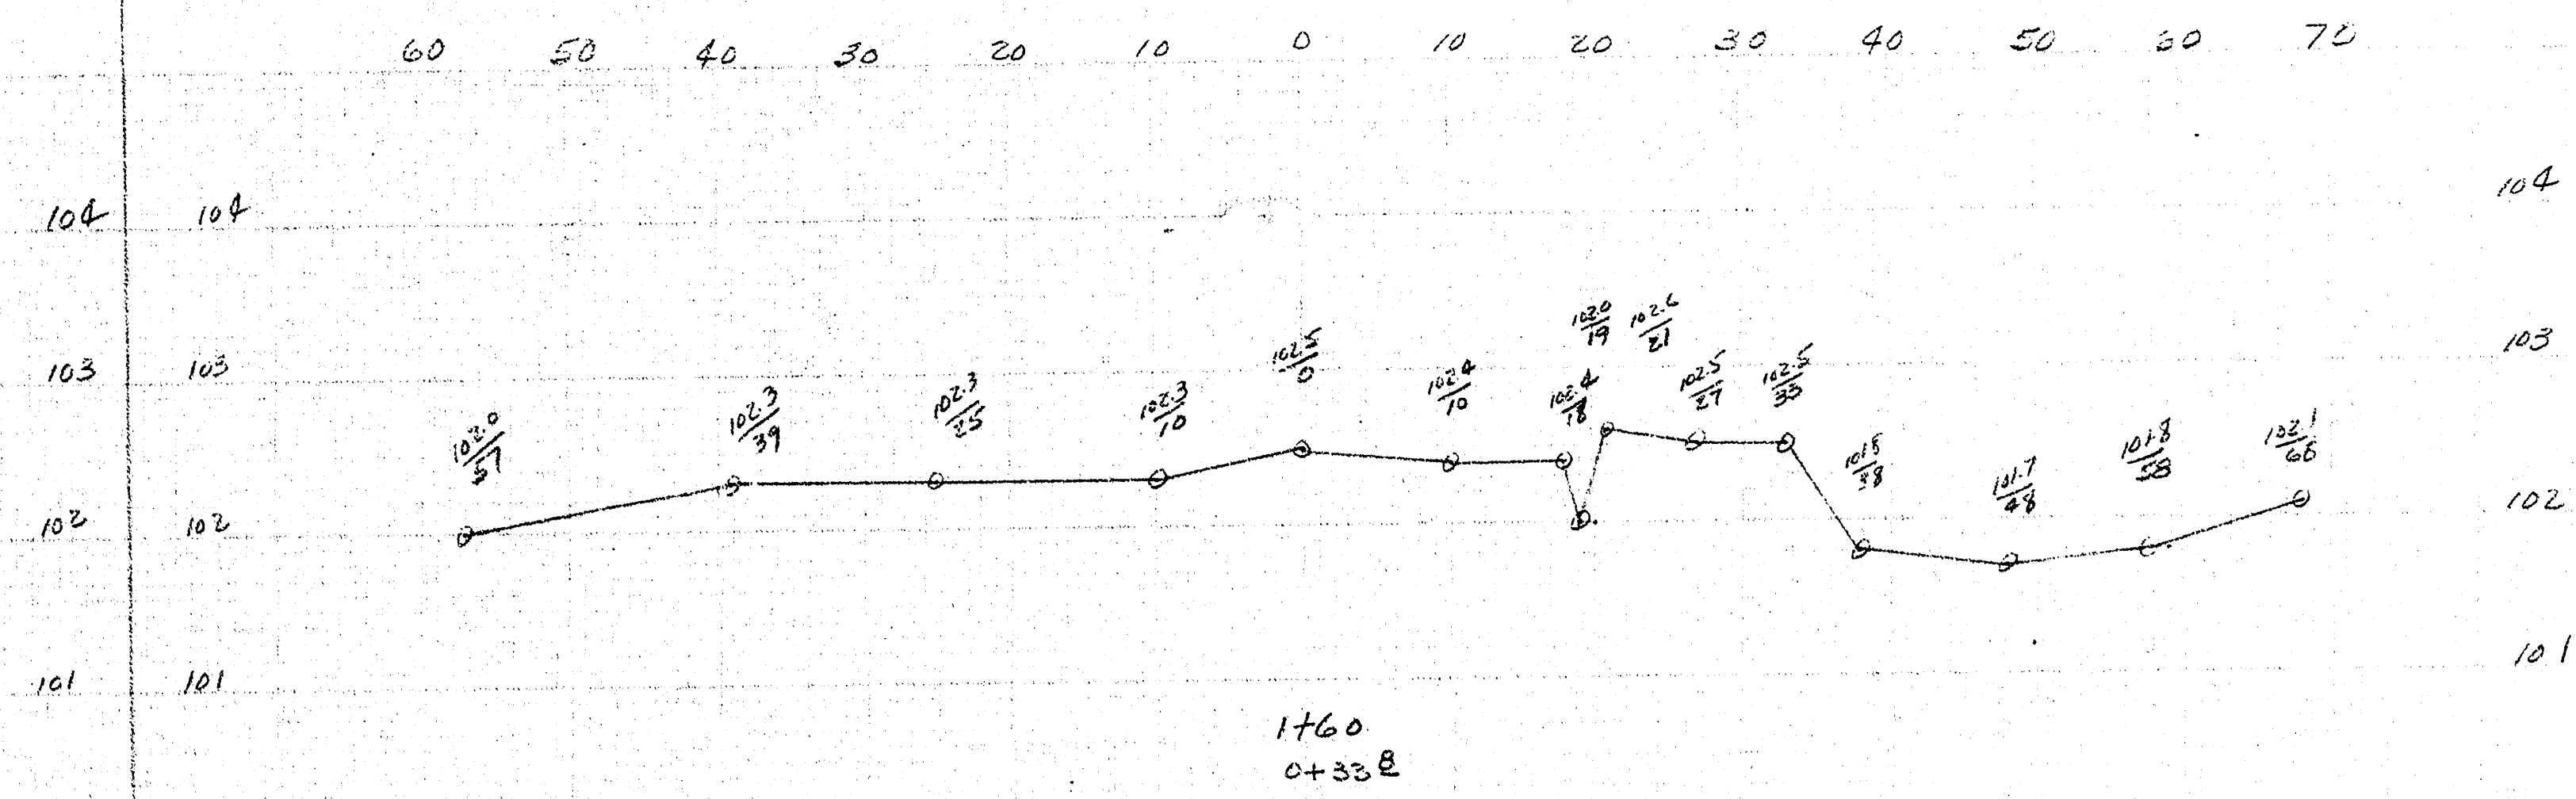
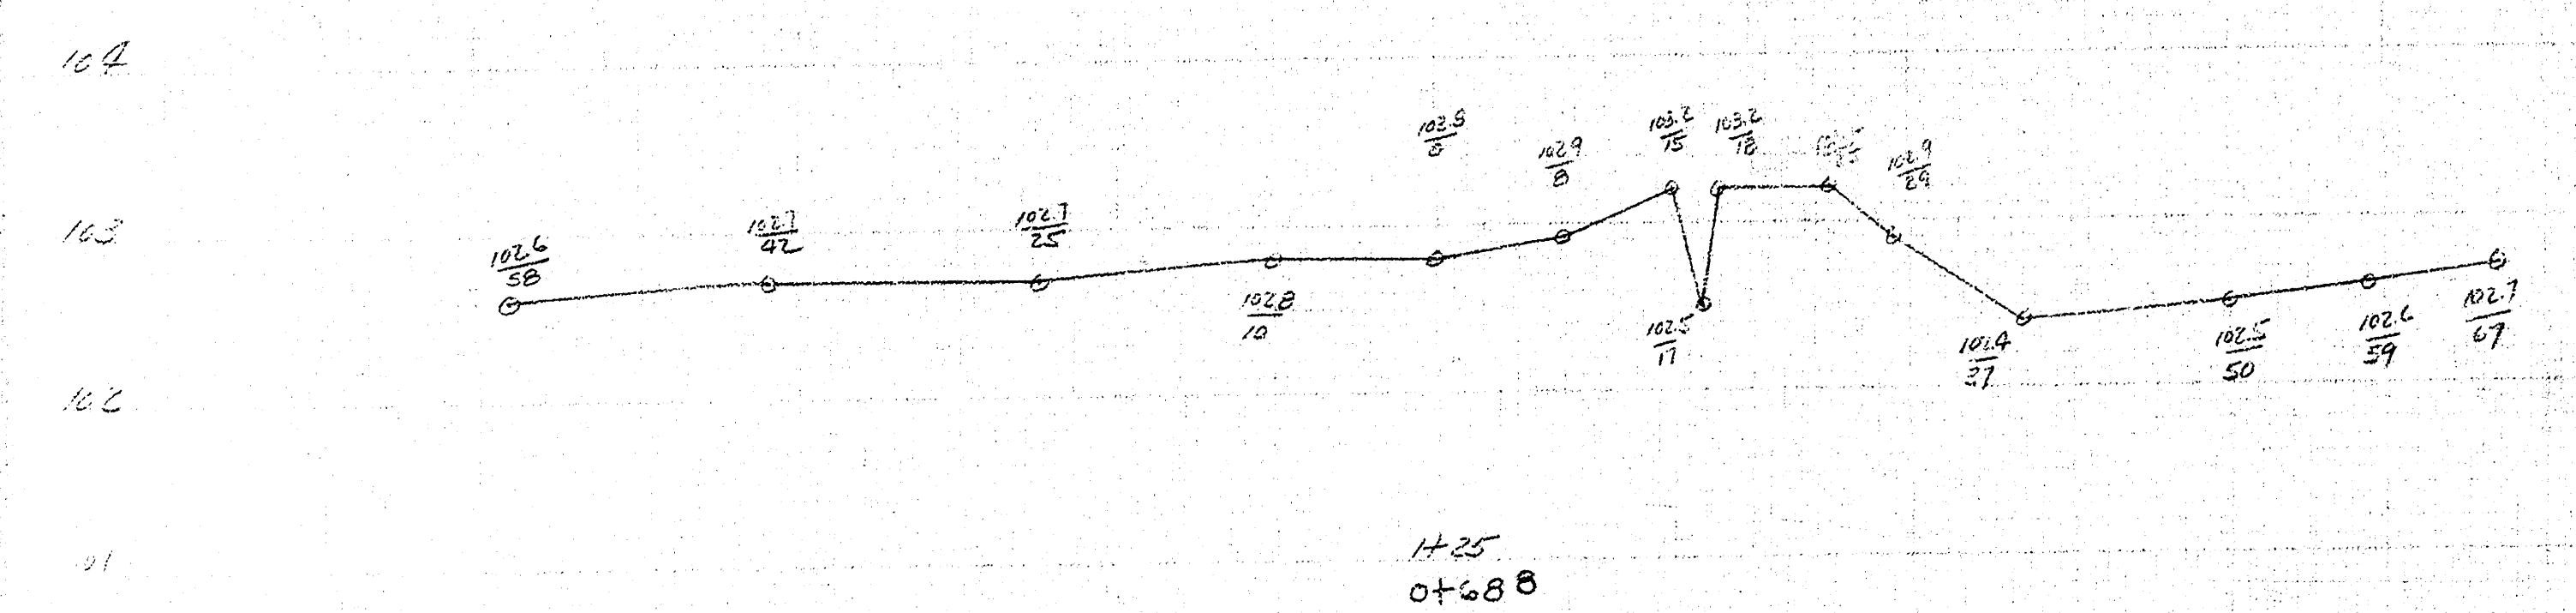


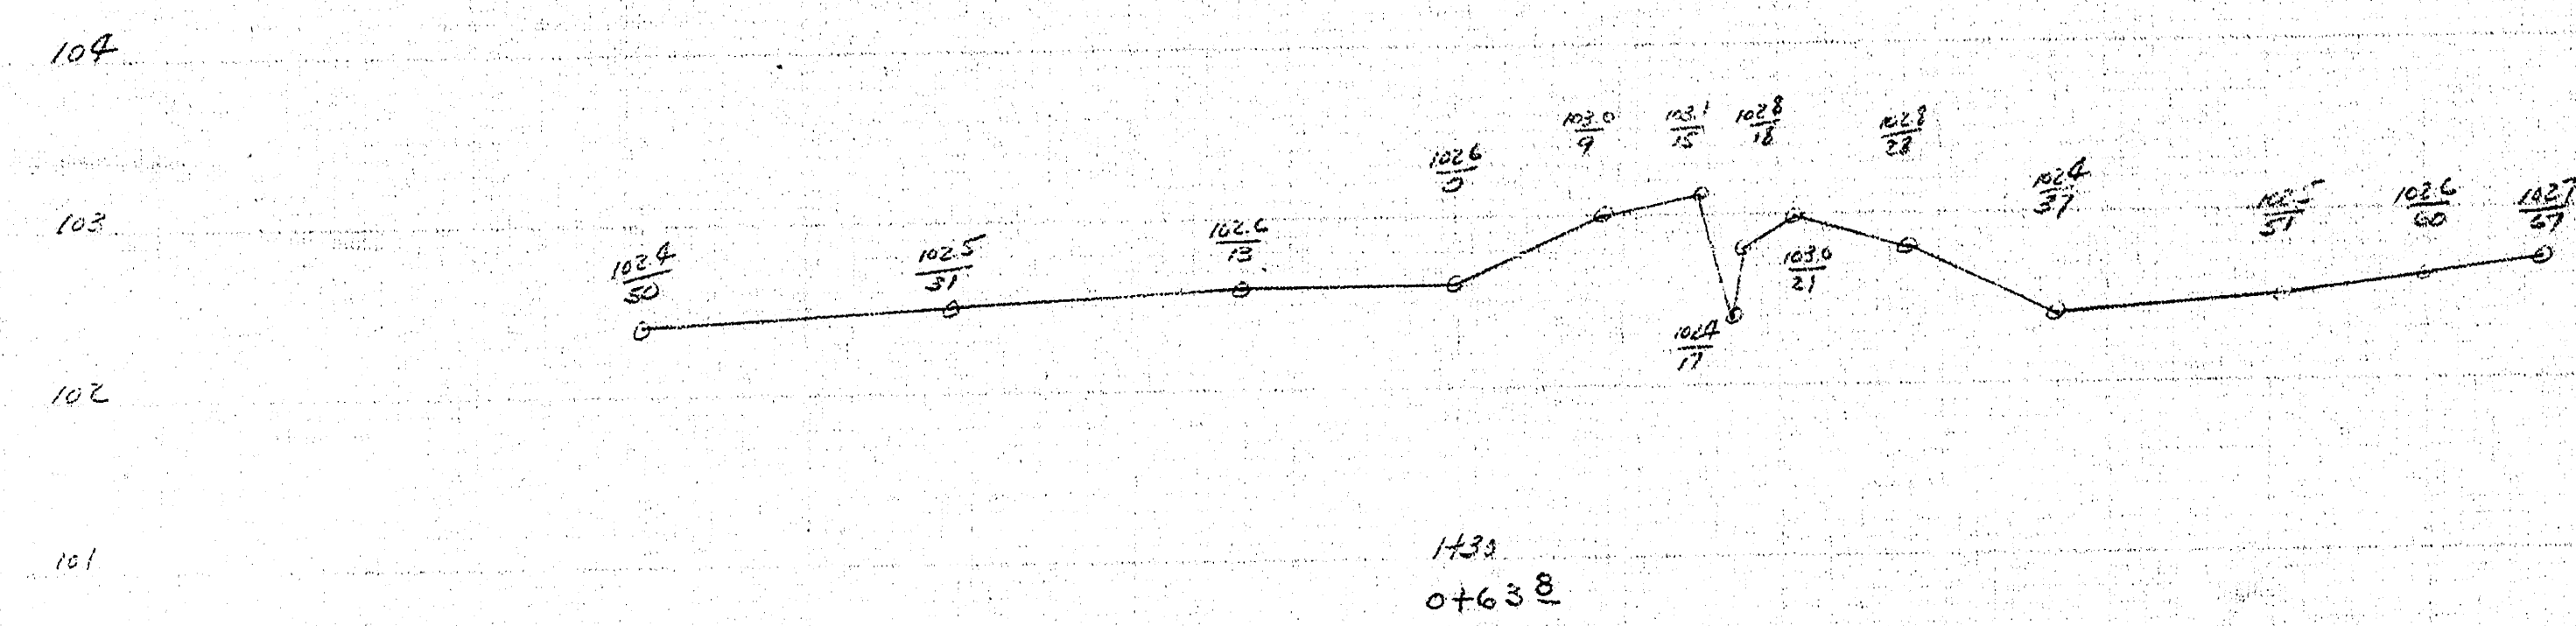

X-500 (GARRISON)
 Ditch
 Sheet # 1 of 5
 Sept 29, 1967

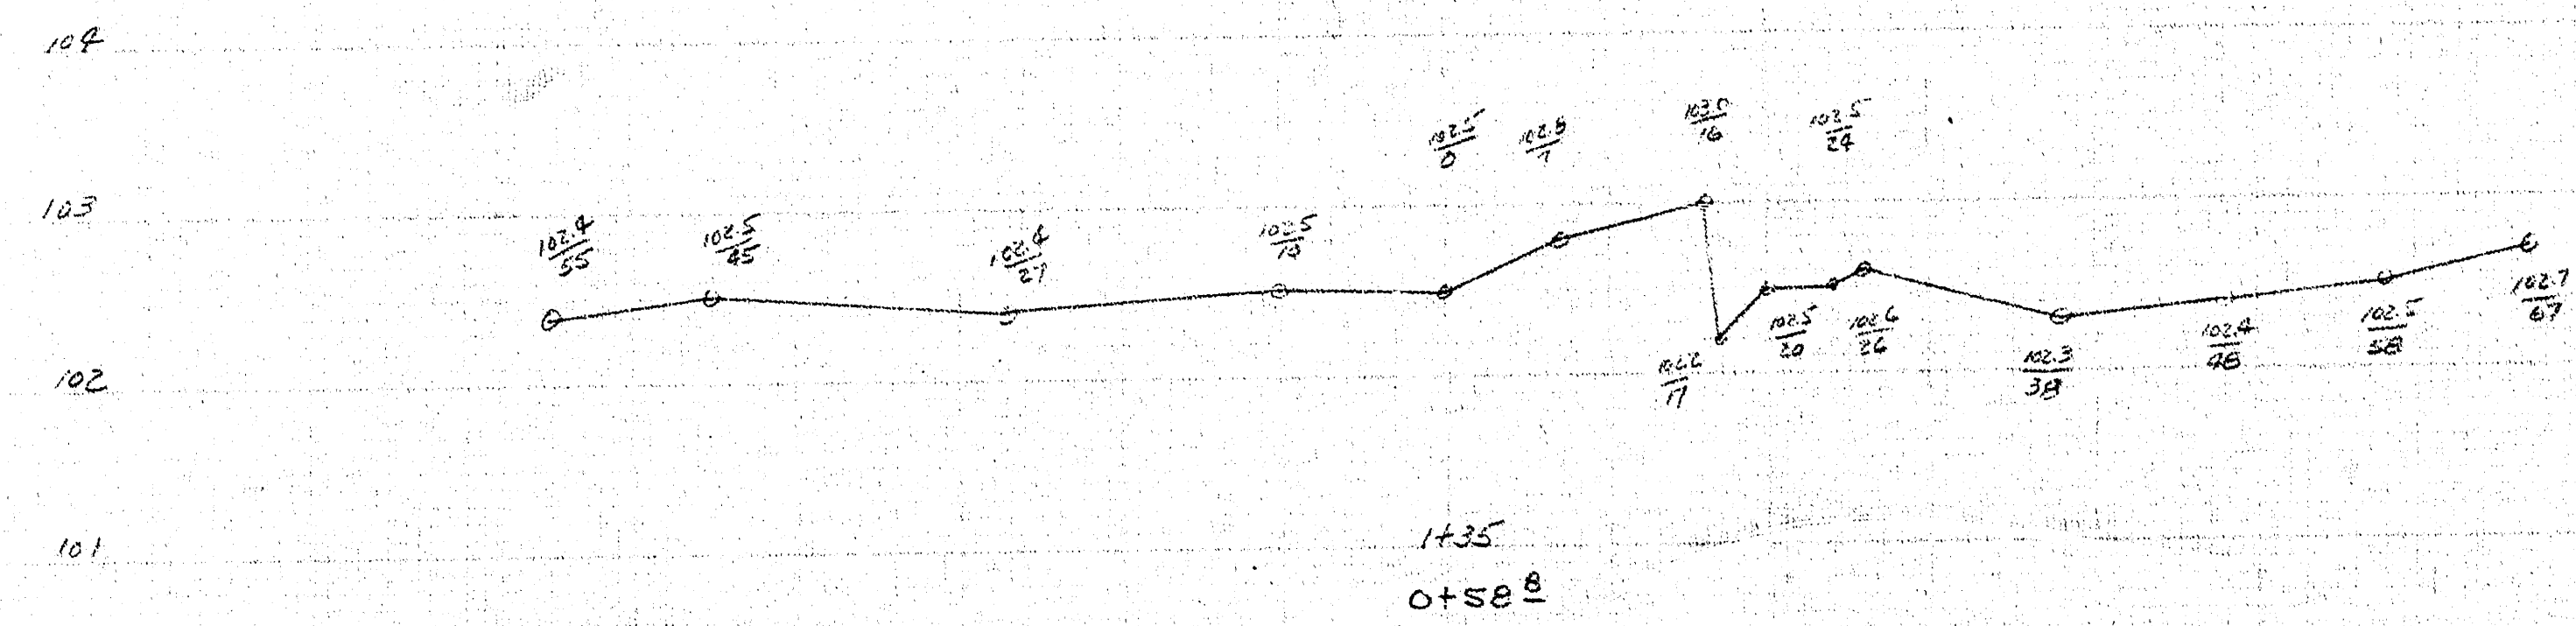

Garrison D.L.

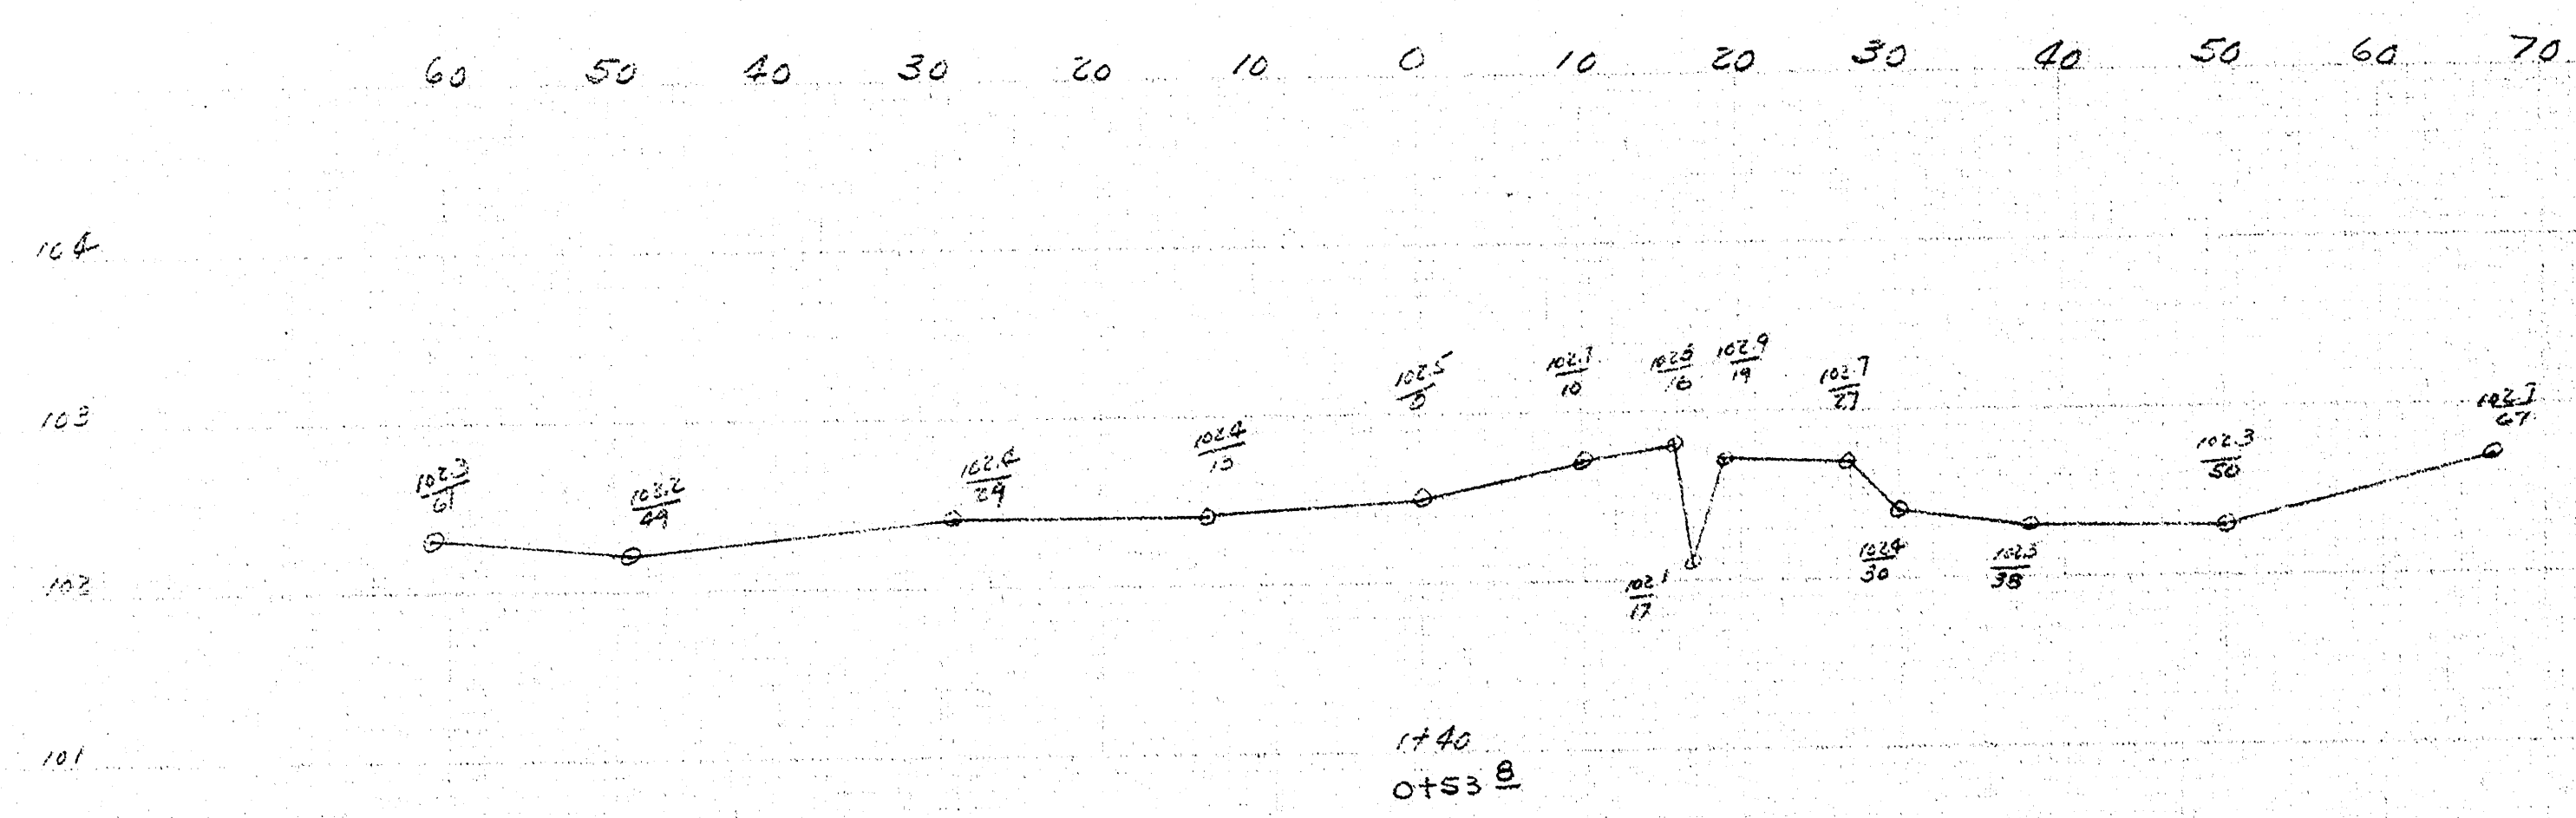