



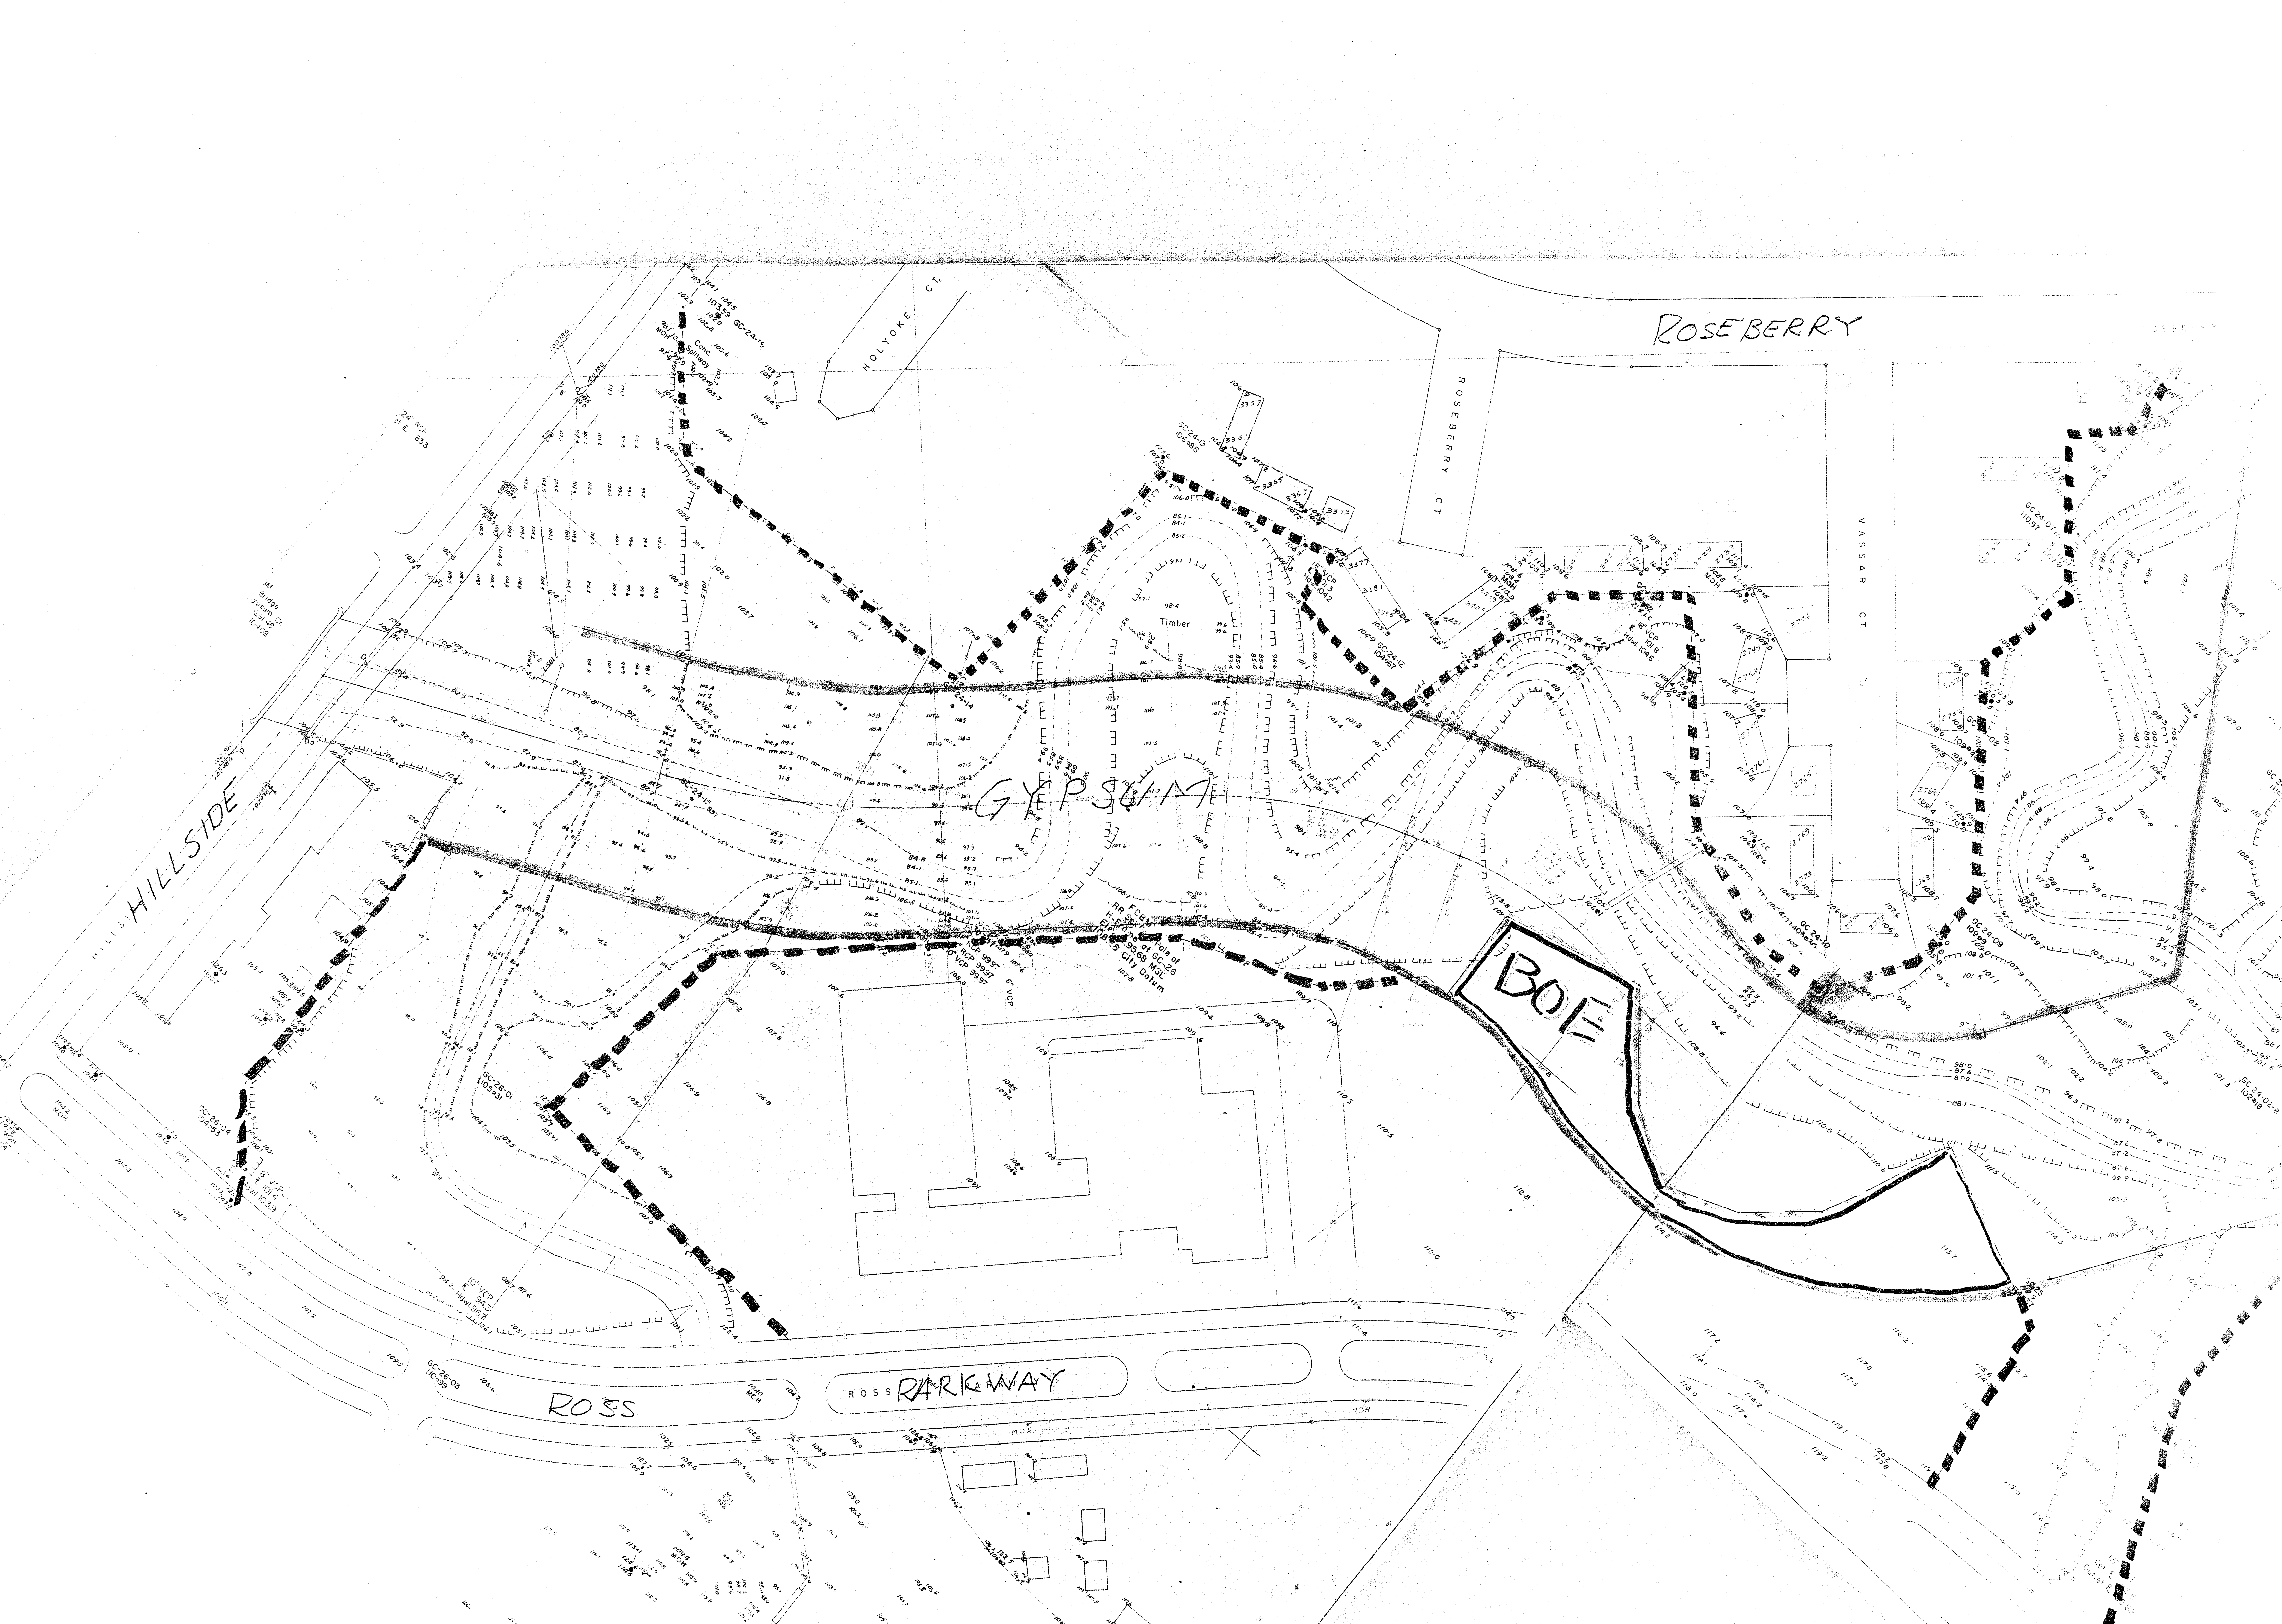

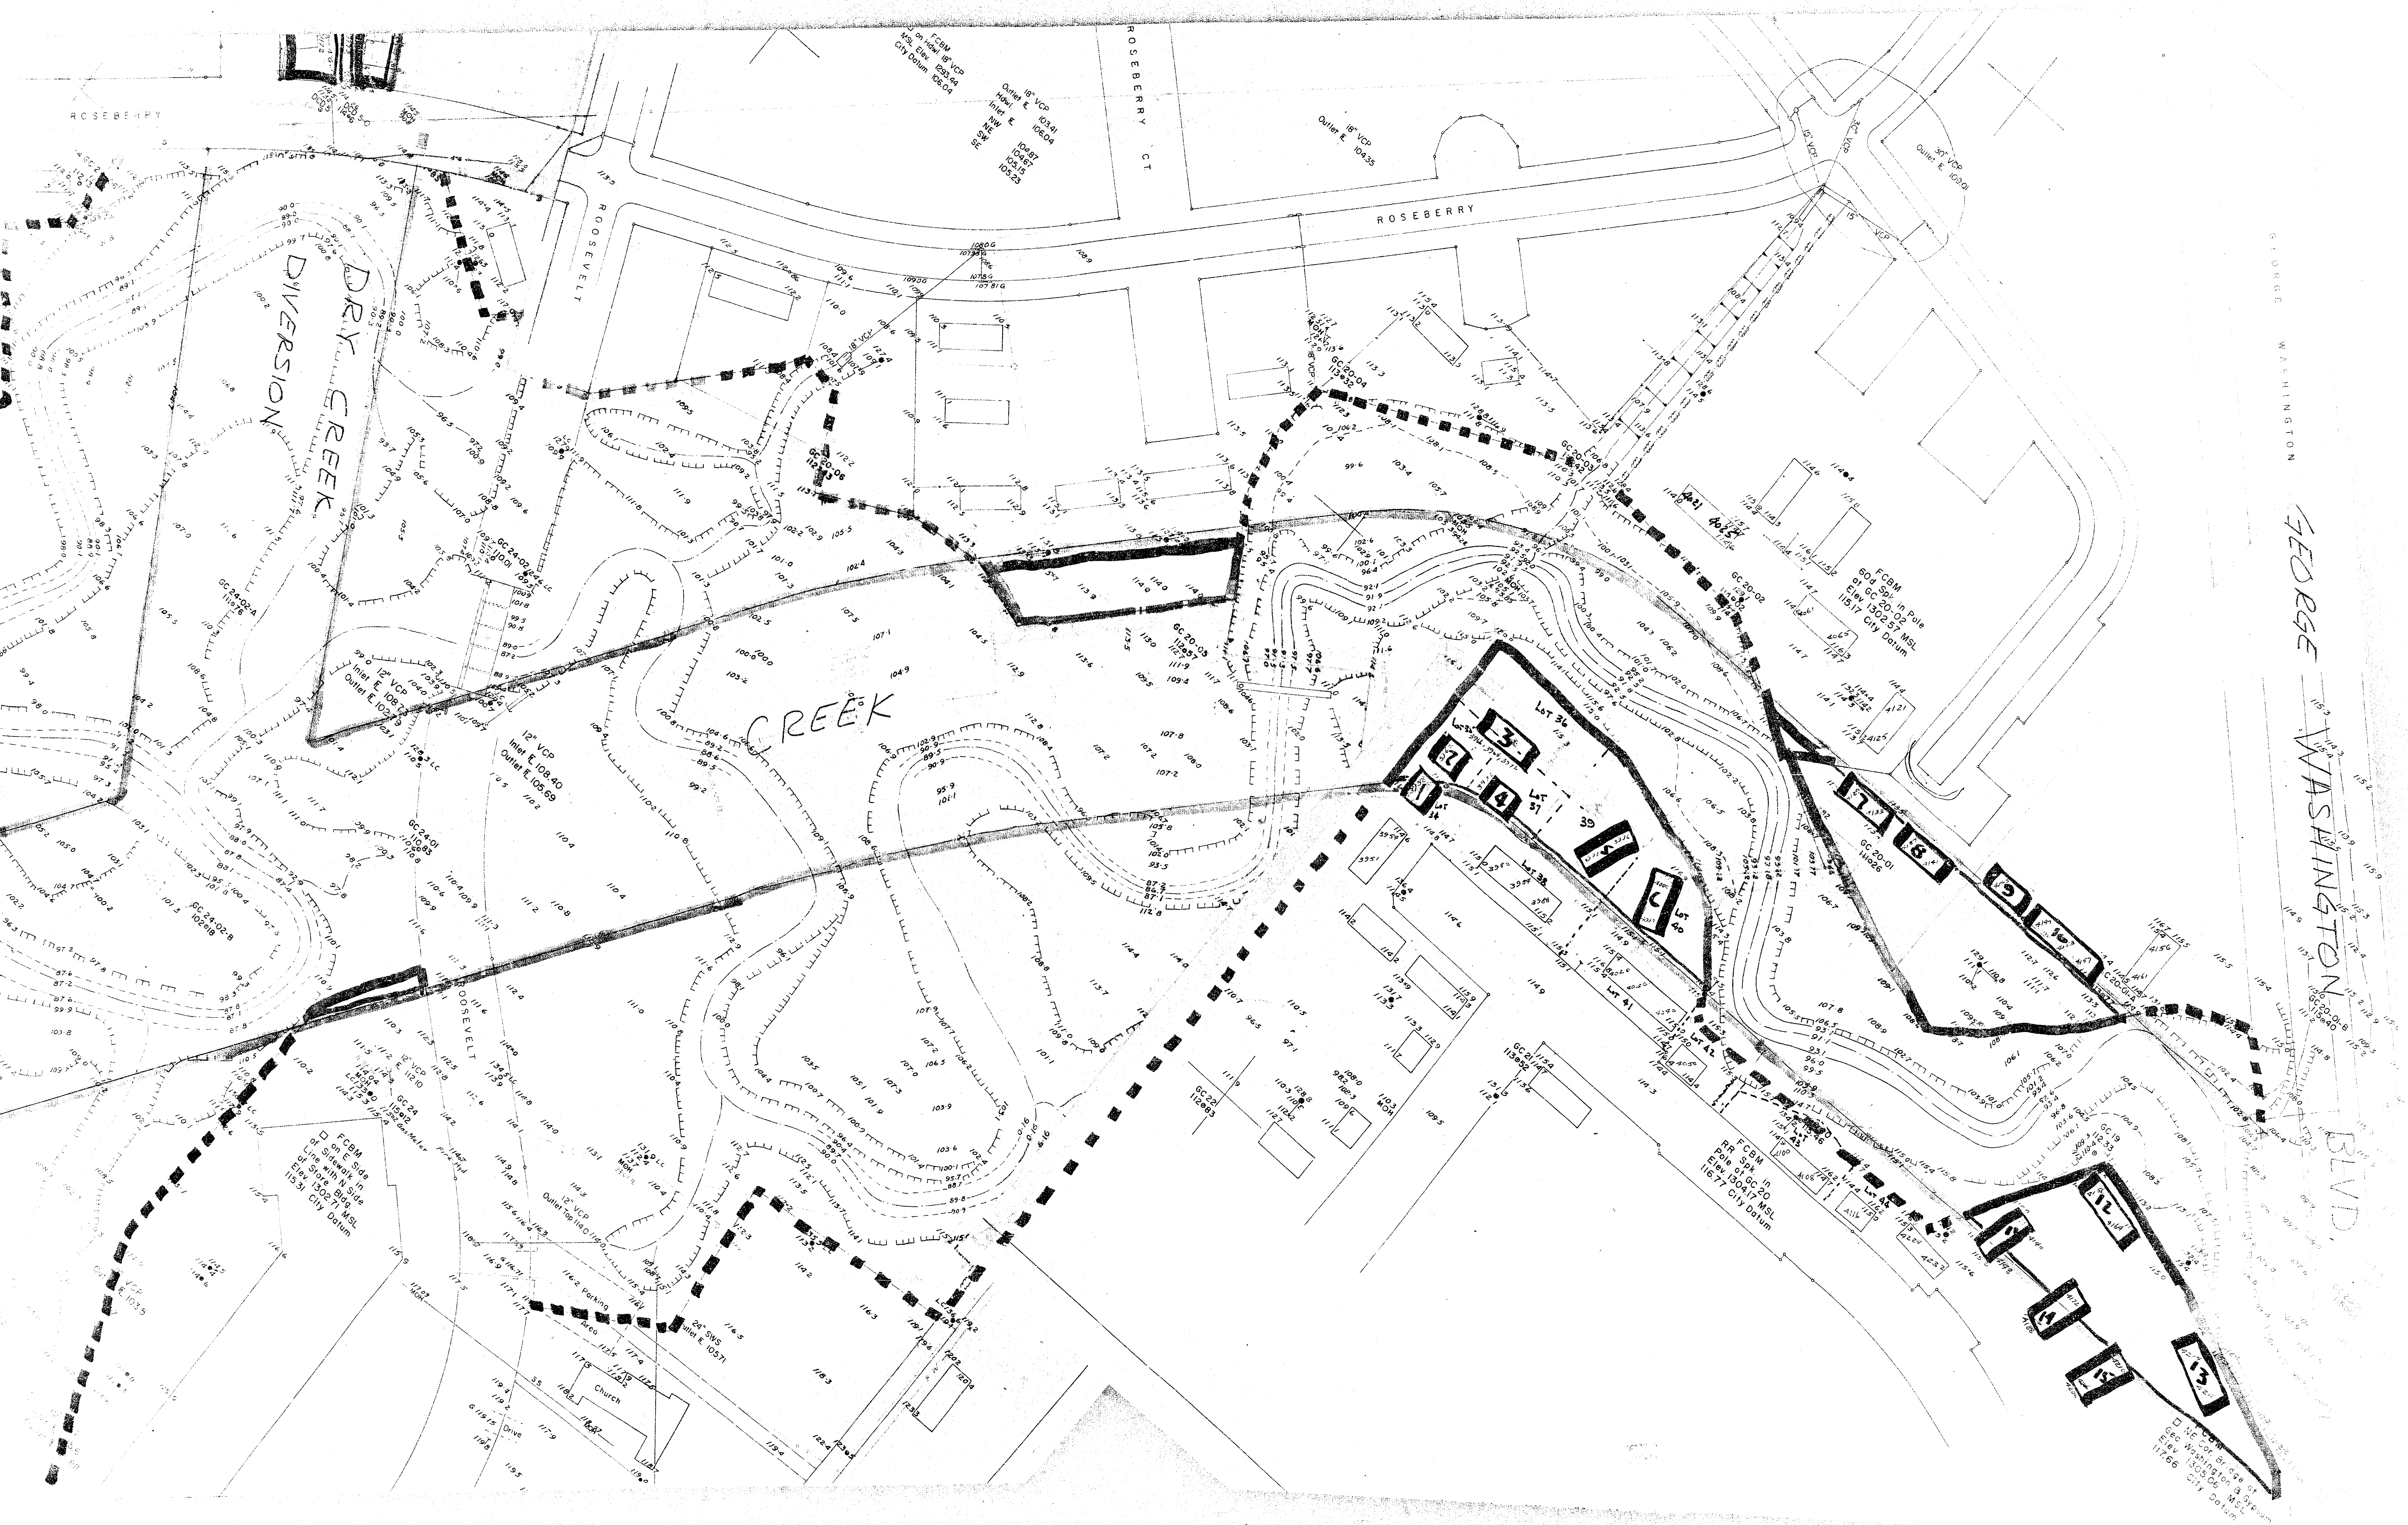

GEORGE WASHINGTON

GEORGE WASHINGTON BLVD

BLVD

