


PLAN  
 SHEET NO. 1  
 DATE

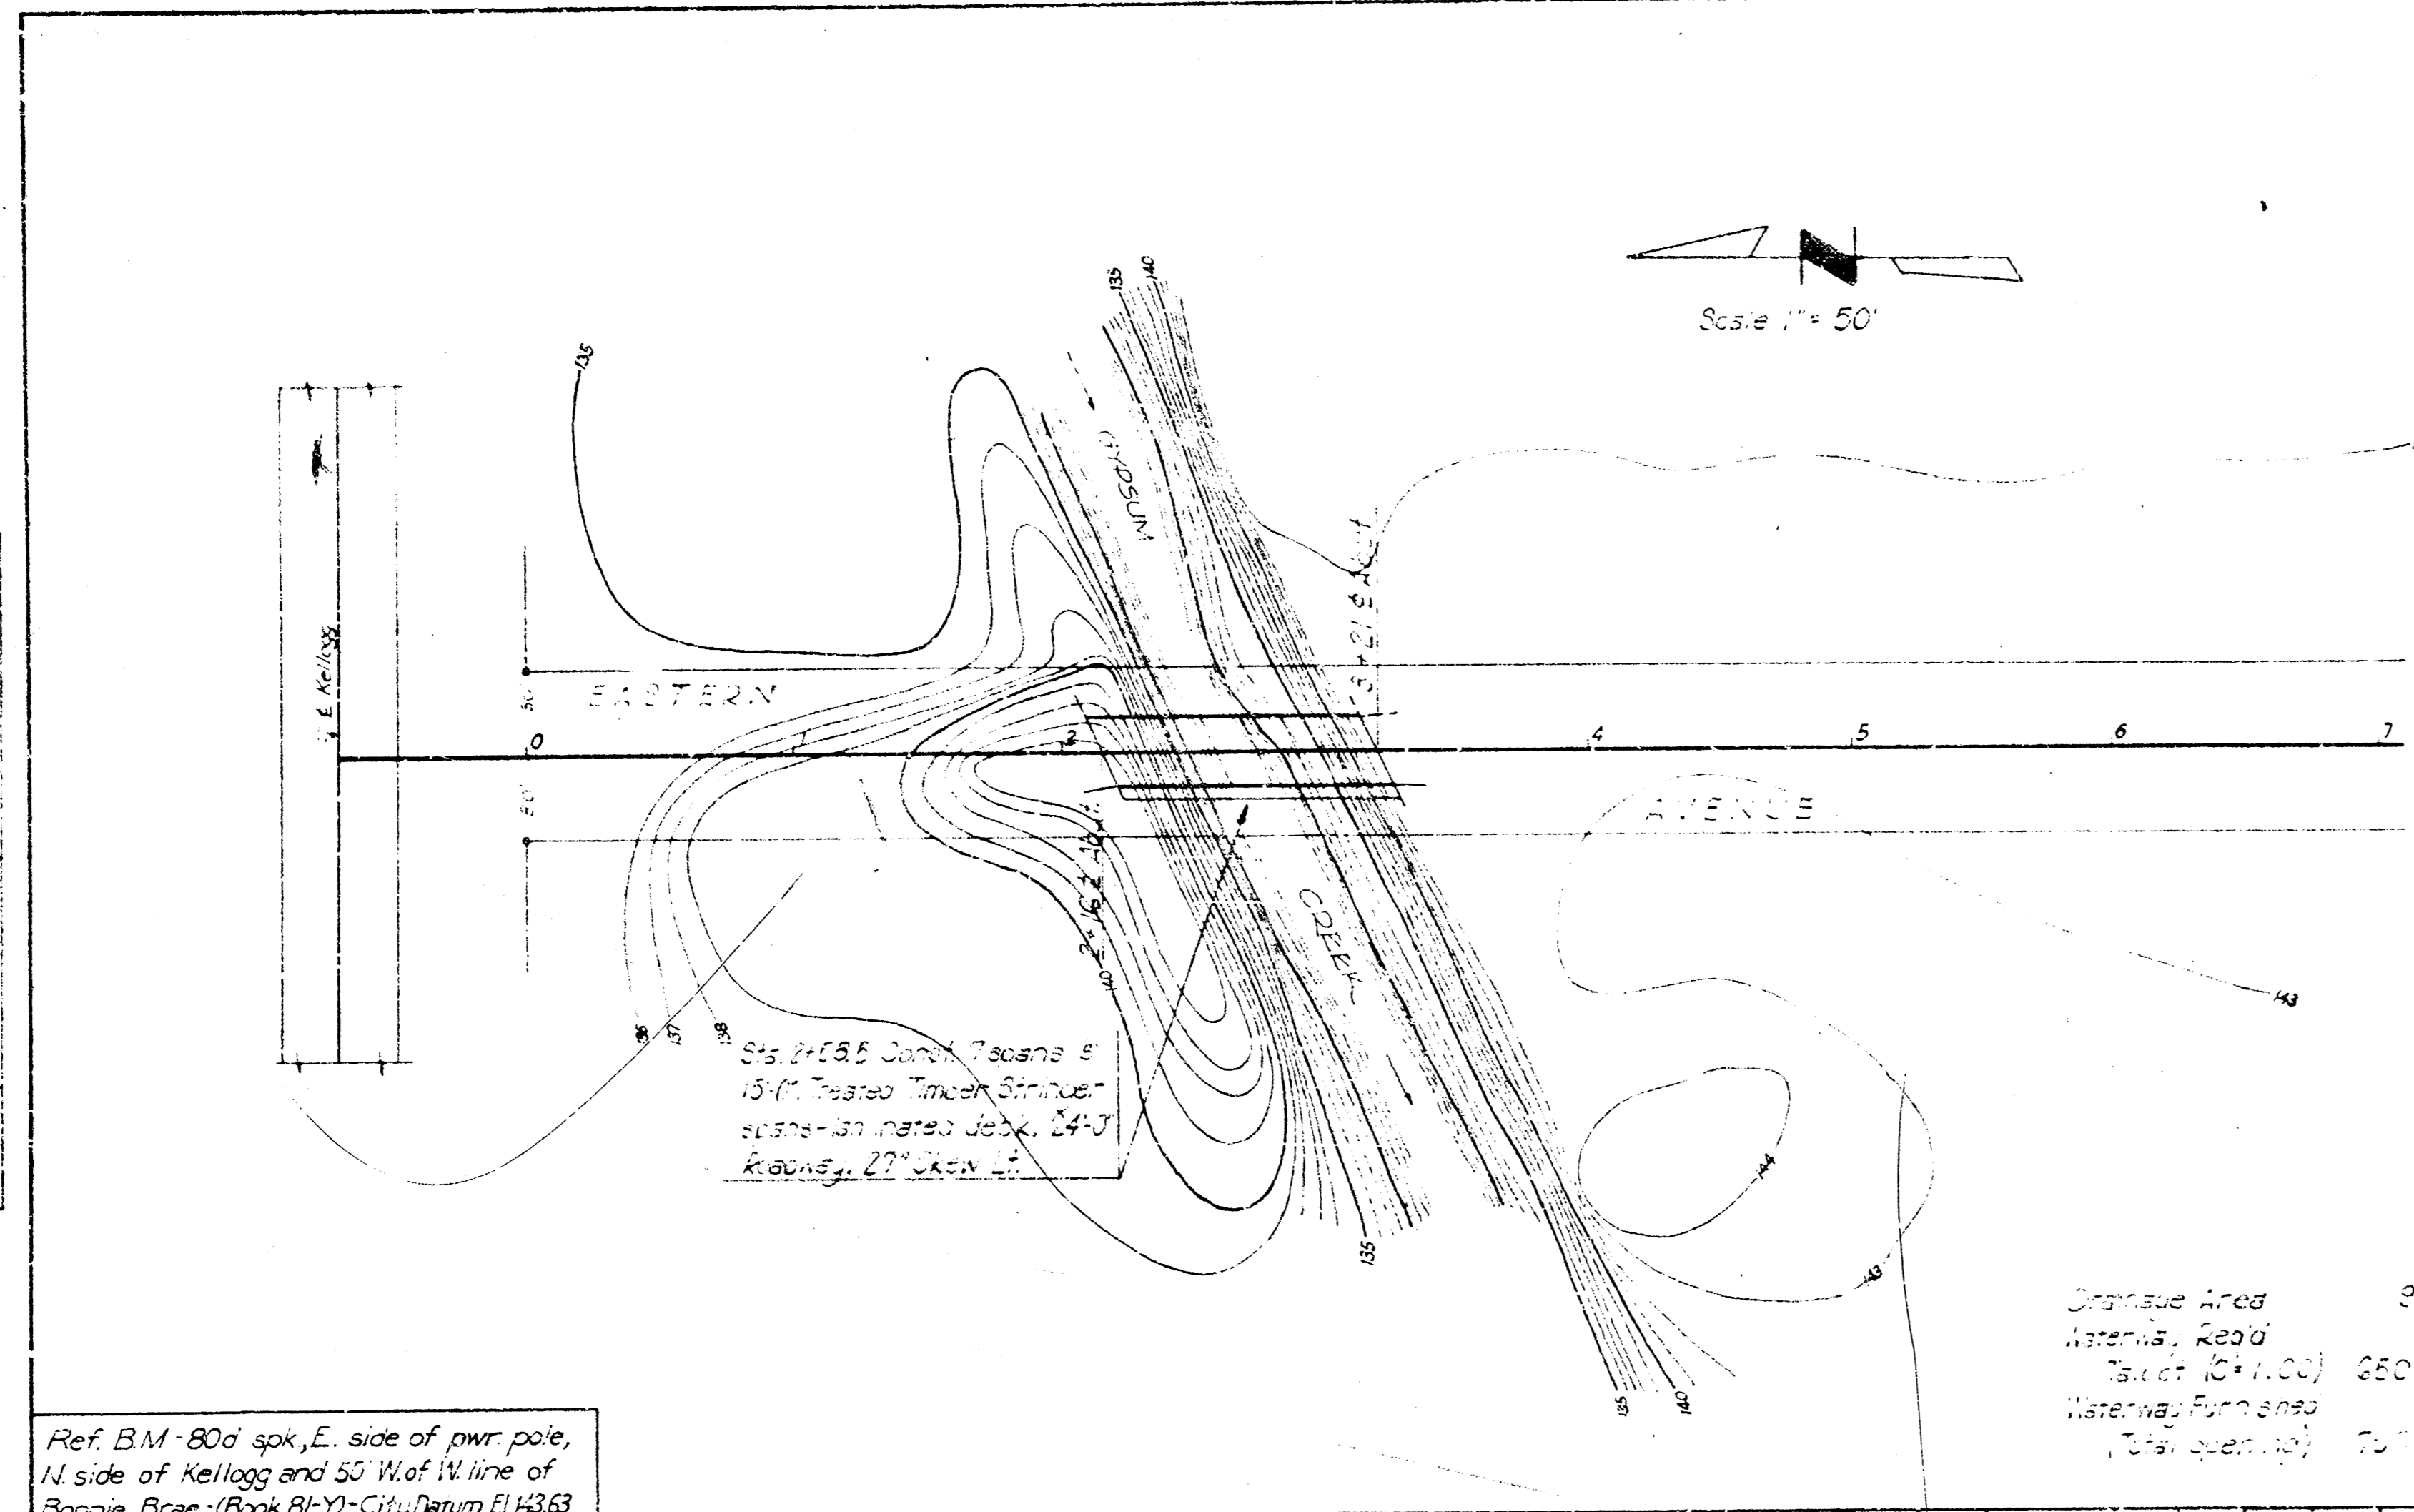

Station	1	2	3	4	5	6	7
1st Pier	1.32'	1.58'	1.23'	1.37'	1.44'	1.44'	1.38'
2nd Pier	1.31'	1.55'	1.58'	1.33'	1.40'	1.45'	1.32'
3rd Pier	1.32'	1.33'	1.28'	1.38'	1.41'	1.37'	1.33'
4th Pier	1.32'	1.37'	1.29'	1.43'	1.40'	1.37'	1.35'


PILE LENGTHS AS DRIVEN


BRIDGE FOR WM. LEVITT  
 WICHITA, KANSAS  
 CONTOUR MAP & PROFILE



 CONSULTING ENGINEER  
 WICHITA, KANSAS  
 (CONSTRUCTED - DECEMBER, 1954)


PROFILE  
 SHEET NO. 2  
 DATE

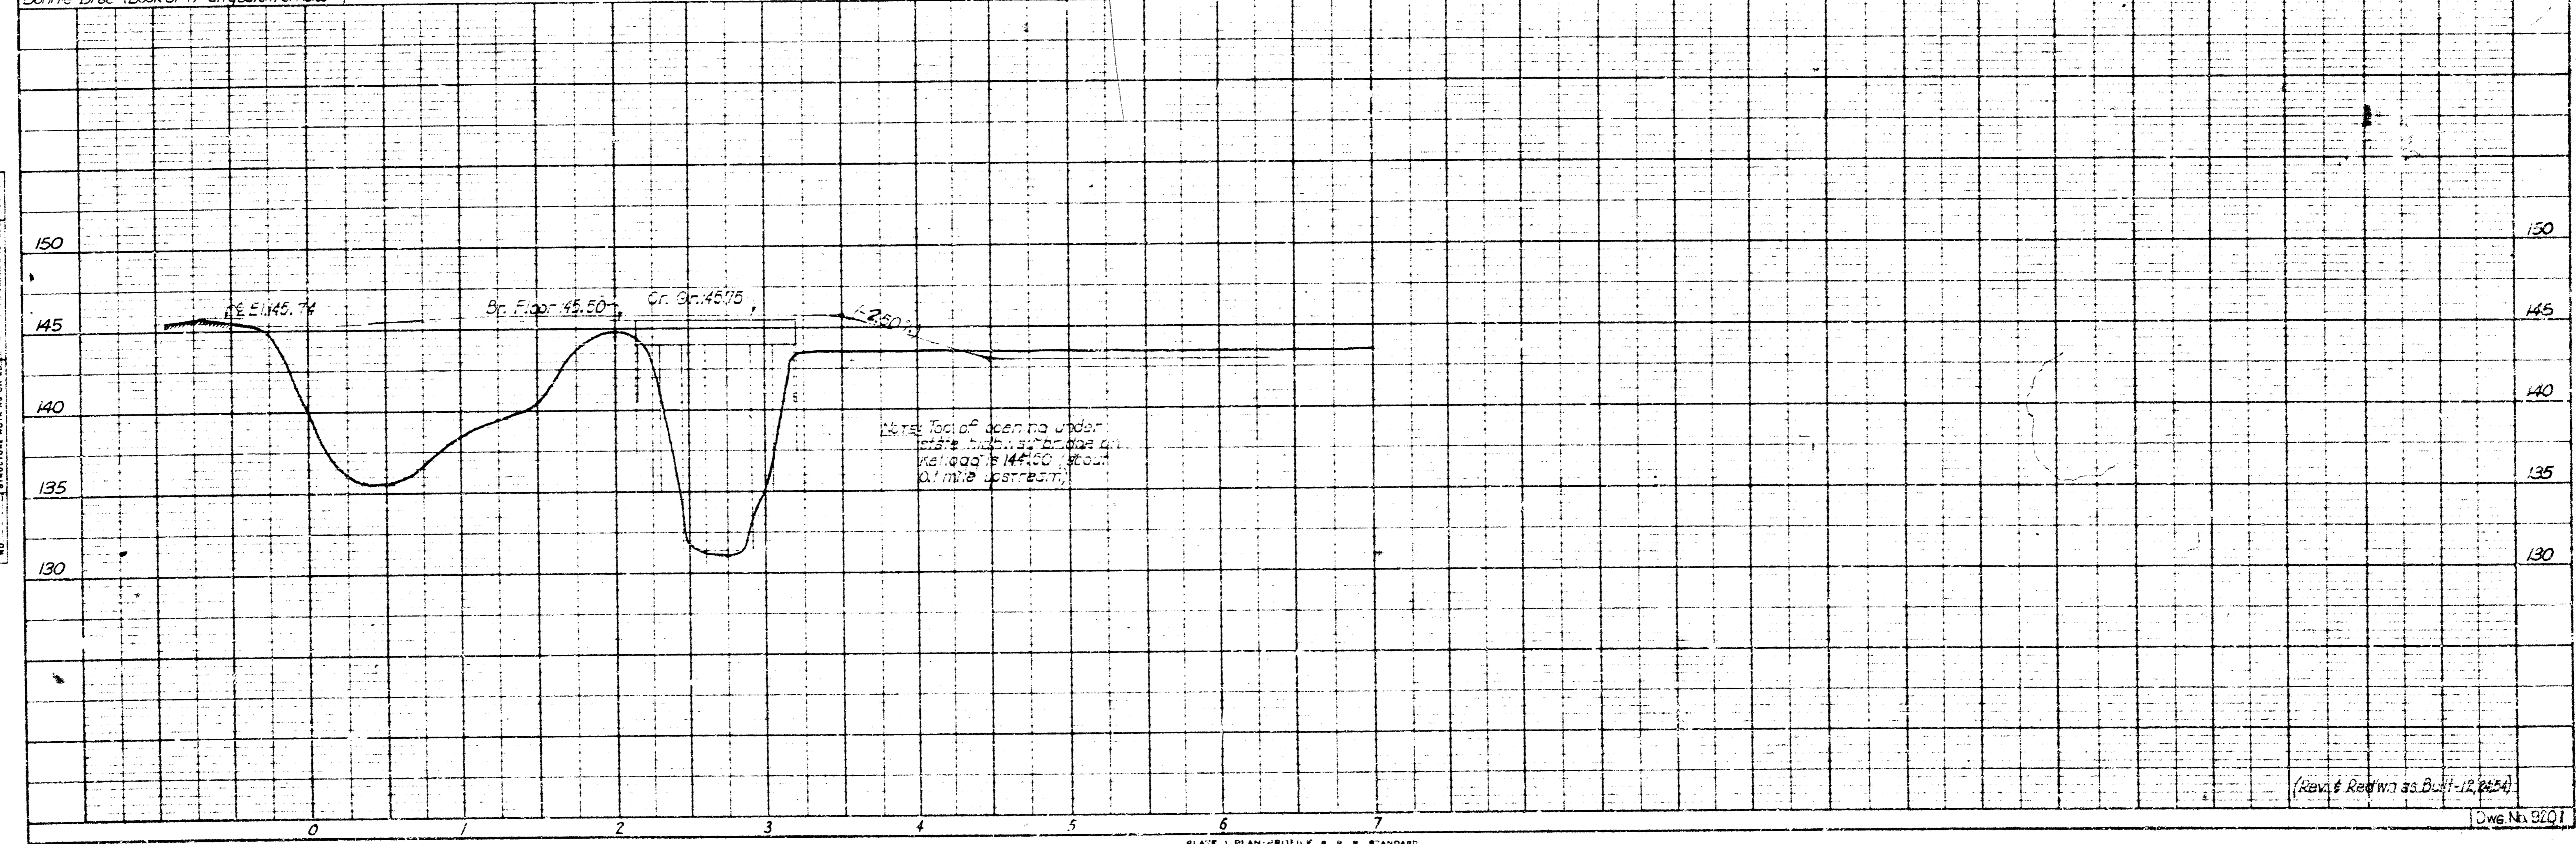

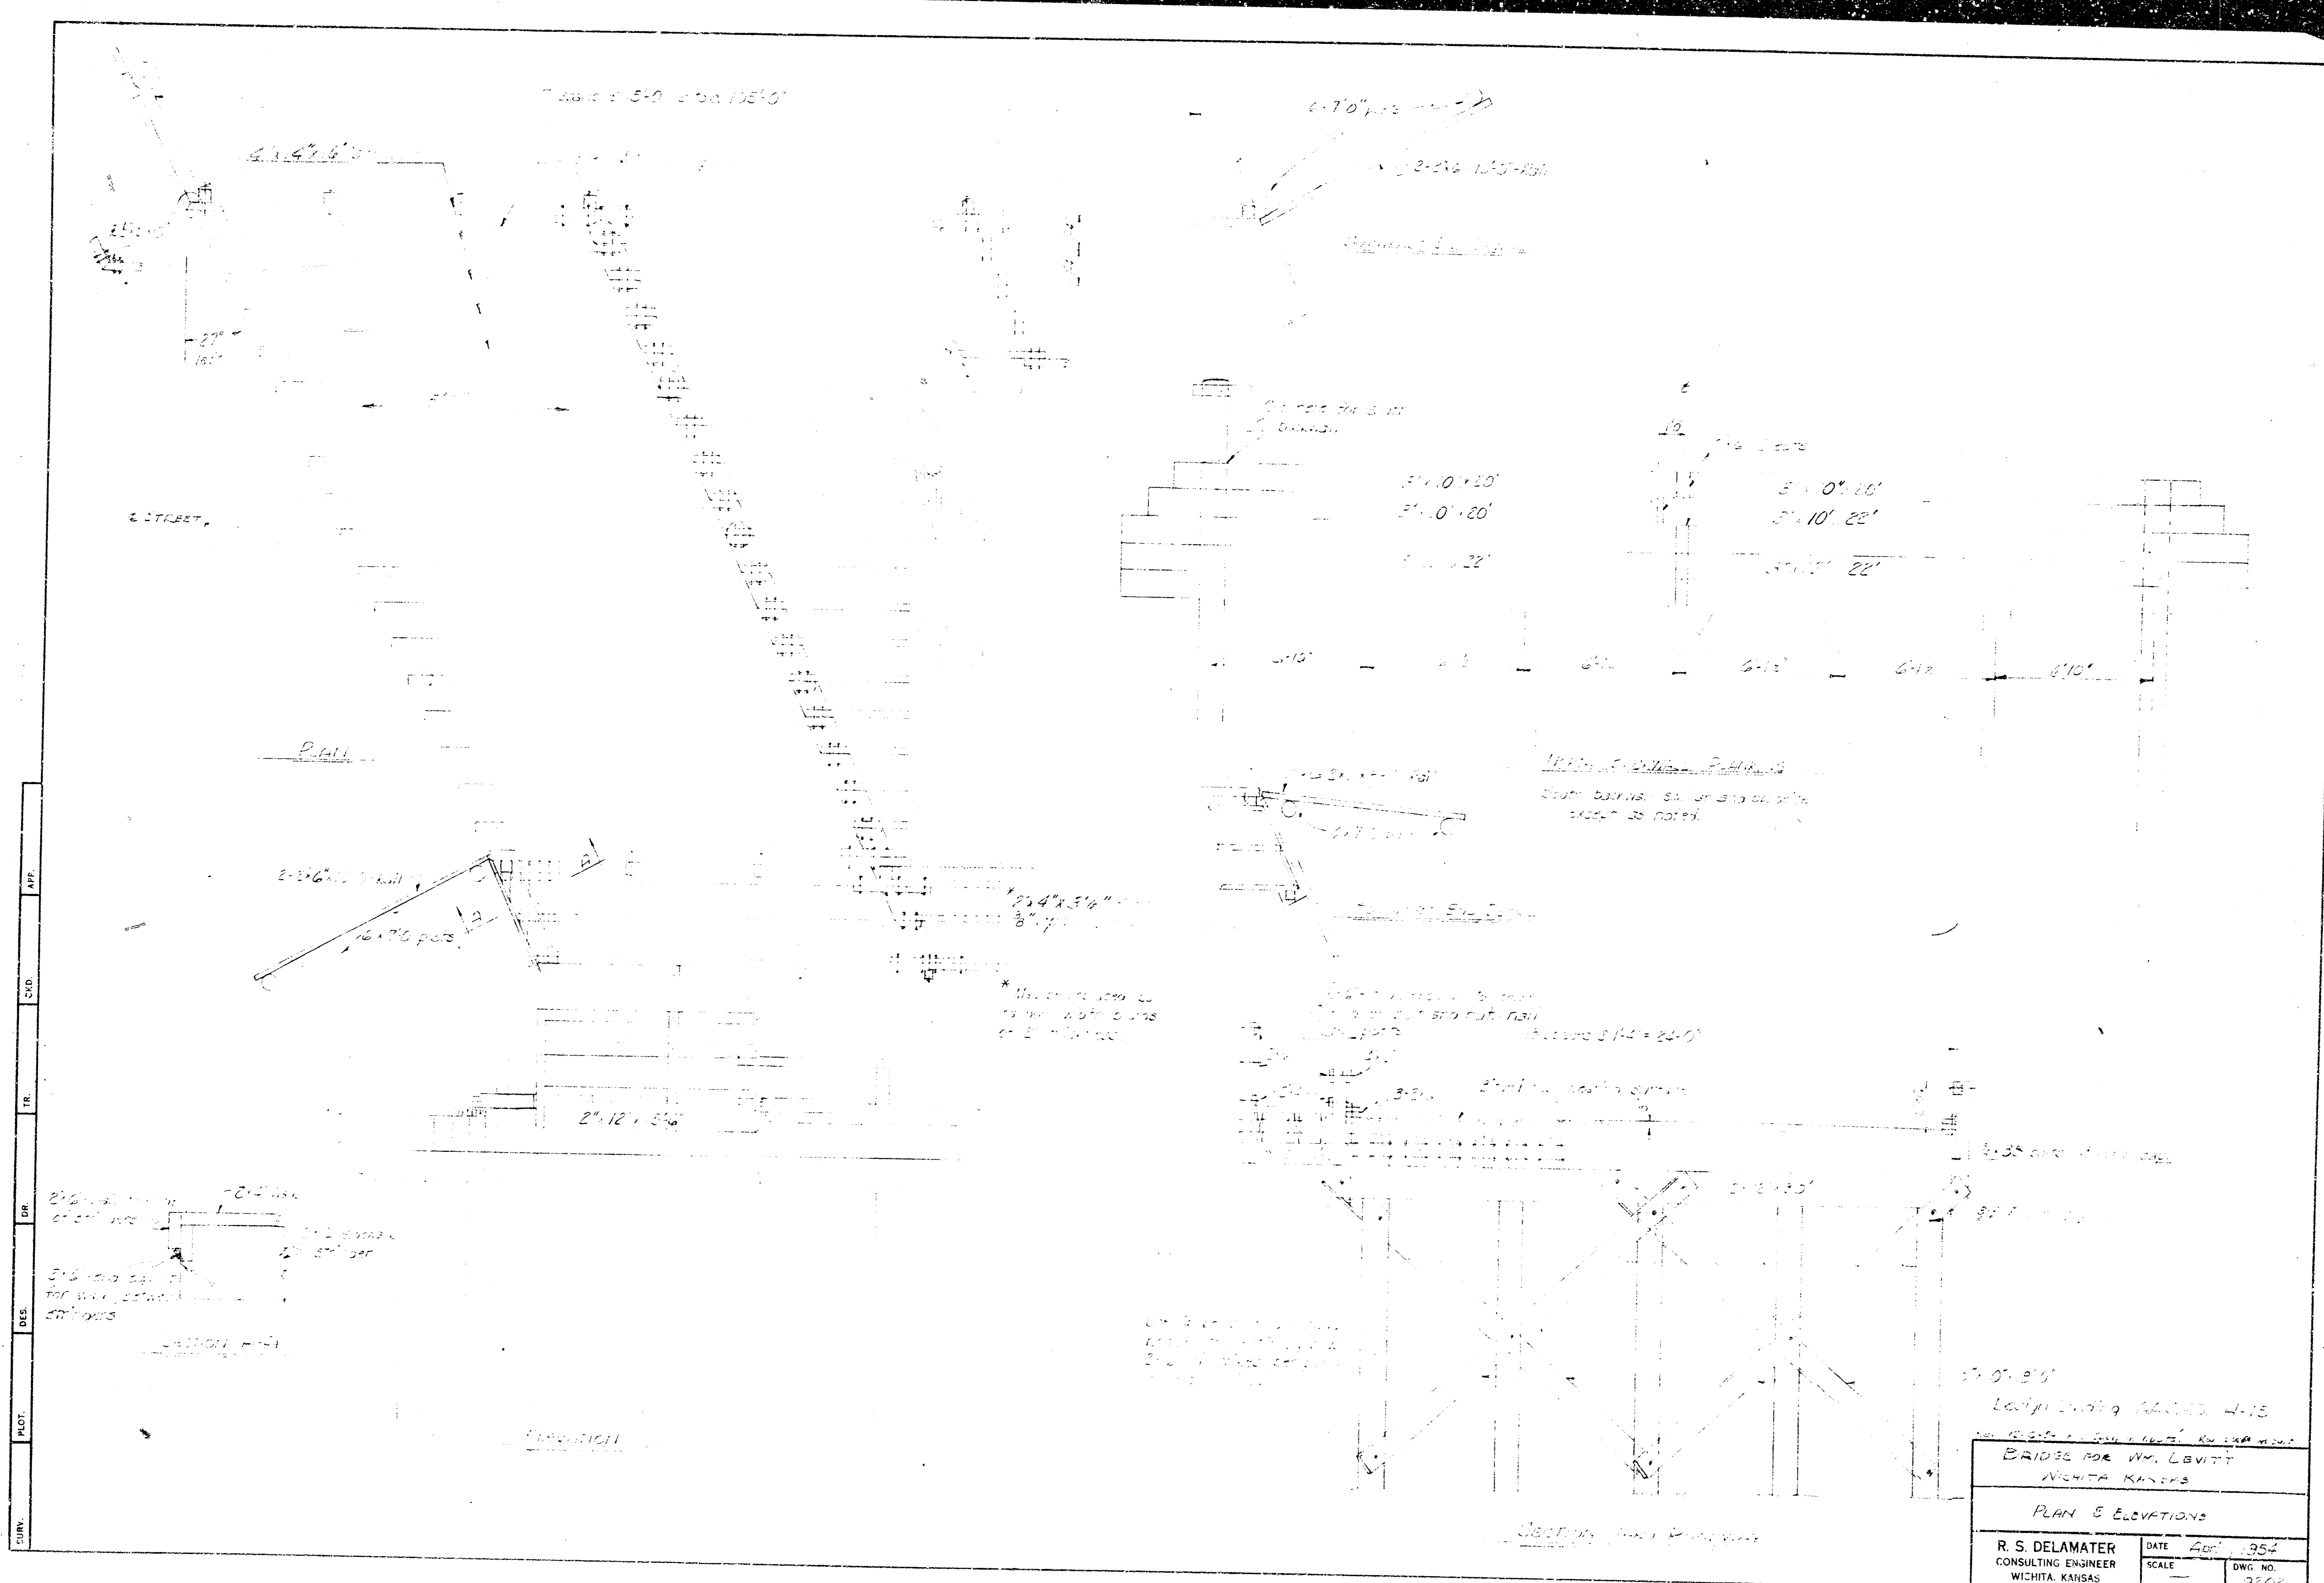


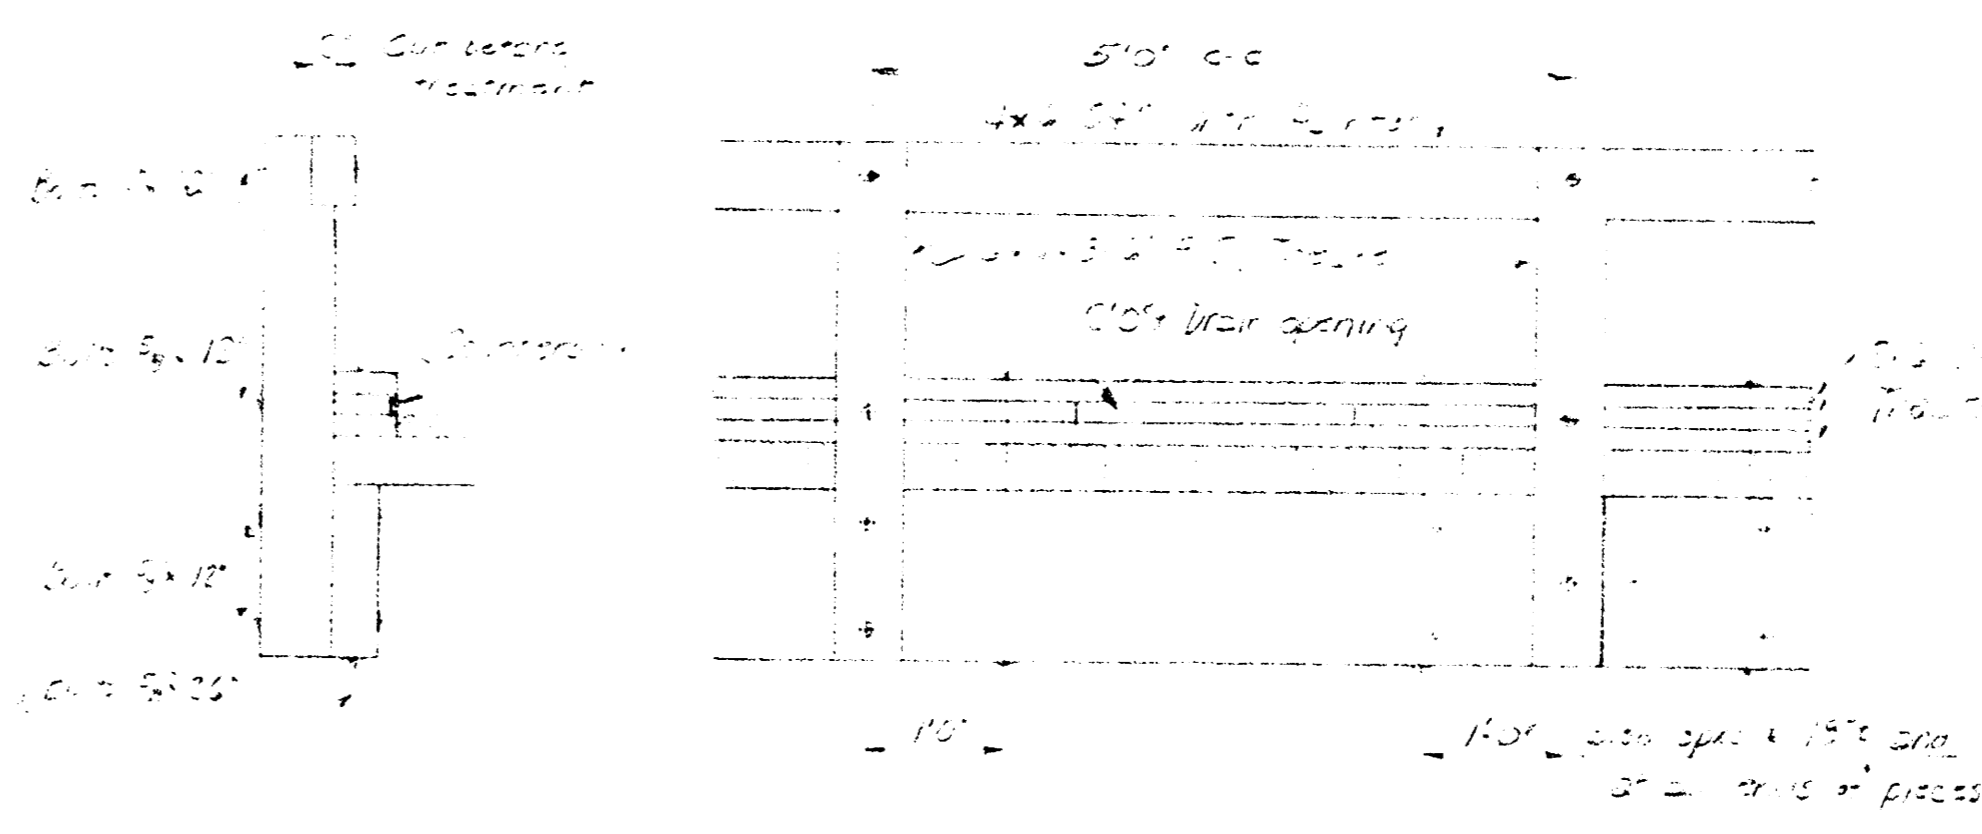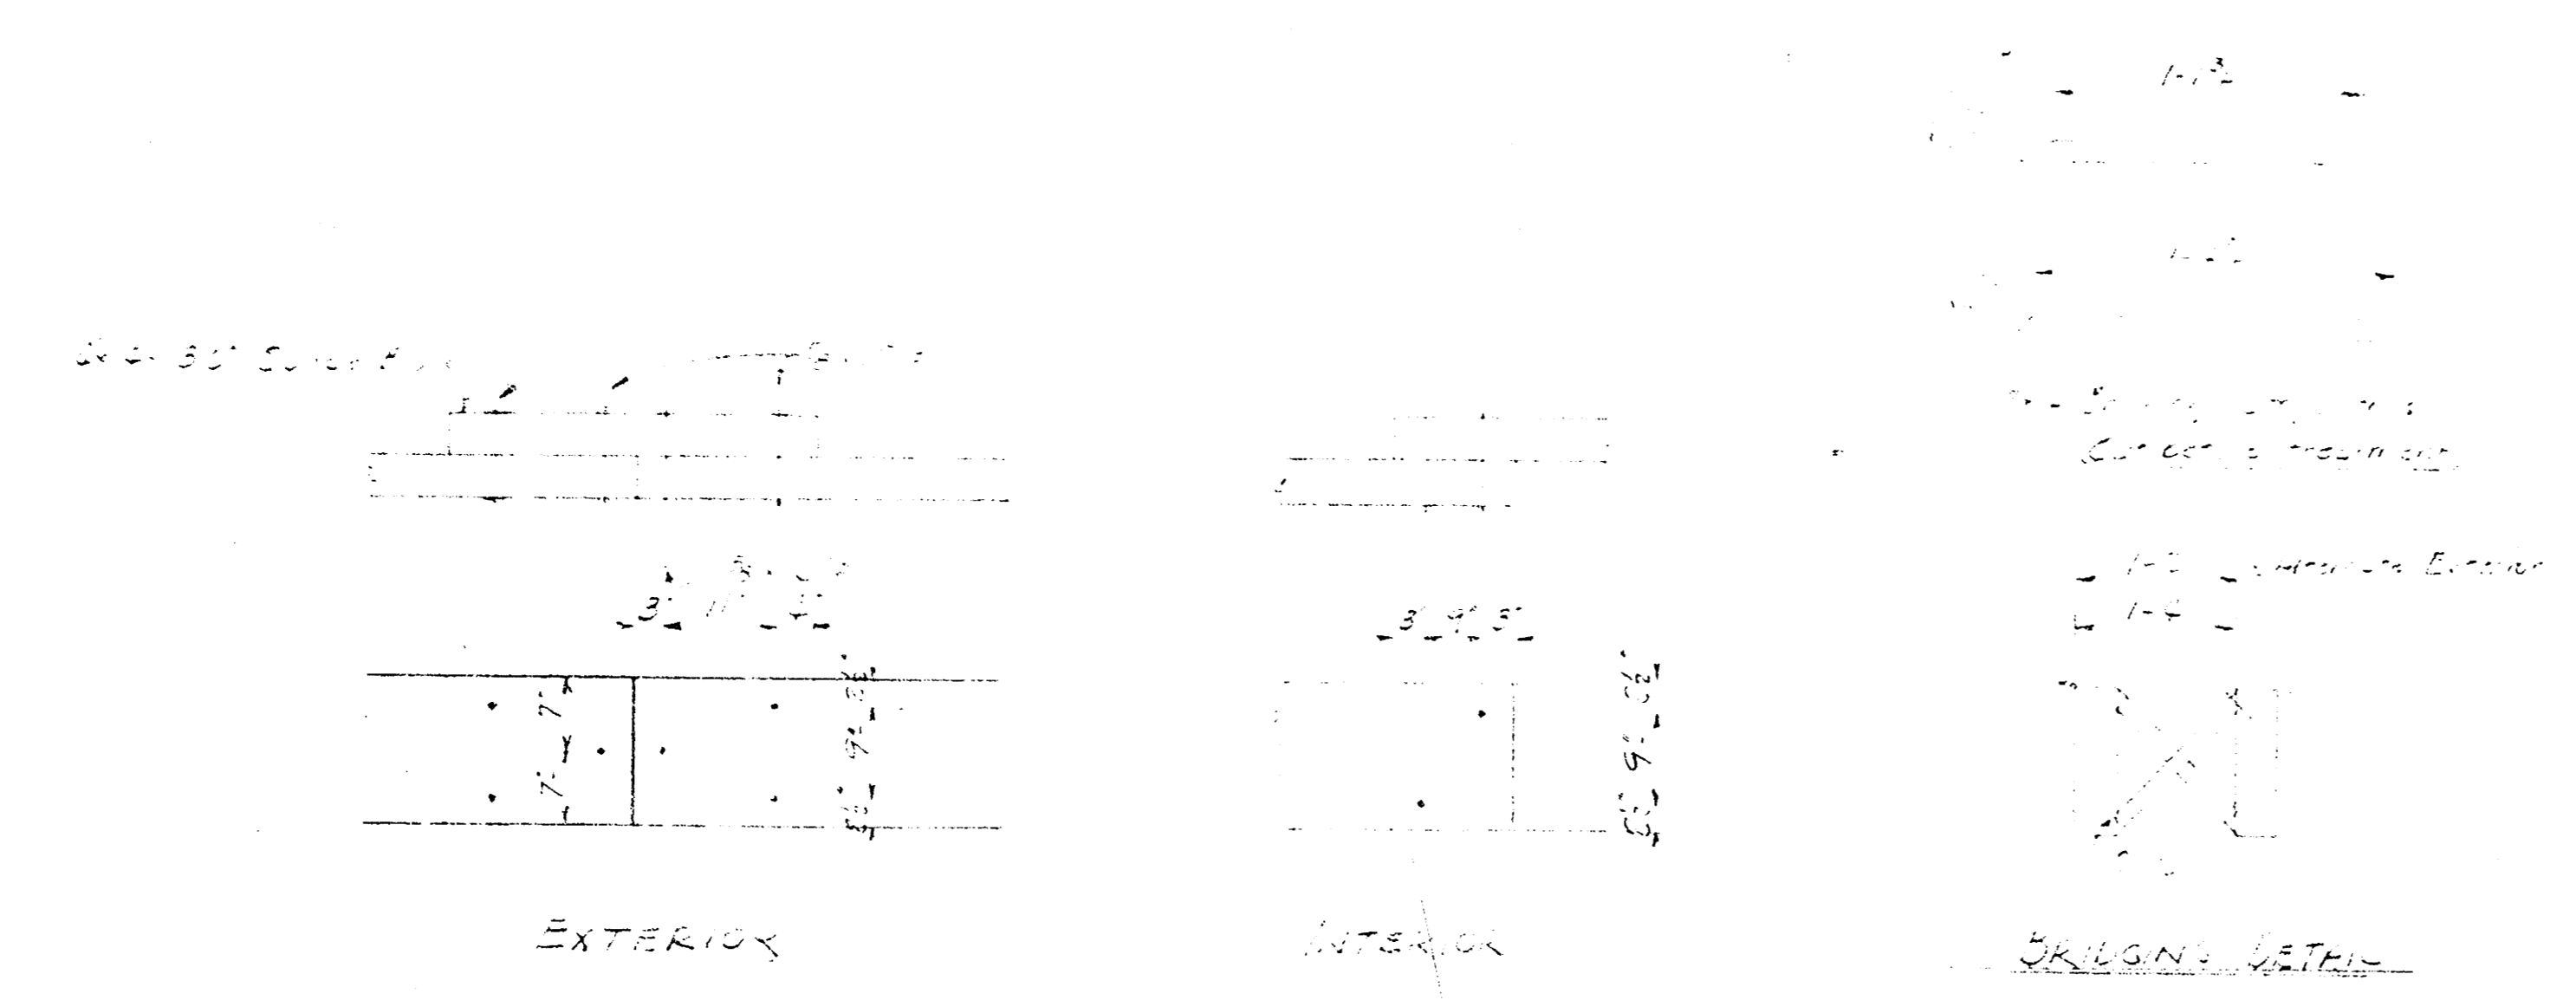

Guardrail Splice  
 Splice to next beam  
 Splice to next beam

Use 2x4 boards, 20' long with 20d nails to attach to stringers, staggered with board to board. Nail boards to water table every 18" and staggered board to board.


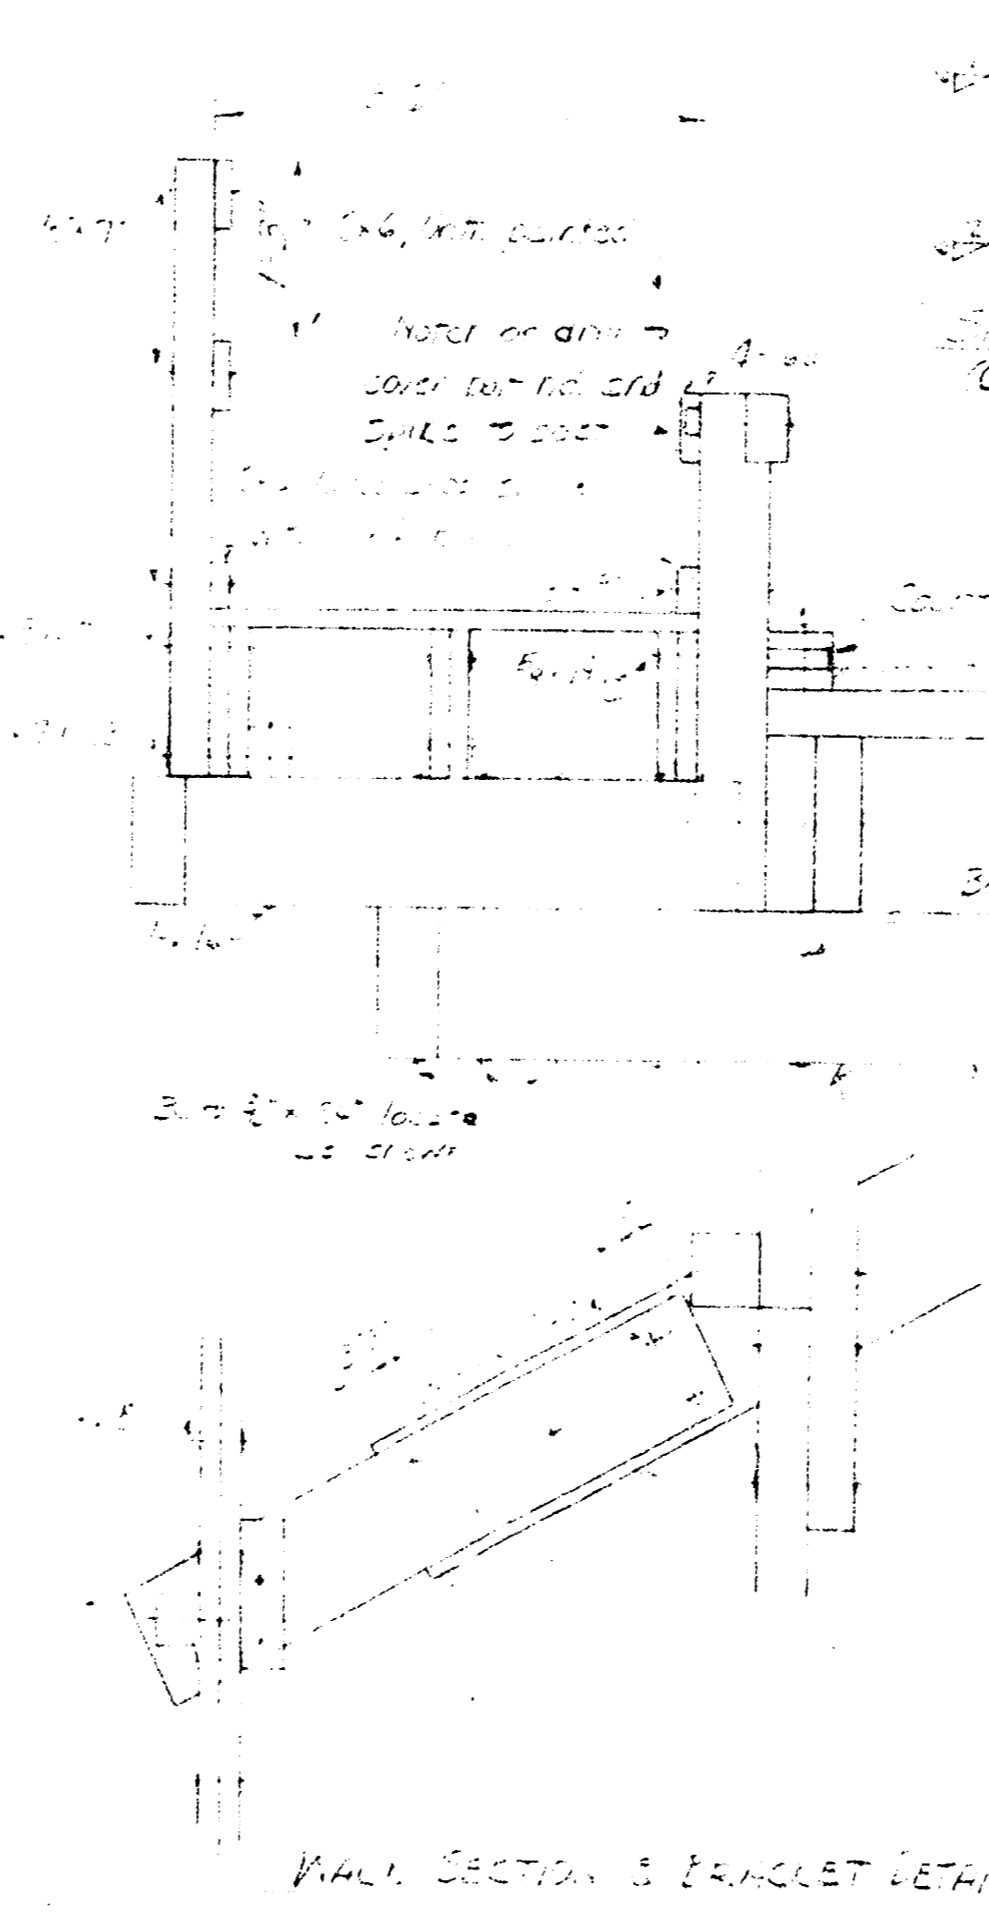



Summary of Quantities


BRIDGE FOR MR. LEVITT  
 WICHITA, KANSAS

MISCELLANEOUS DETAILS

R. S. DELAMATER  
 CONSULTING ENGINEER  
 WICHITA, KANSAS

DATE: APRIL, 1954  
 SCALE: 3/4" = 1'-0"  
 DWG. NO.: 9203