
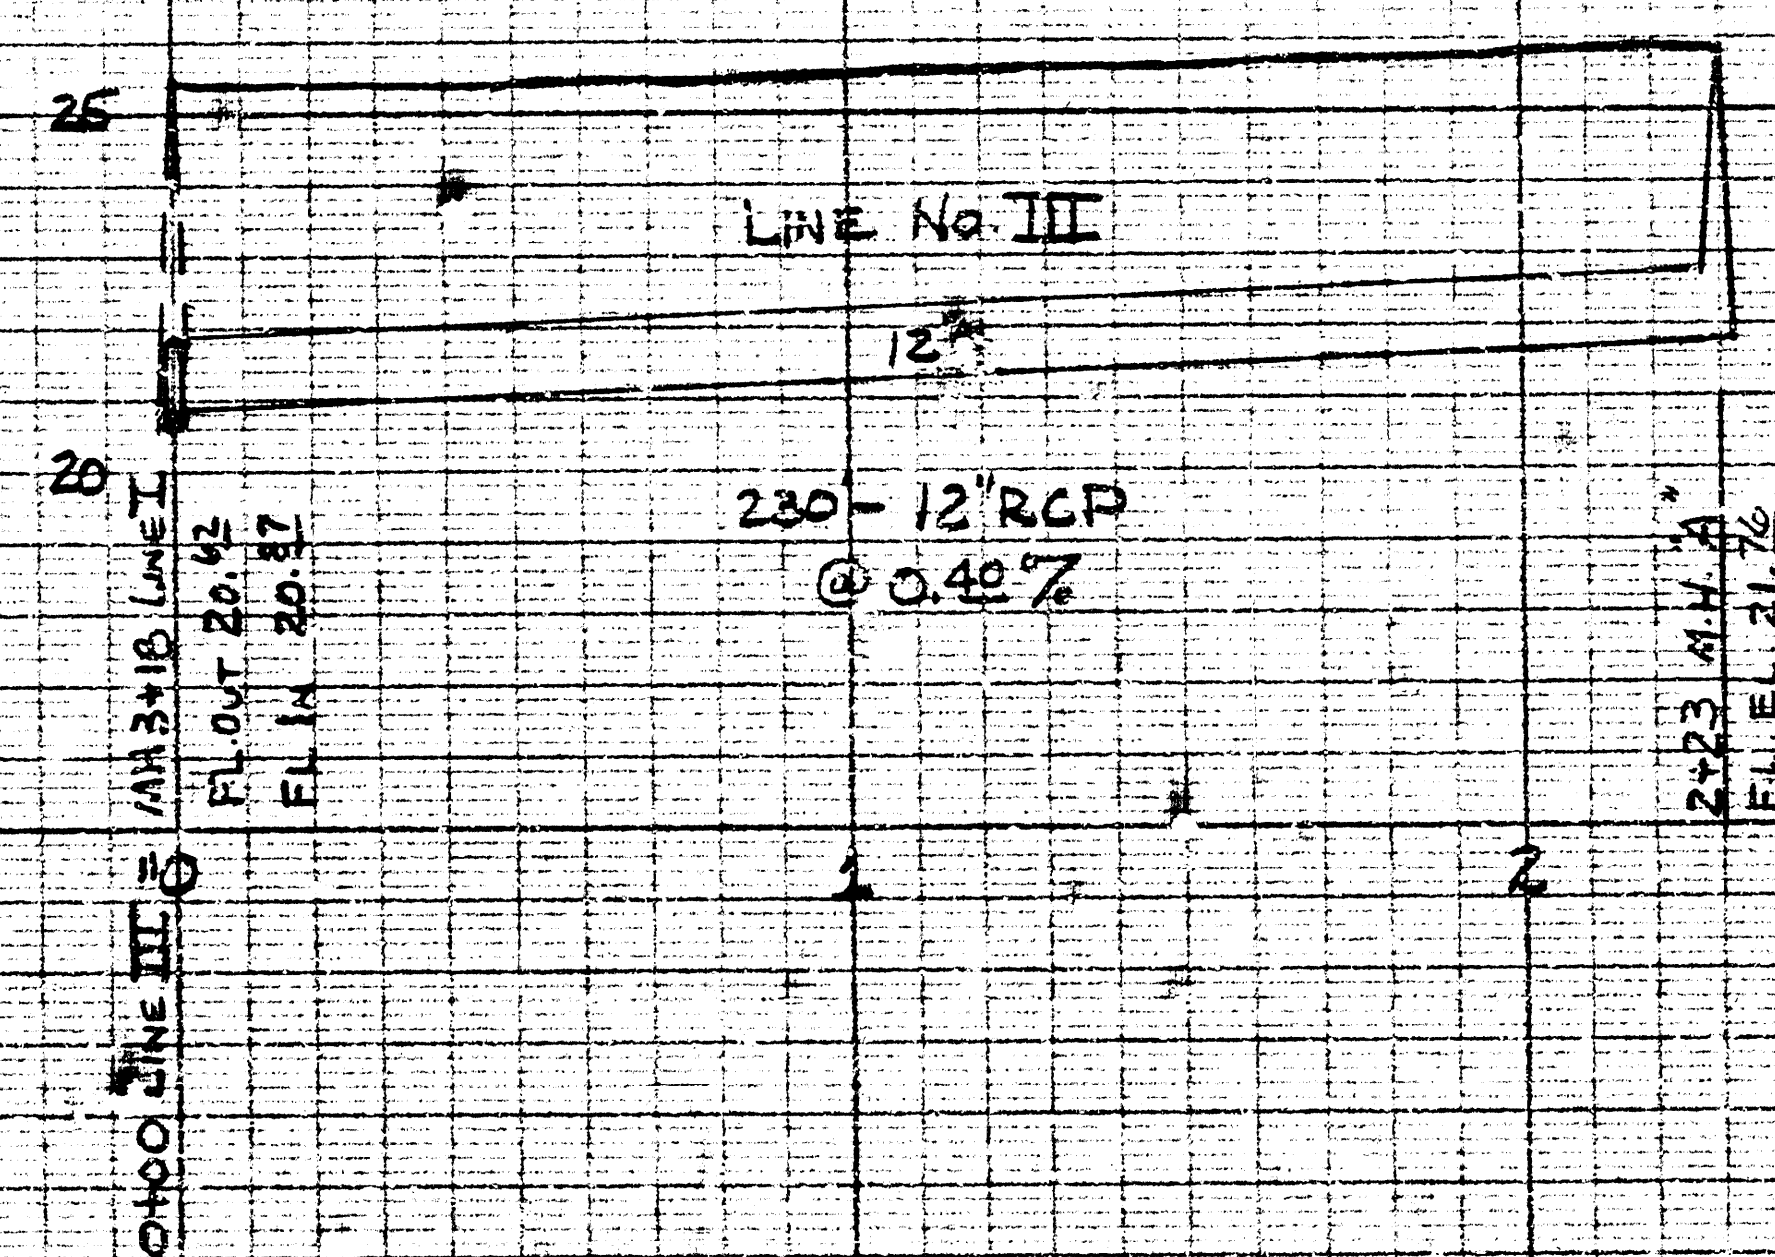
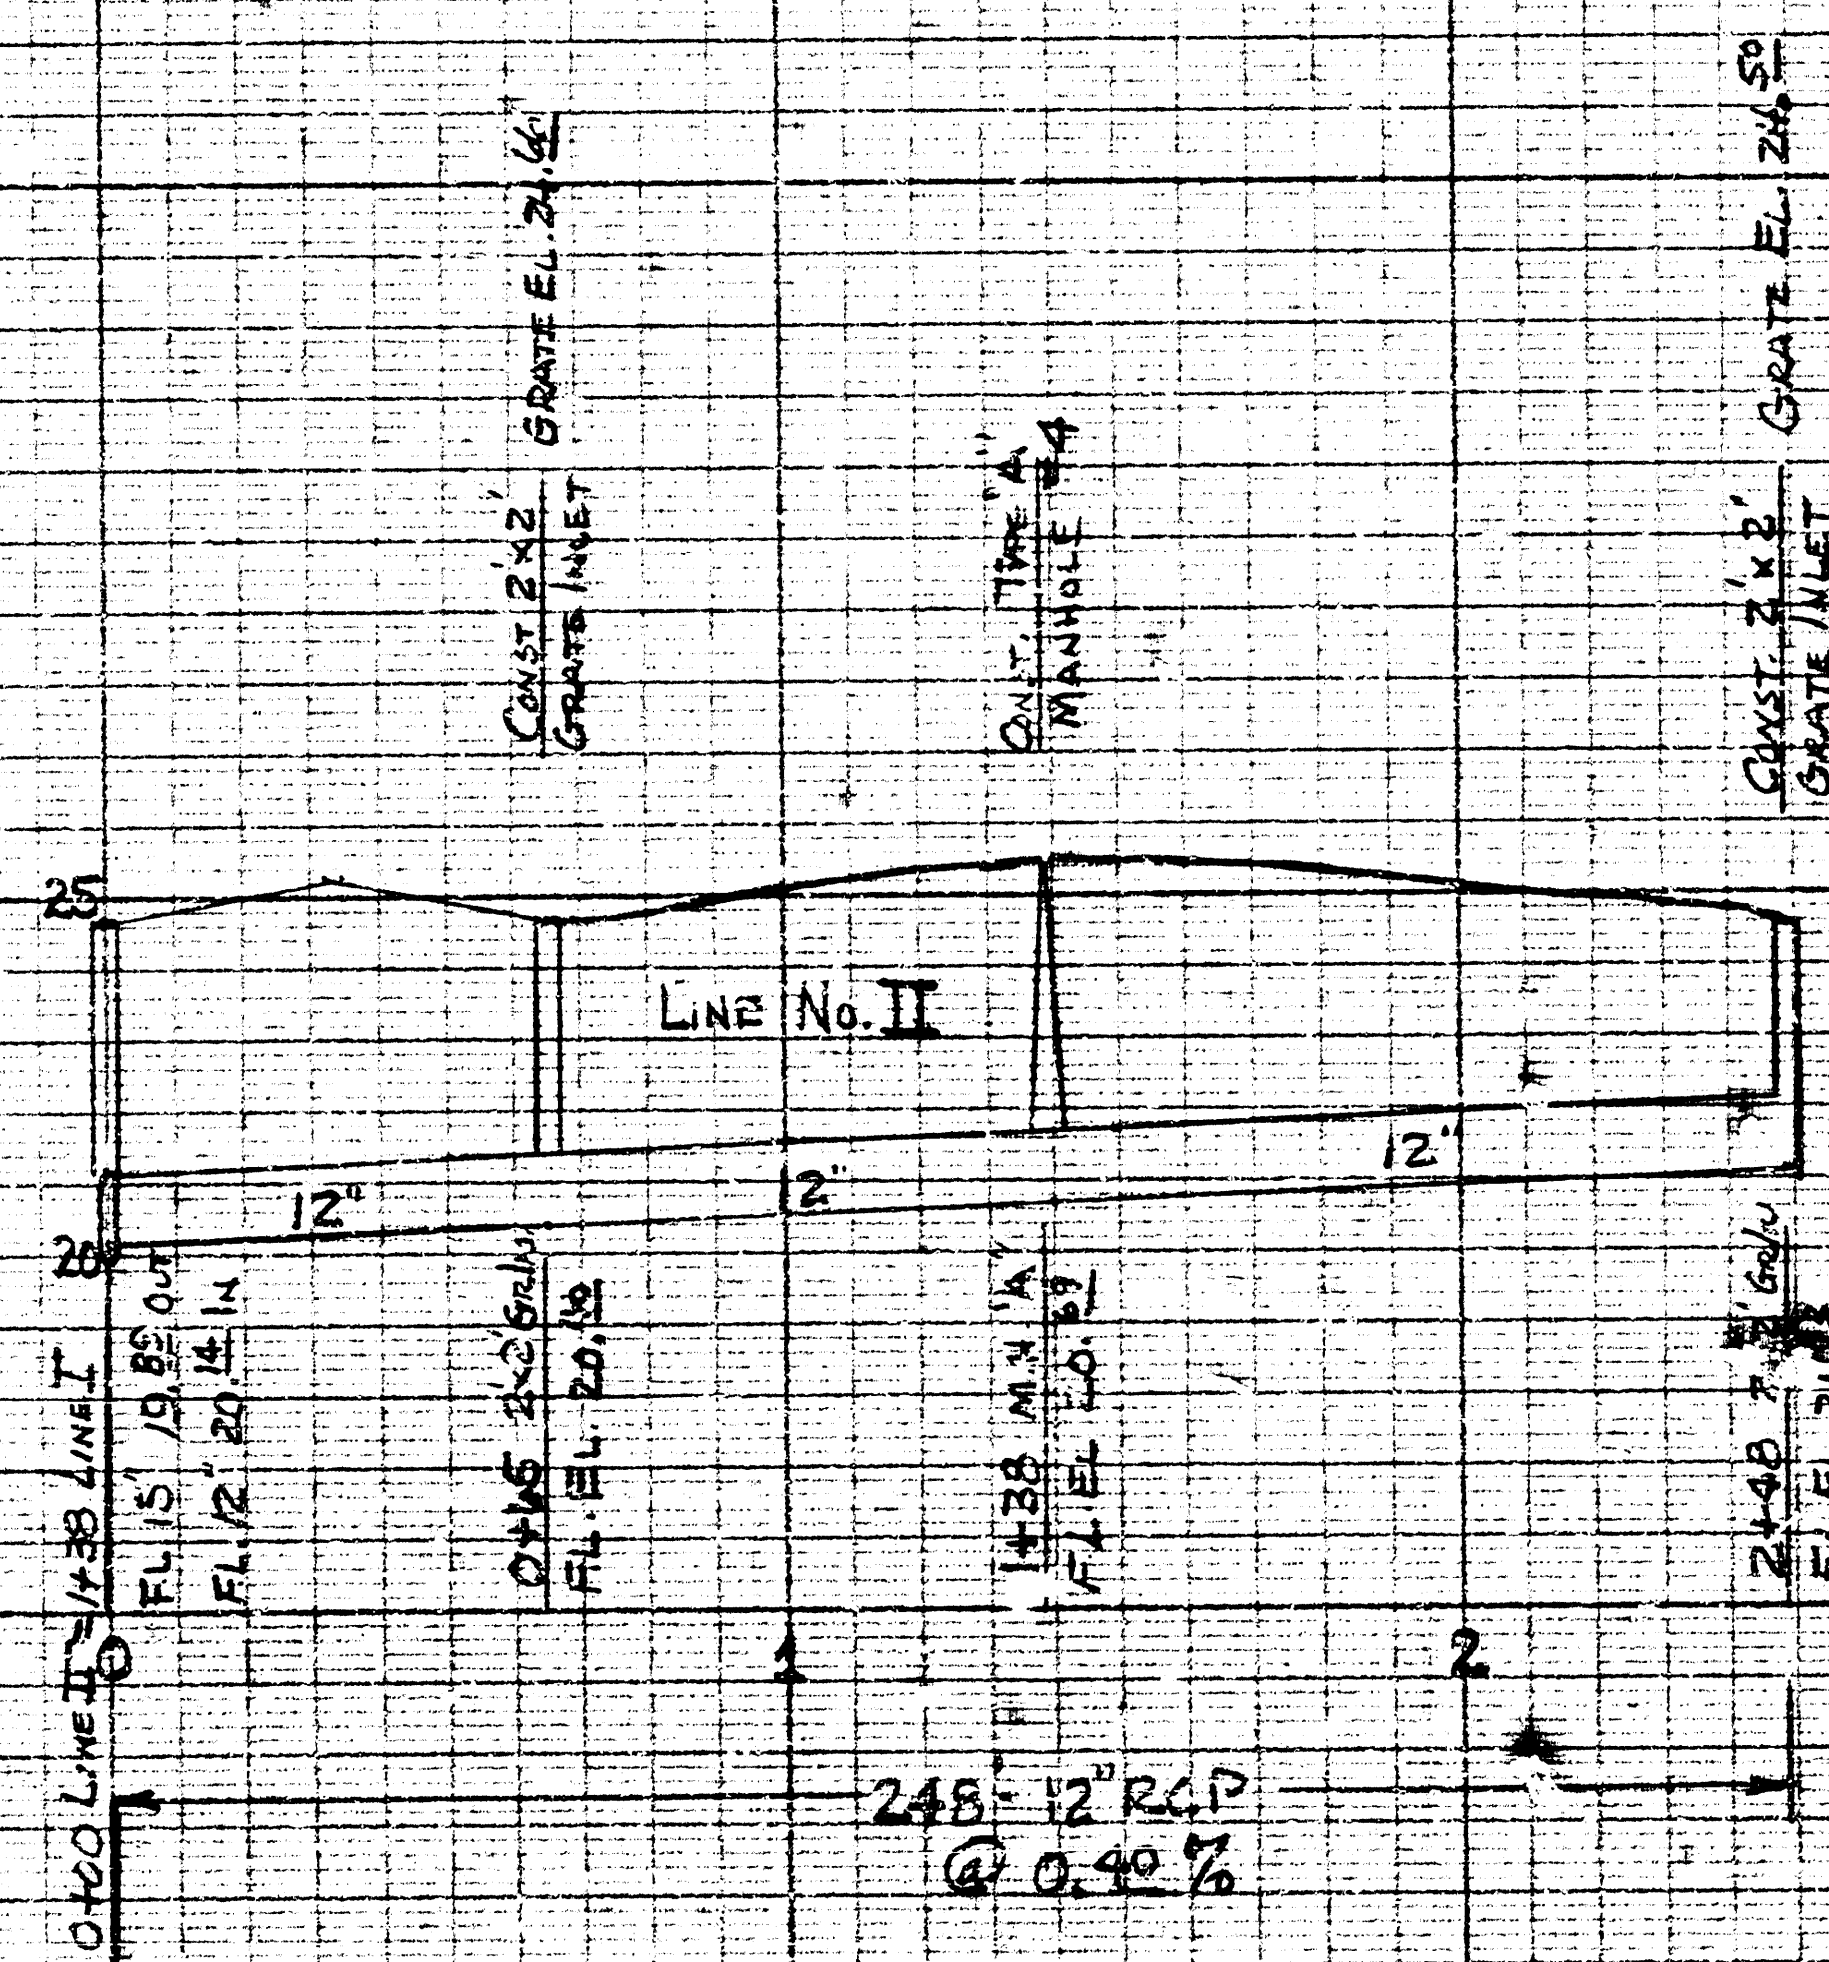


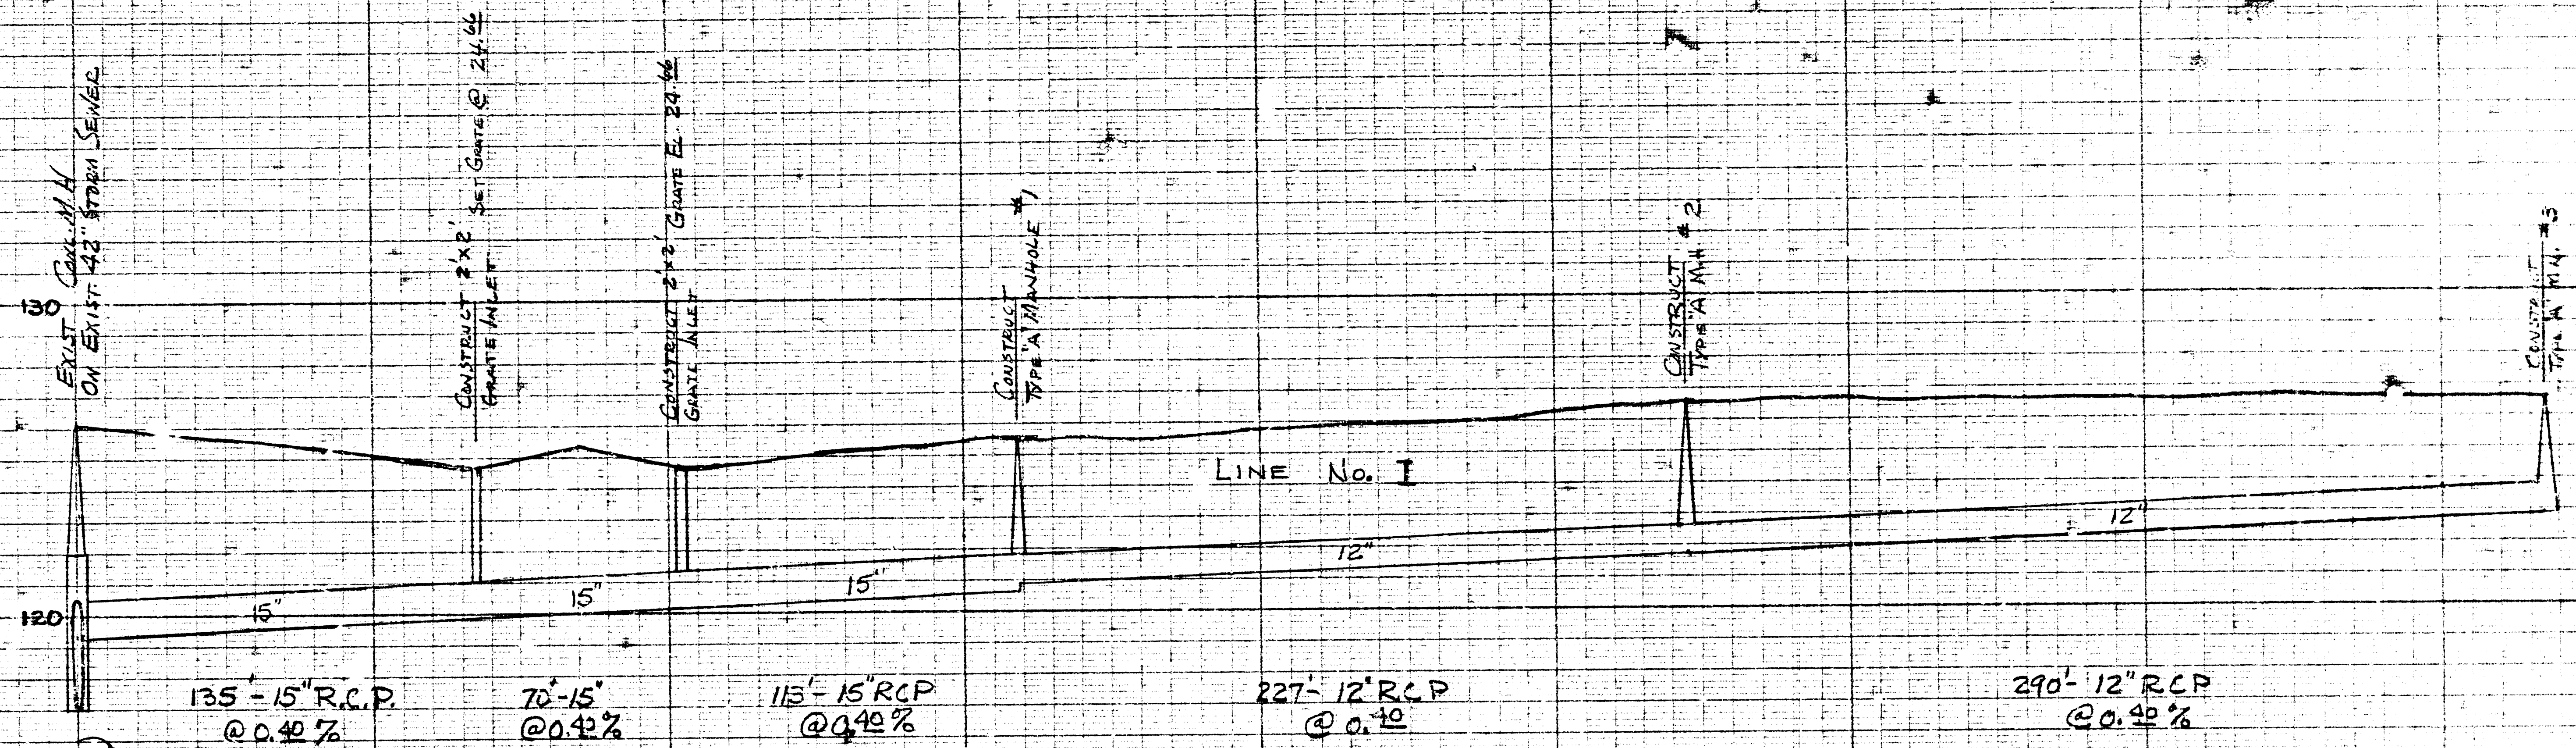


STORM SEWER PROFILES
DOLD PACKING
SEPT. 1973 - WICHITA, KS





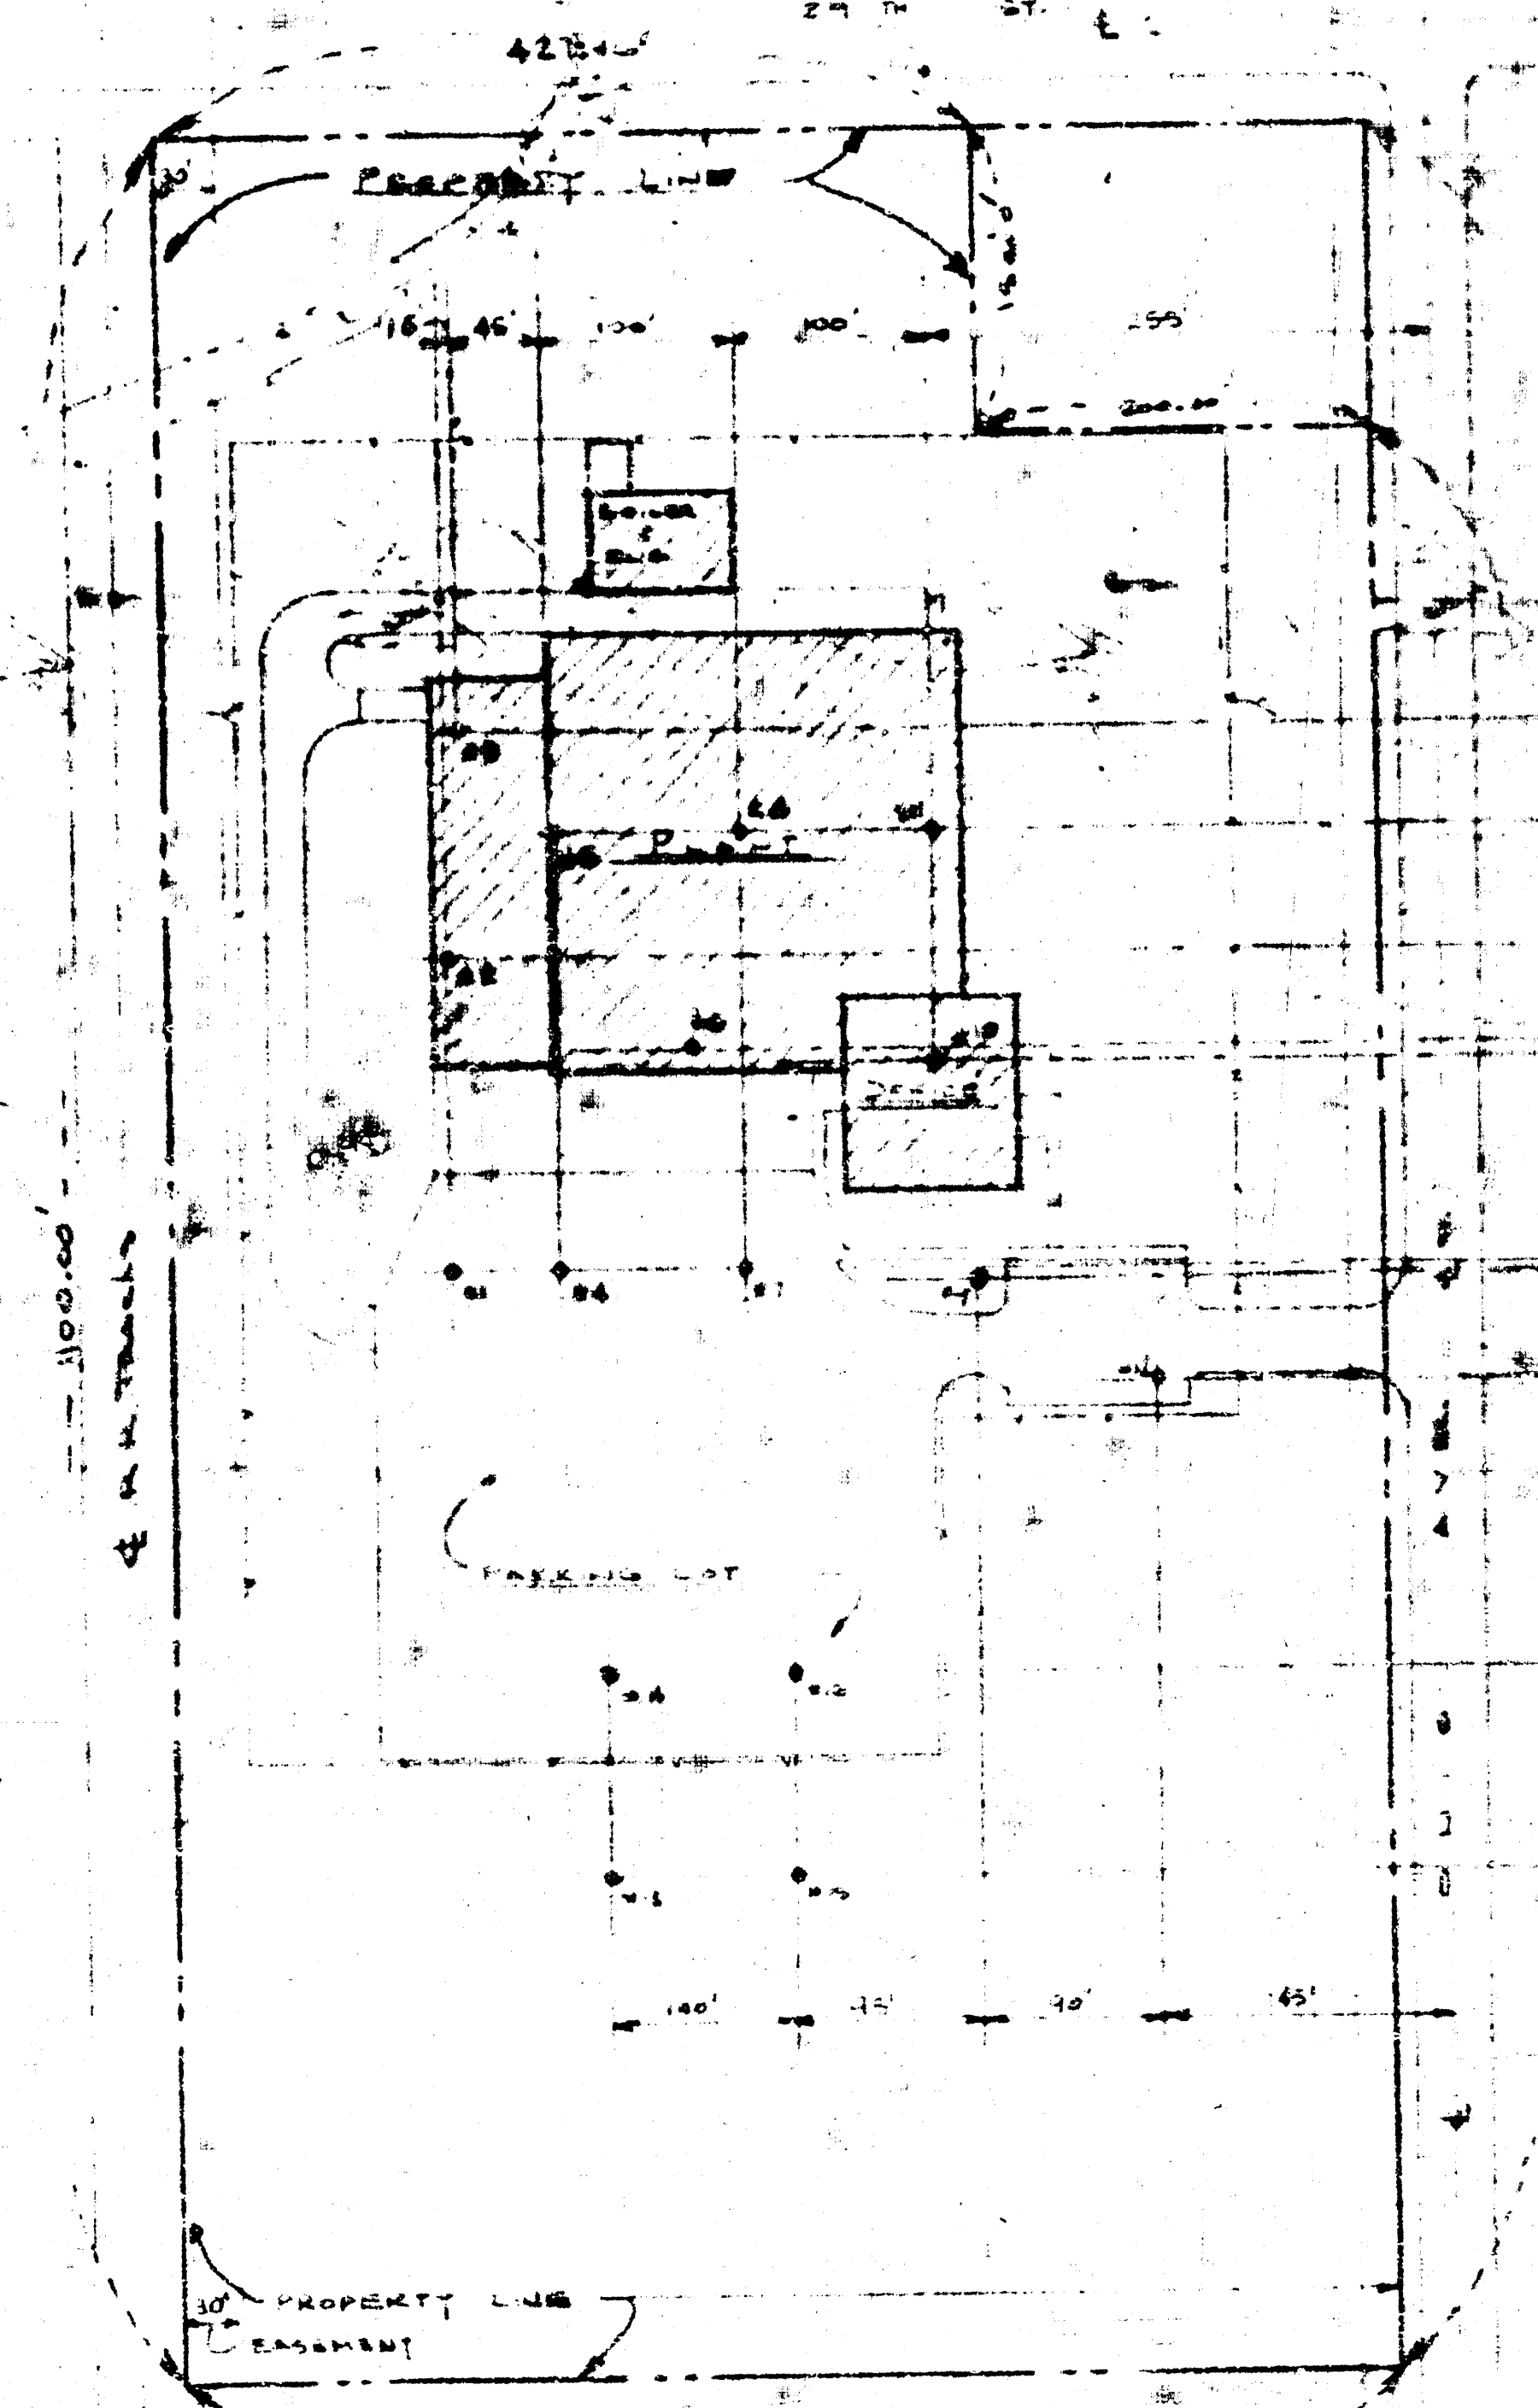

Private Storm Sewer
 Dold Packing Co.
 Proj. No. BHRB503059

14 6 1 ⑦

SCALE 1" = 100.0'

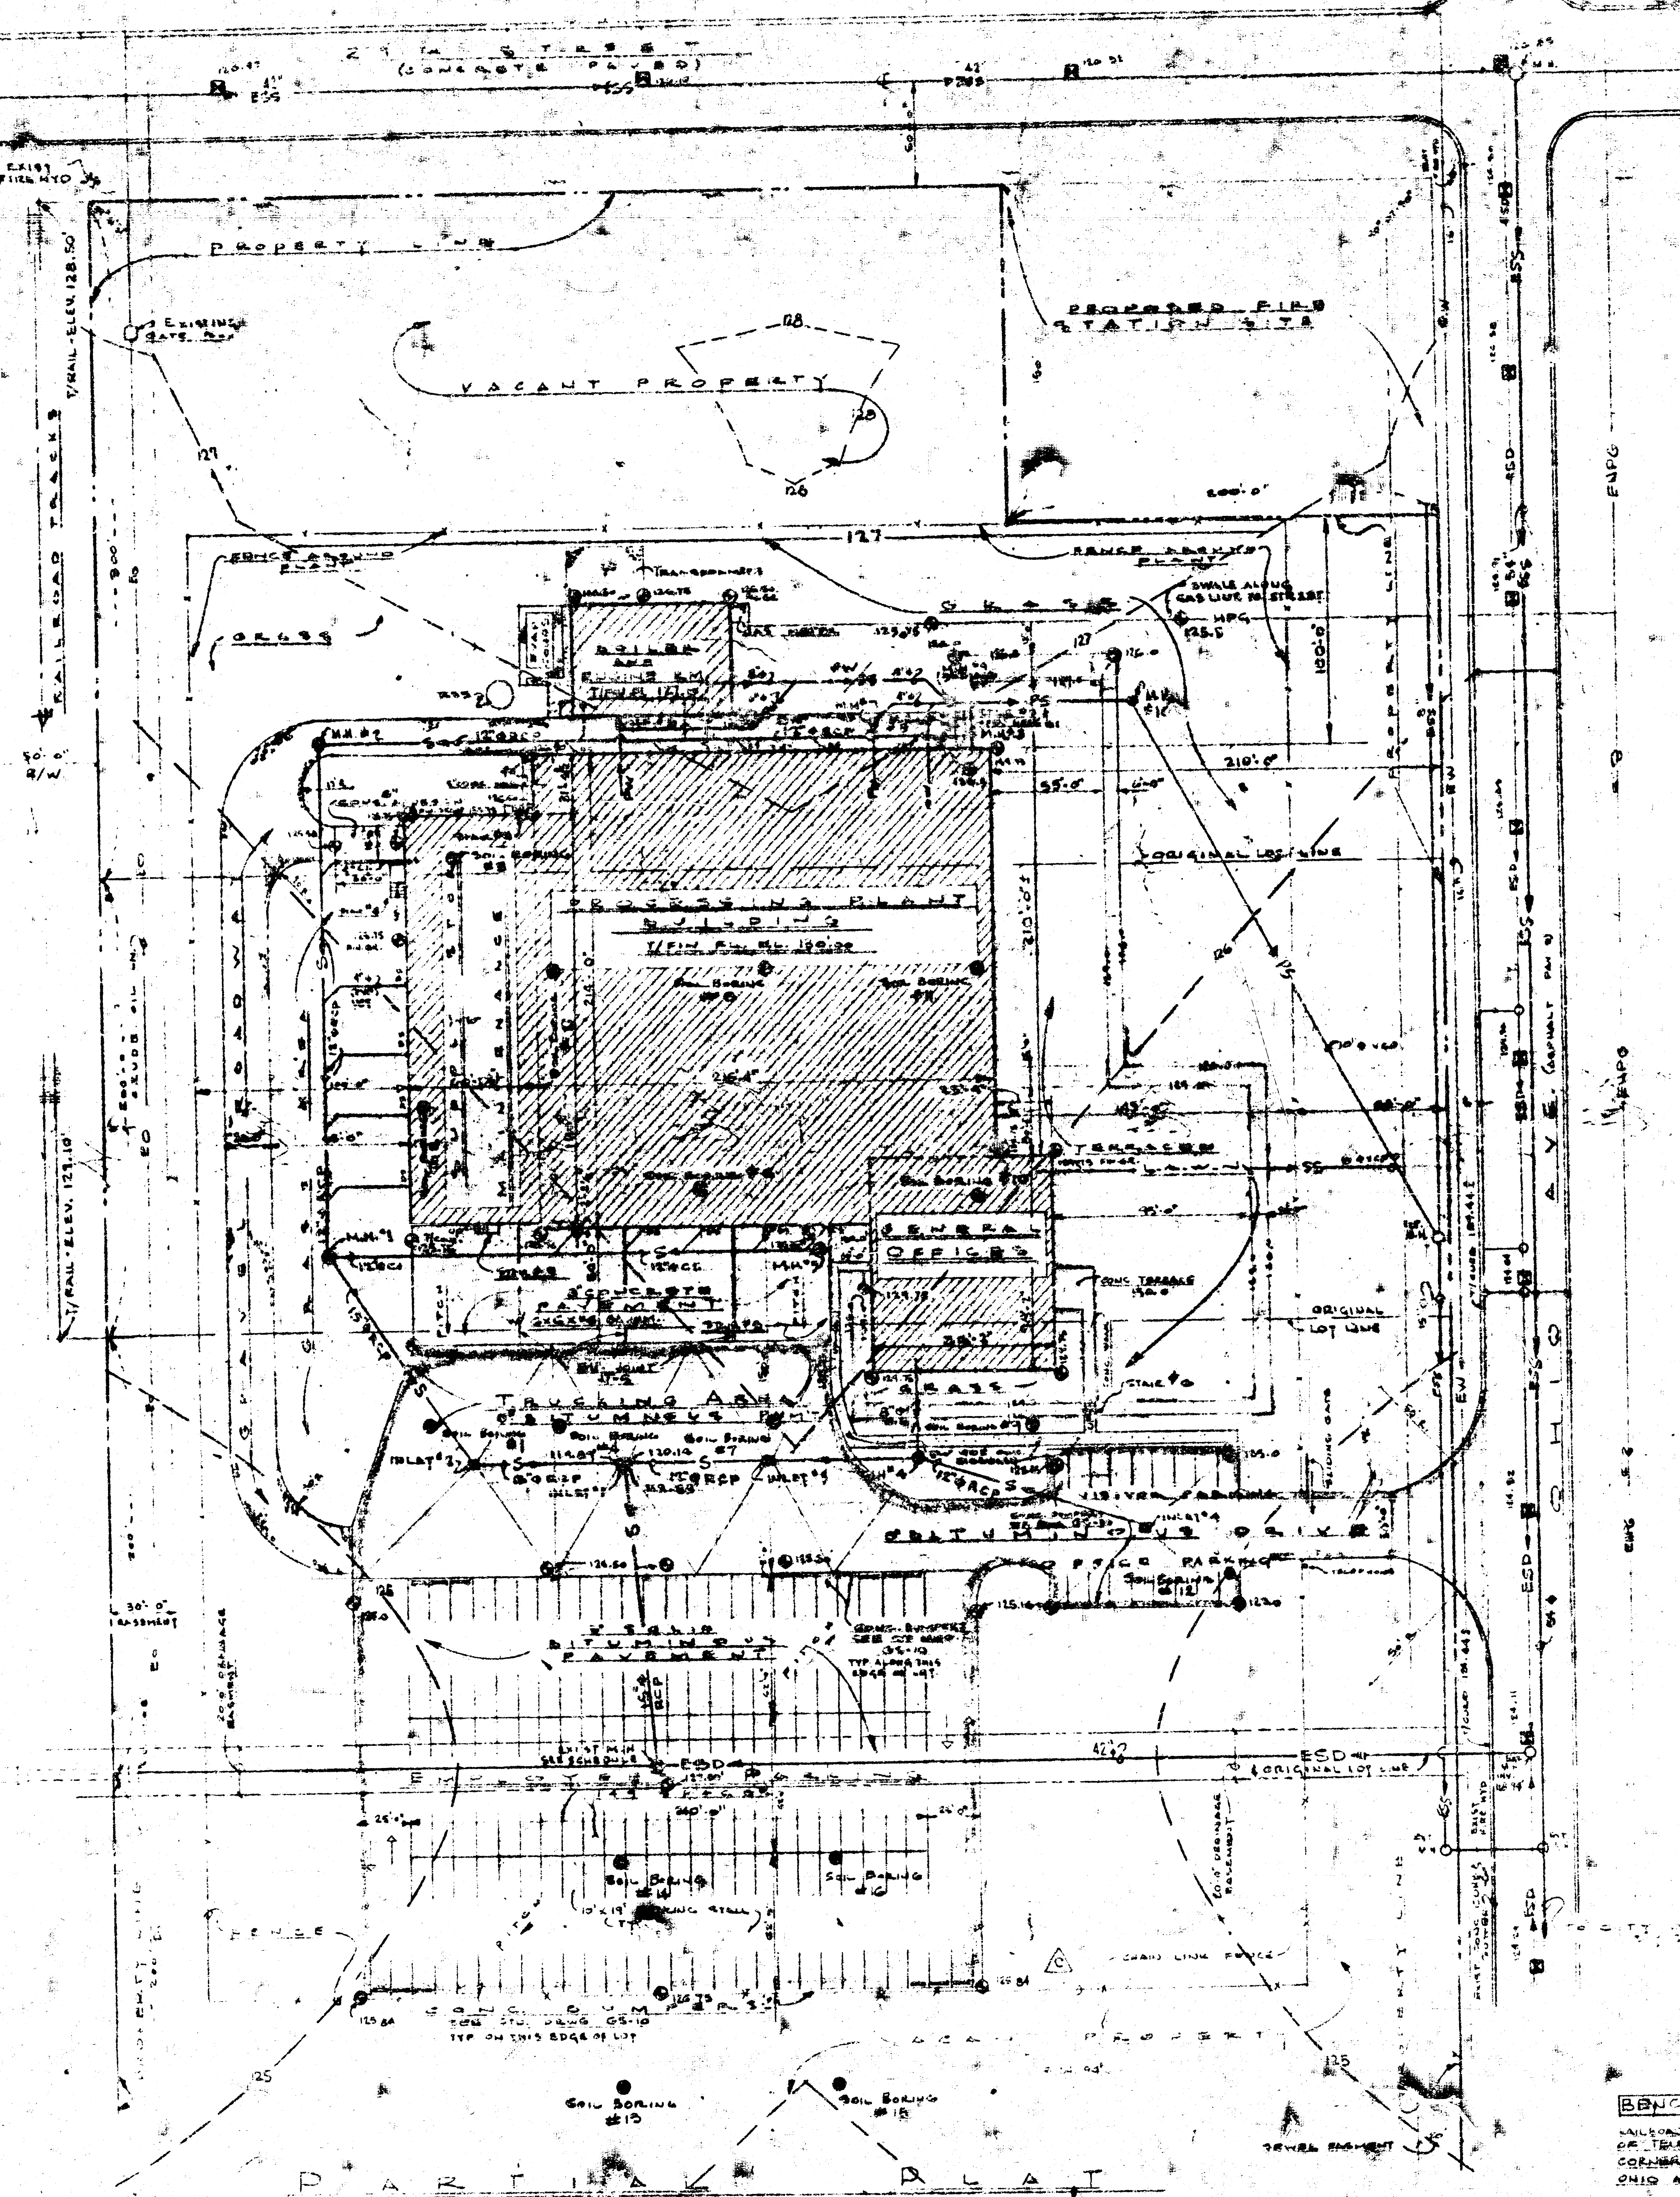

BENCH MARK
 SAILROAD SPIKE IN NORTH CORNER OF TRASHING POLE S.E. CORNER OF ENH ST & CHIO AVE. ELEV. 126.88'

10-10-73
 APPROVED AS NOTED
 By CITY ENGINEER OF WICHITA
 Sanitary Sewers
 Storm Sewers
 Driveway Approaches

NOTE TO CONTRACTOR
 This project will be constructed under the supervision of the CITY ENGINEER and conforming to the SPECIFICATIONS of the CITY OF WICHITA. The CONTRACTOR will reimburse the City of Wichita for all cost of Engineering, Plans, and Inspection.

