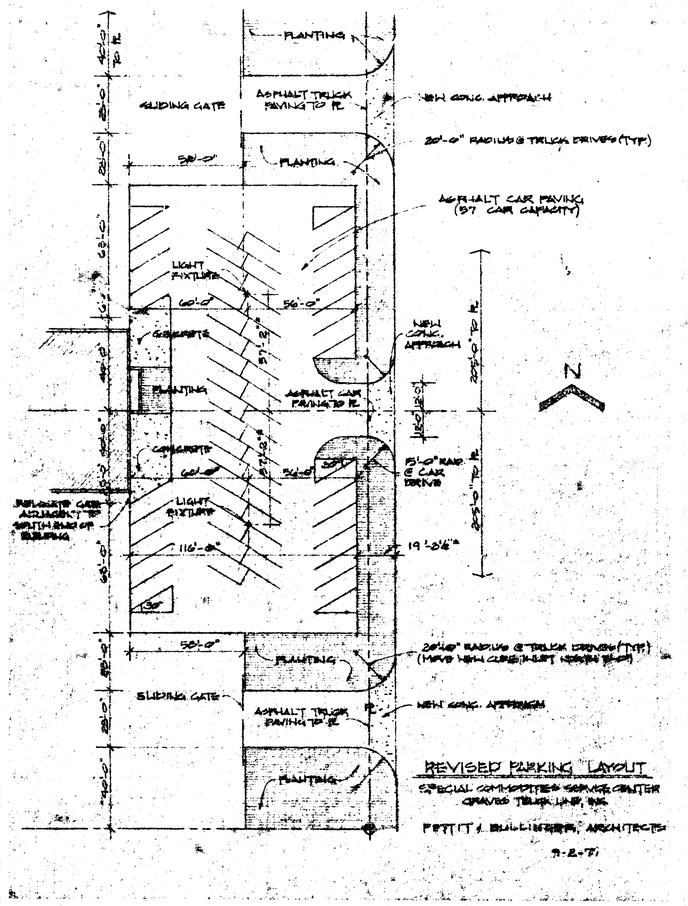

REVISED PARKING LAYOUT

SPECIAL COMMODITIES SERVICE CENTER
GRAVES TRUCK LINE, INC.

PETTIT & BILLINGER, ARCHITECTS

9-2-71

Site Plan

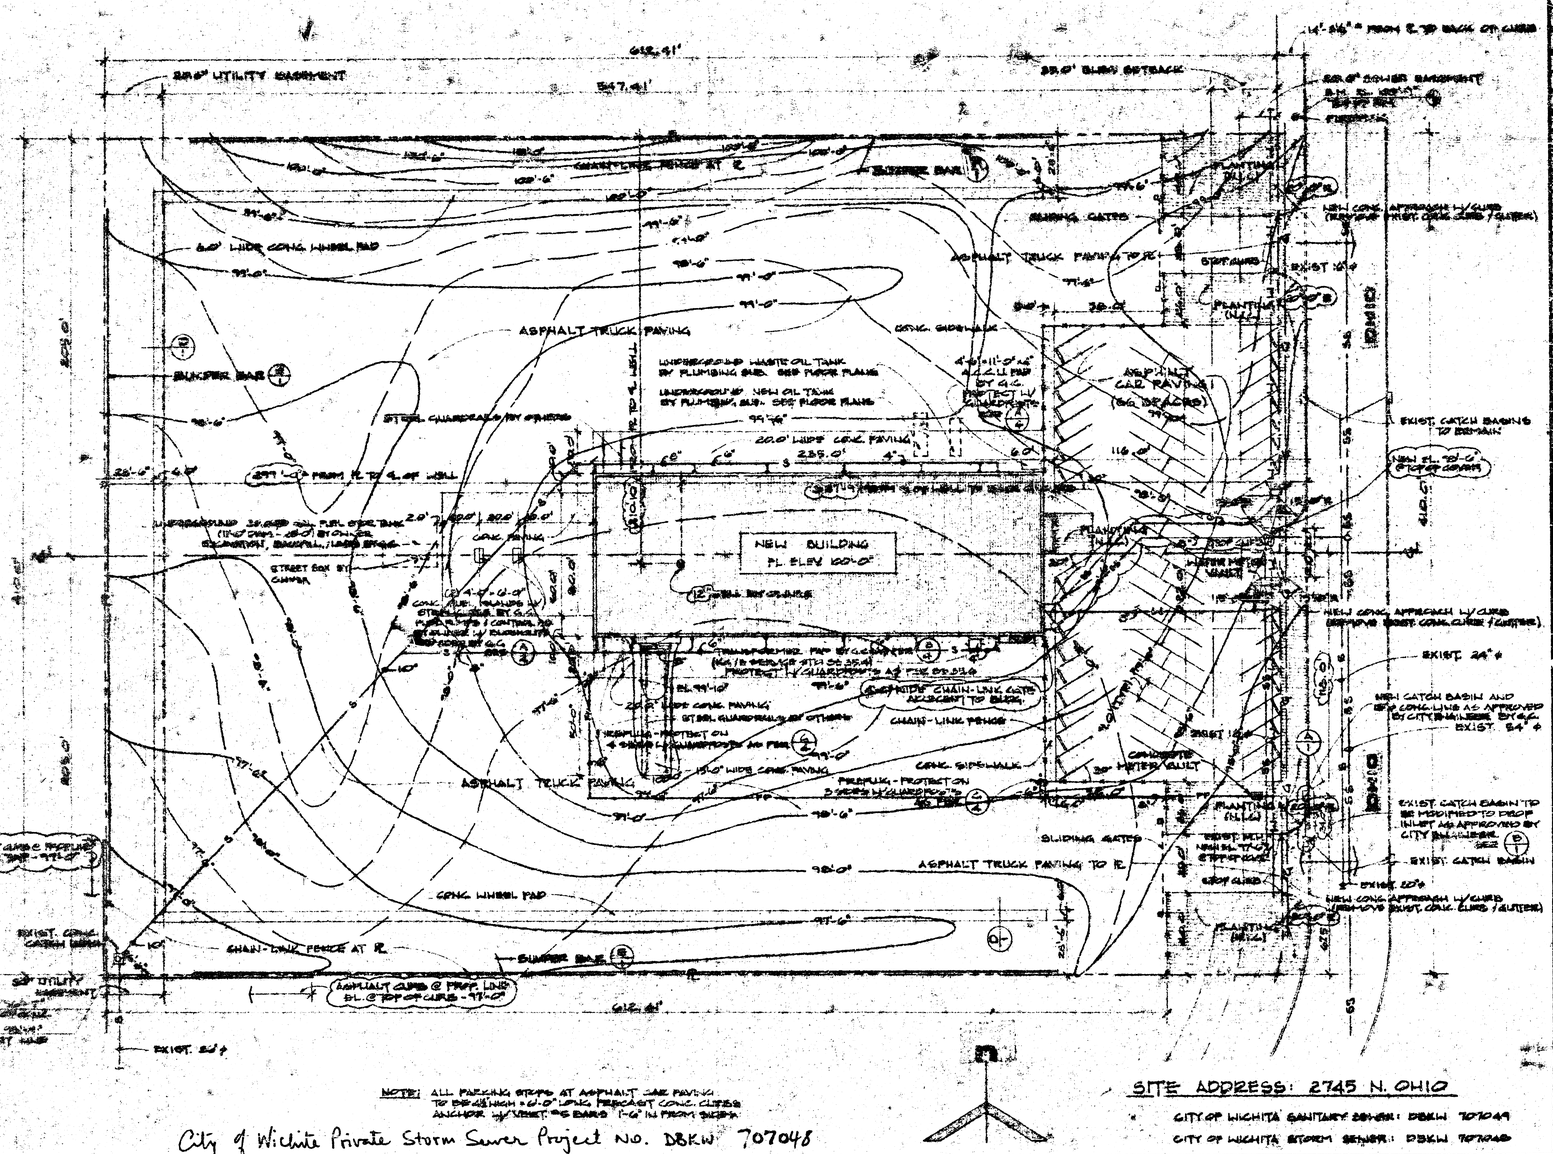

NOTE: ALL PAVING STOPS AT ASPHALT OR CONC. PAVING TO BE ADJACENT TO 6'-0" LONG PRECAST CONC. CURBS ANCHORED W/ VERT. #5 BARS 1'-6" IN FROM ENDS.

City of Wichita Private Storm Sewer Project No. DBKW 707048

SITE ADDRESS: 2745 N. OHIO

CITY OF WICHITA SANITARY SEWER: DBKW 707049

CITY OF WICHITA STORM SEWER: DBKW 707048

1" = 40'-0"

Sheet Index

1	SITE PLAN, SITE DETAILS
2	FIRST FLOOR PLAN, DOOR SCHEDULE, WINDOW TYPES
3	UPPER LEVEL PLAN, DETAILS
4	ELEVATIONS
5	BUILDING SECTIONS, FINISH SCHEDULE, DETAILS
6	WALL SECTIONS
7	STAIR SECTIONS, DETAILS
8	DOOR / WINDOW FRAME DETAILS
9	MISCELLANEOUS DETAILS
S-1	FOUNDATION PLAN, DETAILS
S-2	UPPER LEVEL FRAMING PLAN, COLUMN SCHEDULE, DTLS.
S-3	FOOTING / FOUNDATION SCHEDULES, DETAILS
S-4	MISCELLANEOUS STRUCTURAL DETAILS
M-1	FIRST FLOOR PLUMBING / HVAC PLAN, SCHEDULES
M-2	SITE PLAN, PARTIAL FIRST FLOOR HVAC PLAN, UPPER LEVEL PLUMBING / HVAC PLAN
M-3	TRUCK WASH PIPING LAYOUT
E-1	SITE PLAN, SCHEDULES
E-2	FIRST FLOOR ELECTRICAL PLAN
E-3	UPPER FLOOR ELECTRICAL PLAN

Symbols

BUILDING SECTION — DETAIL NO. / SHEET NO.

WALL SECTION — DETAIL NO. / SHEET NO.

INTERIOR ELEVATION

DETAIL MARK — DETAIL NO. / SHEET NO.

ELEVATION INDICATION — ELEVATION LOCATION

DOOR MARK

WINDOW MARK

ROOM NUMBER — 120

COLUMN NUMBERS

LINTEL NUMBER

WATER LINE — W

STORM SEWER LINE — S

SANITARY SEWER LINE — SS

GAS LINE — G

TELEPHONE LINE — T

ELECTRIC LINE — E

PROPERTY LINE

FENCE — X X X

EXIST. CONTOUR — 98.0

NEW CONTOUR — 98.0

FIRE PROTECTION MAIN — FP

WOOD OR METAL STUD WALL

CONCRETE

CONCRETE BLOCK

BRICK

STEEL OR IRON

STONE

STRUCTURAL GLAZED TILE

ROUGH LUMBER

FINISH WOOD

PLYWOOD

NON-RIGID INSULATION

RIGID INSULATION

EARTH

SAND FILL

Abbreviations

acous.	acoustic	int.	interior
act.	actual	joi.	joist
adj.	adjustable	lav.	lavatory
a/c, c.u.	air conditioning, condensing unit	lt.	light
alt.	alternate	l., lg.	line, long
alum.	aluminum	m.o.	masonry opening
arch.	architectural	matl.	material
avg.	average	max.	maximum
brg.	bearing	mech.	mechanical
b.m.	bench mark	m.c.	mechanical contractor
blkg.	blocking	mtl.	metal
c.i.	cast iron	mull.	mullion
clg.	ceiling	mtr.	muntin
cem.	cement	nat.	natural
c.l.	center line	nom.	nominal
c.t.	ceramic tile	n.a.	not applicable
c.b.	chalkboard	n.t.s.	not to scale
conc.	concrete	no., #	number
conc. blk.	concrete block	o.c.	on center
c.j.	control joint	o.d.	outside dimension
corr.	corridor	pl.	plate, property line
const.	construction	plywd.	plywood
cont.	continuous	pol.	polished
contr.	contractor	q.t.	quarry tile
dtl.	detail	r.	radius, riser
diam.	diameter	ref.	refer, refrigerator
dim.	dimension	reinf.	reinforcing
do.	ditto	rev.	revision
dn.	down	r.d.	roof drain
dnspt.	downspout	rm.	room
dwg.	drawing	r.o.	rough opening
d.f.	drinking fountain	sched.	schedule
ea.	each	s. & h.	sealer & hardener
e.w.	each way	sect.	section
elec.	electrical	sht.	sheet
e.c.	electrical contractor	s.o.	solid core
el.	elevation	specs.	specifications
elev.	elevator	sq. ft.	square feet
eq.	equal	s. & v.	stain & varnish
est.	estimated	std.	standard, stud
exist.	existing	stl.	steel
e.j.	expansion joint	stor.	storage
ext.	exterior	struc.	structural
fin.	finish	s.t.	structural tile
f.o.	finish opening	sub.	subcontractor
flash.	flashing	susp.	suspended
fl.	floor	s.a.t.	susp. acoustic tile
f.d.	floor drain	t.b.	tackboard
ftg.	footing	t.	thickness, tread
fdn.	foundation	tlt.	toilet
g.i.	galvanized iron	typ.	typical
ga.	gauge	vert.	vertical
g.c.	general contractor	v.t.	vinyl tile
gl.	glass	v.a.t.	vinyl asbestos tile
hdwre.	hardware	wt.	weight
ht.	height	w.w.f.	welded wire fabric
h.c.	hollow core	w.	width
h.m.	hollow metal	wdw.	window
horiz.	horizontal	w/	with
		wd.	wood

Dellinger Architects
WICHITA, KANSAS

REVISIONS

PROJECT NUMBER

DATE	DRAWN BY
7-19-77	JBP

TITLE
SITE PLAN
SITE DETAILS

SPECIAL COMMODITIES SERVICE CENTER for GRAVES TRUCK LINE, INC.