



Catholic Diocese of Wichita, Owner
Lot 2, Block 3, 4th Add. to
Pine Valley Estates






B.M. 191.75 spike west side Transformer Pole
at intersection of N.S. & E.W. Alleys

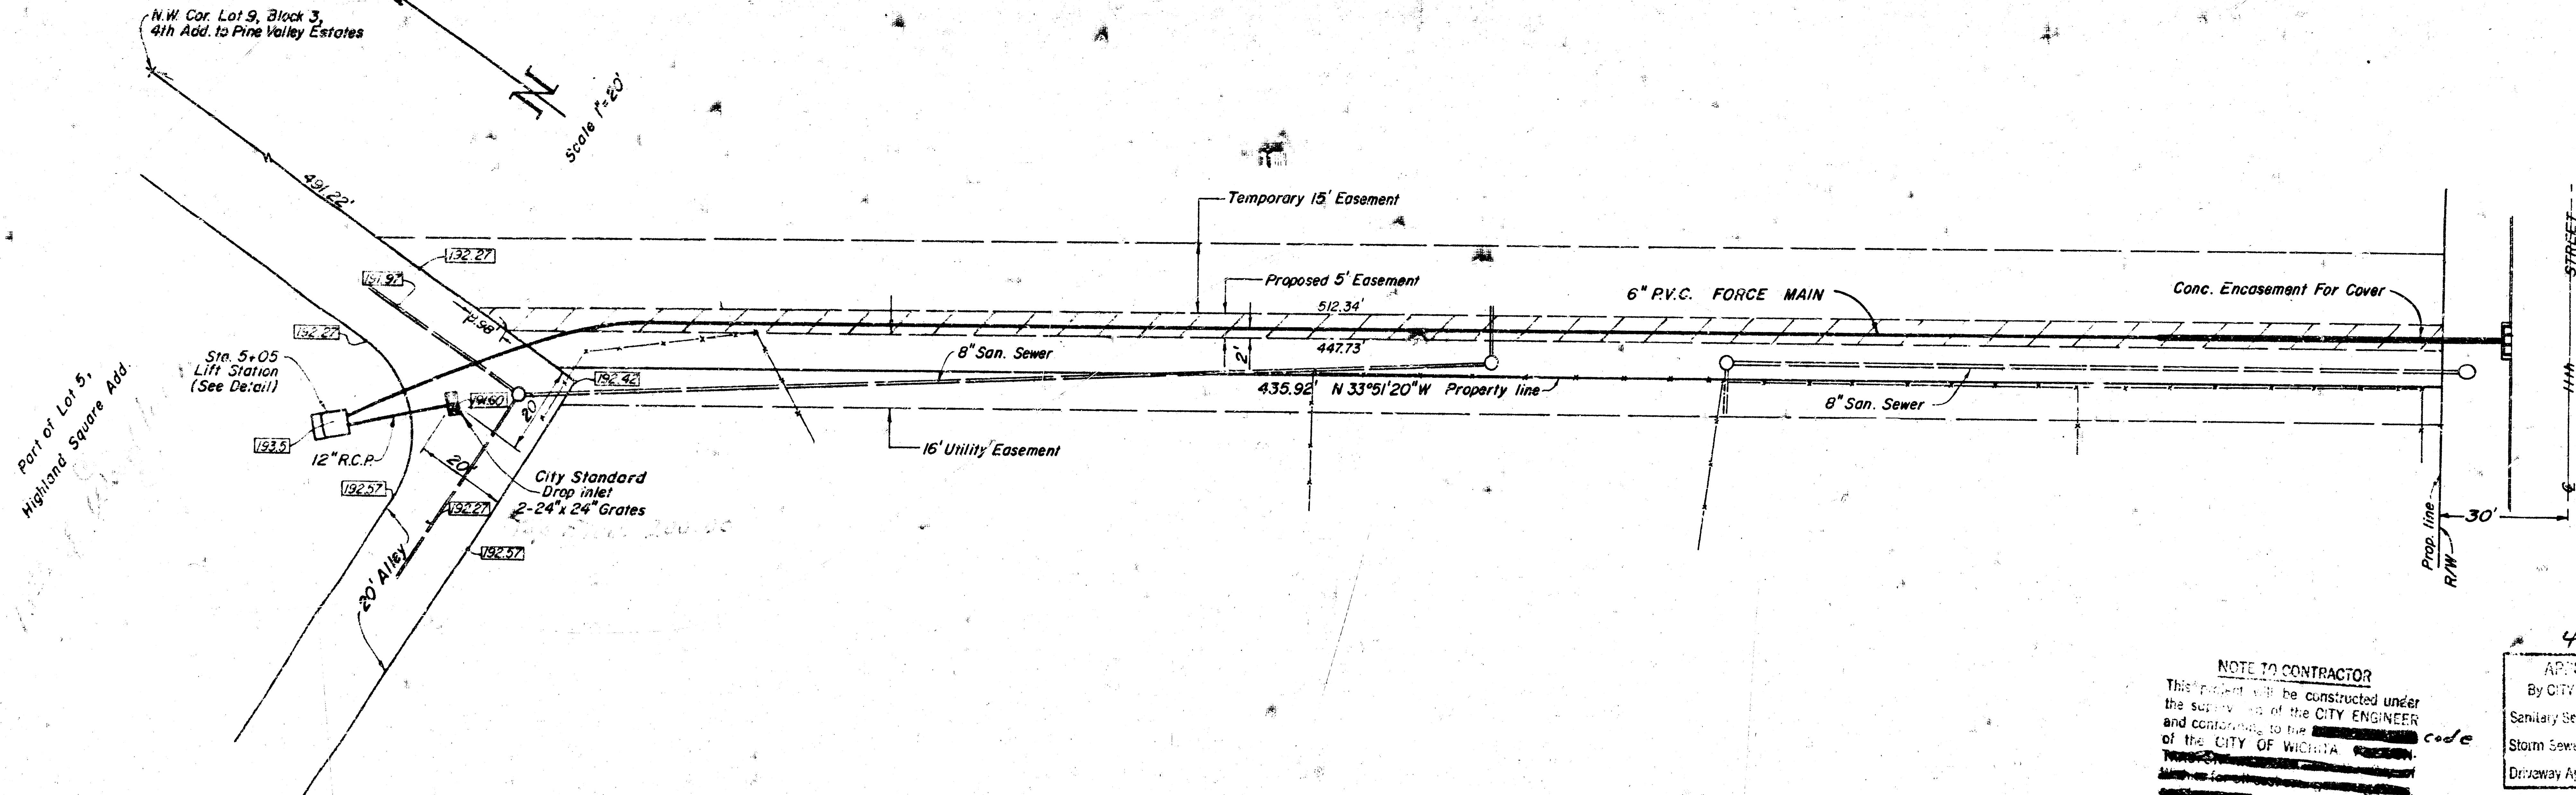

NOTE TO CONTRACTOR
This project will be constructed under
the supervision of the CITY ENGINEER
and conforming to the code
of the CITY OF WICHITA.

4-22-75
APPROVED AS NOTED
By CITY ENGINEER OF WICHITA
Sanitary Sewers
Storm Sewers D. E. J.
Driveway Approaches

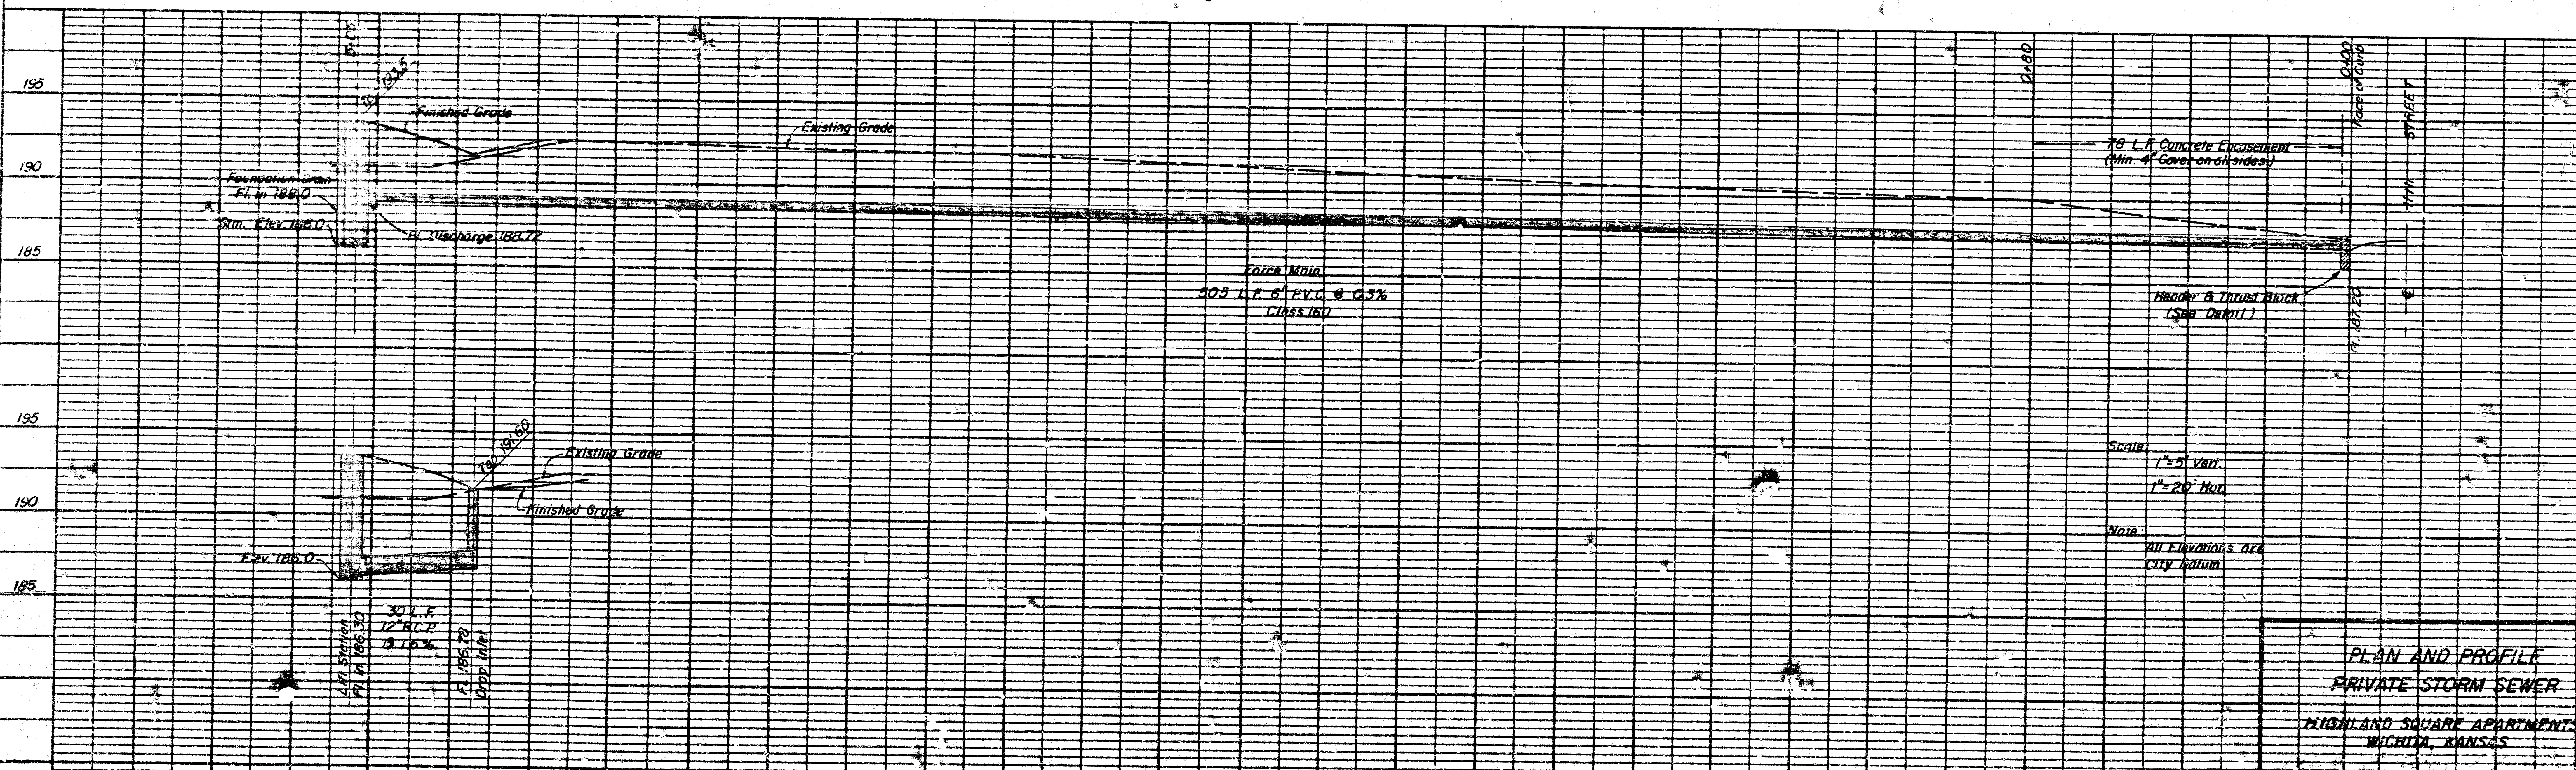

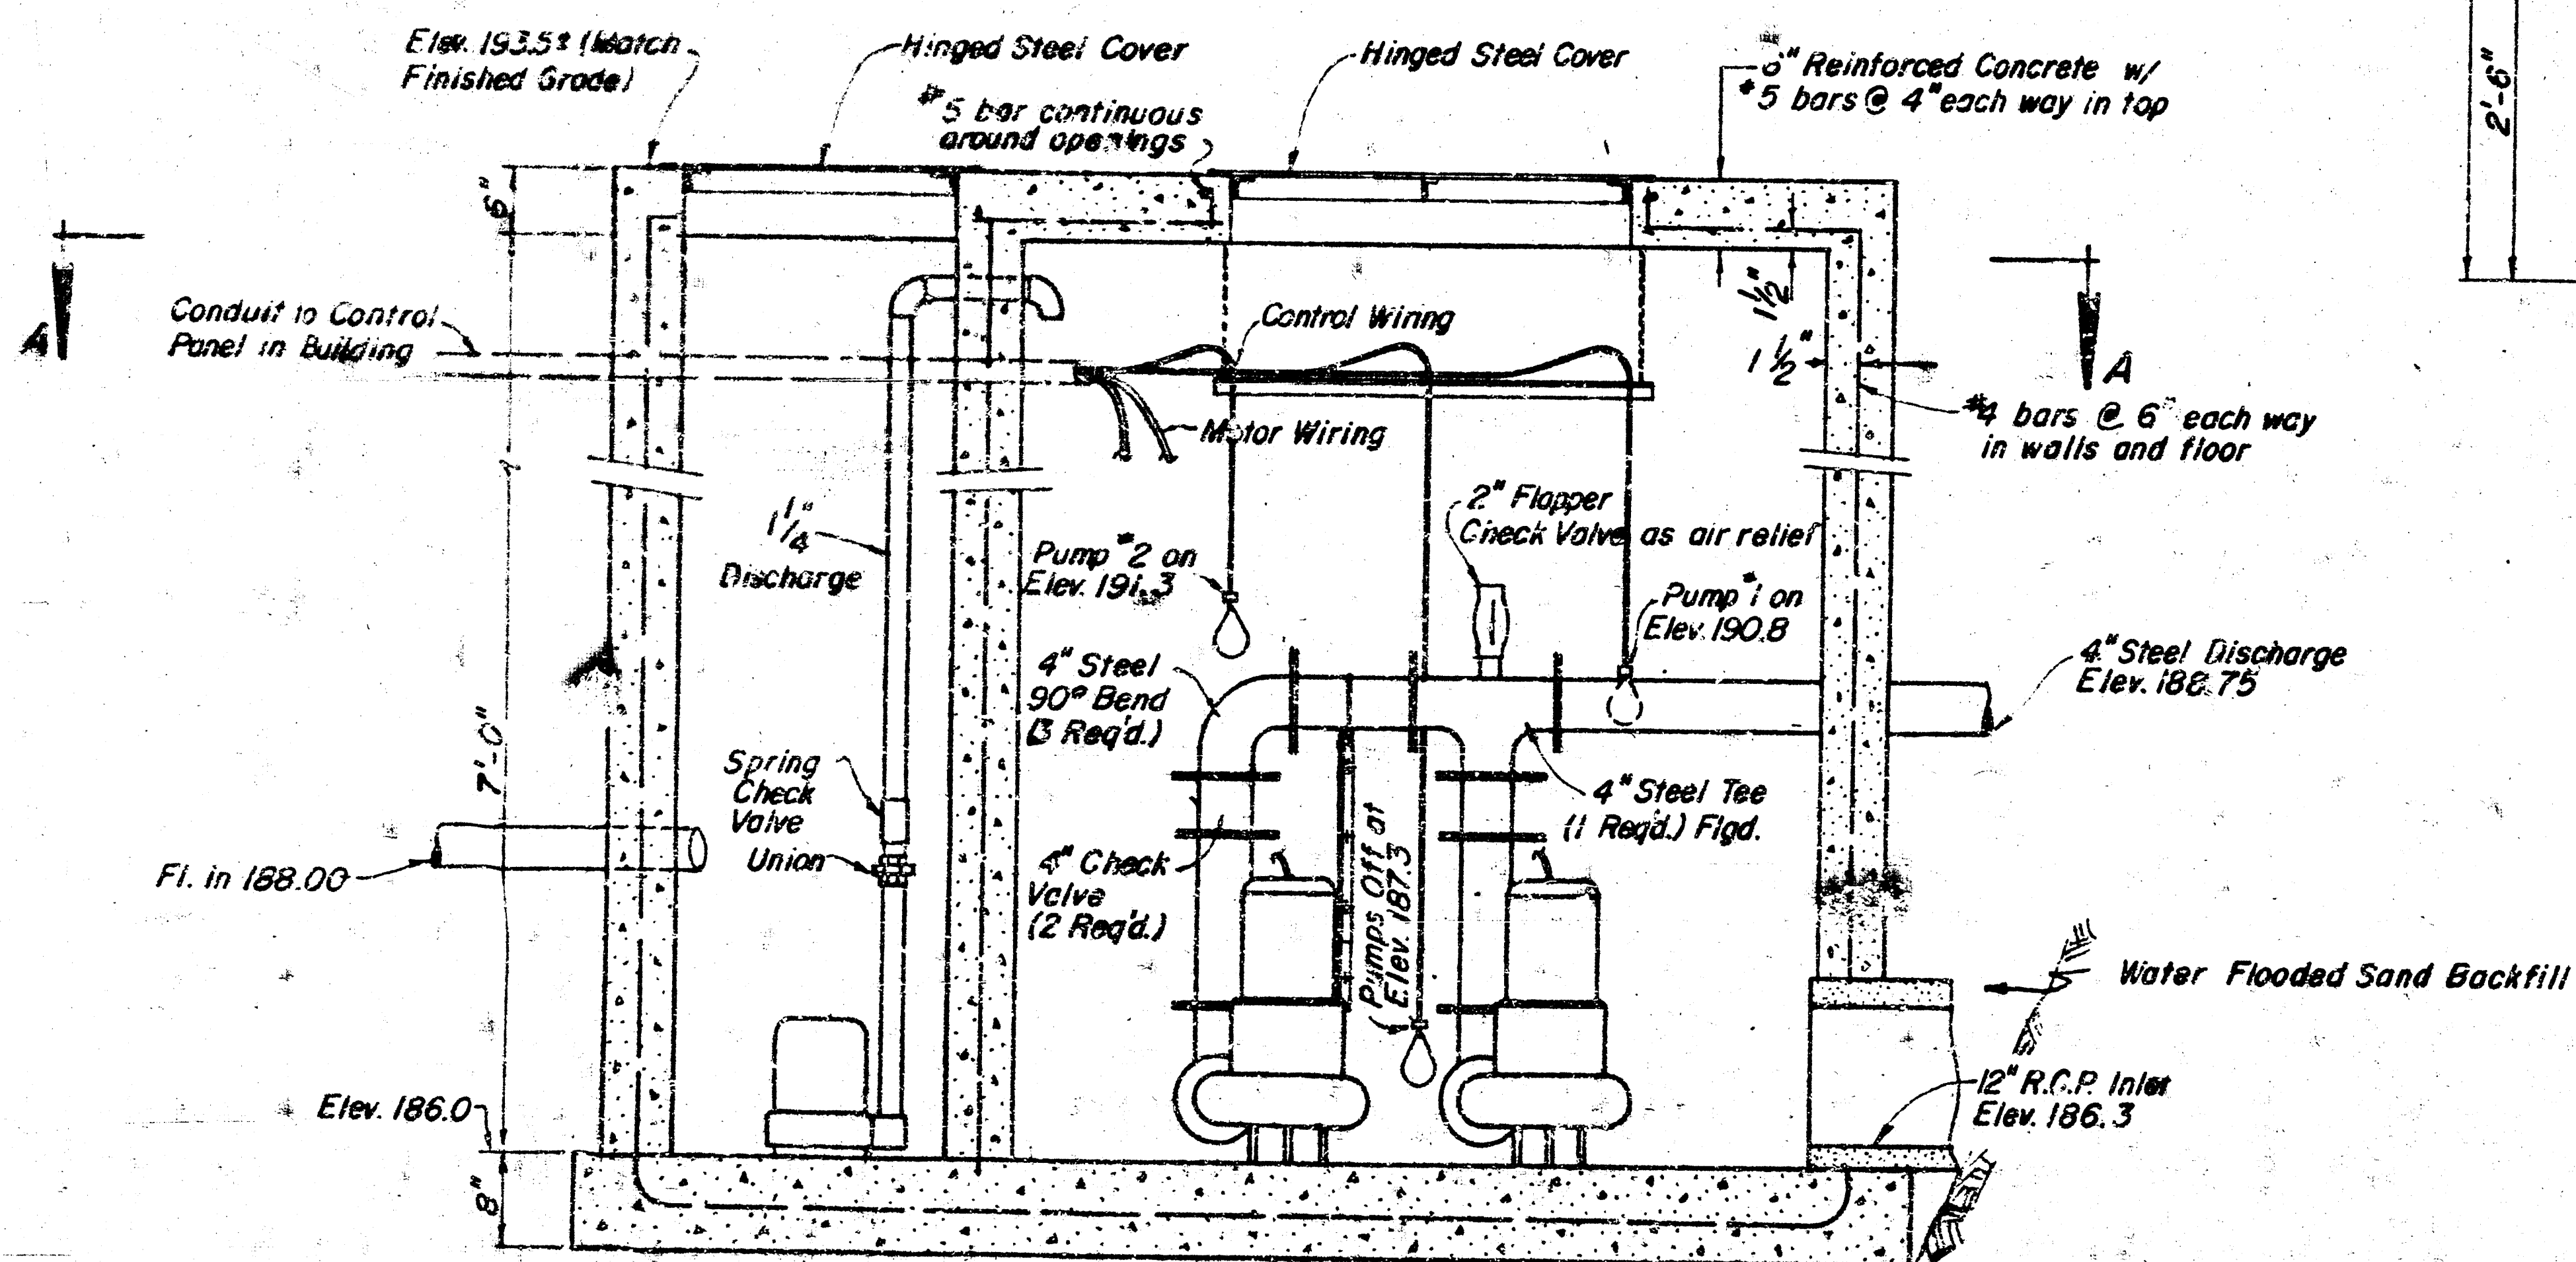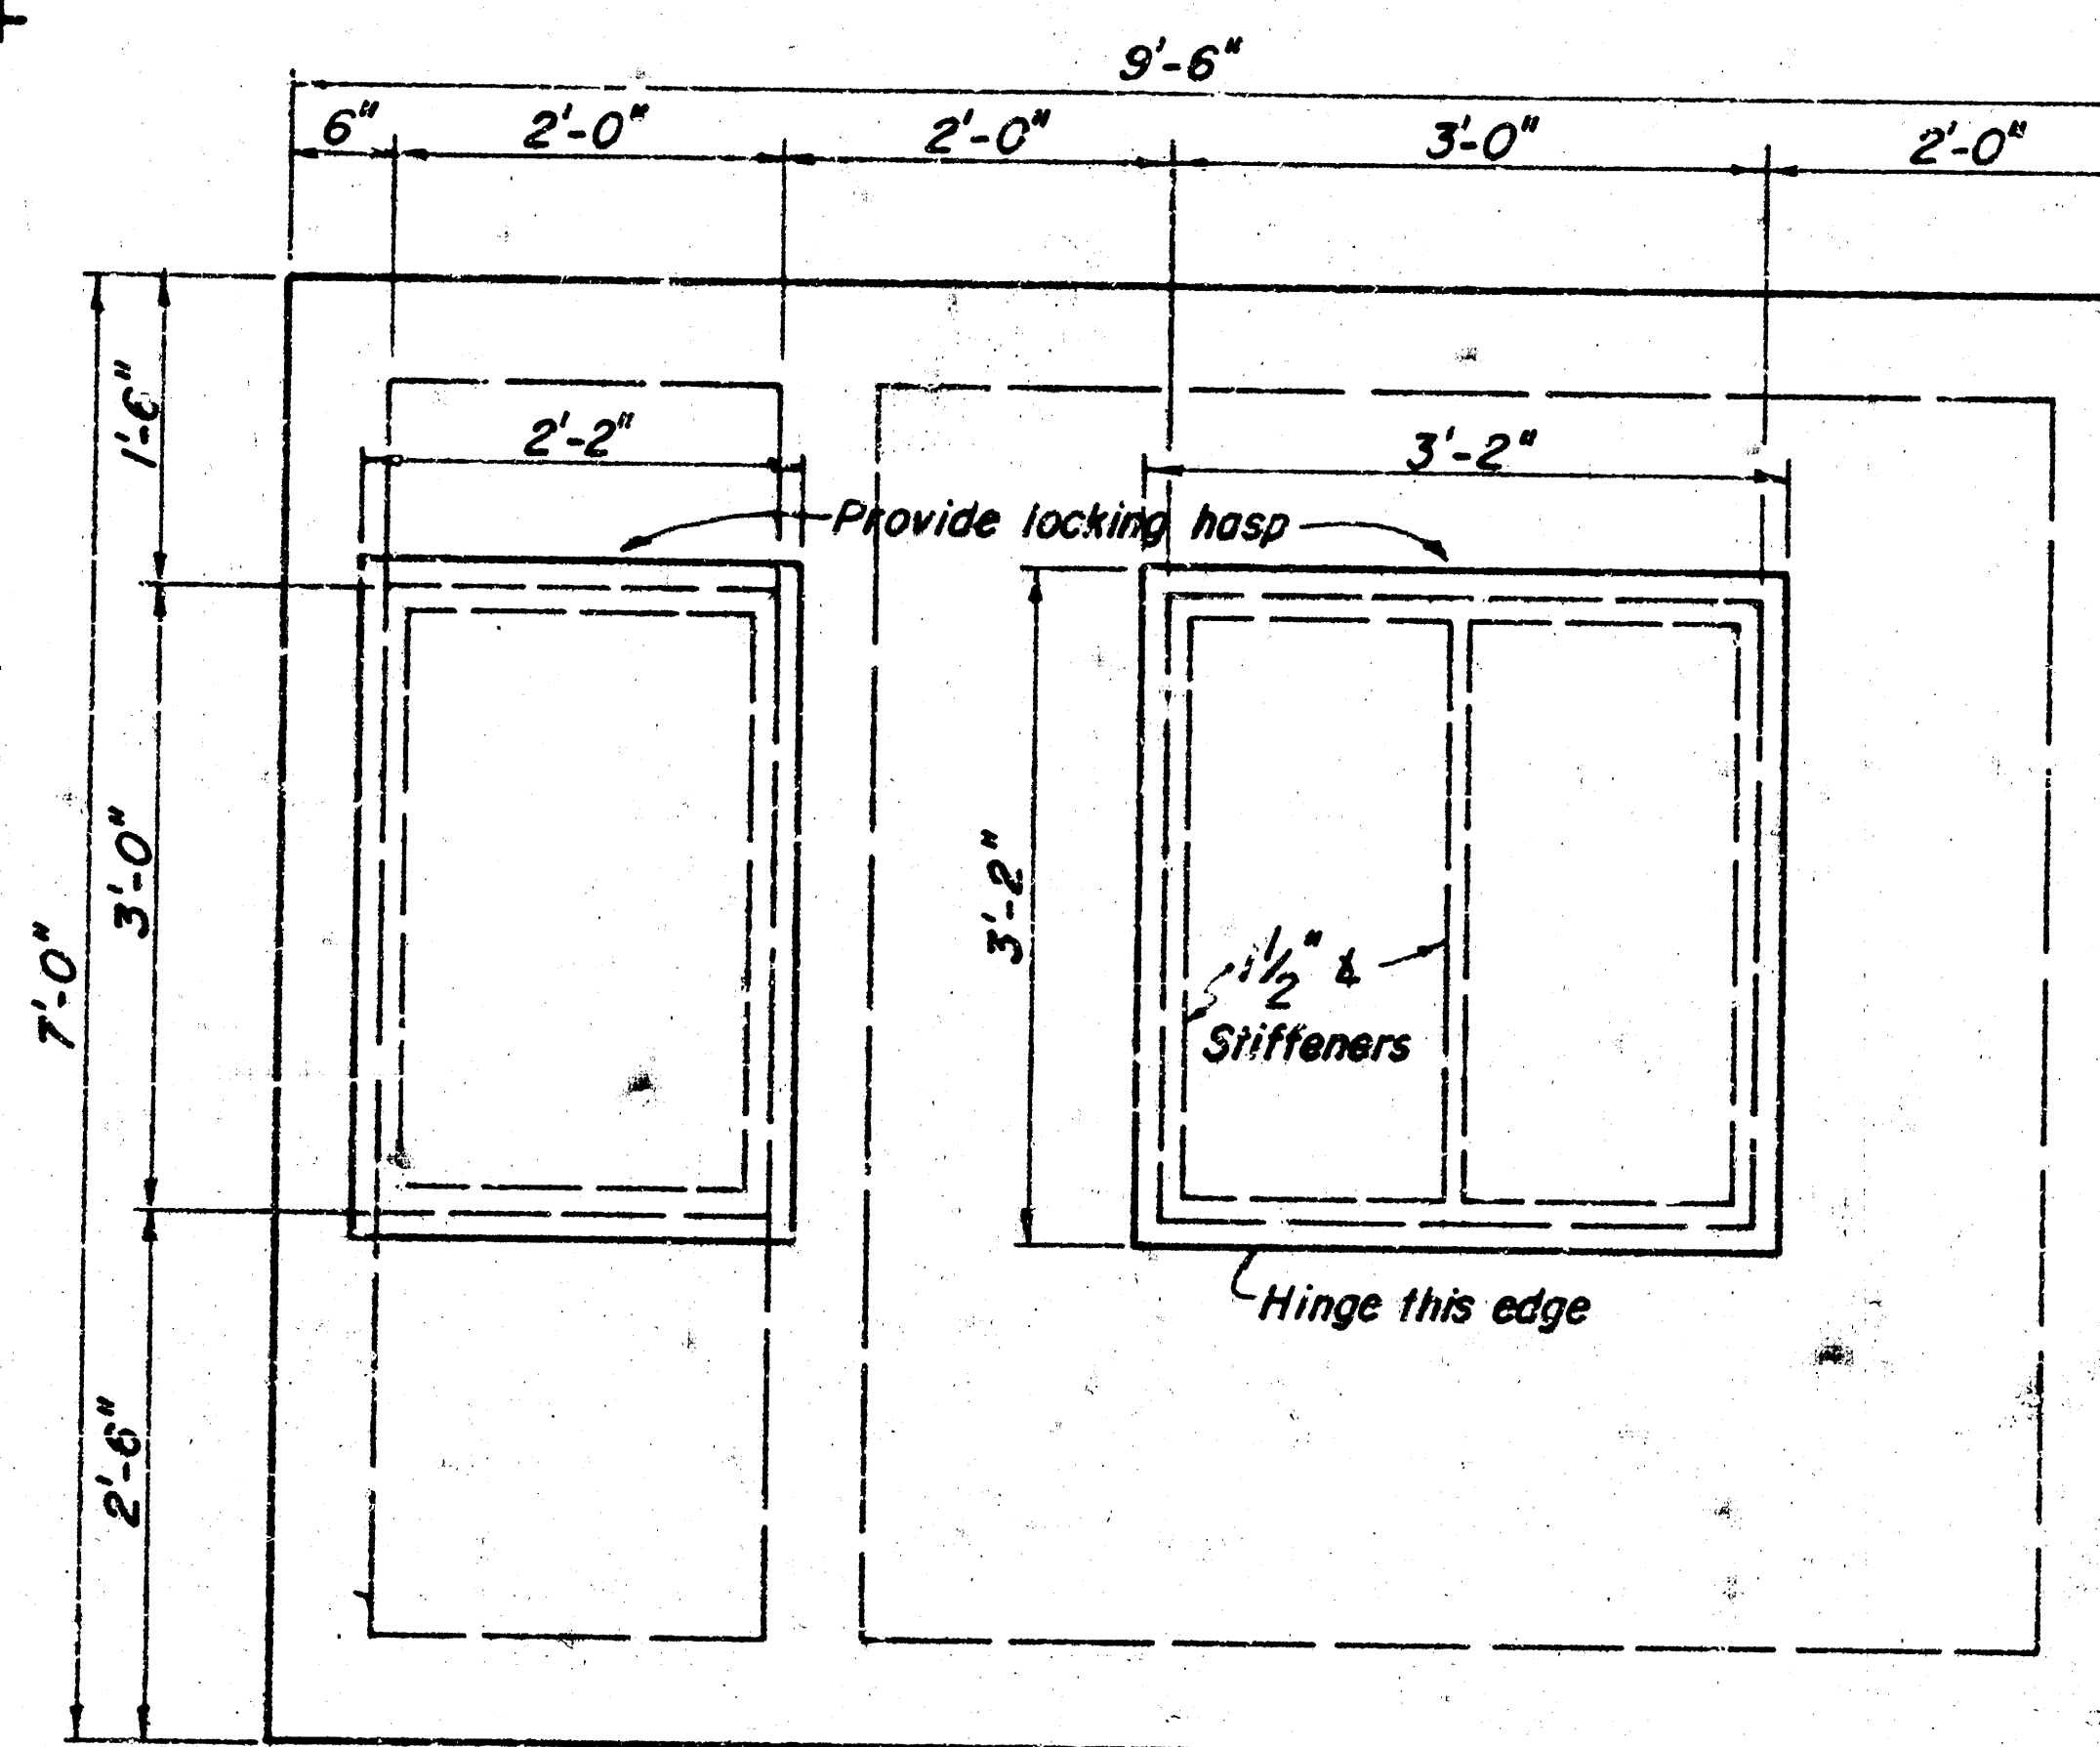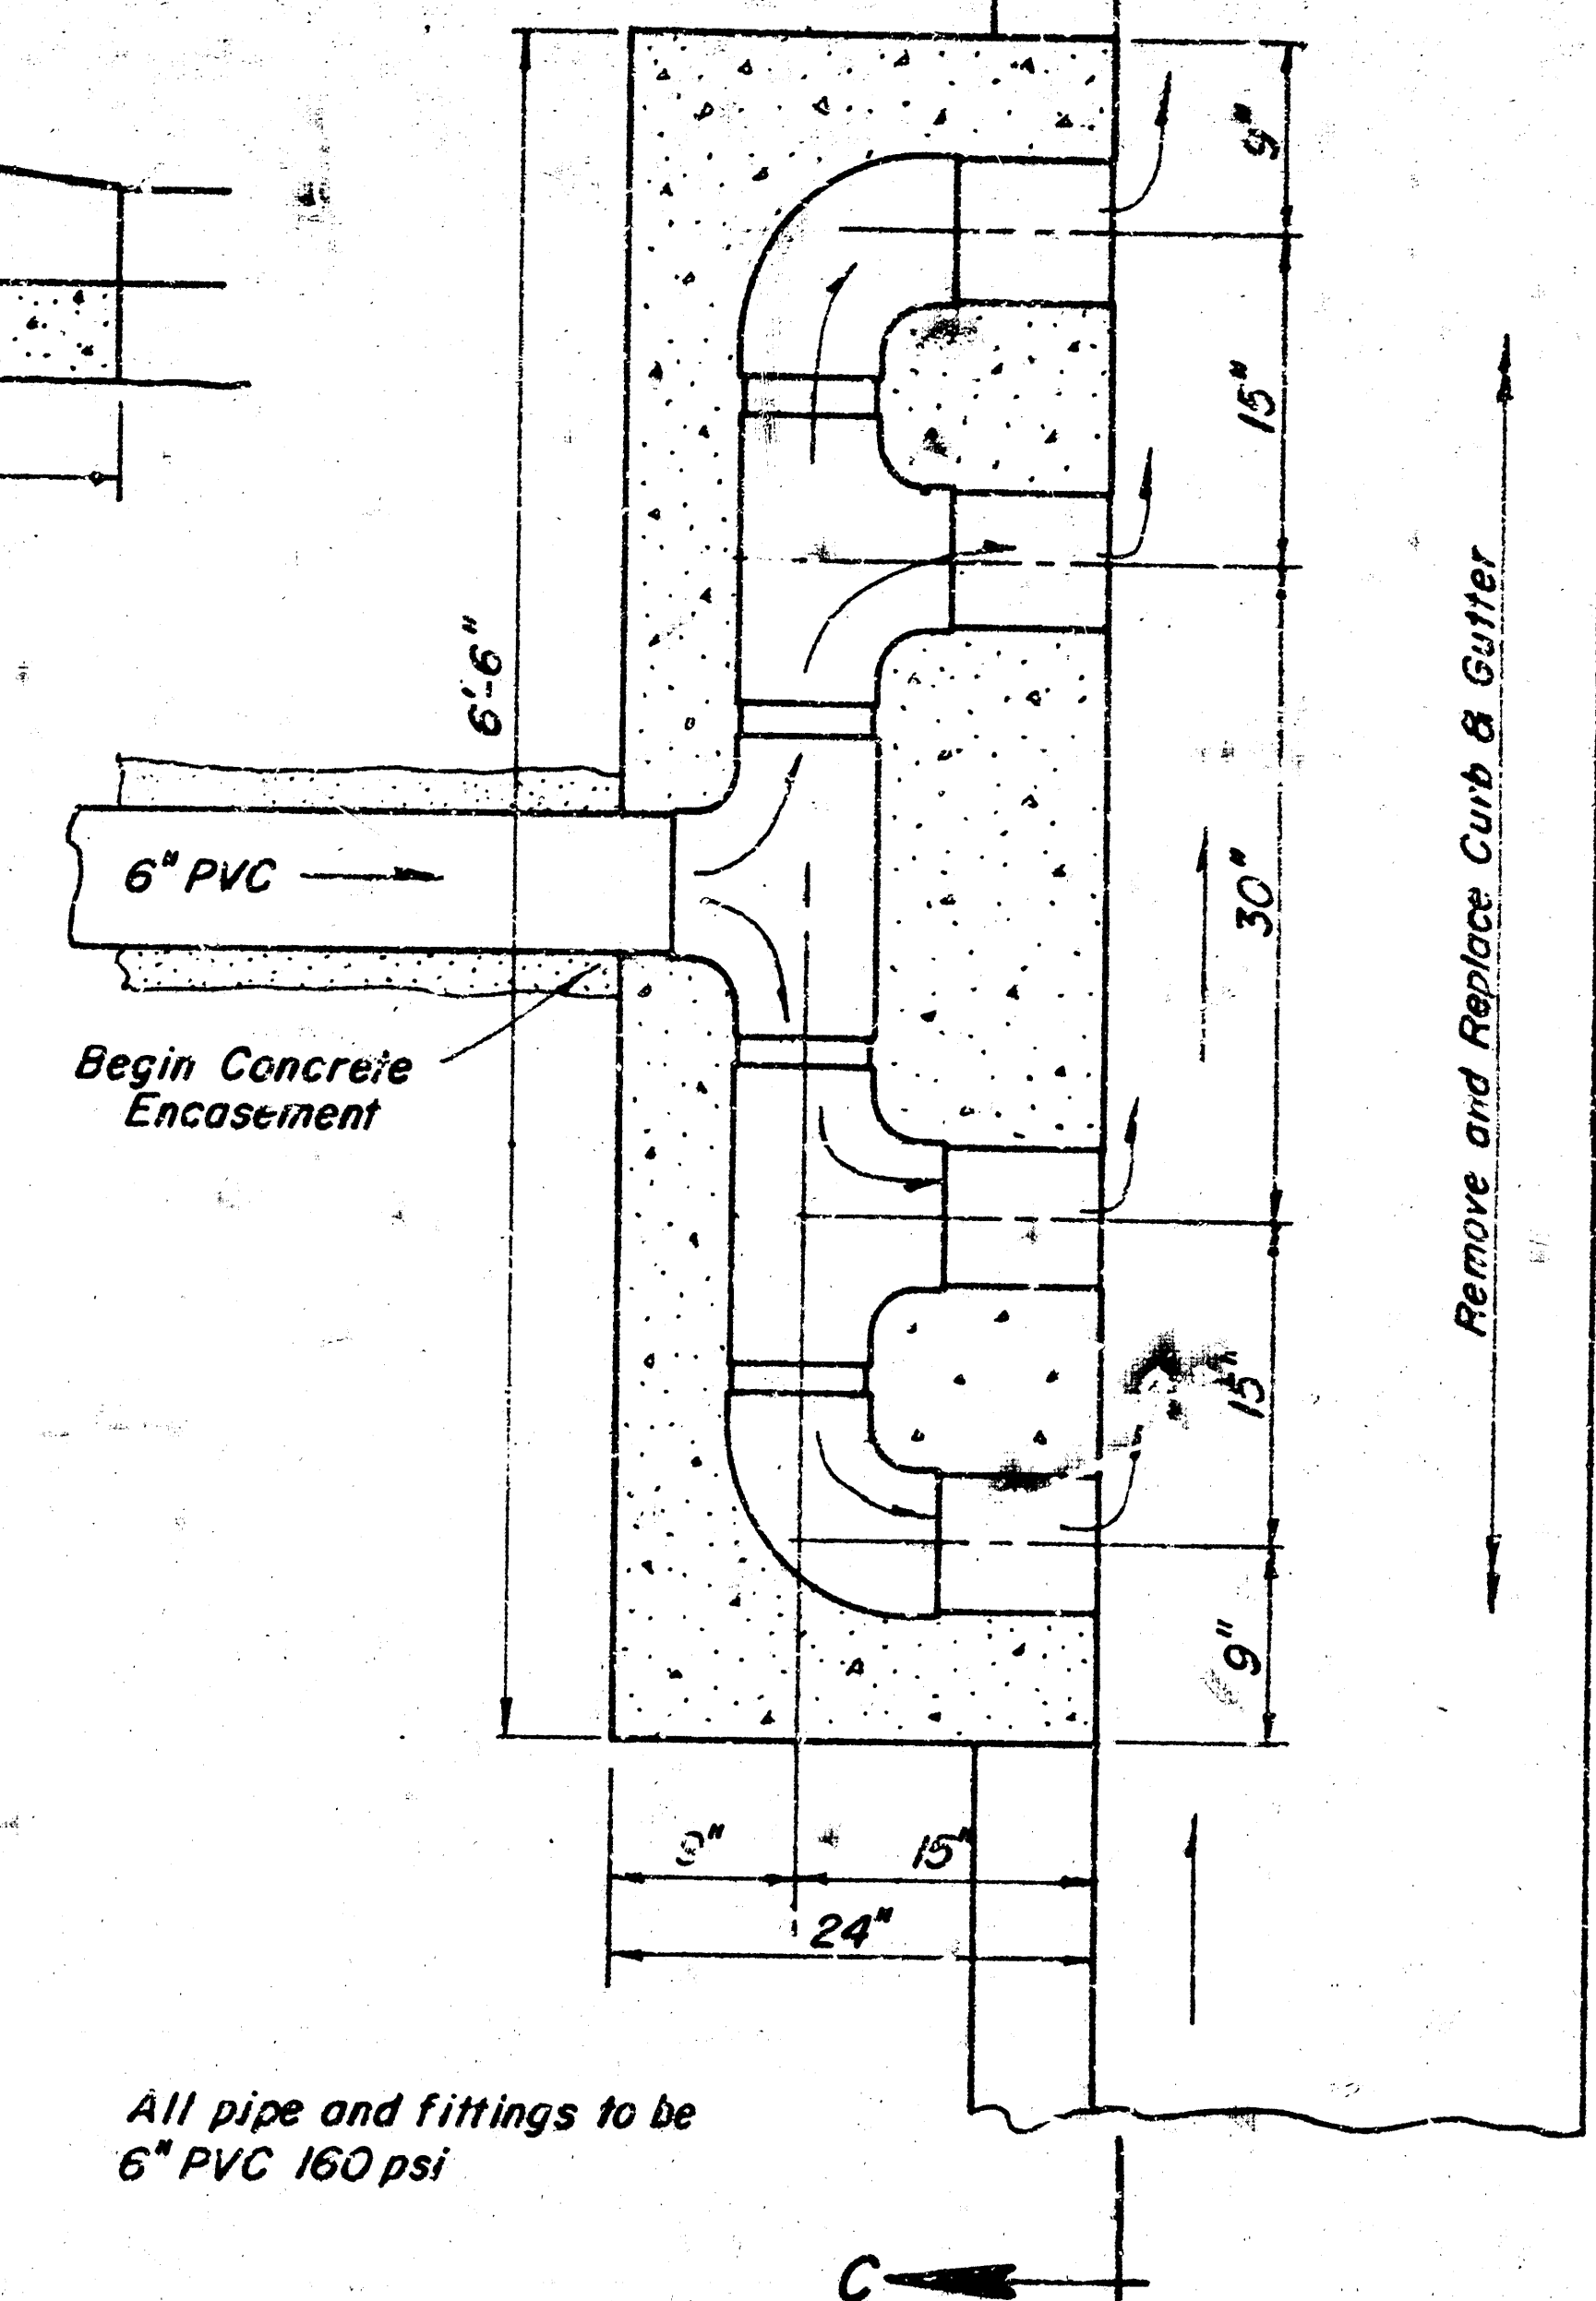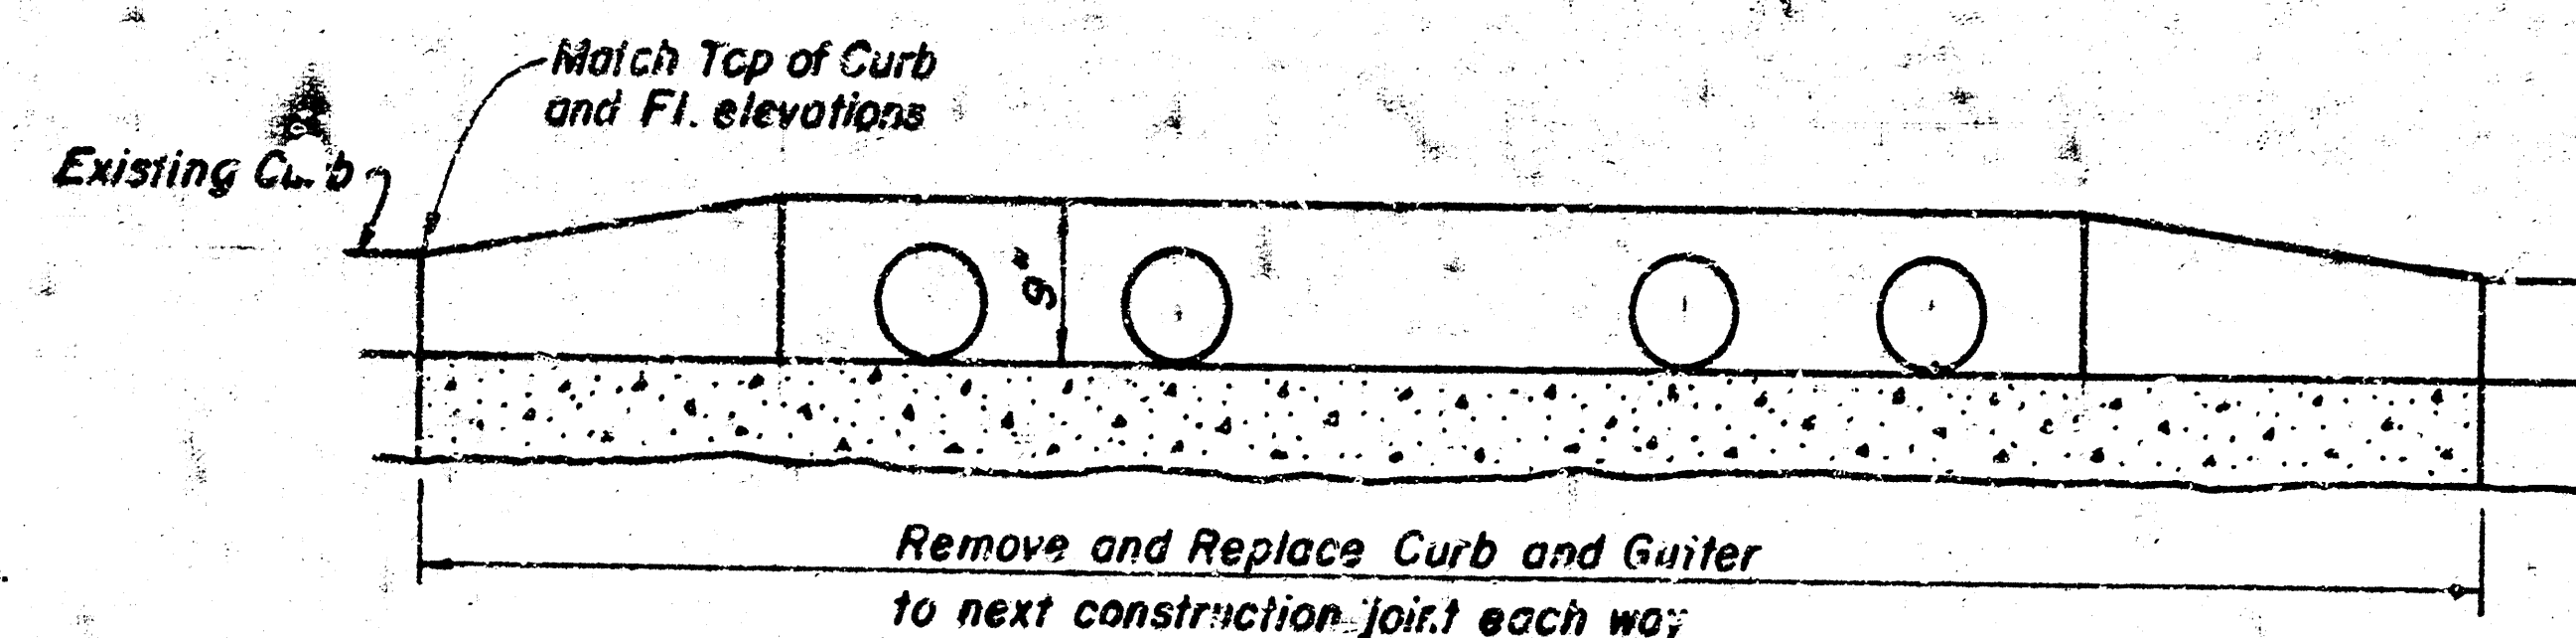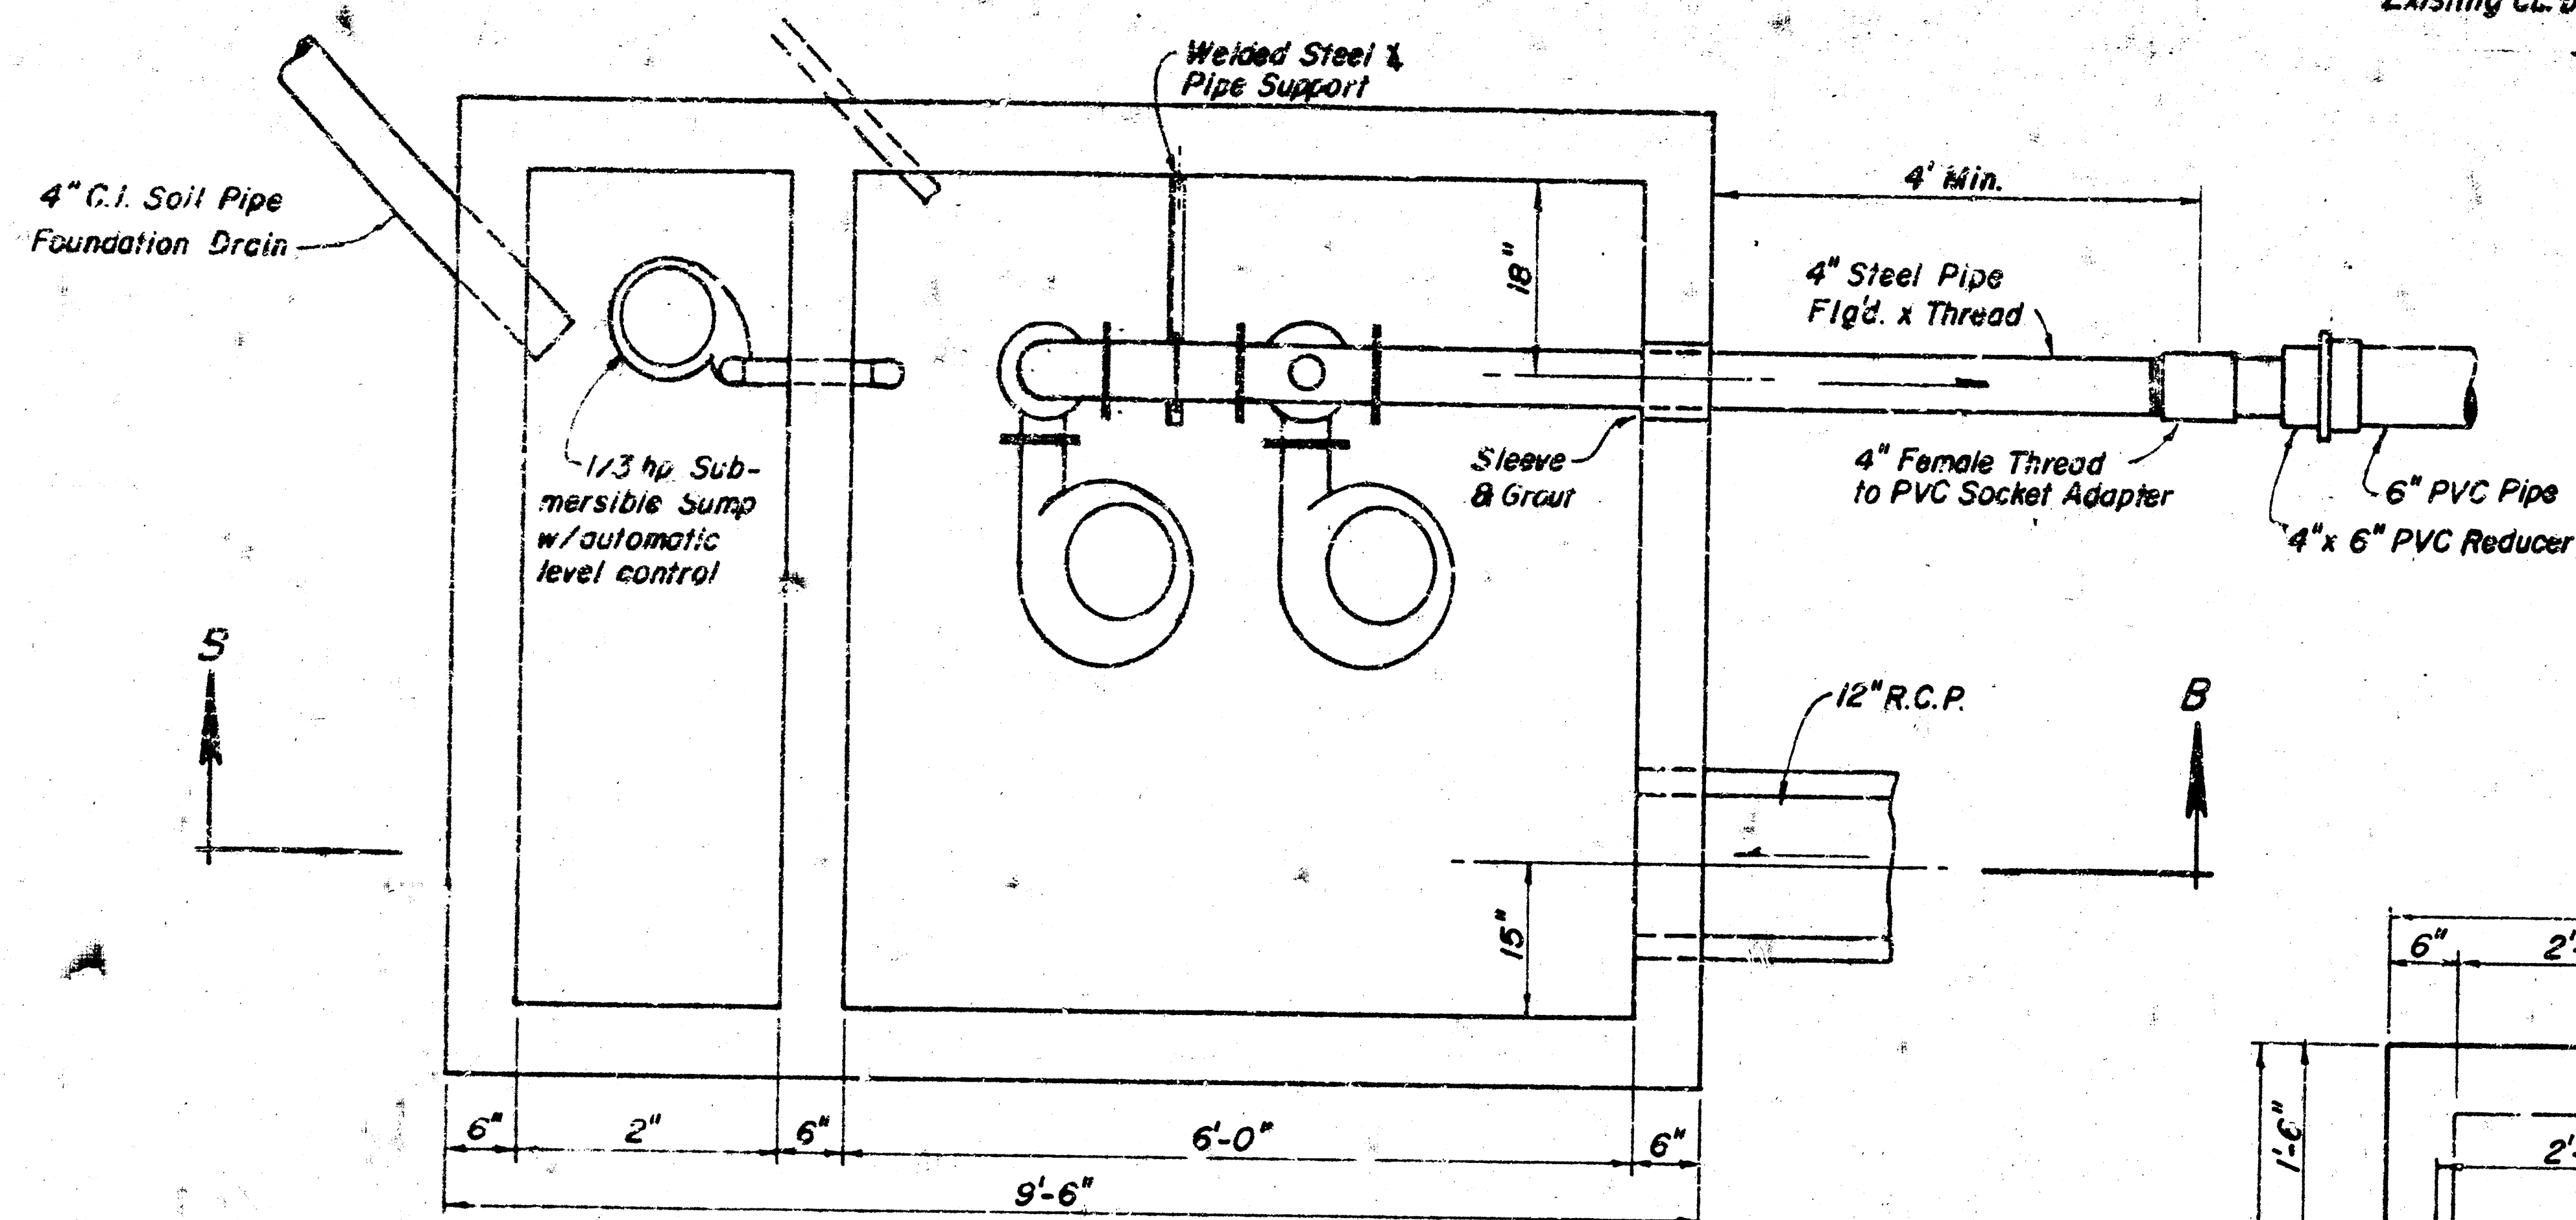

- Construction Notes:**

1. Steel discharge piping to be new Schedule 40 pipe and fittings, with 150 lb. welding flanges
2. 4" Check Valves to be "Technocheck Short Form" suitable for between flange mounting, C.I. body, butterfly type with no risings.
3. Pumps to be Feabody-Barnes, Model SEH 502, heavy duty, submersible (or equal). 54 H.P. - 1750 R.P.M. - 230 V - 3 phase - 60 cycle electric motor driven.

2. 4" Check Valves to be "Technoscheck Short Form" suitable for between flange mounting, C.I. body, butterfly type with no springs.

3. Pumps to be Feabody-Barnes, Model SEH 502, heavy duty, submersible (or equal). 5 H.P. - 1750 RPM - 230 V. - 3 phase - 60 cycle electric motor driven.