


PLAN
 SURVEYED BY
 NOTED BY
 CHECKED BY
 DATE

PROFILE
 SURVEYED BY
 NOTED BY
 CHECKED BY
 DATE

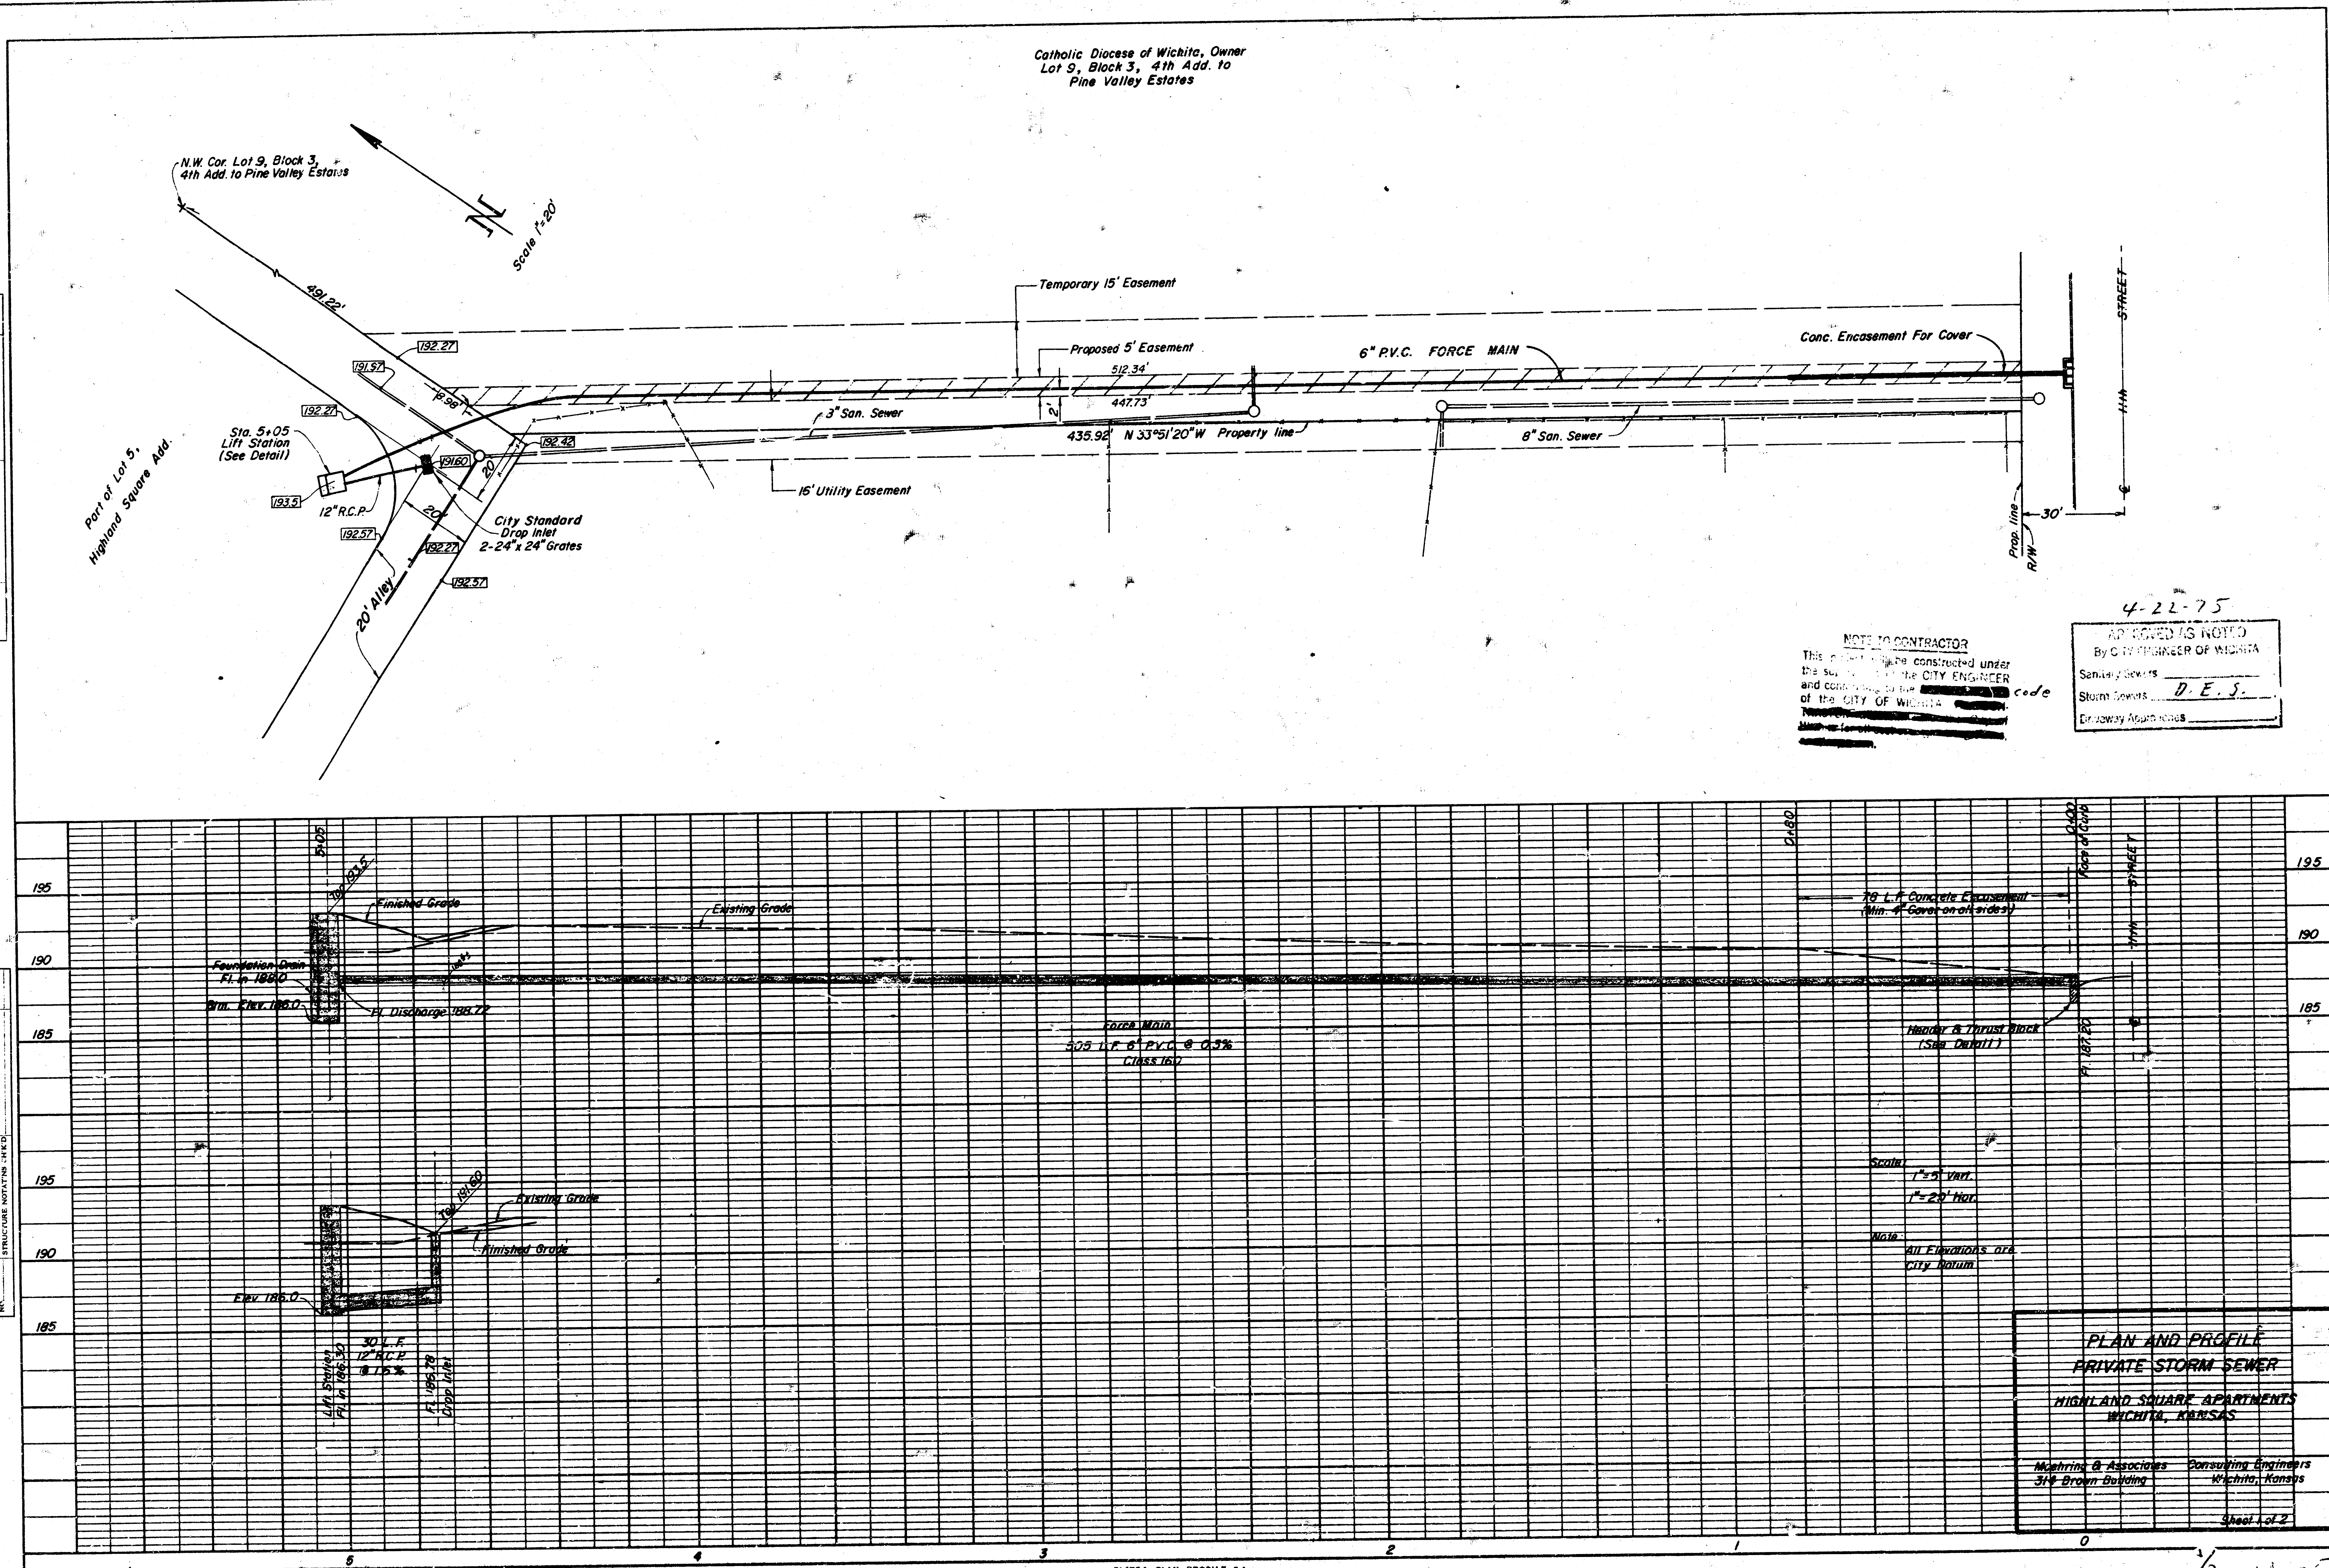



4-22-75
 APPROVED AS NOTED
 By CITY ENGINEER OF WICHITA
 Sanitary Sewers
 Storm Sewers
 Drainage Apertures

NOTE TO CONTRACTOR
 This project shall be constructed under the supervision of the CITY ENGINEER and conform to the CITY ENGINEER of the CITY OF WICHITA code.

**PLAN AND PROFILE
 PRIVATE STORM SEWER
 HIGHLAND SQUARE APARTMENTS
 WICHITA, KANSAS**

MOHRING & ASSOCIATES Consulting Engineers
 314 Brown Building
 Wichita, Kansas

FILMED FROM THE BEST AVAILABLE COPY....

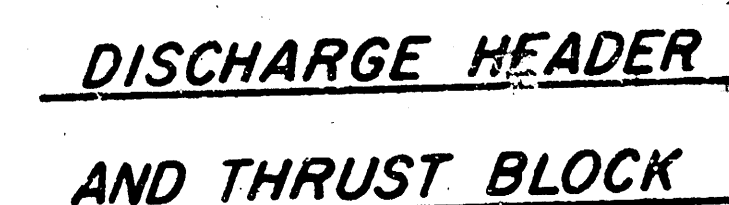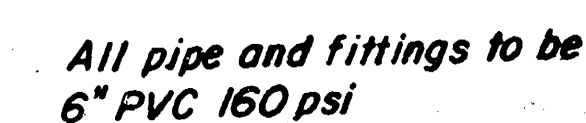

- Construction Notes:**

1. Steel discharge piping to be new Schedule 40 pipe and fittings, with 150 lb. welding flanges
2. 4" Check Valves to be "Technocheck Short Form" suitable for between flange mounting, C.I. body, butterfly type with no springs.
3. Pumps to be Peabody-Barnes Model SEH 502, heavy duty, submersible (or equal). 5 H.P. - 1750 RPM - 230 V- 3 phase-60 cycle electric motor driven.

MISCELLANEOUS DETAILS
PRIVATE STORM SEWER

**HIGHLAND SQUARE APARTMENTS
WICHITA, KANSAS**

Moehring & Associates
314 Brown Building

**Consulting Engineers
Wichita, Kansas**

Sheet 2 of

M-2

FILMED FROM THE BEST
AVAILABLE COPY