



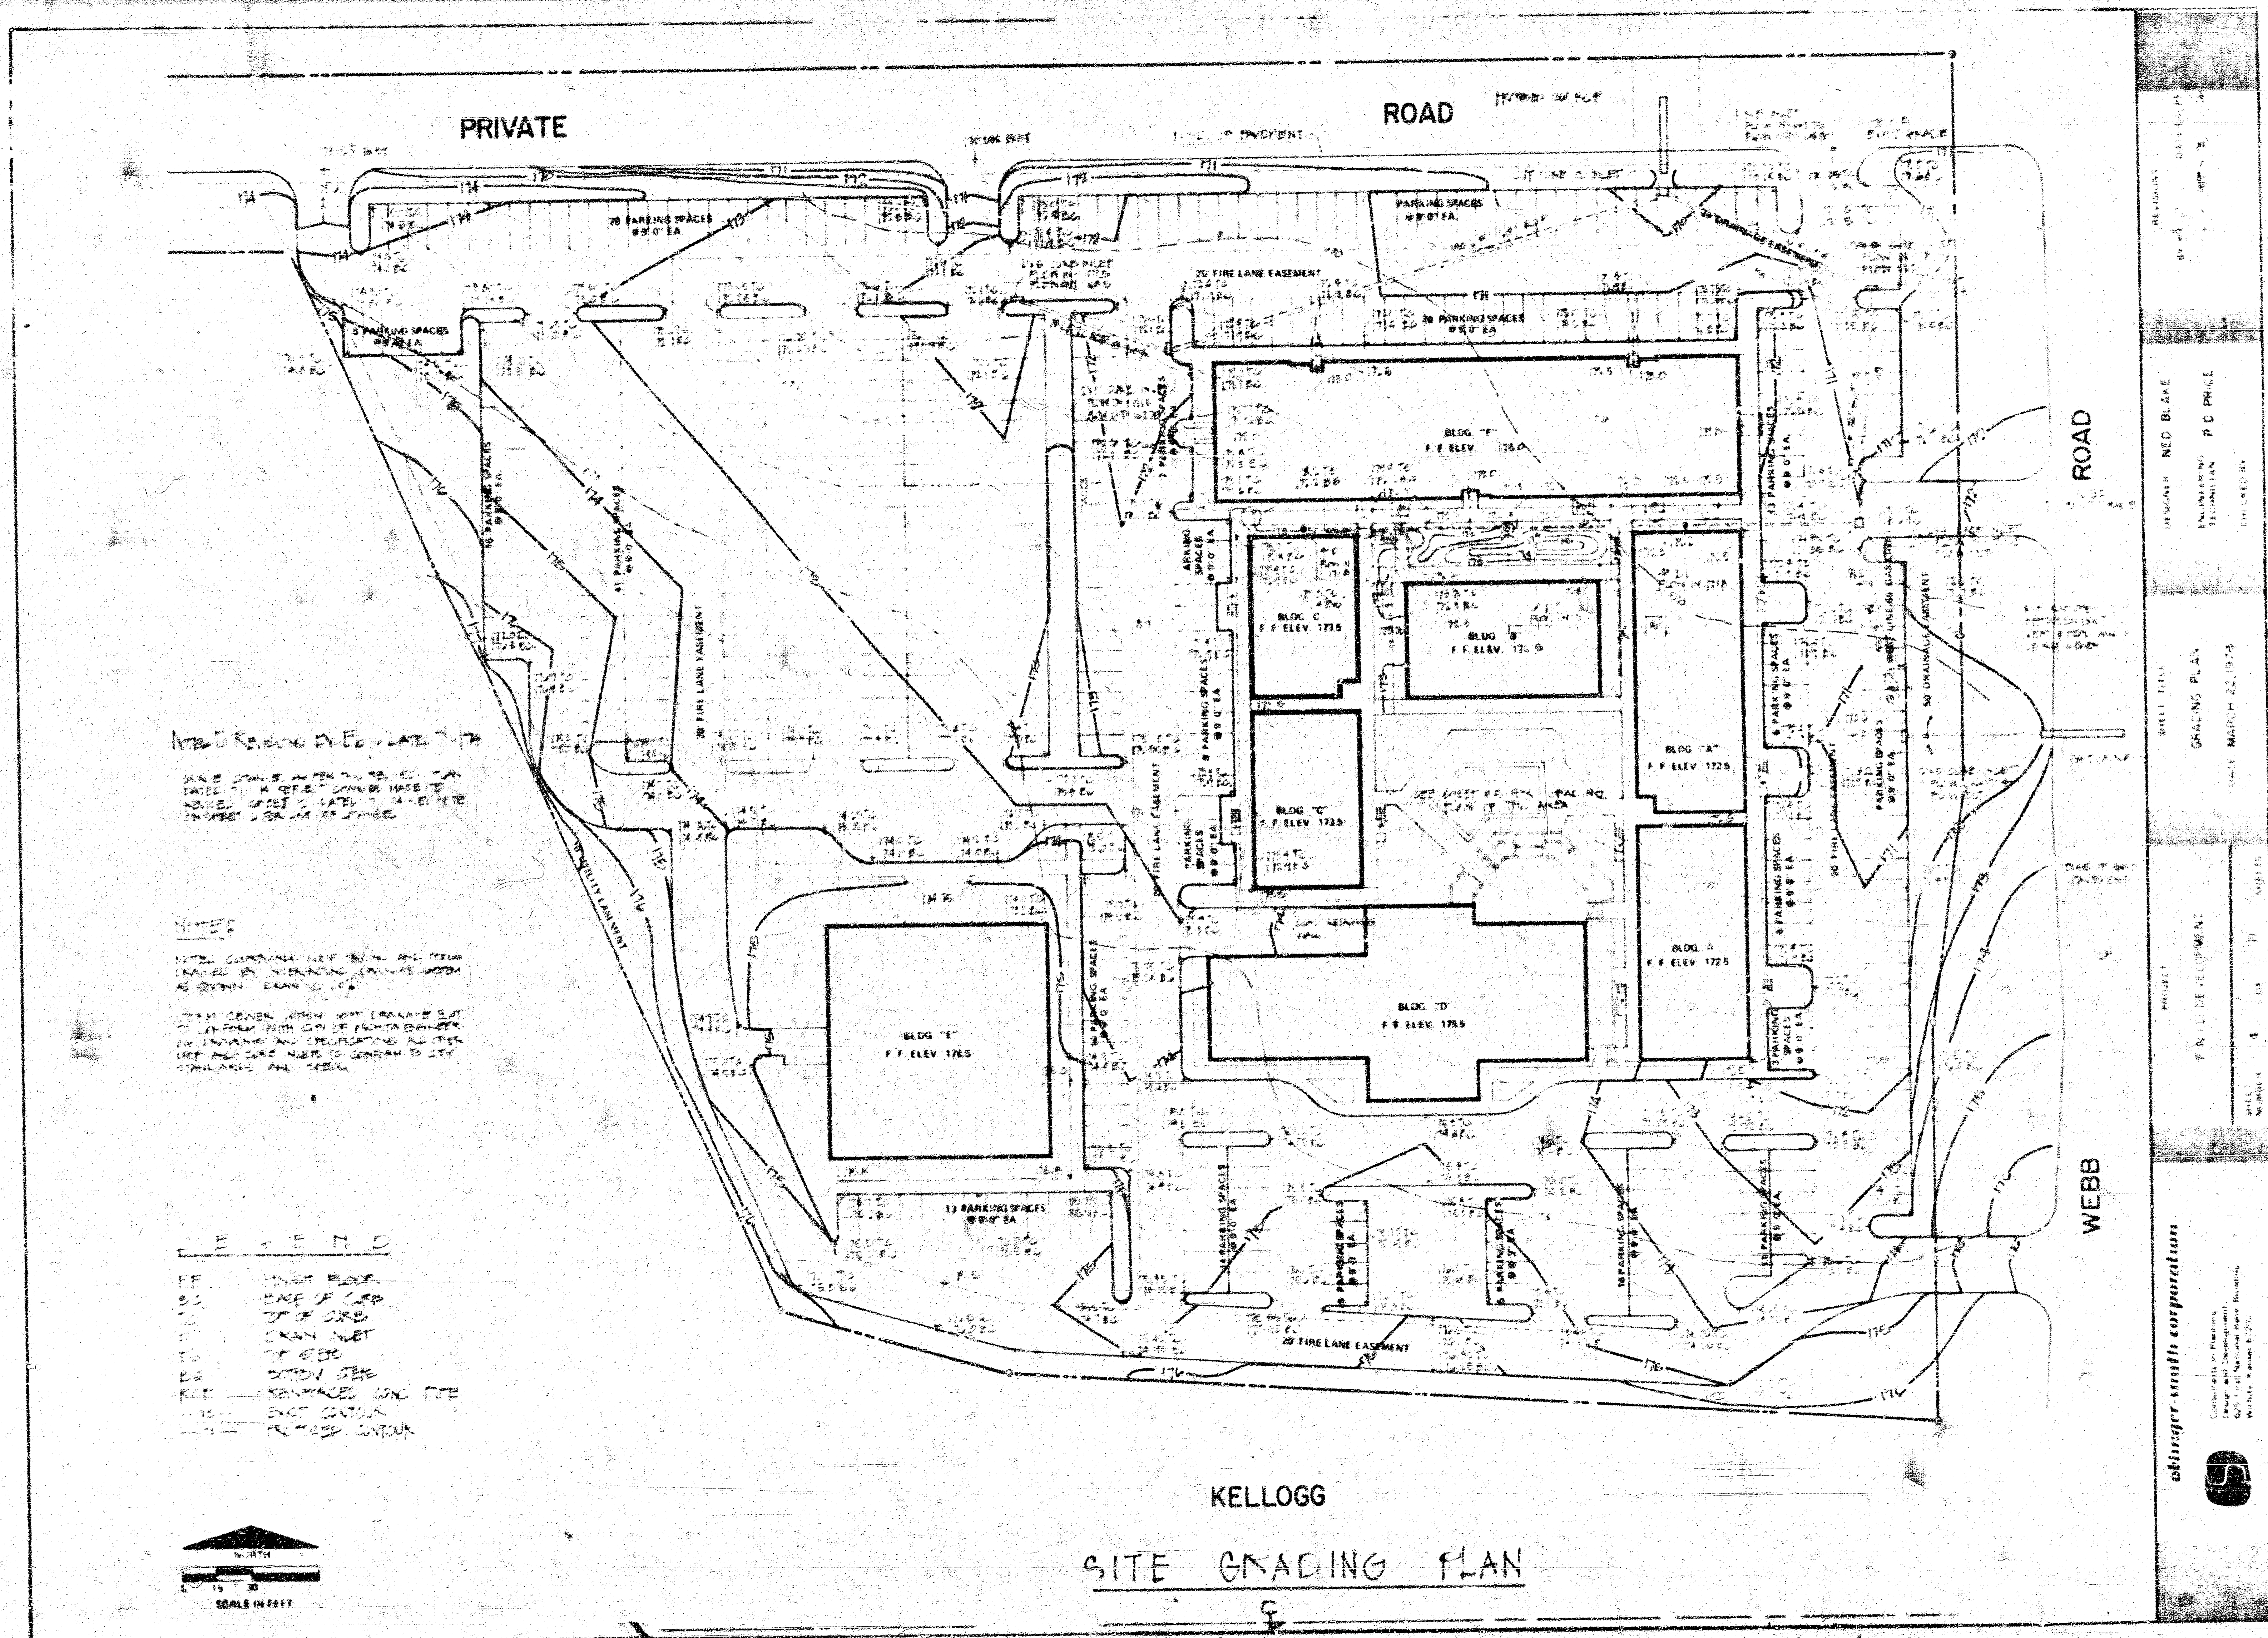

 

NOTES: REVISIONS BY E.D. DATE 7/14

1. IN NORTH CORNER OF SITE, ABOVE DRIVE CHAIN ON PLAN, LABEL #10 IS TO BE DELETED AND REPLACED WITH "VALLEY DRIVE" AS SHOWN FOR THE REVISED PLAN DATE 7/14.



2. PARKING SPACES CHANGED TO BE OF BLUE PRINT TYPE A, 15' OF BLDG. C & NORTH OF BLDG. D. PREVIOUS PLAN SHOWN 24' H. 20' TOTAL MINIMUM 14'50" TOTAL PARKING AREA. THIS REVISION PLAN & 45' AN INCREASE OF 1' STALL.

LEGEND

ROADWAY AND PARKING AREAS SHALL BE ASPHALT W/ CONC. CURB AND GUTTER OR EQUAL.


PLANTERS IN PARKING AREAS SHALL HAVE CONC. CURB AND GUTTER OR EQUAL.

ALL RADII SHALL BE 5' UNLESS NOTED.

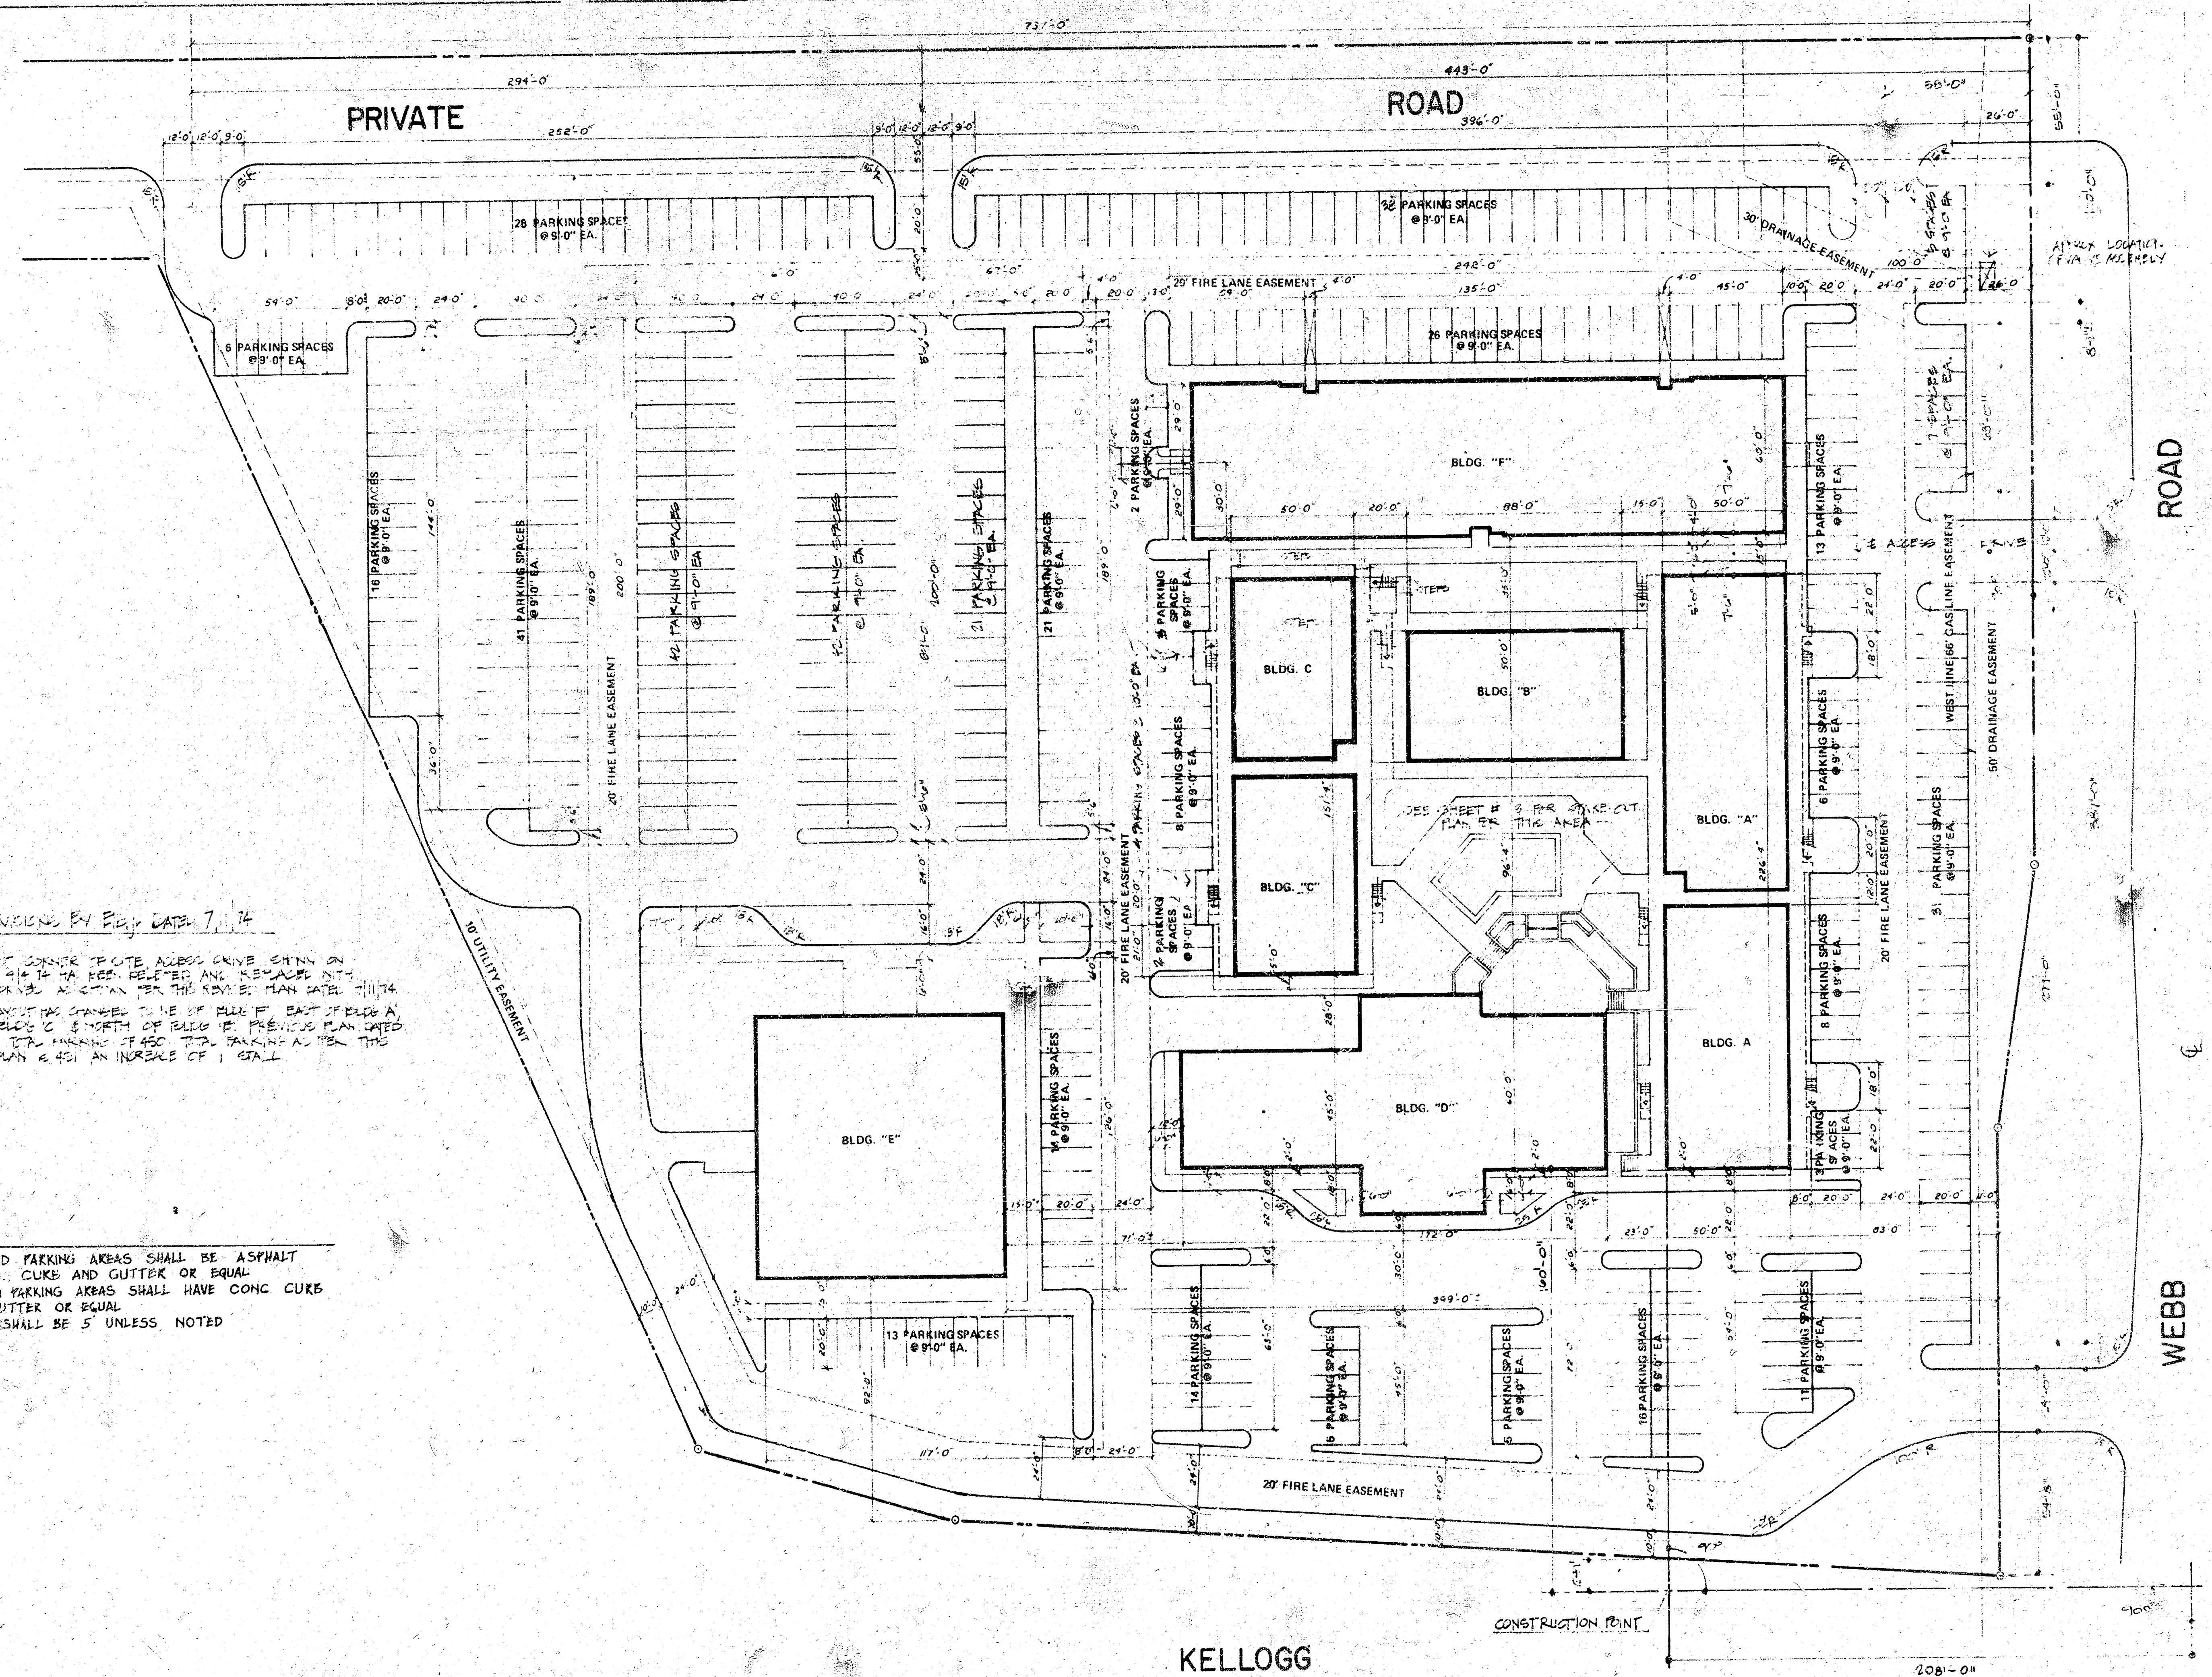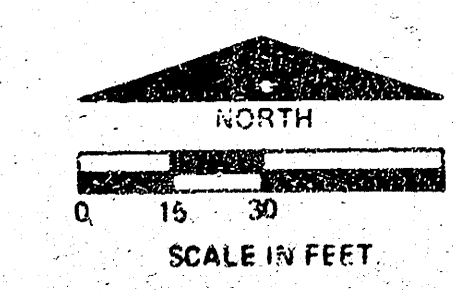

KELLOGG

SITE LAYOUT PLAN

  ottinger-smith corporation Consultants in Planning Design and Development 625 First National Bank Building Wichita, Kansas 67202	PROJECT F.N.C. DEVELOPMENT		SHEET TITLE LAYOUT PLAN		DESIGNER NED BLAKE ENGINEERING P.D. PRICE TECHNICIAN	REVISIONS BY <i>dy</i> DATE <i>4-14-74</i> <i>dy</i> (<i>SEE NOTE</i>) <i>7-11-74</i>
	SHEET NUMBER 2	OF 11	DATE MARCH 22, 1974	CHECKED BY		