

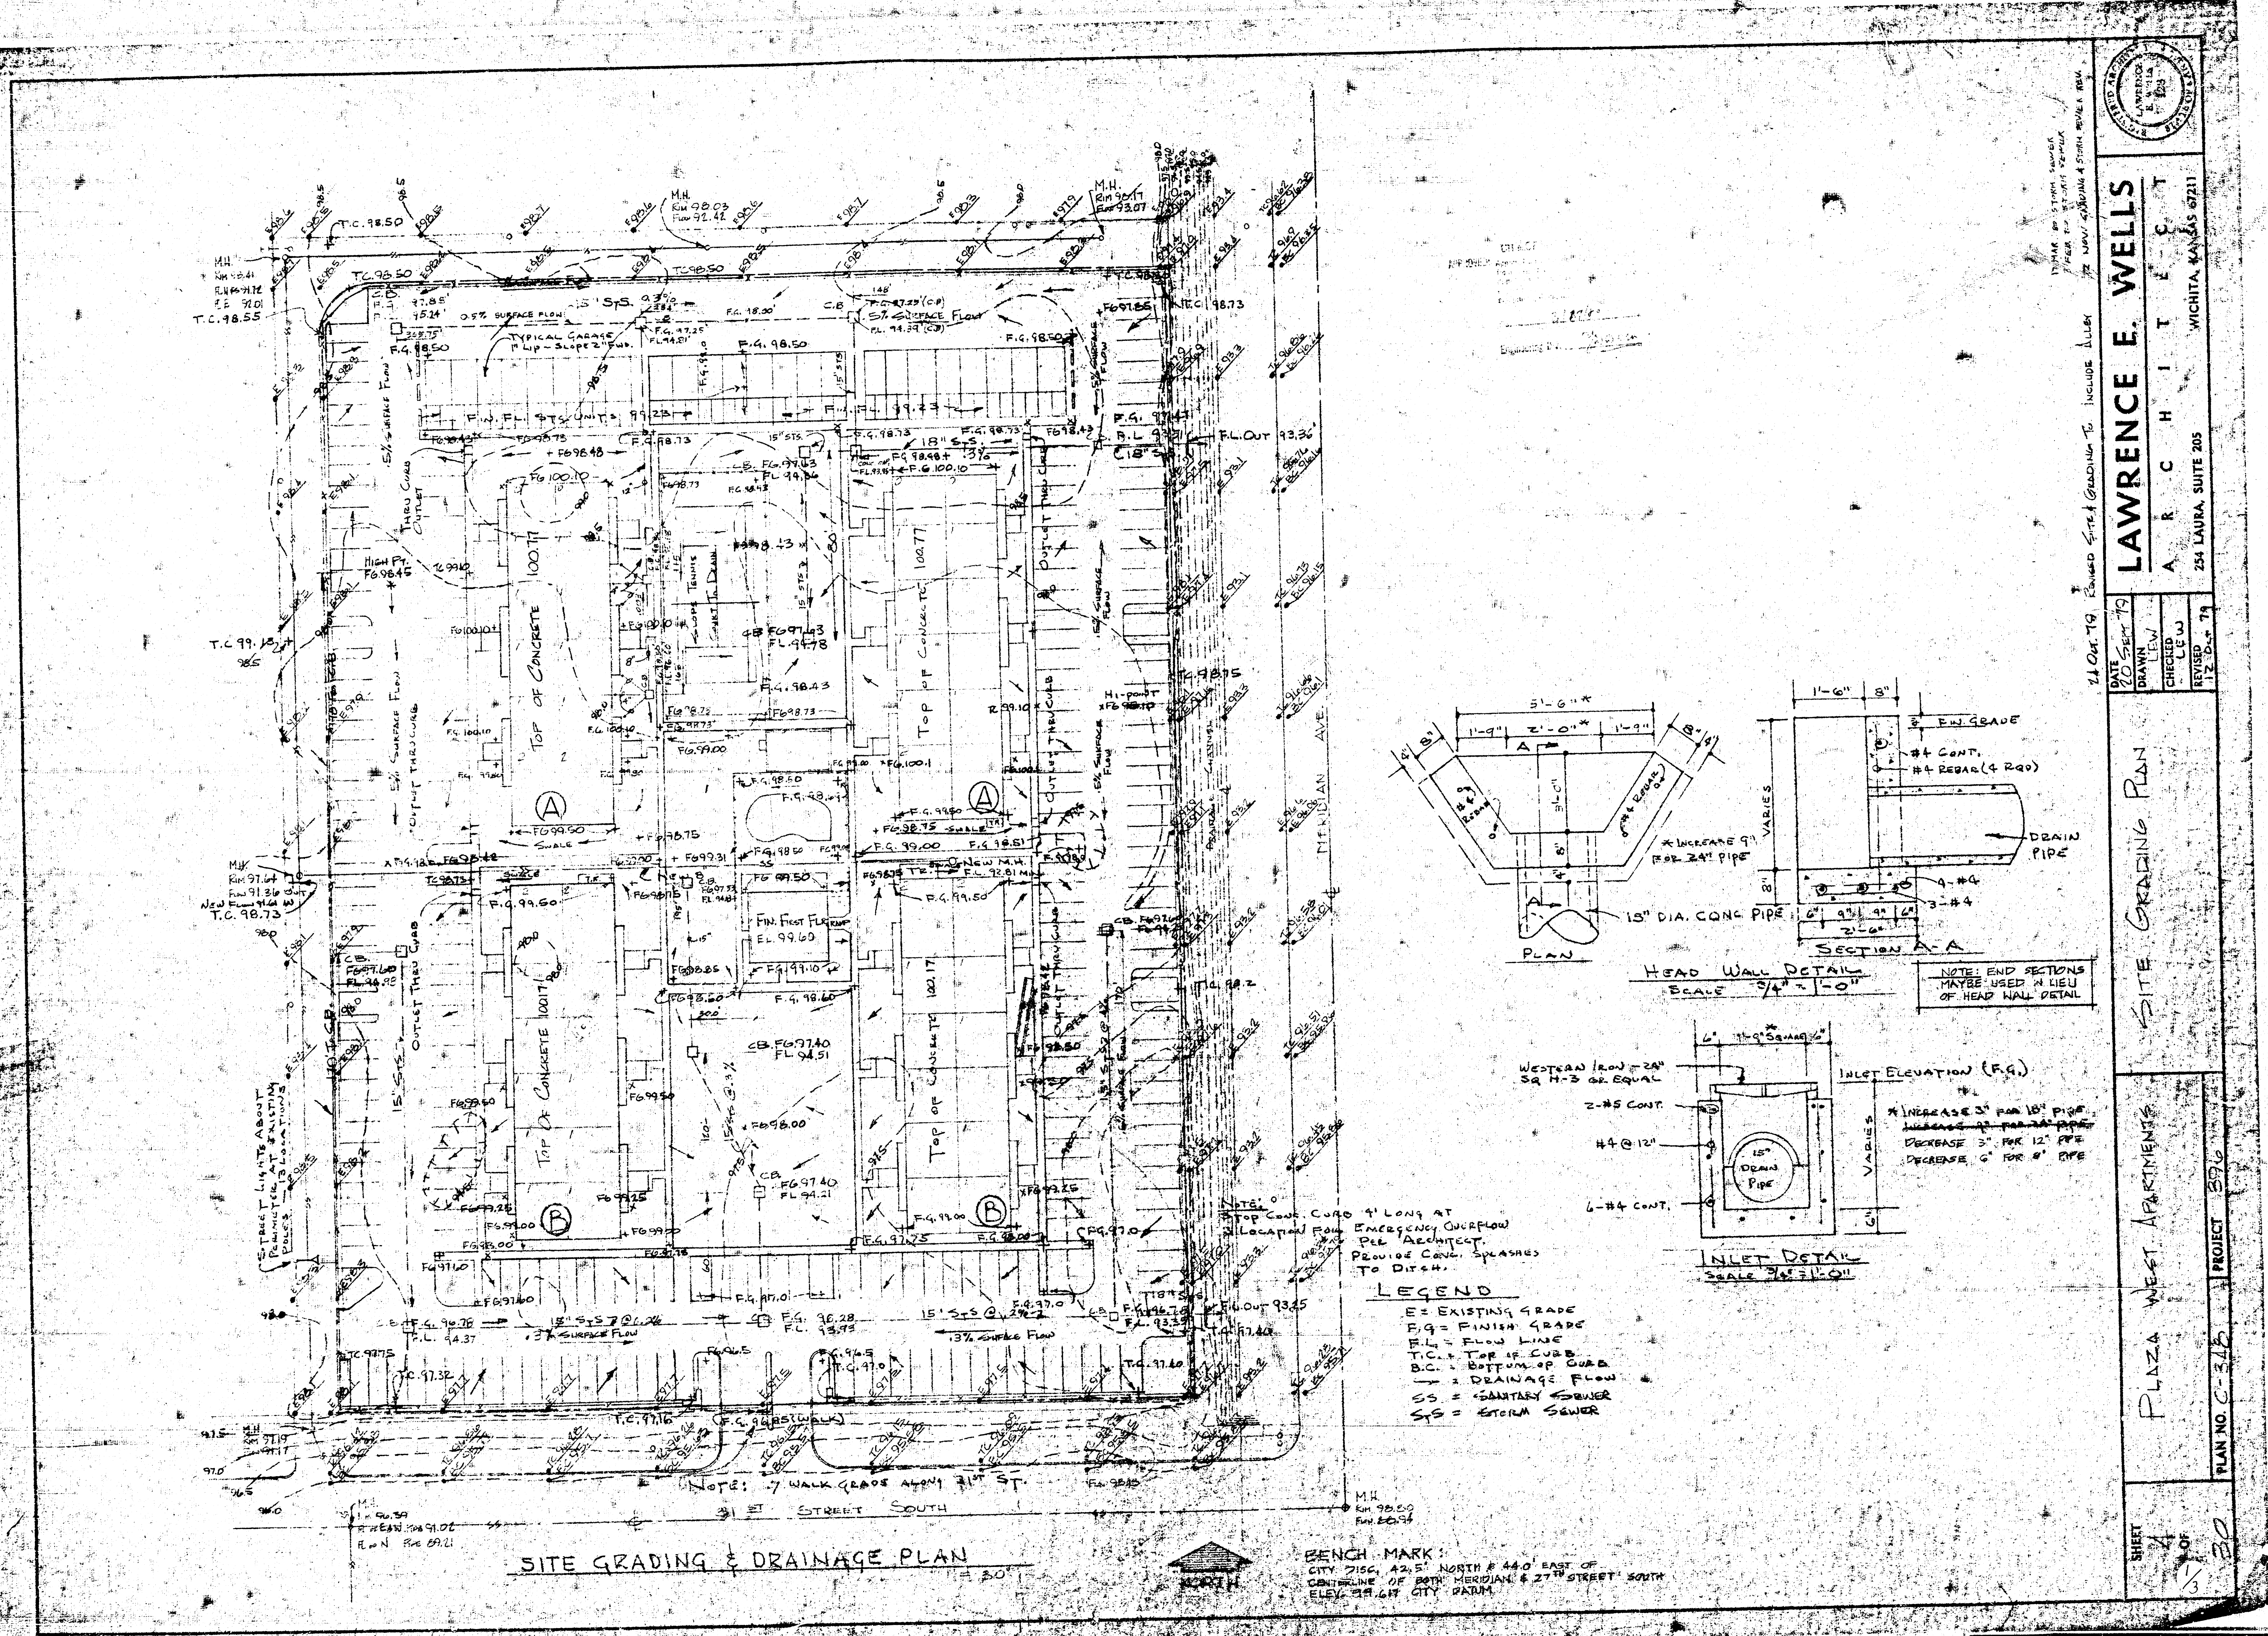


 

		LAWRENCE E. WELLS ARCHITECT 234 LAURA SUITE 205 WICHITA, KANSAS 67211	
		DATE: 10-1-79 DRAWN BY: LEW CHECKED BY: LEW REVISION: 1-1-79	PROJECT: 1506 PLAN NO: C-315
PLAZA WEST APARTMENTS SITE GRADING PLAN		SHEET: 1 OF 1	

FILMED FROM THE BEST AVAILABLE COPY.....

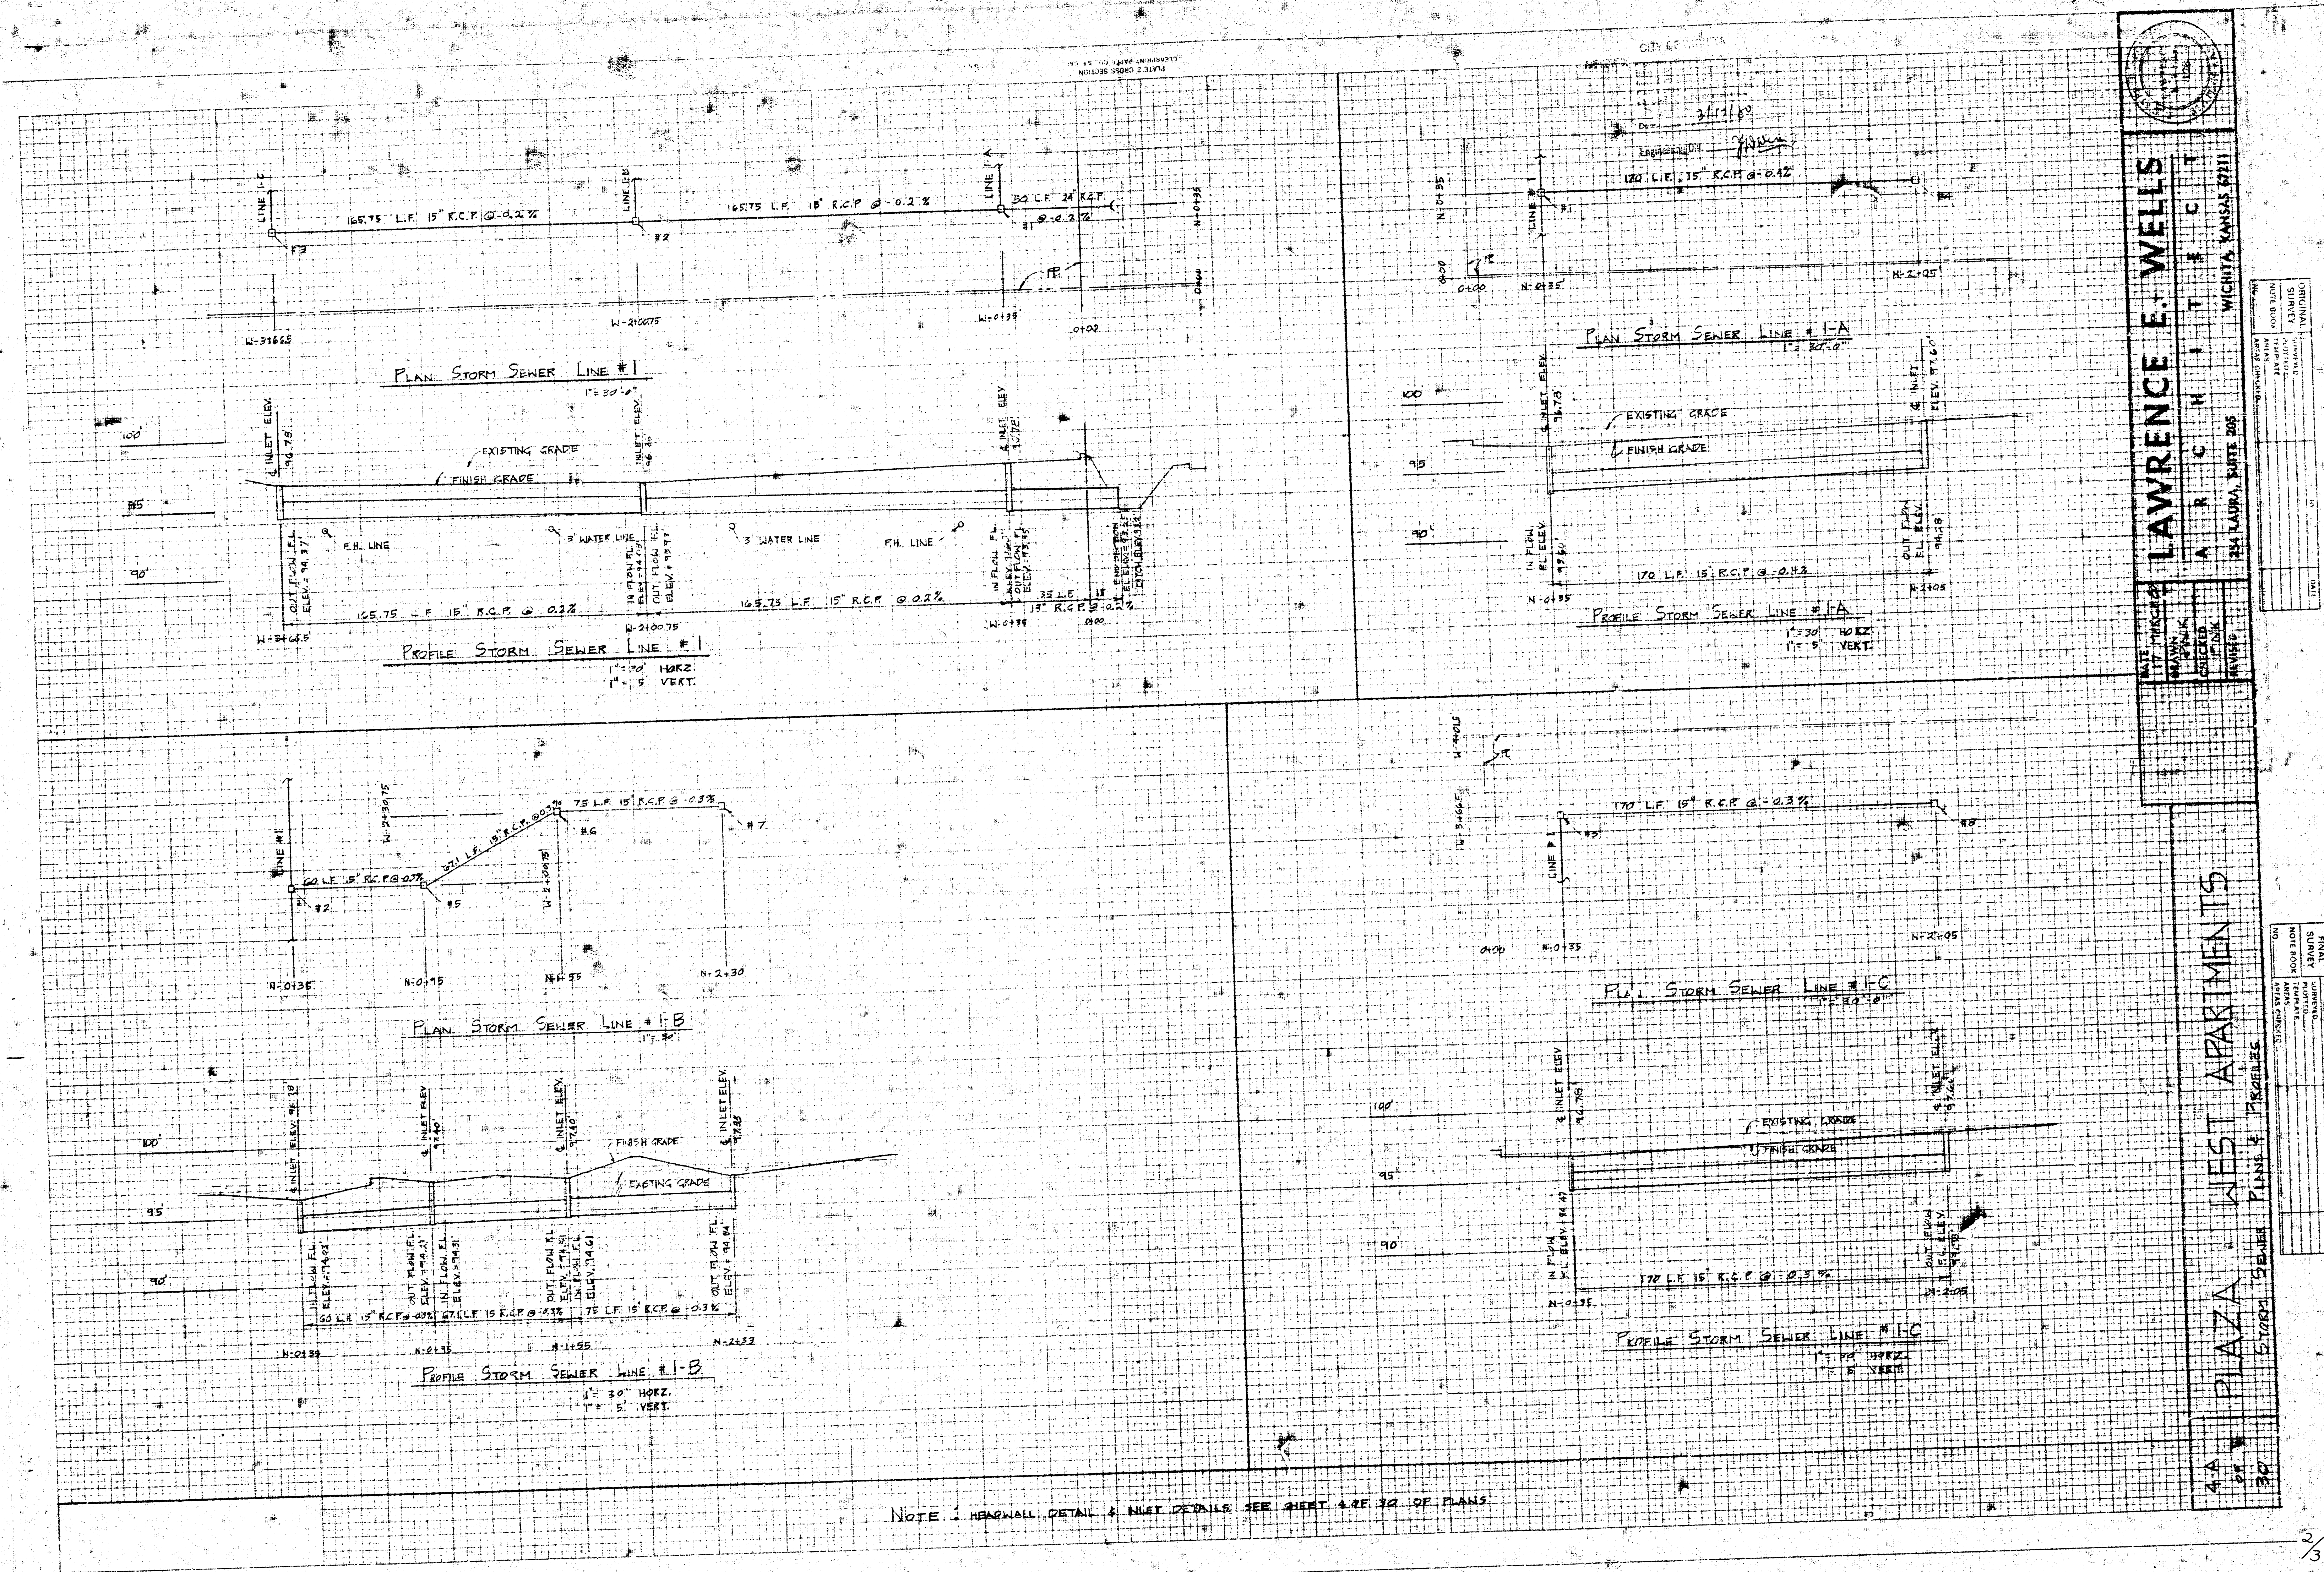

LAWRENCE E. WELLS
A R C H I T E C T

251 LAURA, SUITE 205
WICHITA, KANSAS 67211


4-A PLAZA WEST APARTMENTS
STORM SEWER PLANS & PROFILES


FILMED FROM THE BEST AVAILABLE COPY.....

