

2-6-76

APPROVED AS NOTED
By CITY ENGINEER OF WICHITA
Sanitary Sewers
Storm Sewers D.E.S.
Driveway Approaches

Note: Approval of this plan does not indicate that construction of a building over an existing 30"x18" storm sewer has been approved.

NOTE TO CONTRACTOR


This project will be constructed under the supervision of the CITY ENGINEER and conforming to the SPECIFICATIONS of the CITY OF WICHITA. The CONTRACTOR will reimburse the City of Wichita for all cost of Engineering, Plans, and Inspection.

Scale:
Plan: 1"=50'
Profile: 1"=50'
Vert: 1"=5'

Assumed North
True North

All coordinates based on Assumed North

All bearings based on True North

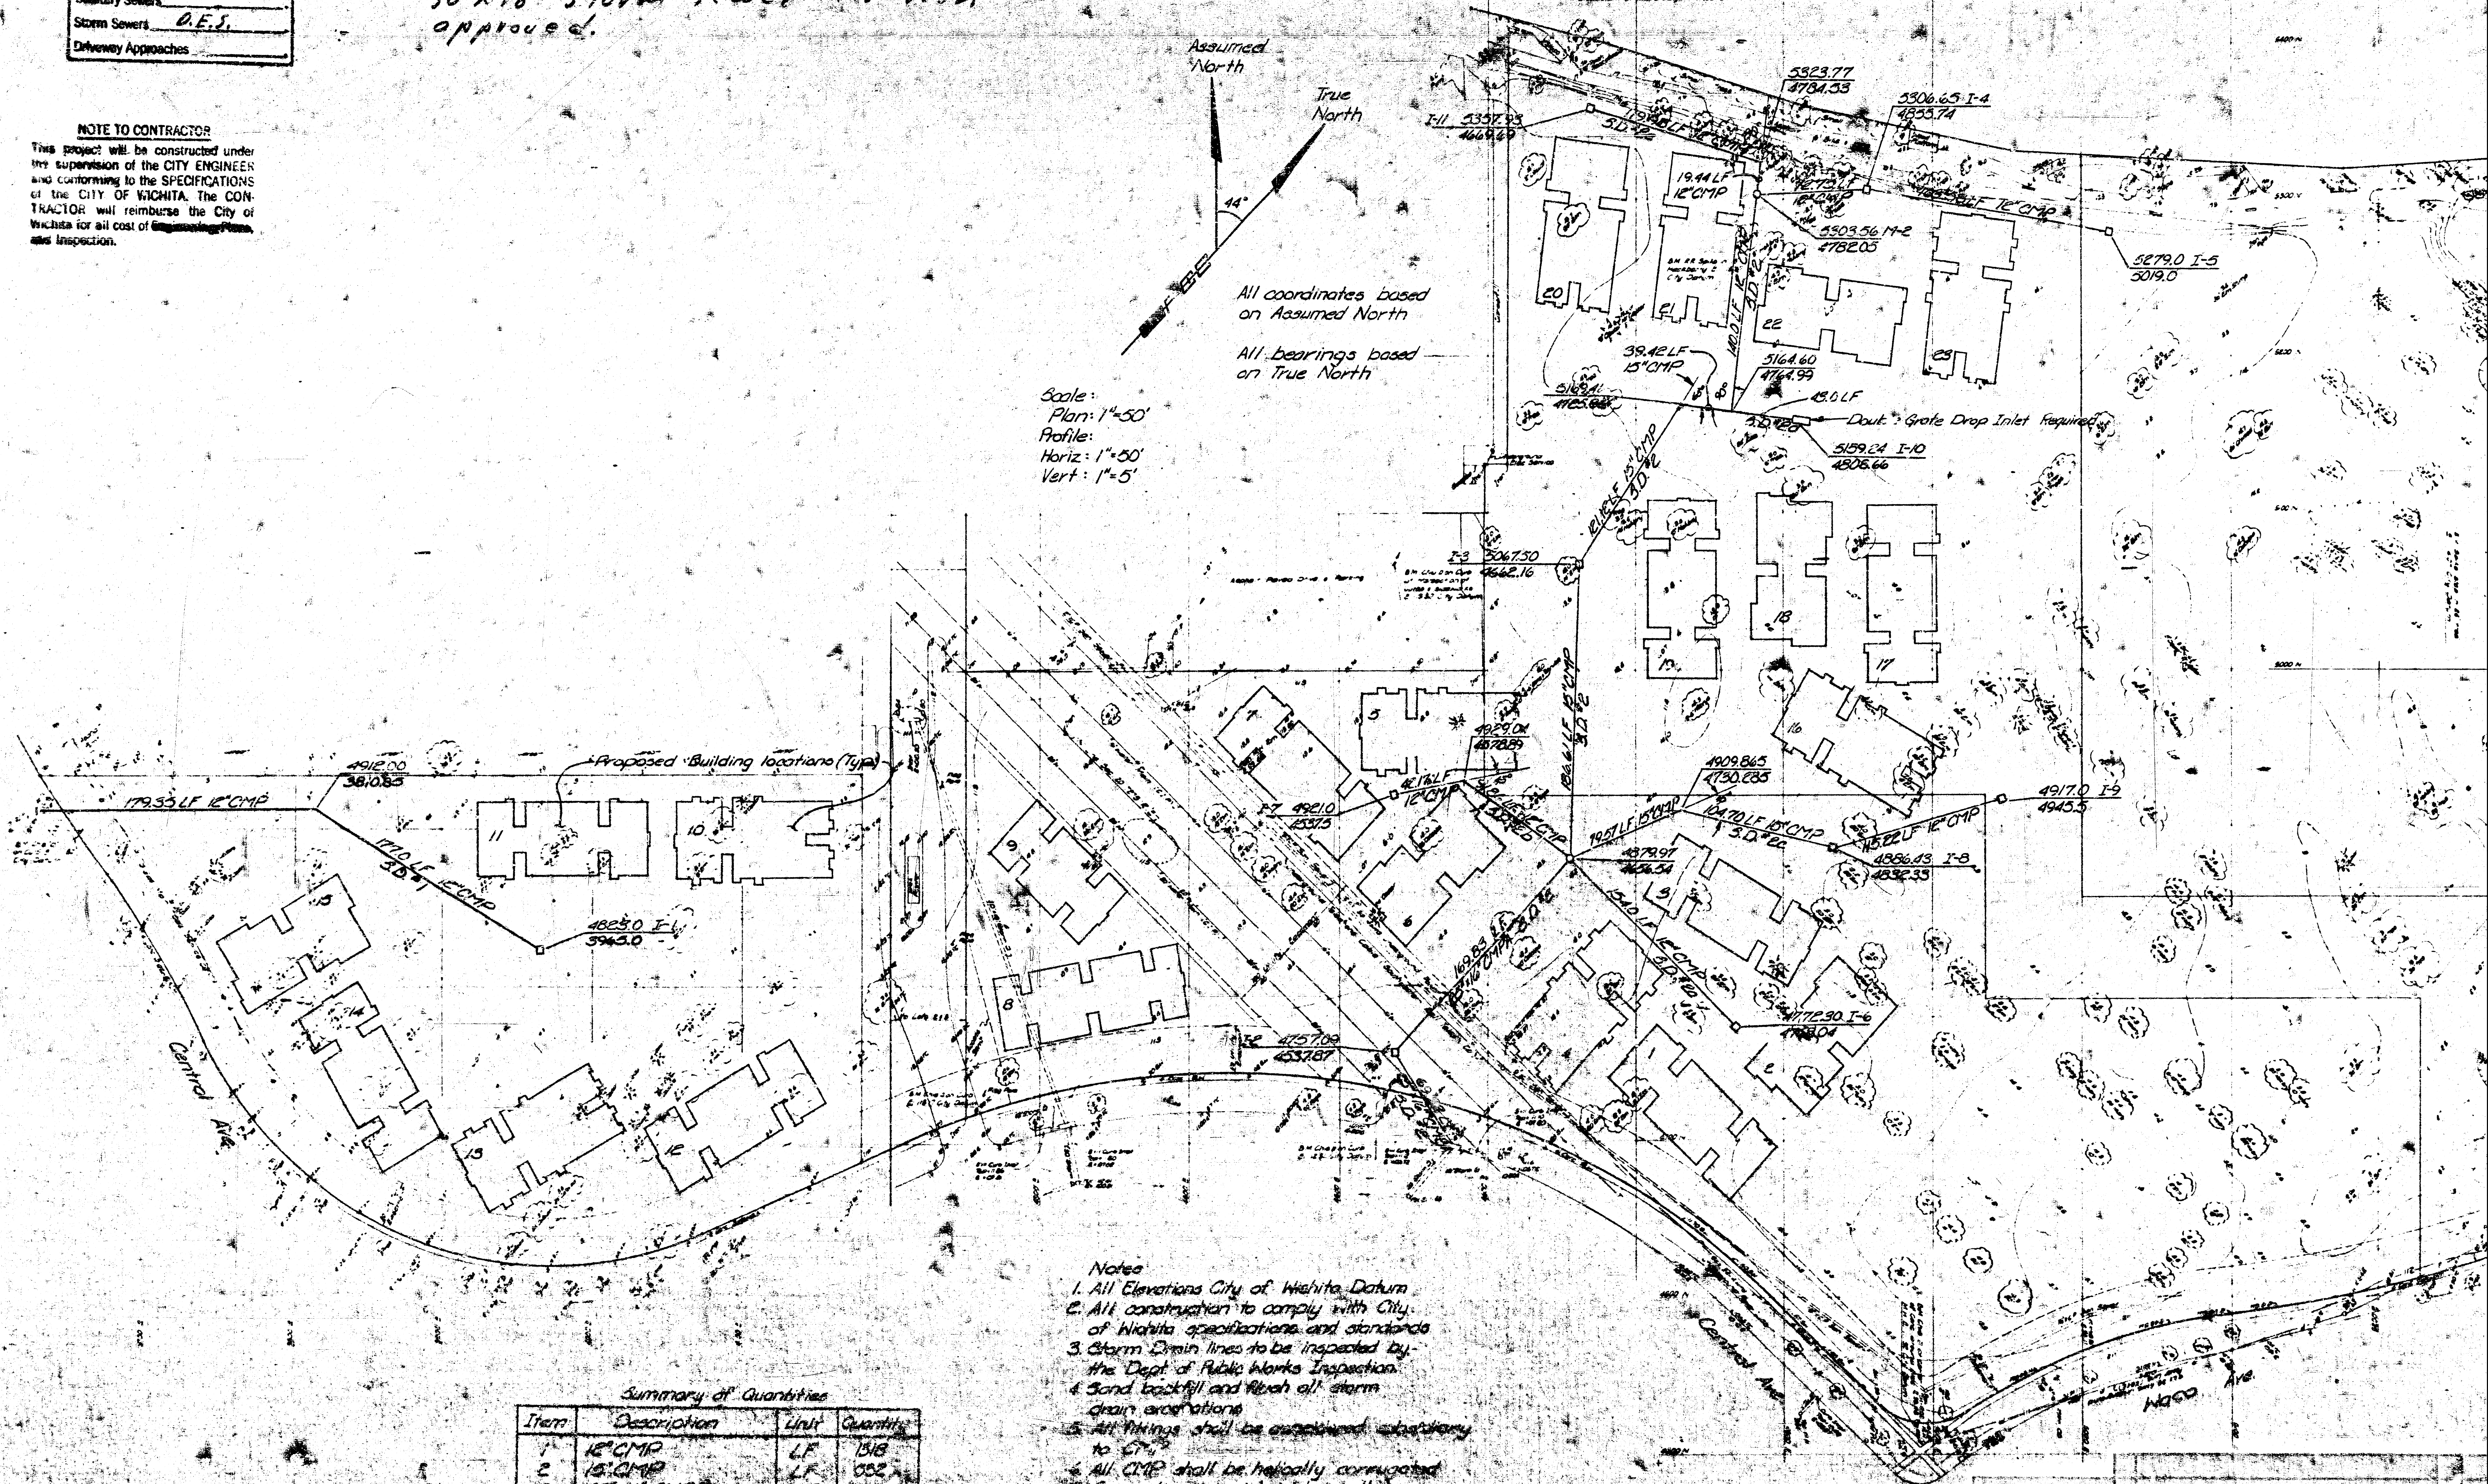

Notes

1. All Elevations City of Wichita Datum
2. All construction to comply with City of Wichita specifications and standards
3. Storm Drain lines to be inspected by the Dept. of Public Works Inspection
4. Sand backfill and finish all storm drain excavations
5. All fittings shall be approved subsidiary to City
6. All CMP shall be helically corrugated
7. Connection to exist inlets shall be constructed subsidiary to CMP
8. All inlets to be City of Wichita Std. Dwg. unless otherwise specified

Summary of Quantities

Item	Description	Unit	Quantity
1	12" CMP	LF	1518
2	15" CMP	LF	852
3	25" 16" CMP	LF	239
4	Manhole, Std	EA	2
5	Inlet (Single Grate)	EA	11
6	Inlet (Double Grate)	EA	1

FIVE INCH APARTMENT

