


- (1) PROVIDE ELECTRIC SERVICE TO LIGHT FIXTURES, PARKING CONTROL EQUIP ETC. AS REQ'D AND NOTED ON THE SITE PLAN.
- (2) NEW LIGHT FIXTURES (3 TUBS) SHALL BE PRECASTITE #5470 1/2" V-HO 120 LAMP SPAL ALUMINUM FIFTEENER HEAD AND FITTINGS ALL ALUMINUM LOW TEMP BALLAST, INST #16K 1/2" 2-PIECE BASE COVER, PROVIDE BRONZE FINISHED ALUMINUM IN COLOR AS SELECTED, MOUNTING HEIGHT 11'-0" - CONCRETE BASES AS REQ'D BY MFG. AND FURNISHED BY G.C.
- (3) ALL DIMENSIONS, RADIIUS, ETC. ARE TO FACE OF CURB.
- (4) ALL NEW WALKS SHALL BE 4" CONCRETE (SAND FILL MIX) W/ 3-6 #3, #3 IN. W/ OVER 3" COMPACTED AND FULL MATCH FINISH WHERE NEW WALK IS ADJACENT TO EXISTING.
- (5) PROVIDE 1/2" EXPANSION JOINT MATERIAL BETWEEN BACKSIDE OF CONCRETE CURB AND WALKS, AND BETWEEN EXISTING WALKS AND NEW WALKS, PROVIDE WITHIN NEW WALKS AT MAXIMUM 20' ± O.C.
- (6) LOCATE CONCRETE JOINTS AS INDICATED ON SITE PLAN AT 5' ± O.C.
- (7) ALL NEW WALKS, PAVING AND CURBS SHALL CONFORM TO EXISTING DIRECTION OF SLOPES FOR PROPER SURFACE DRAINAGE. VERIFY ALL ELEVATIONS THAT DEVIATE FROM THOSE SHOWN ON THE SITE PLAN.
- (8) ALL NEW CONC CURBS SHALL MATCH EXISTING PROFILE (DEPTH, WIDTH ETC.) AND SHALL BE CITY MIX.

- ⑨ ALL NEW COMBINED CURB AND GUTTER SHALL BE CITY MIX - STANDARD OF RESERVE GUTTER AS REQ'D FOR FLOW OF SURFACE DRAINAGE.
- ⑩ VERIFY DEPTH AND LOCATION OF ALL UNDERGROUND UTILITIES BEFORE EXCAVATION WORK.
- ⑪ ALL ELEVATIONS ARE FINISH GRADE OF PAVING OR FLOW LINE GUTTER.

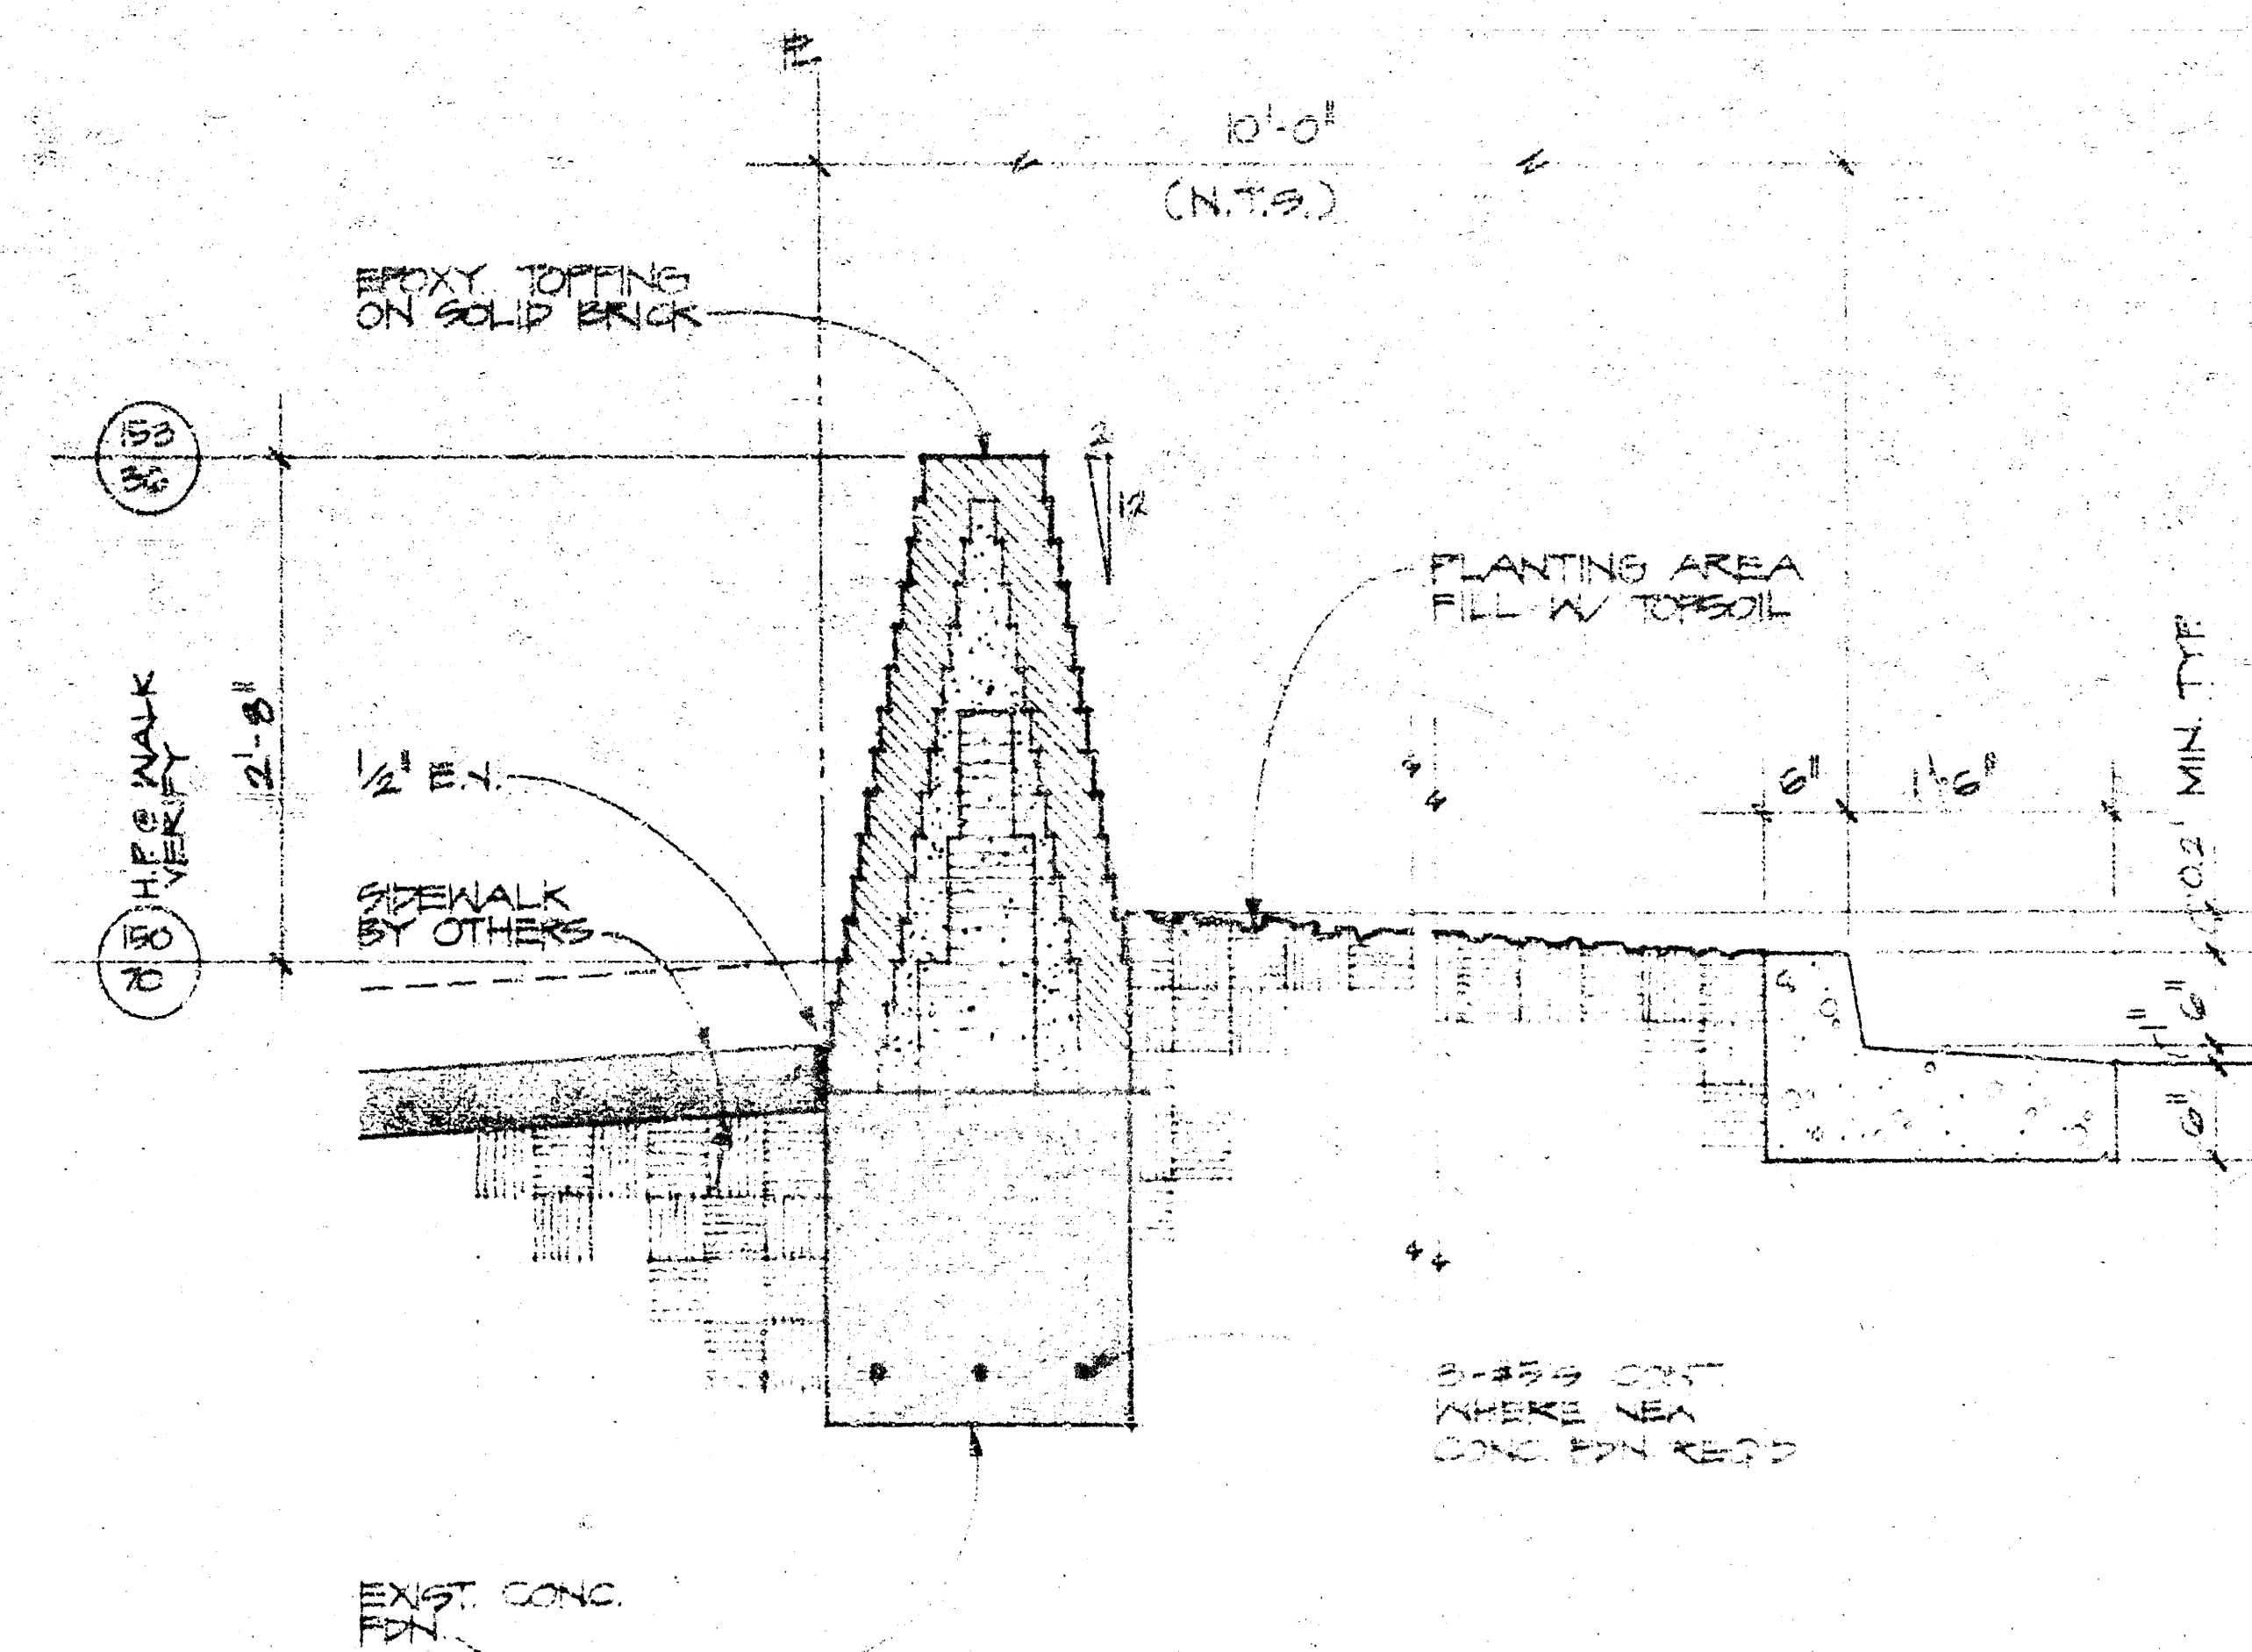

B SECTION @ MASONRY WALL $\frac{3}{4}'' = 1' - 0''$

NOTE TO CONTRACTOR
This project will be constructed under the supervision of the CITY ENGINEER and conforming to the SPECIFICATIONS of the CITY OF WICHITA. The CONTRACTOR will reimburse the City of Wichita for all cost of Engineering, Plans, and Inspection.

APPROVED AS NOTED
By CITY ENGINEER OF WICHITA

Storm Sewers *D.F.S.*

Driveway Approaches

NORTH PARKING GARAGE

EXTENDED CARE FACILITIES

MATEKNITY BUILDING

NORTHWEST COURTYARD

WEST BUILDING

SECRET

HILLSIDE AVENUE

A SITE PLAN/PARKING LOT "C"

$$J'' = 20$$

¹ Storm Water Ext. for Wesley Medical Center

LEGEND

EXISTING CURB & GUTTER TO REMAIN

EXISTING CEMENTAL K-70 REMAINS

THOMAS, HARRIS, ASH & MASON Architects & Engineers
2822 NORTH WACO WICHITA, KANSAS 67202 (316) 262-8484

HILLSIDE
LOTS
ISSLEY MEDICAL
PARKING
REVISIONS
CENTER
KANSAS
NIGHT