

NOTE TO CONTRACTOR


NOTE

This contract shall be constructed under the supervision of the CITY ENGINEER and conform to the SPECIFICATIONS of the CITY CONTRACTOR shall pay the cost of plan review, and the cost of contract.

Sanitation
Sgt. [Signature] 6-3-86
[Signature]



FINALED
4-15-87
GREENE

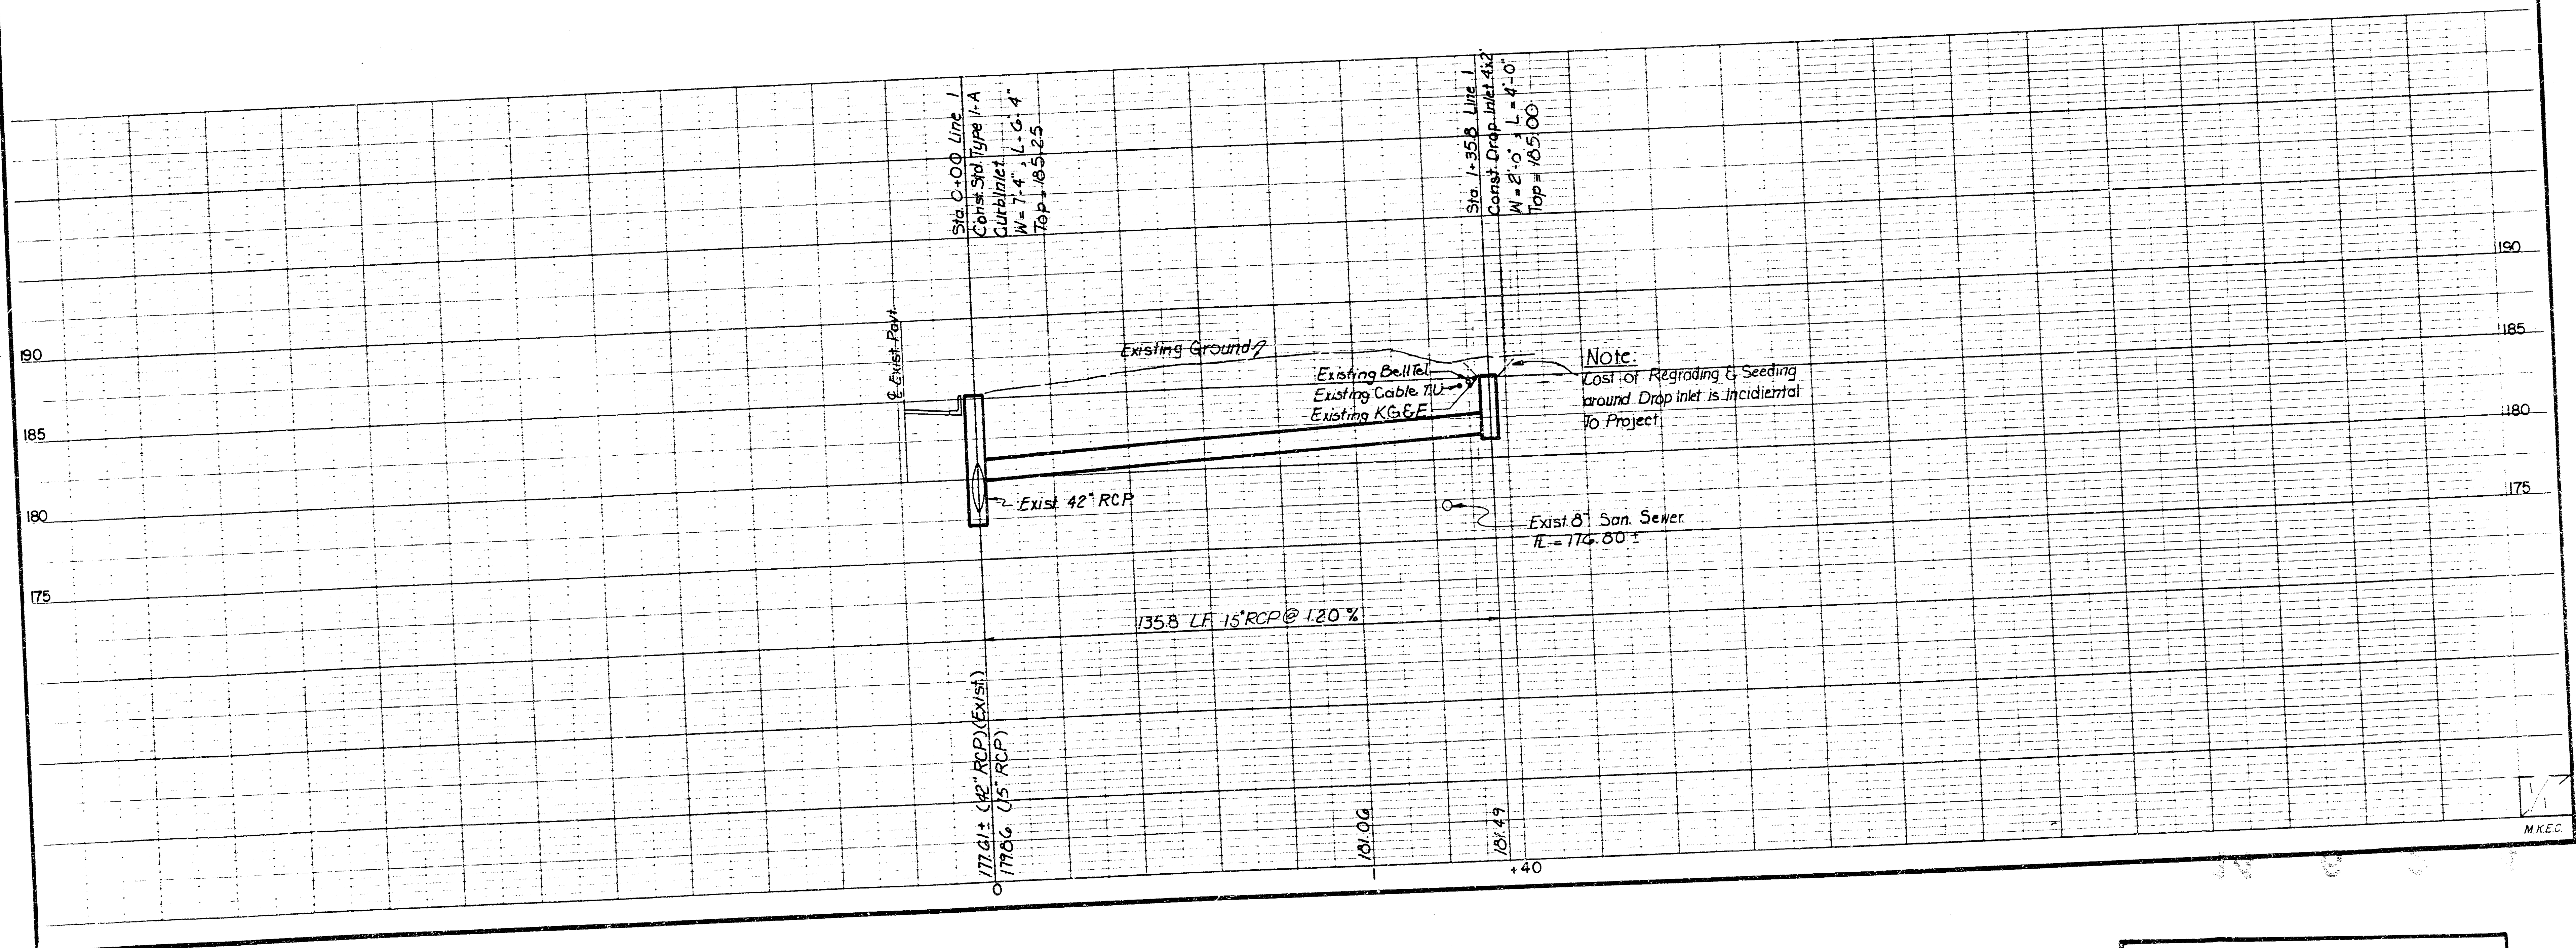

FILMED FROM THE BEST
AVAILABLE COPY.....